
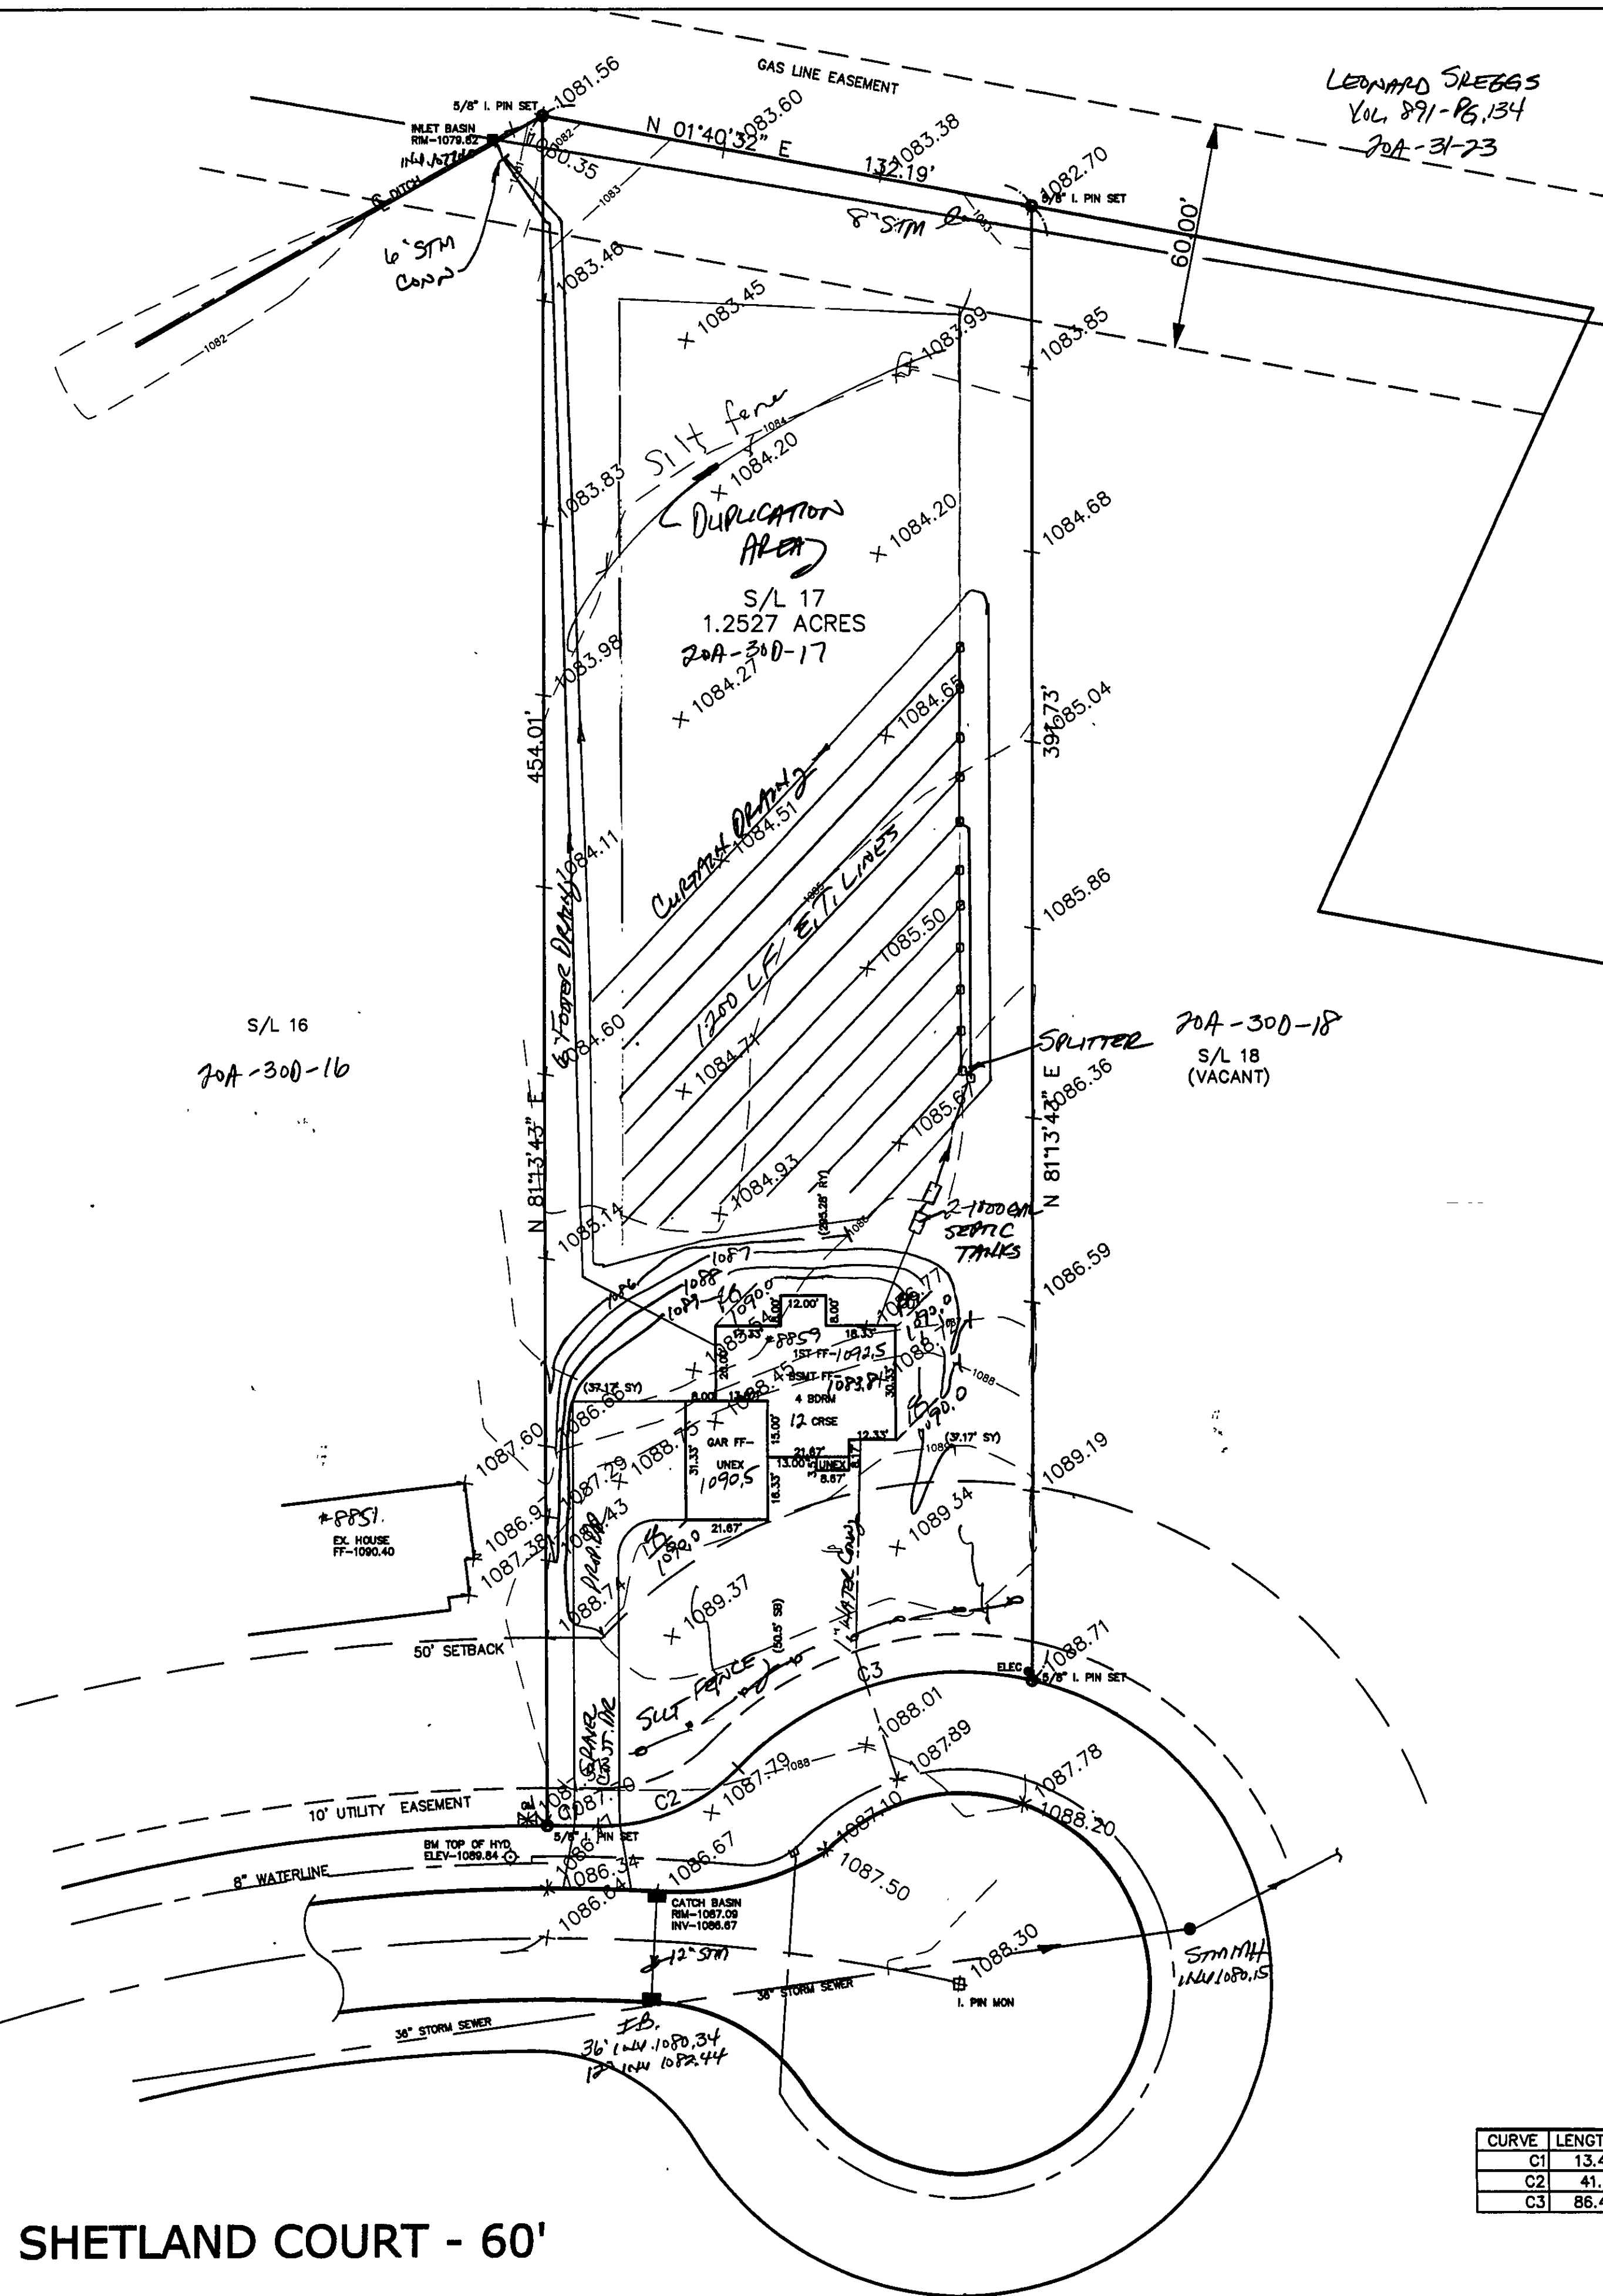
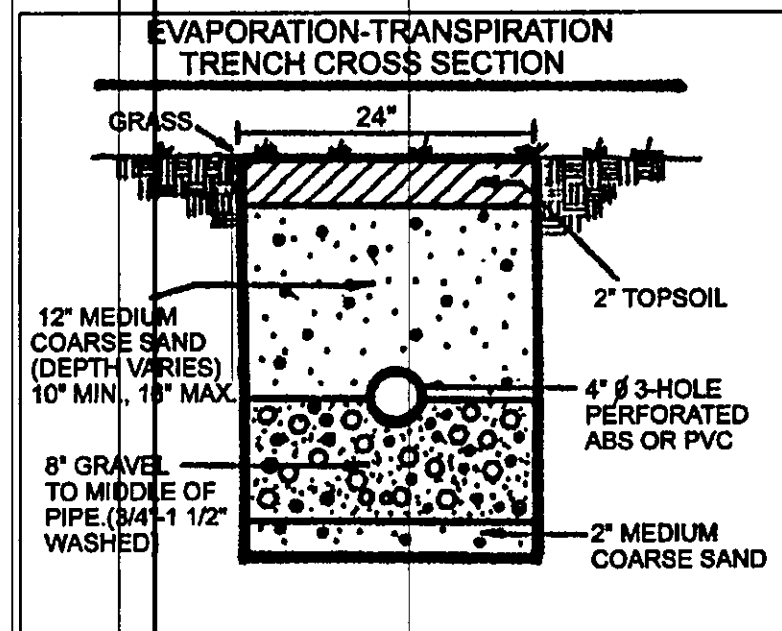


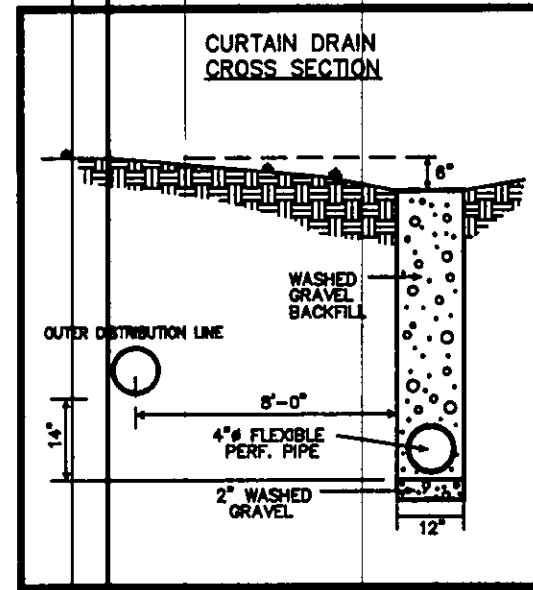

SURVEYOR CERTIFICATION

THIS PLAT REPRESENTS A SURVEY WHICH MEETS STANDARDS FOR A BOUNDARY SURVEY IN THE STATE OF OHIO AS SPECIFIED IN THE ADMINISTRATIVE CODE CHAPTER 4733-37

SURVEYED ON Sept. 24, 2003 BY William Babcock UNDER THE SUPERVISION OF HARRY JONES, P.S. # 6343, ALL IRON PINS SHOWN HEREON WERE EITHER FOUND OR SET AS NOTED.

Harry Jones P.S.# 6343 DATE: 9/25/03

THE TOPOGRAPHY, INDICATED BY 1' CONTOURS, AND ELEVATIONS SHOWN HEREON REPRESENT AN ACTUAL FIELD SURVEY MADE BY William Babcock ON 9/24/03. THE ELEVATIONS WERE TAKEN AT APPROPRIATE INTERVALS AND AS OF THE ABOVE DATE THEY EXISTED AS INDICATED HEREON.

Harry Jones P.S.# 6343 DATE: 9/25/03

Stormwater Management Plan
Approved as shown and/or noted
JAMES R. GILLS, P.E.
County Drainage Engineer
By GJH Date 10/15/03

APPROVED
CT CONSULTANTS, INC.
Philip W. Kifer 10-10-03
CITY ENGINEER DATE

BM TOP OF FIRE HYDRANT
ELEV-1089.84

CURVE	LENGTH	RADIUS	TANGENT	CHORD	BEARING	DELTA
C1	13.44	530.00	6.72	13.44	N08°02'42"W	D1°27'11"
C2	41.51	50.00	22.04	40.33	N31°08'14"W	47°34'18"
C3	86.42	83.00	47.59	82.57	N25°03'42"W	59°39'20"

EXISTING UTILITIES NOTE:
THE SIZE AND LOCATION, BOTH HORIZONTAL AND VERTICAL, OF THE UNDERGROUND UTILITIES SHOWN HEREON, HAVE BEEN OBTAINED BY A SEARCH OF AVAILABLE RECORDS. VERIFICATION BY FIELD OBSERVATION HAS BEEN CONDUCTED WHERE PRACTICAL. HOWEVER, BABCOCK, JONES AND ASSOCIATES, INC. DOES NOT GUARANTEE THE COMPLETENESS NOR ACCURACY THEREOF.



REV NO.	DESCRIPTION	DATE	BY	CHK'D

bj BABCOCK, JONES AND ASSOCIATES, INC.
CIVIL ENGINEERS - SURVEYORS - LAND PLANNERS
PAINESVILLE OHIO 44077

DATE 9/25/03
DESIGN BY HJ
DRAWN BY NS
APPROVED BY HJ

SITE PLAN
FOR
ALEXANDRA FINE HOMES INC.
S/L 17 SHETLAND COURT ROCKING HORSE SUBDIVISION
CITY OF KIRTLAND LAKE COUNTY STATE OF OHIO

SCALE 1"=30'
JOB NO. 98-061-17
SHEET 1 OF 1