

**Grading Plan Approved  
as shown and/or noted  
THOMAS P. GILLES, P.E.  
Lake County Engineer**

~~TAN~~ Date 9/7/99  
 Lower FG TO 1148.5  
 Swale as shown

REVIEWED AND ACCEPTED  
LAKE COUNTY GENERAL  
HEALTH DISTRICT


Date 8-31-99 by David B Norris

**SEWAGE DISPOSAL PERMIT MUST BE OBTAINED BY A LAKE COUNTY LICENSED INSTALLER BEFORE INSTALLATION IS STARTED.**

LEROY TOWNSHIP  
 Zoning Approve:  
 # 7693  
 [Signature]  
 Zoning Inspector

**AUG 27 1999**

## LEGEND

- 
  - EX. LIGHT POLE
  - EX. CROWN SILET BASIN
  - EX. SIGN
  - EX. UTILITY POLE
  - EX. WATER LINE VALVE
  - EX. HYDRANT
  - EX. MAILBOX
  - EX. TREE
  - EX. ELEC. CONN.
  - EX. PHONE CONN.
  - EX. STO. / SAN. CONN.



## CERTIFICATION

"I THE UNDERSIGNED HEREBY CERTIFY THAT THIS TOPOGRAPHY INDICATED BY 11-0" CONTOURS AND ELEVATIONS SHOWN HEREON REPRESENTS AN ACTUAL FIELD SURVEY MADE BY GREENLAND CONSULTING INC., UNDER THE SUPERVISION OF BRUCE R. LANDES, P.S. No. 7465 ON THE 5TH DAY OF AUGUST 1999 AND THAT THE ELEVATIONS WERE TAKEN AT APPROPRIATE INTERVALS AND THAT AS OF THAT DATE THEY EXISTED AS INDICATED HEREON."

THIS PLAN WAS PREPARED BY ME AND I CERTIFY IT TO BE  
ACCURATE TO THE BEST OF MY KNOWLEDGE AND BELIEF.

SEE BUILDER'S PLAN FOR COMPLETE HOUSE DETAILS AND DIMENSIONS.

DOWNSPOUTS TO BE SPLASHBLOCKS.

Bruce R. Landes  
BRUCE R. LANDES


8-26-98  
DATE



SITUATED IN THE TOWNSHIP OF LEROY,  
COUNTY OF LAKE, AND STATE OF  
OHIO AND KNOWN AS A PART OF OF  
ORIGINAL LEROY TOWNSHIP.

SITE PLAN FOR S/L 28 OF  
 THE HIGHLAND TRAIL SUBDIVISION (VOL. 24 PG. 25)  
 PREPARED FOR: ANDREW GIANFAGNONE BUILDERS  
 14354 PAINVILLE WARREN ROAD  
 PAINVILLE, OHIO 44624

**GRAPHIC SCALE**

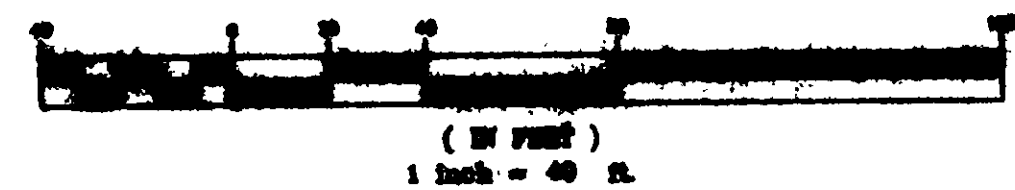

**Greenland Consulting, Inc.**  
 Planning - Engineering - Construction Management  
 6520 Brighton Beach Boulevard, O.E. 44000  
 Phone: (214) 345-6167 Fax: (214) 345-1057