

SITE PLAN

LEROY TOWNSHIP, LAKE COUNTY, OHIO

for:

CLIENT: TOM AUSTRAL
OWNER: PAINESVILLE
ADDRESS: 340 MEMPHIS DR. PAINESVILLE
CITY: PAINESVILLE
STATE: OHIO
ZIP: 44061

SUBDIVISION: VOL. - PG. NAME: LOT: TRACT: PAGE: 1 OF 1
SUBLOT NO.: STREET: PERM. PARCEL NO.: STREET: CITY: STATE: ZIP:

LEGEND

SANITARY MANHOLE: WATER VALVE (GAS)
STORM MANHOLE: WATER METER (GAS)
INLET OR CATCH BASIN: AS BUILT ELEVATION
HYDRANT: INDICATES DIRECTION OF SURFACE DRAINAGE
EXISTING CONTOURS: 100.0, 100.0, 100.0, 100.0
PROPOSED CONTOURS: 100.0, 100.0, 100.0, 100.0
EXIST. ELEV.: 100.0, 100.0, 100.0, 100.0
PROP. ELEV.: 100.0, 100.0, 100.0, 100.0

REMARKS

ALL BOUNDARY DATA SHOWN WAS OBTAINED FROM IDEEDS, RECORDED
SUBDIVISION PLAT OR OTHER PUBLIC RECORDS
LOCATIONS AS SHOWN OF ADJACENT WELLS AND SEPTIC TANKS OBTAINED FROM
LAKE COUNTY HEALTH DEPARTMENT

DESIGN CERTIFICATION

THIS PLAT WAS PREPARED BY ME, AND IS CORRECT
TO THE BEST OF MY KNOWLEDGE AND BELIEF.

NAME: SURVEYOR: REGISTRATION NO.:

CHECK LIST

NO. OF BEDROOMS: WATER MAIN SIZE, LOCATION
DIMENSIONS: SAN. SEWER SIZE, GR. LOC.
BEARINGS: SAN. MH. CAST ELEV. INV. ELEV.
TIE TO NEAREST STREET: SAN. CONN. SIZE, LOC. DEPTH
SUBLOT NO. PARCEL NO.: STORM SEWER SIZE, GR. LOC.
SURROUNDING OWNERS: STORM SEWER SIZE, GR. LOC.
BLDG. TIE P.L.R. GRADES: PAV. TYPE GRADE CURBS
SIDEWALK TYPE WIDTH THICKNESS: GAS LINE LOC. SIZE PRESSURE
SEPTIC TANK LOCATION & DUPLICATION AREA
CULVERT TYPE DIA. LENGTH: WELL LOCATION
ROCK OUTCROPPINGS: ISOLATION RADIUS FROM WELL

PLAN PREPARED BY:

BABCOCK • JONES & ASSOCIATES, INC.
PAINESVILLE OHIO

NO.	DATE	BY
1		
2		
3		
4		
5		
6		

DRAWN BY: JH	SCALE: 1" = 30'	PHONE NO.: 357-1811
CHK'D: JH	DATE: 6/10/84	DRAWING NO.: 357-1811
CREW: JH	APP'D: JH	DATE: 6/10/84

"AS BUILT" CERTIFICATION

I, HEREBY CERTIFY THAT THE CIRCLED GRADES ARE EXISTING
FINISH GRADES CHECKED IN THE FIELD ON 19
AND ARE CORRECT TO THE BEST OF MY KNOWLEDGE AND BELIEF.


REGISTERED SURVEYOR

LEROY TOWNSHIP

REG. NO.

Zoning Approved: 6-7-84

Zoning Inspector: [Signature]

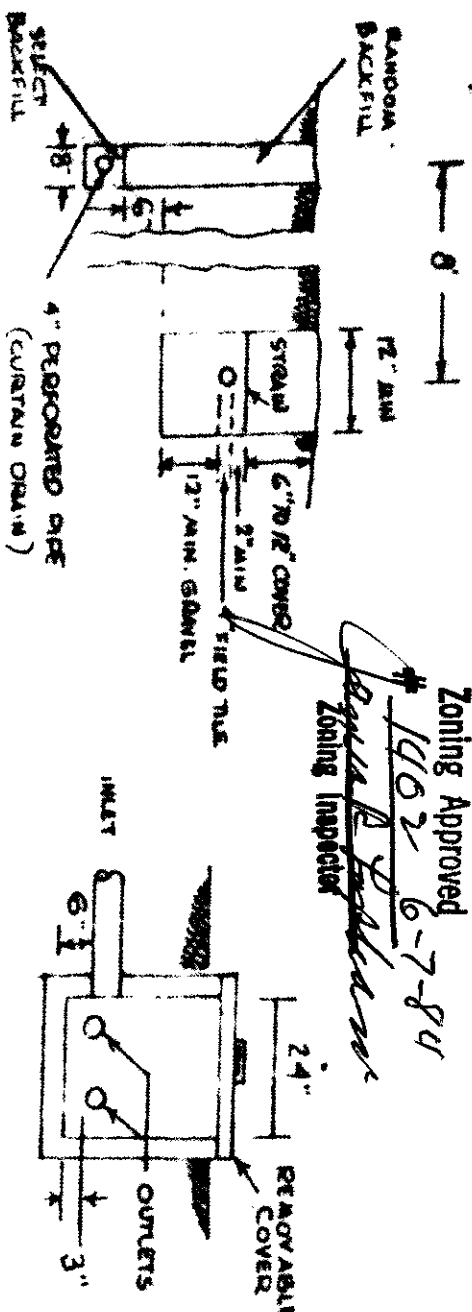

LEACHING TILE FIELD

WITH CURTAIN DRAIN

