
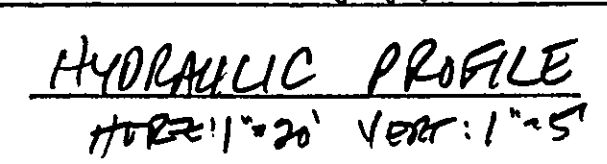
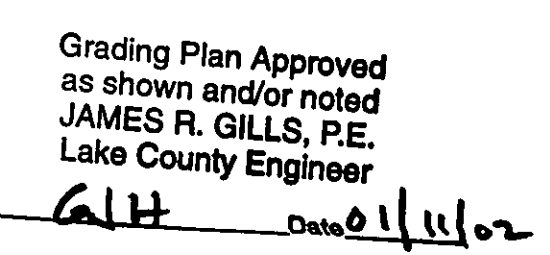


CL

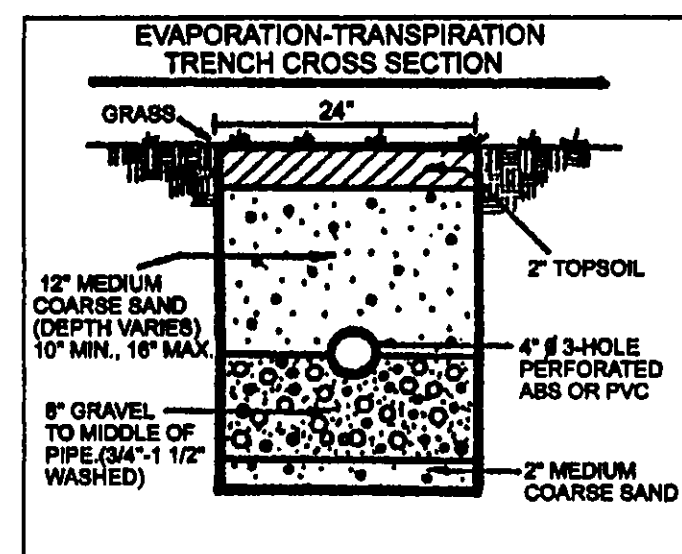

Name Harry Jones Reg. No. #6343

LAKE COUNTY