
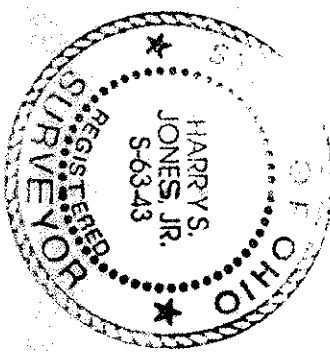
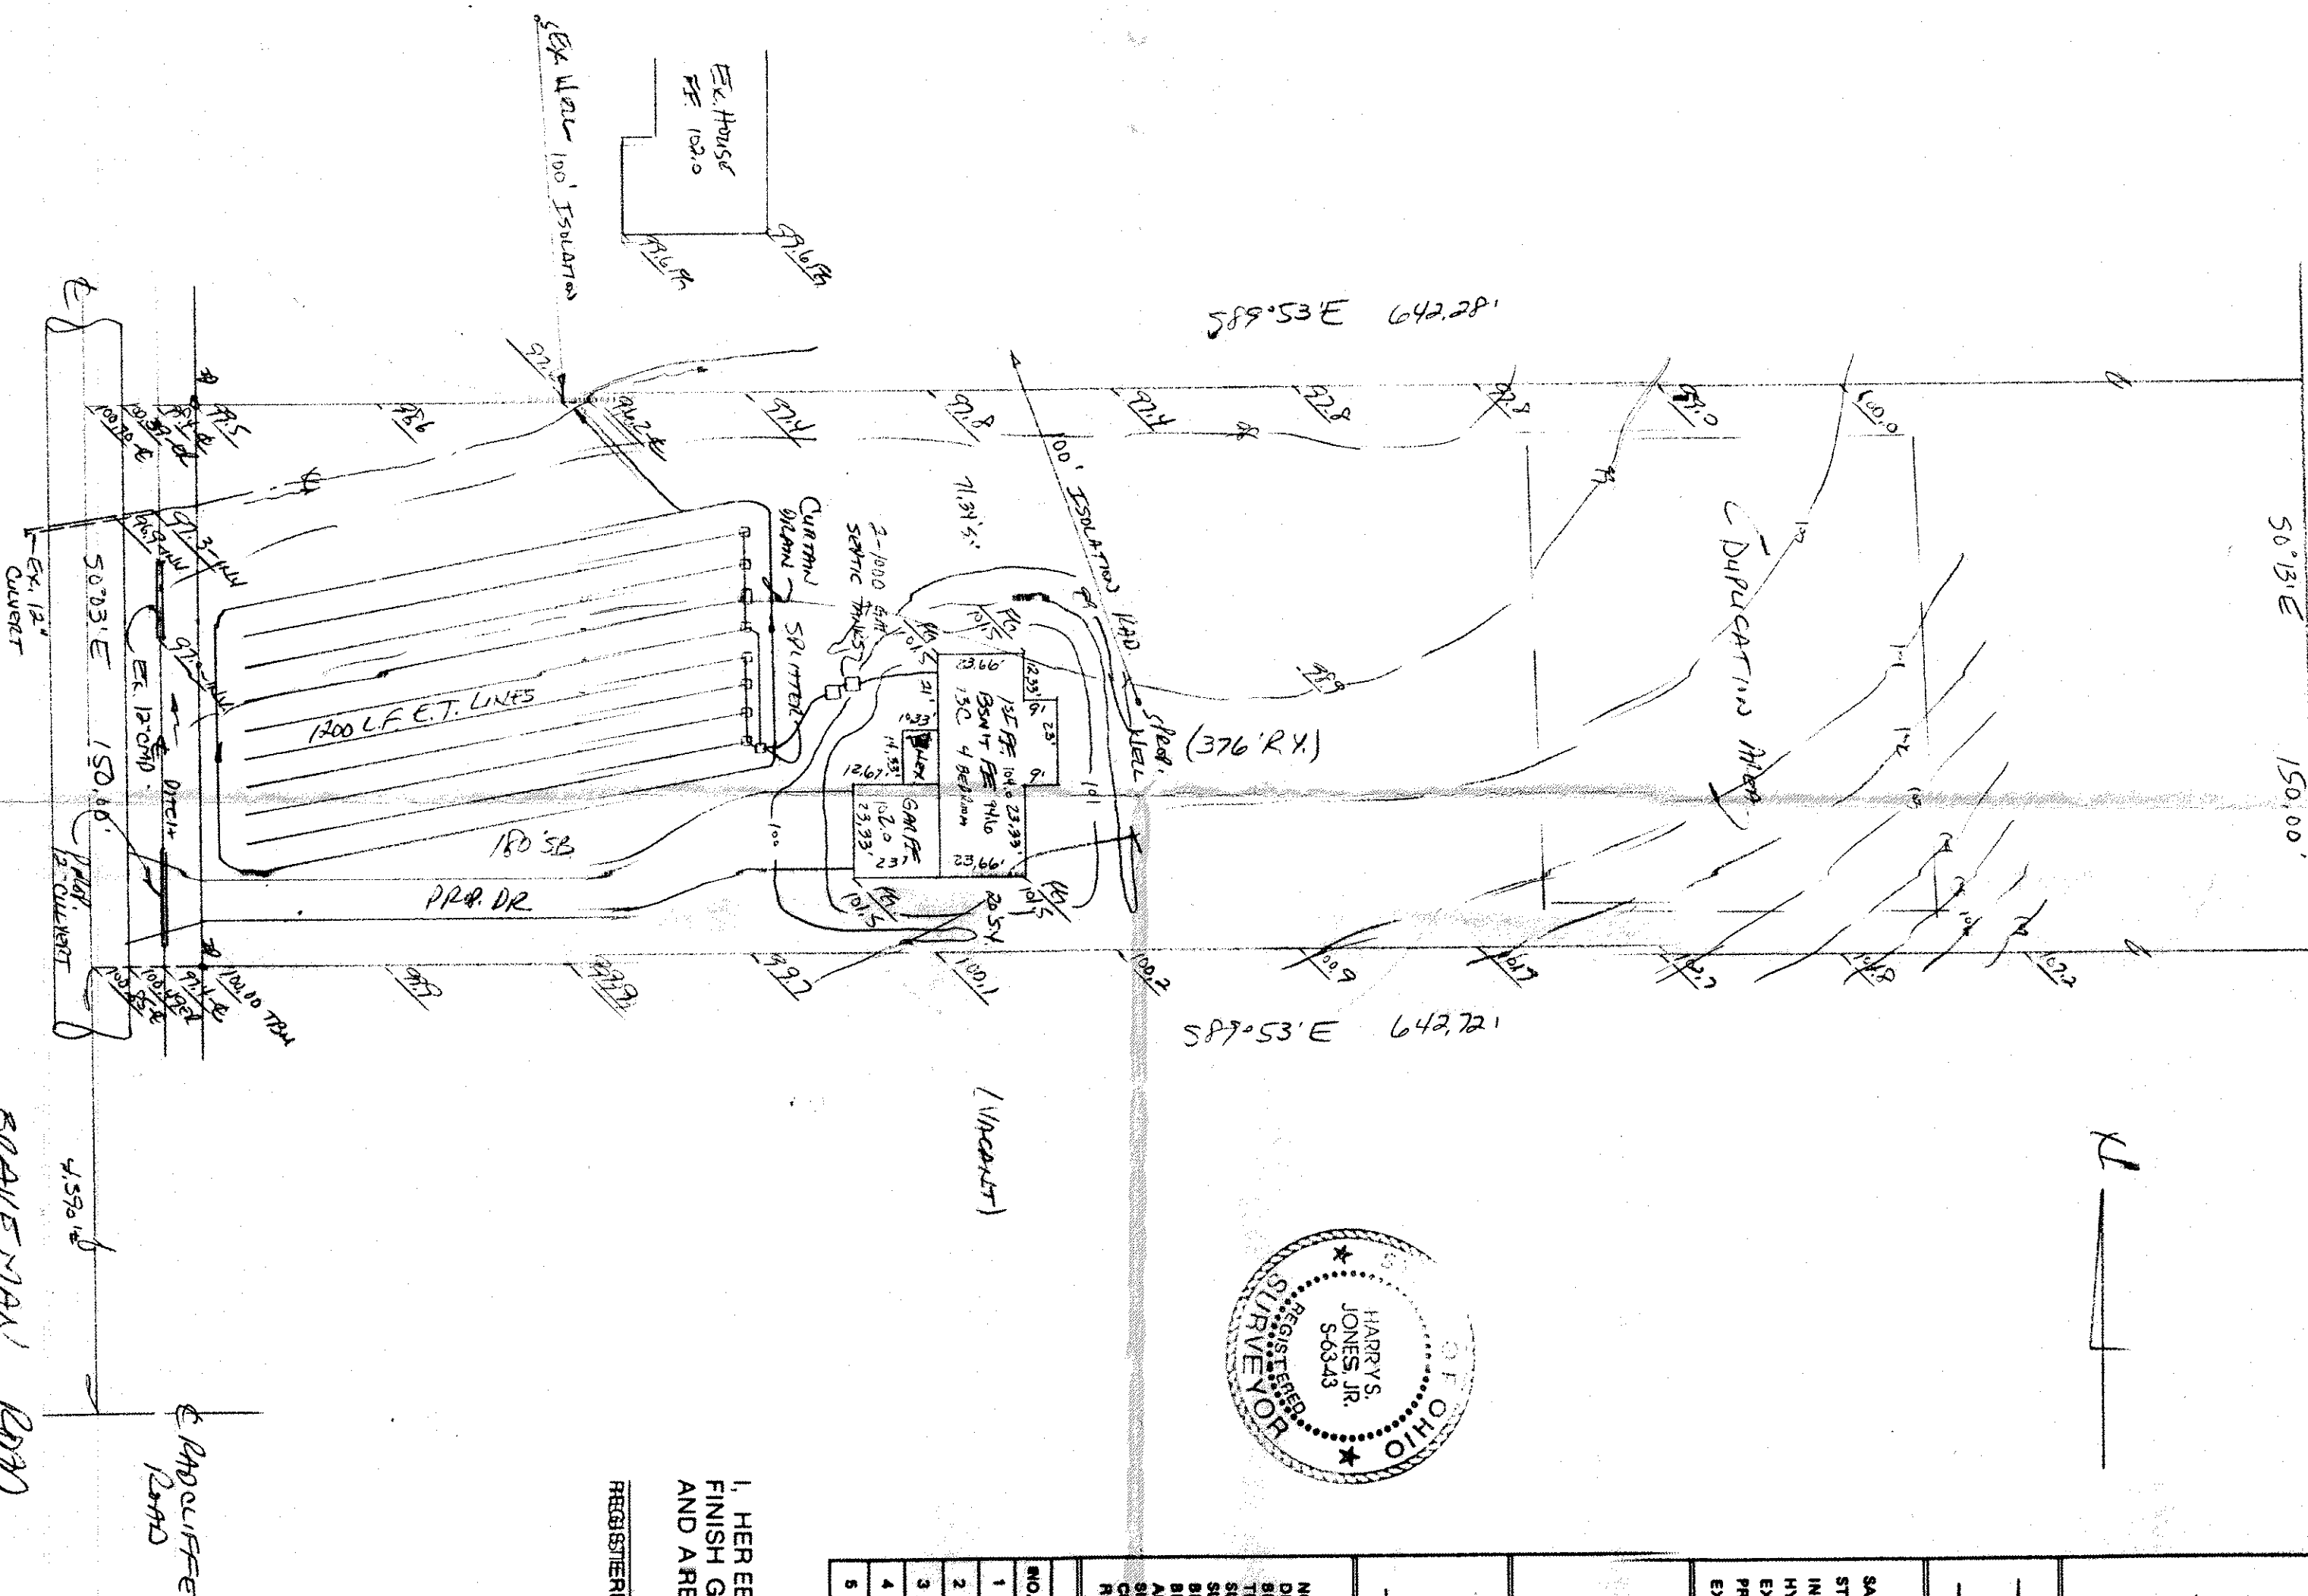
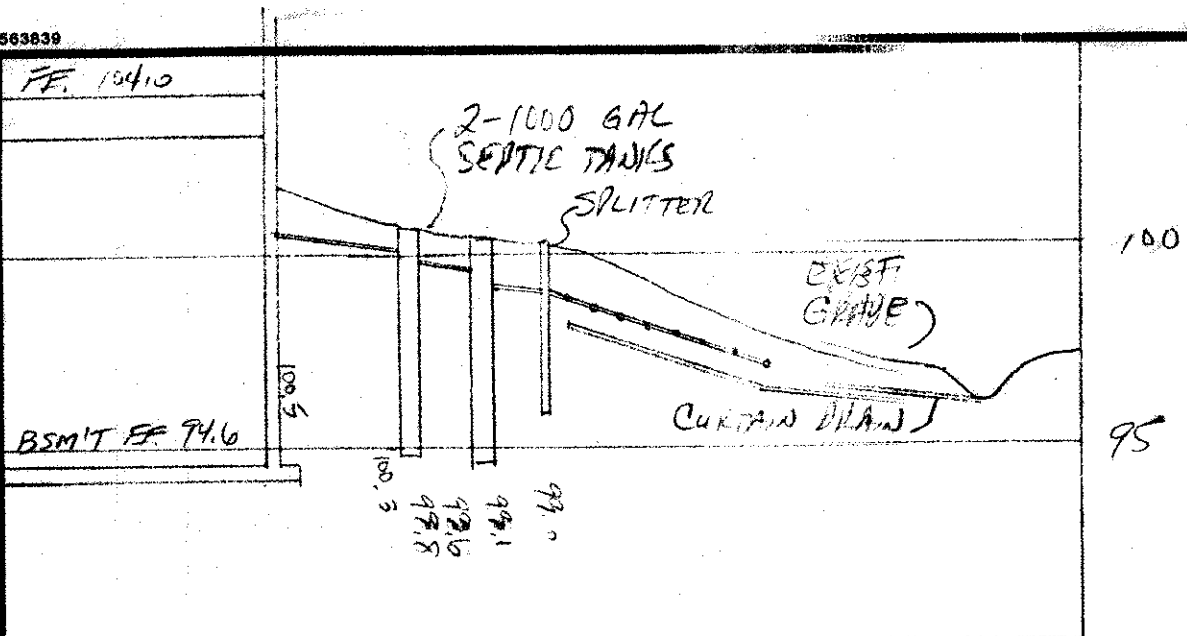


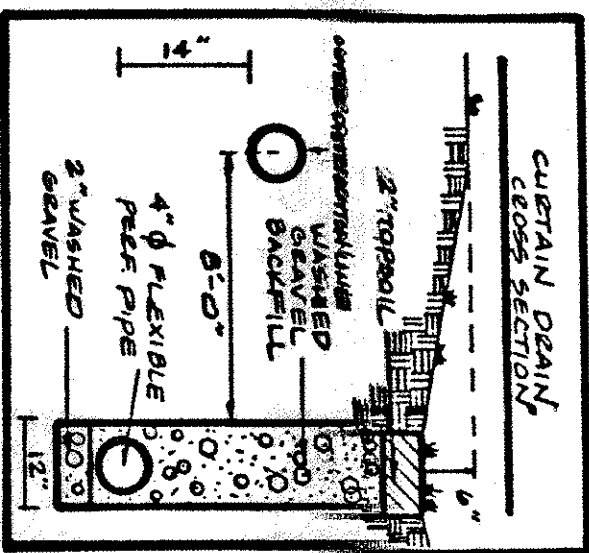

LEBOY TOWNSHIP, LAKE COUNTY, OHIO

for: Mr. Verlic
CLIENT

[illegible]

SUBDIVISION	NAME	VOLUME	PAGE
VOL - PG			

SUBLOT NO.	STREET	PERM. PARCEL NO.	STREET

SANITARY MANHOLE ①
 STORM MANHOLE ②
 INLET OR CATCH BASIN
 HYDRANT
 EXISTING CONTOURS
 PROPOSED CONTOURS
 EXIST. ELEV. 100.0
 PROP. ELEV. 100.0

WATER VALVE (GAS)
 WATER METER (GAS)
 AS BUILT ELEVATION

INDICATES
 DIRECTION OF
 SURFACE DRAINAGE

100.0

SANITARY MANHOLE --- ①
STORM MANHOLE --- ●
INLET OR CATCH BASIN --- □
HYDRANT --- ⊕
EXISTING CONTOURS ---
PROPOSED CONTOURS ---
EXIST. ELEV. --- 100.0
PROP. ELEV. ---

WATER VALVE (GAS) --- +
WATER METER (GAS) ---
AS BUILT ELEVATION ---

INDICATES DIRECTION OF SURFACE DRAINAGE

100.0

ALL BOUNDARY DATA SHOWN WAS OBTAINED FROM (DEEDS, RECORDED SUBDIVISION PLAT OR OTHER PUBLIC RECORDS)

LOCATIONS AS SHOWN OF ADJACENT WELLS AND SEPTIC TANKS OBTAINED FROM LAKE COUNTY HEALTH DEPARTMENT

ALL BOUNDARY DATA SHOWN WAS OBTAINED FROM (DEEDS, RECORDED SUBDIVISION PLAT OR OTHER PUBLIC RECORDS)

LOCATIONS AS SHOWN OF ADJACENT WELLS AND SEPTIC TANKS OBTAINED FROM LAKE COUNTY HEALTH DEPARTMENT

THIS PLAT WAS PREPARED BY ME, AND IS CORRECT
TO THE BEST OF MY KNOWLEDGE AND BELIEF.

NAME	SURVEYOR	REGISTRATION	NO.

NO. OF BEDROOMS	WATER MAIN SIZE, LOCATION
DIMENSIONS	SEWER SIZE % GR. LOC.
BEARINGS	SAN. MH. CAST. ELEV. INV. ELEV.
THE TO NEAREST STREET	SAN. CONN. SIZE, LOC. DEPTH
SUBLOT NO. PARCEL NO.	STORM SEWER SIZE % GR. LOC.
SURROUNDING OWNERS	STORM MH. CAST. ELEV. INV. ELEV.
BLOG. DIMENSIONS FIN. GR.	PAV'T TYPE GRADE DE CURBS
BLOG. TIES FLTR. GRADES	GAS LINE LOC. SIZE PRESSURE
ANION TYPE WIDTH THICKNESS	SEPTIC TANK LOCATION & DUPLICATION AREA
THE WIDTH THICKNESS	WELL LOCATION
CULVERT TYPE DIA. LENGTH	ISOLATION RADIUS FROM WELL
ROCK OUTCROPPINGS	

NO. OF BEDROOMS	WATER MAIN SIZE, LOCATION
DIMENSIONS	SEWER SIZE % GR. LOC.
BEARINGS	SAN. MH. CAST. ELEV. INV. ELEV.
THE TO NEAREST STREET	SAN. CONN. SIZE, LOC. DEPTH
SUBLOT NO. PARCEL NO.	STORM SEWER SIZE % GR. LOC.
SURROUNDING OWNERS	STORM MH. CAST. ELEV. INV. ELEV.
BLOG. DIMENSIONS FIN. GR.	PAV'T TYPE GRADE DE CURBS
BLOG. TIES FLTR. GRADES	GAS LINE LOC. SIZE PRESSURE
ANION TYPE WIDTH THICKNESS	SEPTIC TANK LOCATION & DUPLICATION AREA
THE WIDTH THICKNESS	WELL LOCATION
CULVERT TYPE DIA. LENGTH	ISOLATION RADIUS FROM WELL
ROCK OUTCROPPINGS	

BARBOCK • JONES & ASSOCIATES, INC.

PAINESVILLE, OHIO

DRAWN BY	SCALE	PHONE NO.
15	4" = 15'	257-10

CHK'D.	DATE	DRAWING NO.
1/5	9/10/91	037-10

CREW	17	11/17	95-180
APP'D.	17	11/17	95-180

CHIEF	✓	✓	✓	✓
-------	---	---	---	---

"AS BUILT" CERTIFICATION

I, HEREBY CERTIFY THAT THE CIRCLED GRADES ARE EXISTING
FINISH GRADES CHECKED IN THE FIELD ON _____, 19____,
AND ARE CORRECT TO THE BEST OF MY KNOWLEDGE AND BELIEF.

REGISTERED SURVEYOR **REG. NO.**

THM - TOP OF IRON AND
C.S.W. COVER
ELEV. = 100.00

"I, the undersigned hereby certify that this topography indicated by 6", 1 or 2" contours, and elevations shown hereon represent an actual field survey made by me on the 10th day of Sept, 1984 and that the elevations were taken at appropriate intervals and that as of that date they existed as indicated hereon."

#6343
 100J. No. 100J. No.