

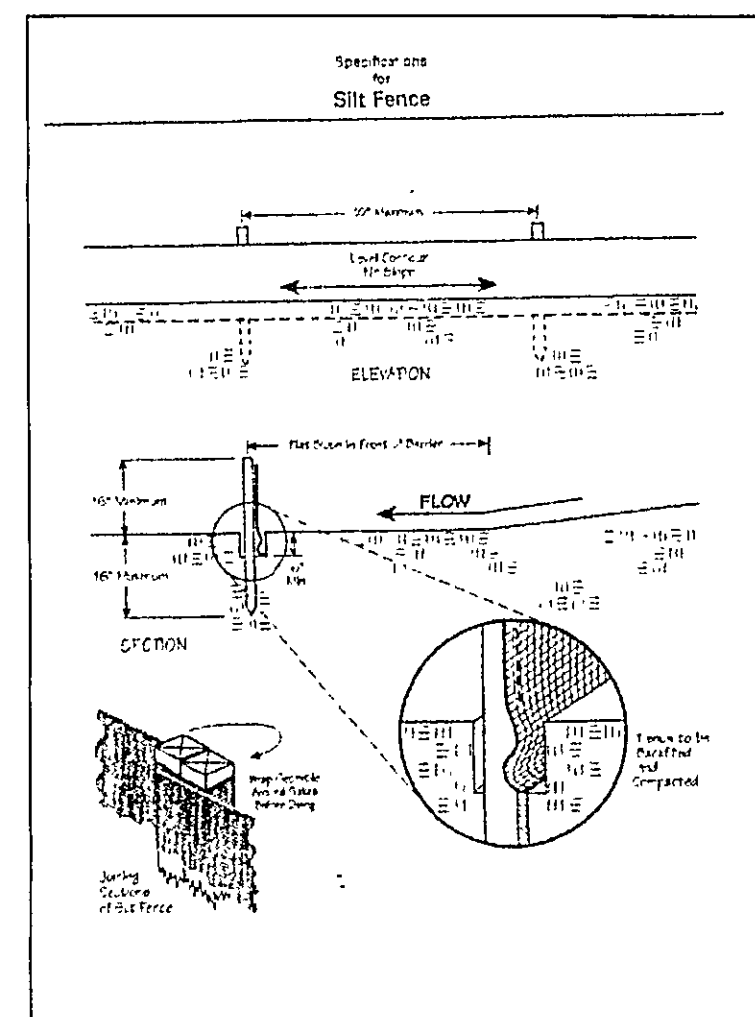
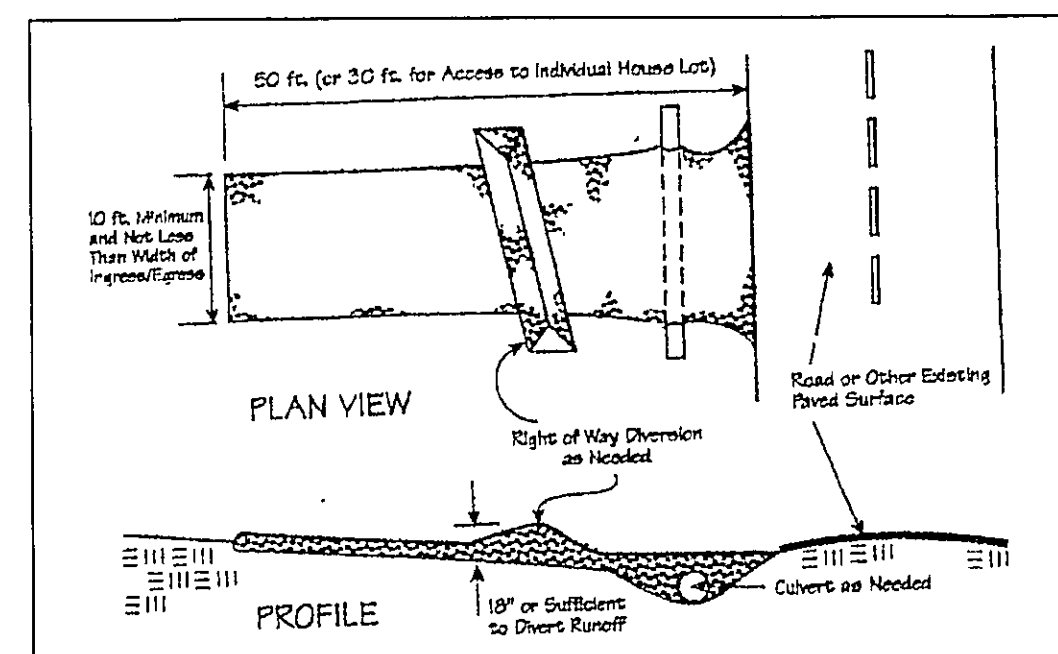
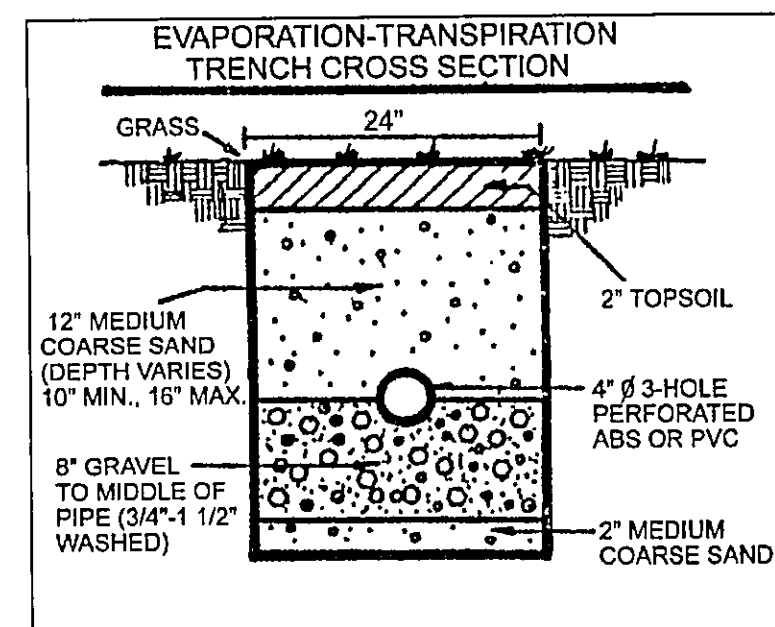


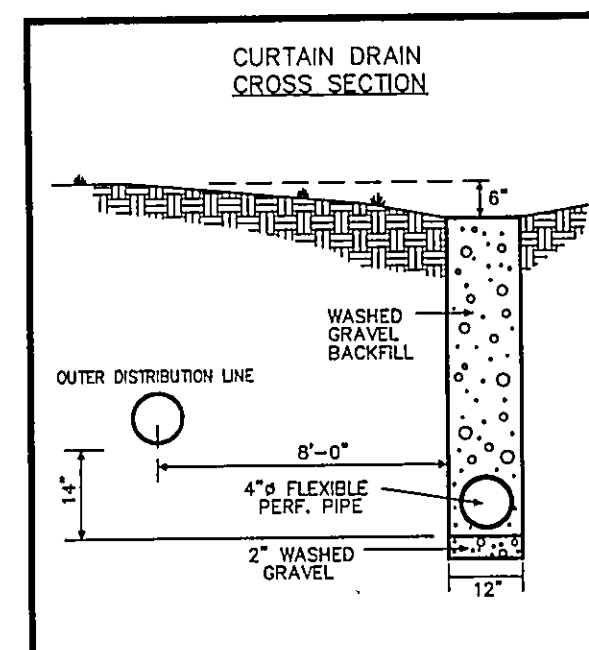

Temporary Seeding Species Selection			
Seeding Dates	Species	Lb./1,000 ft. ²	Per Ac.
March 1 to August 15	Oats	3	4 bushel
	Tall Fescue	1	40 lb.
	Annual Ryegrass	1	40 lb.
	Perennial Ryegrass	1	40 lb.
August 16 to November 1	Rye	3	2 bushel
	Tall Fescue	1	40 lb.
	Annual Ryegrass	1	40 lb.
	Wheat	3	2 bushel
November 1 to Spring Seeding	Tall Fescue	1	40 lb.
	Annual Ryegrass	1	40 lb.
	Perennial Ryegrass	1	40 lb.
	Annual Ryegrass	1	40 lb.

Note: Other approved seed species may be substituted.

RECEIVED AND ACCEPTED
LAKES COUNTY GENERAL
HEALTH DISTRICT
Date 5-6-04
LARRY SLAPNICKER
SEWAGE DISPOSAL PERMIT MUST BE
OBTAINED BY LAKES COUNTY LICENSED
INSTALLER BEFORE INSTALLATION IS
STARTED

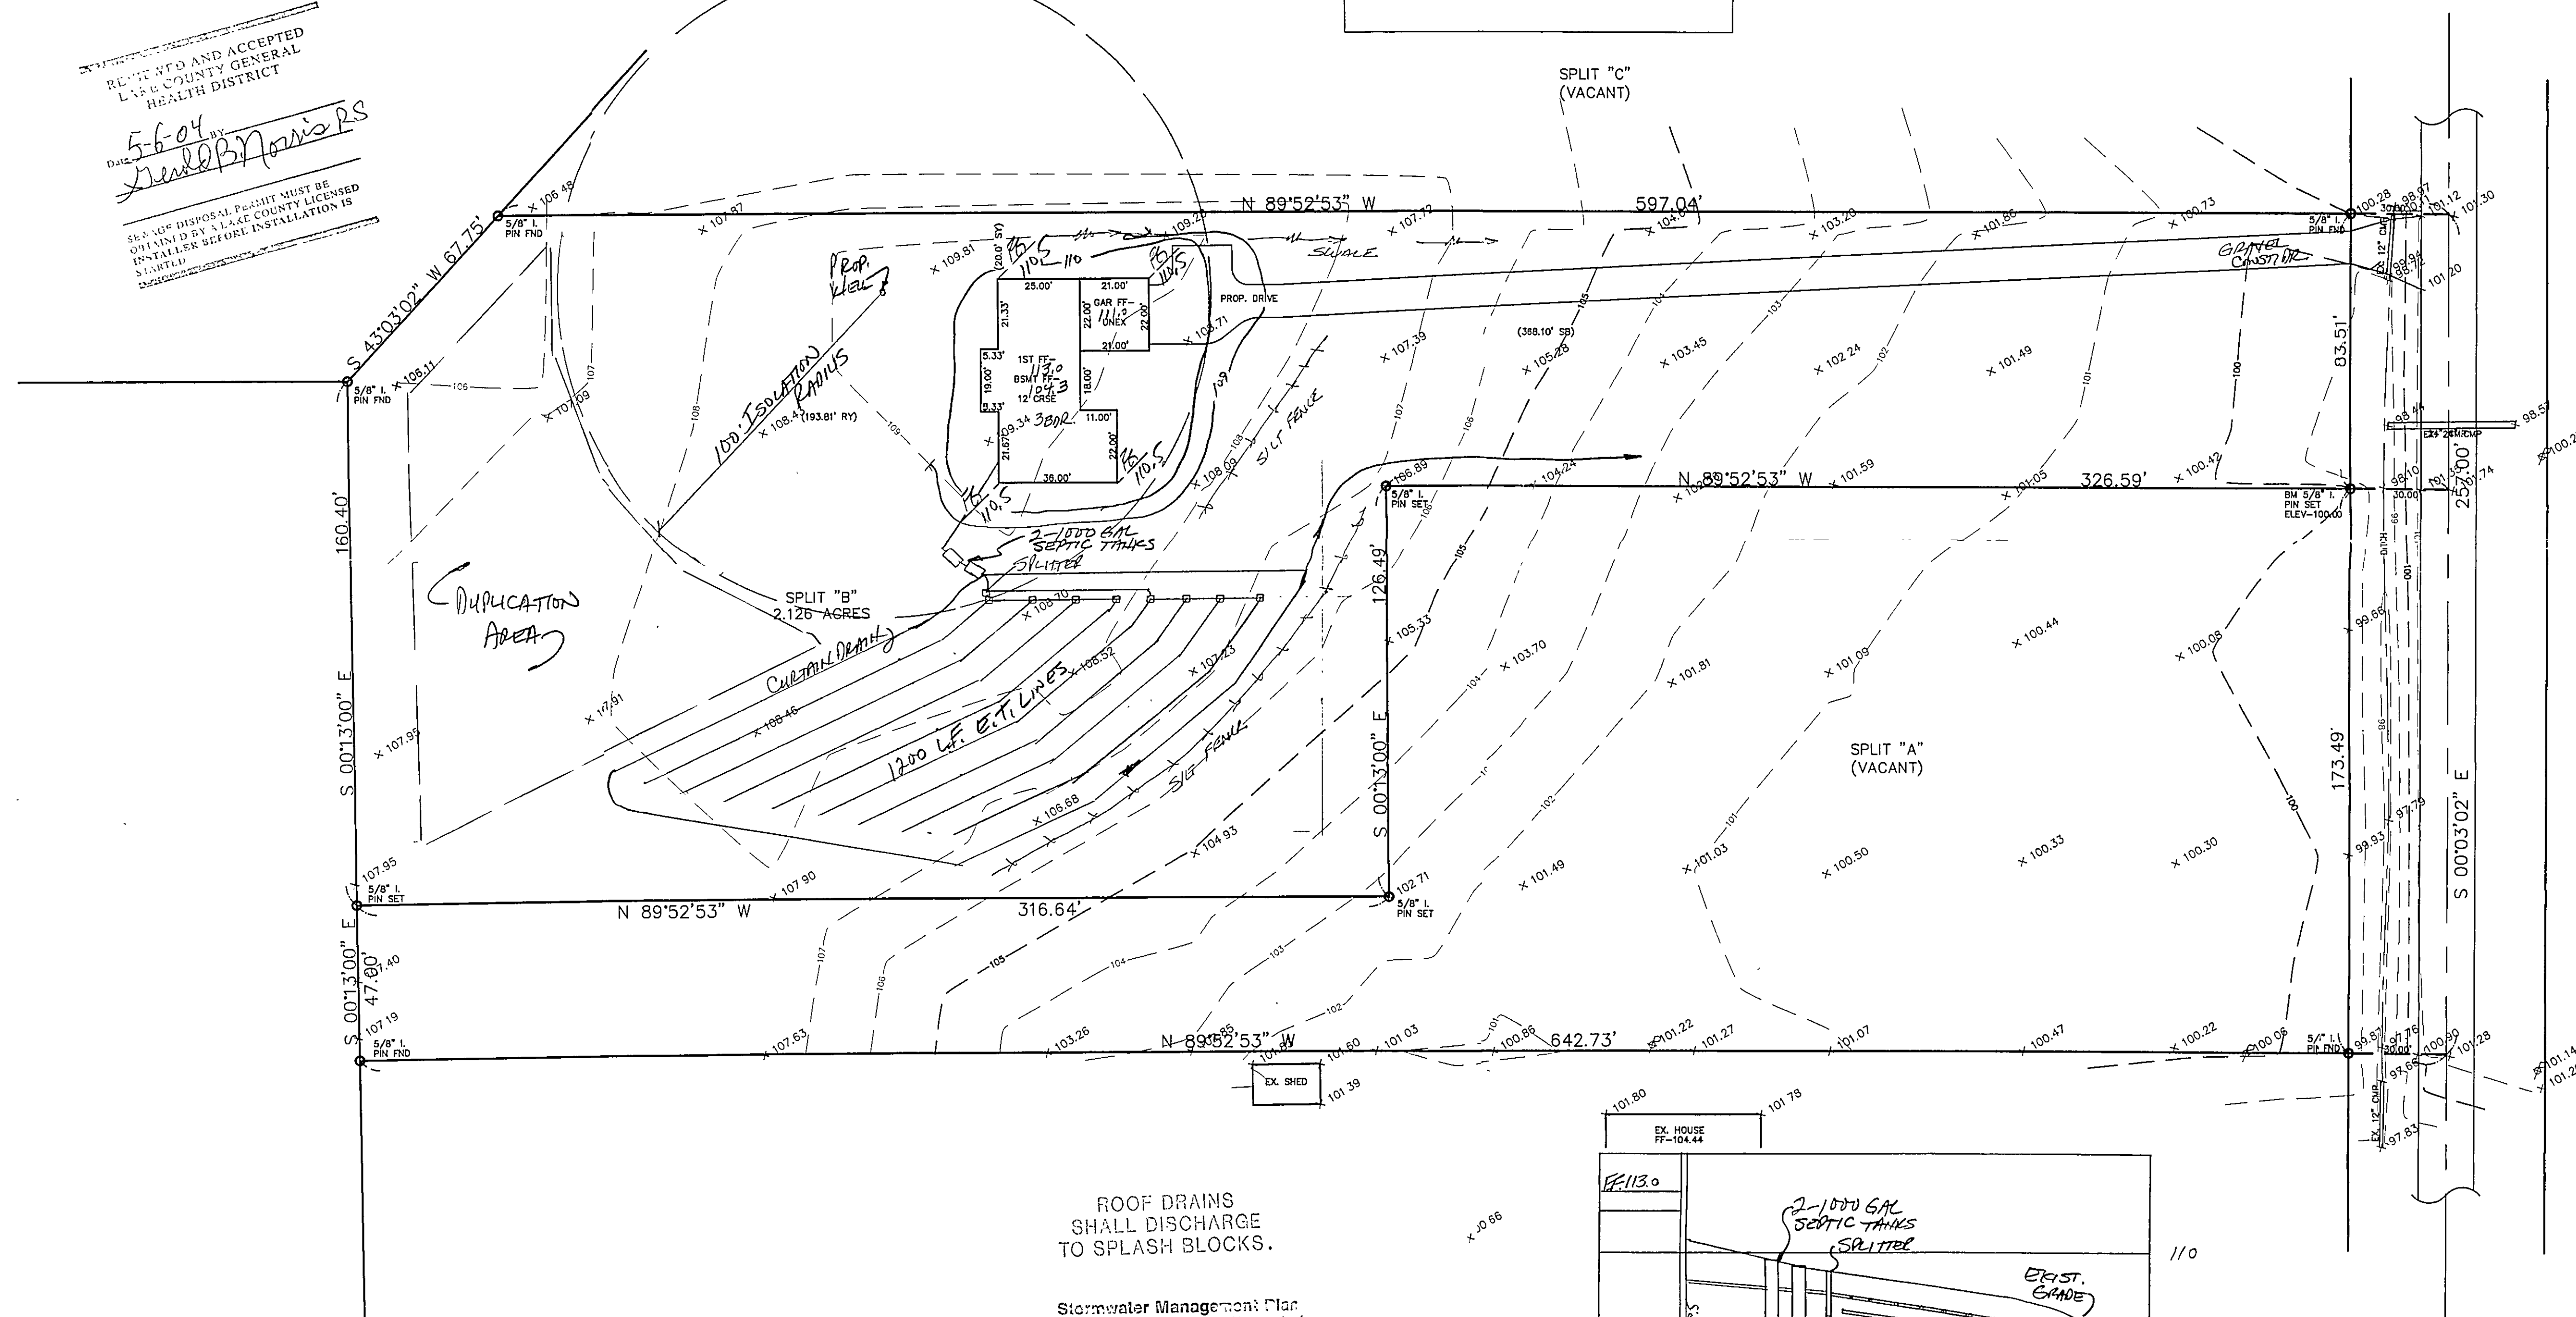

This project is exempt from
ESC Plan Review
Date 4-28-04
Lake SWCD

"I, the undersigned hereby certify that
this topography indicated by 6", 1" or 2"
contours, and elevations shown hereon
represent an actual field survey made by
me on the 22nd day of June, 2004,
and that the elevations were taken at
appropriate intervals and that as of that
date they existed as indicated hereon."


Name: Larry Slapnick
Reg. No. 26343

TBM 5/8" IRON PIN SET
ELEV=100.00


ROOF DRAINS
SHALL DISCHARGE
TO SPLASH BLOCKS.

Stormwater Management Plan
Approved as shown and/or noted
JAMES R. GILLS, P.E.
County Drainage Engineer
By: L.S. Date: 6/2/04

NOTE: ALL IRON PINS SET ARE
5/8" X 30" AND CAPPED
BABCOCK, JONES & ASSOC.

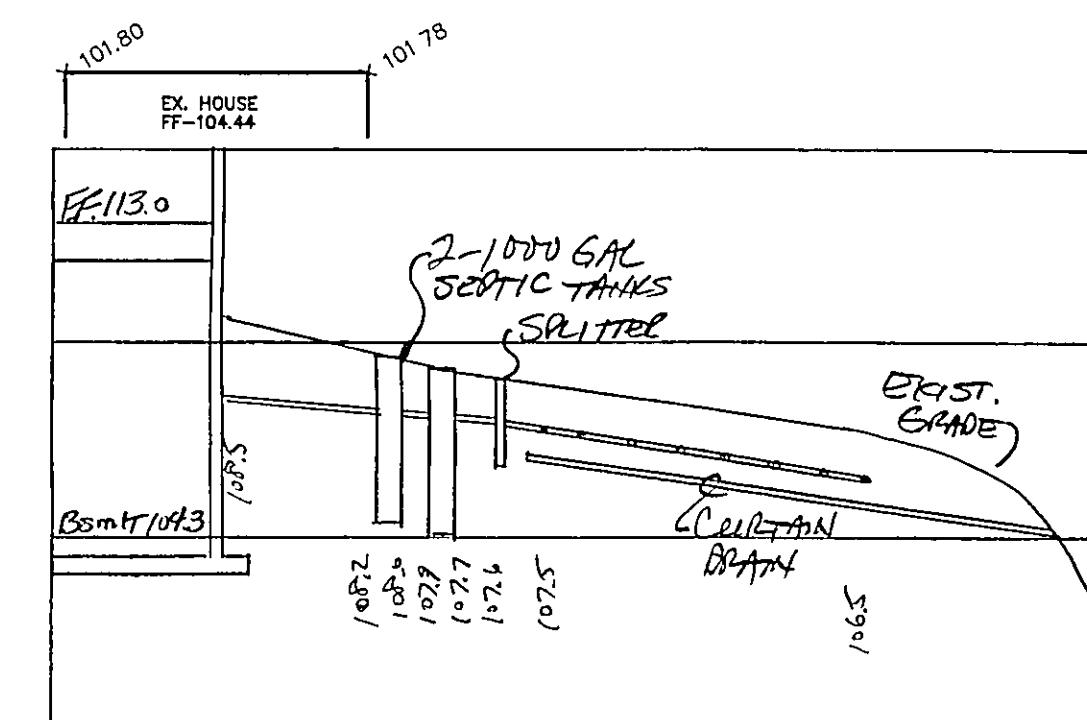

EXISTING UTILITIES NOTE:
THE SIZE AND LOCATION, BOTH HORIZONTAL AND VERTICAL
OF THE UNDERGROUND UTILITIES SHOWN HEREON, HAVE BEEN
OBTAINED BY A SEARCH OF AVAILABLE RECORDS.
VERIFICATION BY FIELD OBSERVATION HAS BEEN CONDUCTED
WHERE PRACTICAL, HOWEVER, BABCOCK, JONES & ASSOCIATES
INC. DOES NOT GUARANTEE THE COMPLETENESS NOR ACCURACY
THEREOF.

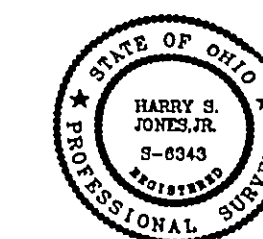

REV. NO.	DESCRIPTION	DATE	BY	CHK'D



BABCOCK, JONES AND ASSOCIATES, INC
CIVIL ENGINEERS - SURVEYORS - LAND PLANNERS
PAINESVILLE OHIO 44077
PHONE: 440-357-1811 FAX: 440-357-9173

DATE	6/27/04
DESIGN BY	HJ
DRAWN BY	NS
APPROVED BY	HJ

SITE PLAN
FOR
LARRY SLAPNICKER
SPLIT "B" BRAKEMAN ROAD
LEROY TOWNSHIP LAKE COUNTY STATE OF OHIO

SCALE	1"=30'
JOB NO.	90-156-B
SHEET	OF
1	1