

50' 00" W 150.00'

POL # 8
51.53 AC

SITE PLAN

LEROY TOWNSHIP, LAKE COUNTY, OHIO

FOR: Ken Hopper OWNER 861-0023 (C)

ADDRESS STREET CITY ZIP

SUBDIVISION VOL. PG. NAME LOT 7-7 VOLUME 1-1 TRACT 537/8209 AC B2

SUBLOT NO. STREET PERM. PARCEL NO. STREET

LEGEND

SANITARY MANHOLE WATER VALVE (GAS) WATER METER (GAS) AS BUILT ELEVATION HYDRANT EXISTING CONTOURS PROPOSED CONTOURS EXIST. ELEV. 100.0 PROP. ELEV. 100.0

REMARKS

ALL BOUNDARY DATA SHOWN WAS OBTAINED FROM IDEEDS, RECORDED SUBDIVISION PLAT OR OTHER PUBLIC RECORDS LOCATIONS AS SHOWN OF ADJACENT WELLS AND SEPTIC TANKS OBTAINED FROM LAKE COUNTY HEALTH DEPARTMENT

DESIGN CERTIFICATION

THIS PLAN, WAS PREPARED BY ME, AND IS CORRECT TO THE BEST OF MY KNOWLEDGE AND BELIEF.

NAME SURVEYOR REGISTRATION NO. 6393

CHECK LIST

NO. OF BEDROOMS DIMENSIONS SAN. SEWER SIZE, LOCATION, BEARINGS TIE TO NEAREST STREET, SUBLOT NO., PARCEL NO., SURROUNDING OWNERS, BLDG. DIMENSIONS FIN. OR BLDG. TIE F.L.R. GRADES APRON TYPE WIDTH THICKNESS SIDEWALK TYPE WIDTH THICKNESS ROCK OUTCROPPINGS

PLAN PREPARED BY: BABCOCK • JONES & ASSOCIATES, INC. PAINESVILLE, OHIO

NO.	DATE	BY
1		
2		
3		
4		
5		

"AS BUILT" CERTIFICATION

I, HEREBY CERTIFY THAT THE CIRCLED GRADES ARE EXISTING FINISH GRADES CHECKED IN THE FIELD ON 19

REGISTERED SURVEYOR REG. NO. 2159

LOU YIELD WATER FIXTURES REQUIRED ON ALL: Shower Head Toilet






"I, the undersigned hereby certify that this topography indicated by 6" 1' or 2" contours, and elevations shown hereon represent an actual field survey made by me on the 22 day of June, 1994 and that the elevations were taken at appropriate intervals and that as of that date they existed as indicated hereon."

THOMAS P. GILLES, P.E. Lake County Engineer

- A. To Be brought to finished grade
1. Septic tank manhole covers
 2. Splitter box cover
 3. Distribution box cover
- B. No footer drains or downspouts to be discharged into septic tanks
- C. All wastewater to be discharged into septic tanks

Reviewed and Accepted
LANE COUNTY GENERAL HEALTH DISTRICT
Date: 6-16-94
JOEL LUCIA R. S. M. P. H.
Health Commissioner
BY: J. Lindsey

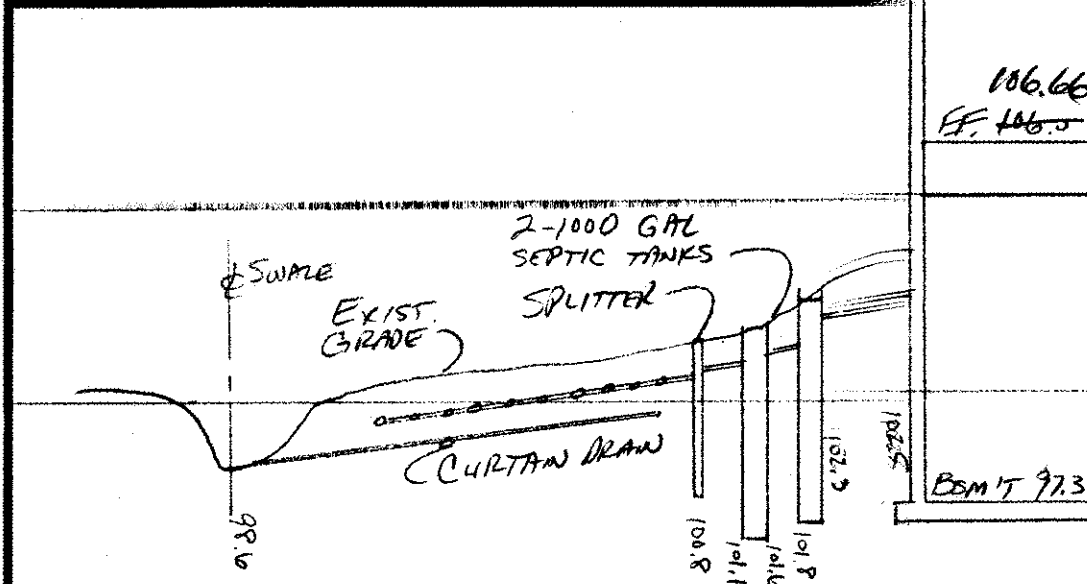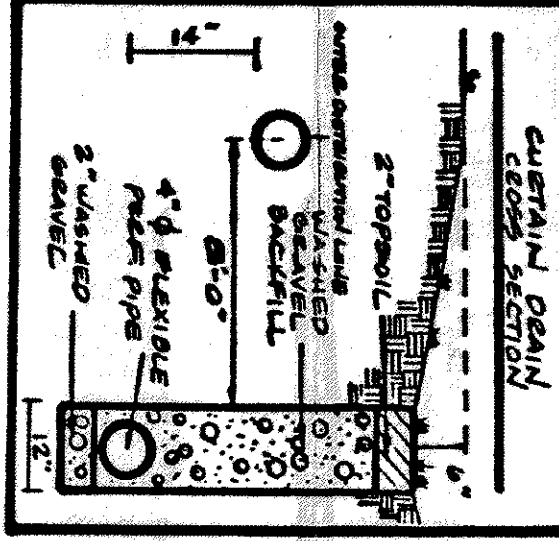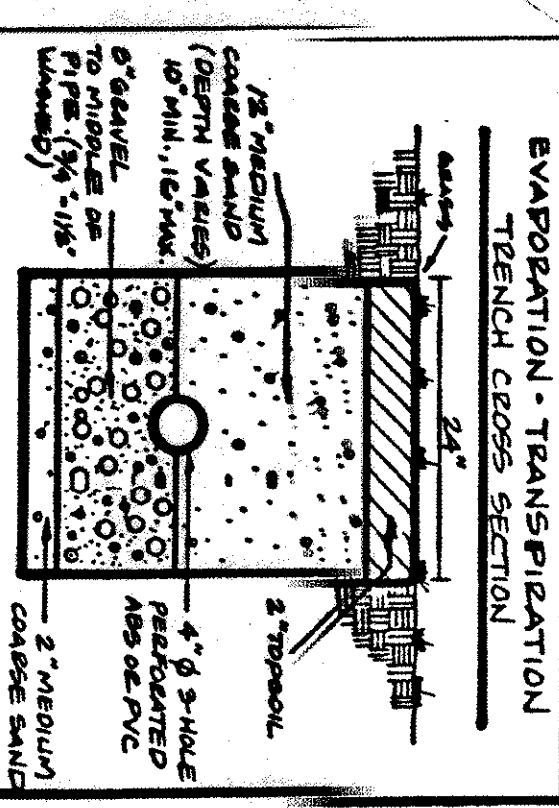

HYDRAULIC PROFILE
SCALE: HORIZ: 1"=40'
VERT: 1"=5'

BRALEMAN ROAD - 600'

By: 614 Date: 8/22/94