

SITE PLAN

LEBOY TOWNSHIP, LAKE COUNTY, OHIO

for: THOMAS ZABOSKY

ADDRESS STREET CITY ZIP

SUBDIVISION	NAME	LOT	TRACT
VOL. - PL.			
SUBLOT NO.	STREET	VOLUME	PAGE
		FINAL PARCEL NO.	BRACKETED NO.

SANITARY MANHOLE	WATER VALVE (GAS)
STORM MANHOLE	WATER METER (GAS)
INLET OR CATCH BASIN	AS BUILT ELEVATION
HYDRANT	INDICATES DIRECTION OF SURFACE DRAINAGE
EXISTING CONTOURS	
PROPOSED CONTOURS	
EXIST. ELEV.	PROF. ELEV.

REMARKS
ALL BOUNDARY DATA SHOWN WAS OBTAINED FROM (IDEOS, RECORDED SUBDIVISION PLAT OR OTHER PUBLIC RECORDS)
LOCATIONS AS SHOWN OF ADJACENT WELLS AND SEPTIC TANKS OBTAINED FROM LAKE COUNTY HEALTH DEPARTMENT


DESIGN CERTIFICATION
THIS PLAT WAS PREPARED BY ME, AND IS CORRECT TO THE BEST OF MY KNOWLEDGE AND BELIEF.
NAME: [Signature]
SURVEYOR REGISTRATION NO. 3

NO.	DATE	BY
1		
2		
3		
4		
5		

PLAN PREPARED BY:
BABCOCK • JONES & ASSOCIATES, INC.
PAINESVILLE, OHIO
PHONE NO. 367-1811
DRAWING NO. 90-156(a)
DATE 4-17-91
CHECKED BY: [Signature]
DRAWN BY: [Signature]
SCALE 1" = 40'

"AS BUILT" CERTIFICATION
I, HEREBY CERTIFY THAT THE CIRCLED GRADES ARE EXISTING FINISH GRADES CHECKED IN THE FIELD ON 19__
AND ARE CORRECT TO THE BEST OF MY KNOWLEDGE AND BELIEF.
REGISTERED SURVEYOR REG. NO. 175

SEWAGE DISPOSAL PERMIT MUST BE OBTAINED BY A LAKE COUNTY LICENSED INSTALLER BEFORE INSTALLATION IS STARTED.
B.M. TOP 1200 PIN SW CORNER PROP., ELEV. = 100.00

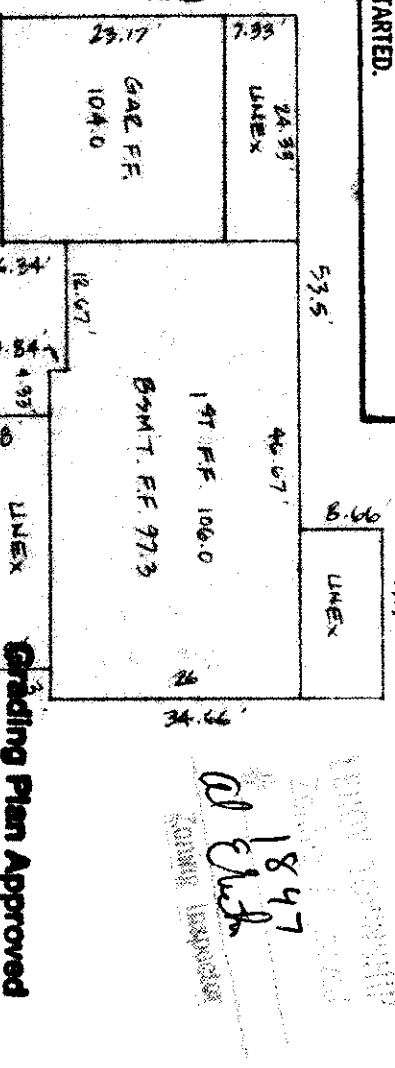

Grading Plan Approved
as shown and/or noted
THOMAS P. GILLES, P.E.
Lake County Engineer
Date 5/3/91
By: [Signature]
12" MINIMUM DRIVE
CULVERT.

