



ADJUST ALL BOXES, TANKS AND MANHOLES TO GRADE

* THE STANDARD ET TRENCH IS 24 INCHES HOWEVER THE TRENCH CAN VARY BETWEEN 18 INCHES TO 30 INCHES DEEP IF NECESSARY WHEN TRENCH DEPTH VARIES THE SAND AT THE TOP OF THE TRENCH WILL VARY FROM 10 TO 18 INCHES DEEP


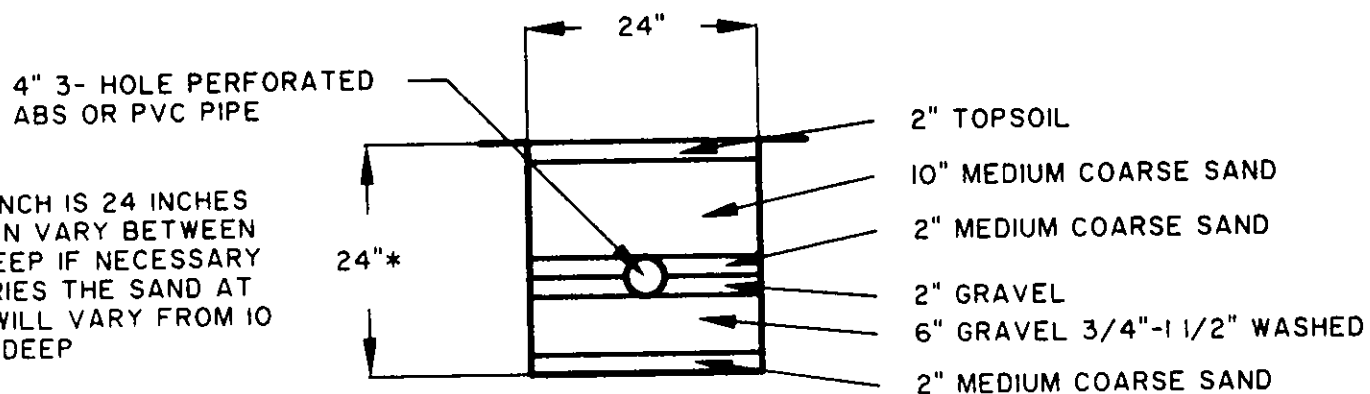


TYPICAL EVAPOTRANSPIRATION TRENCH CROSS SECTION

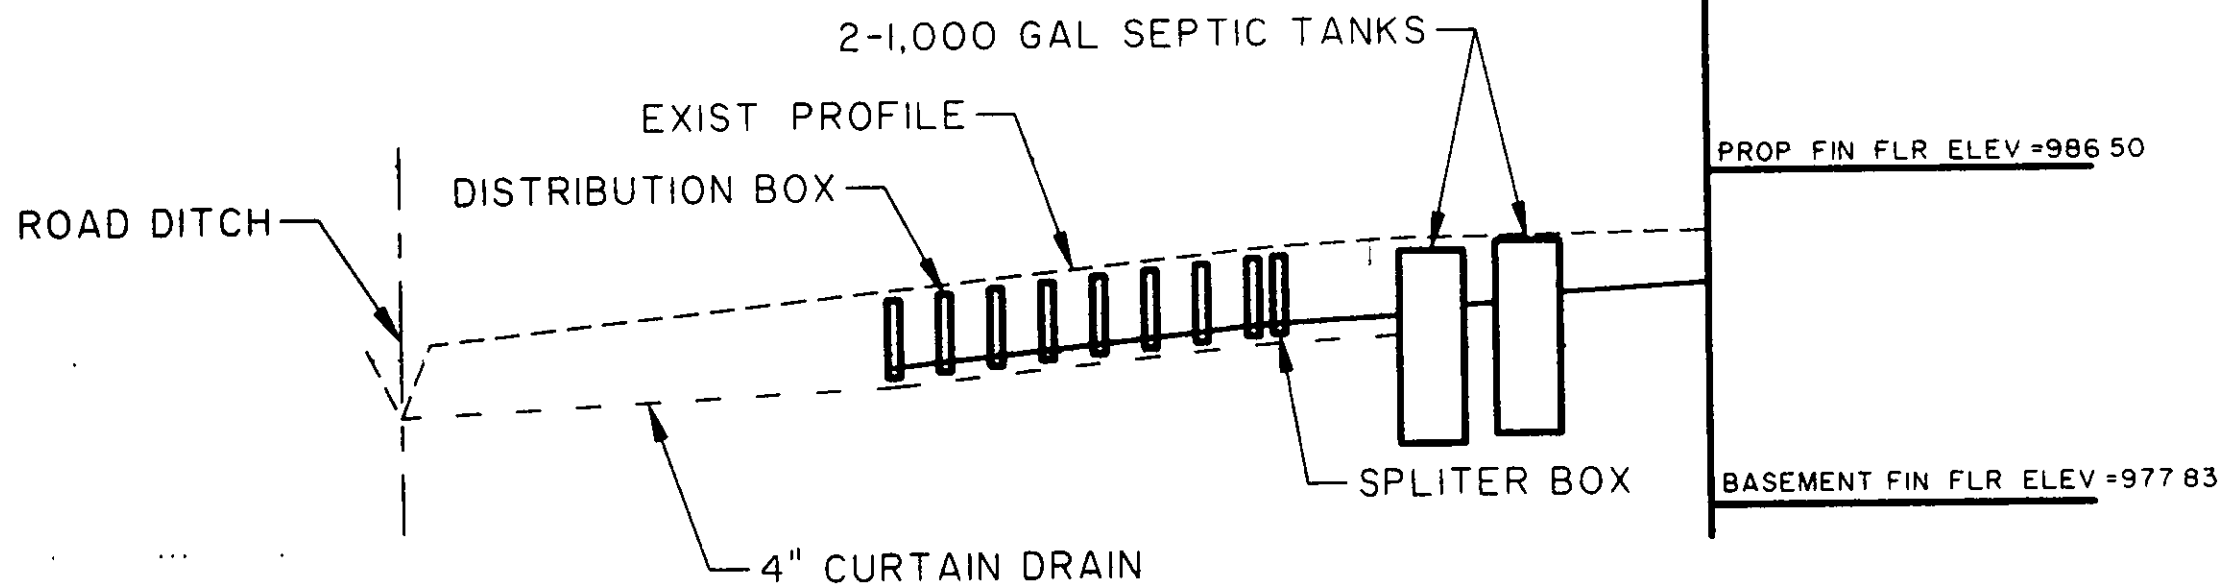


1000
995
990
985
980
975
970
965

REVIEWED AND ACCEPTED
LAKE COUNTY GENERAL
HEALTH DISTRICT
2/13/98 Dailal
well must be moved
SEWAGE DISPOSAL PERMIT MUST BE
OBTAINED BY A LAKE COUNTY LICENSED
INSTALLER BEFORE INSTALLATION IS
STARTED.

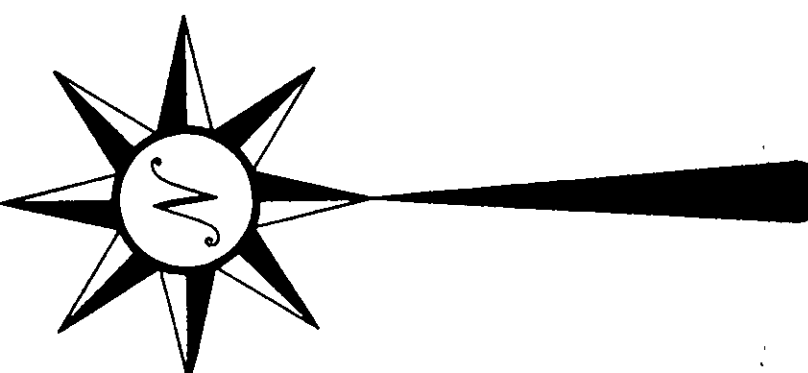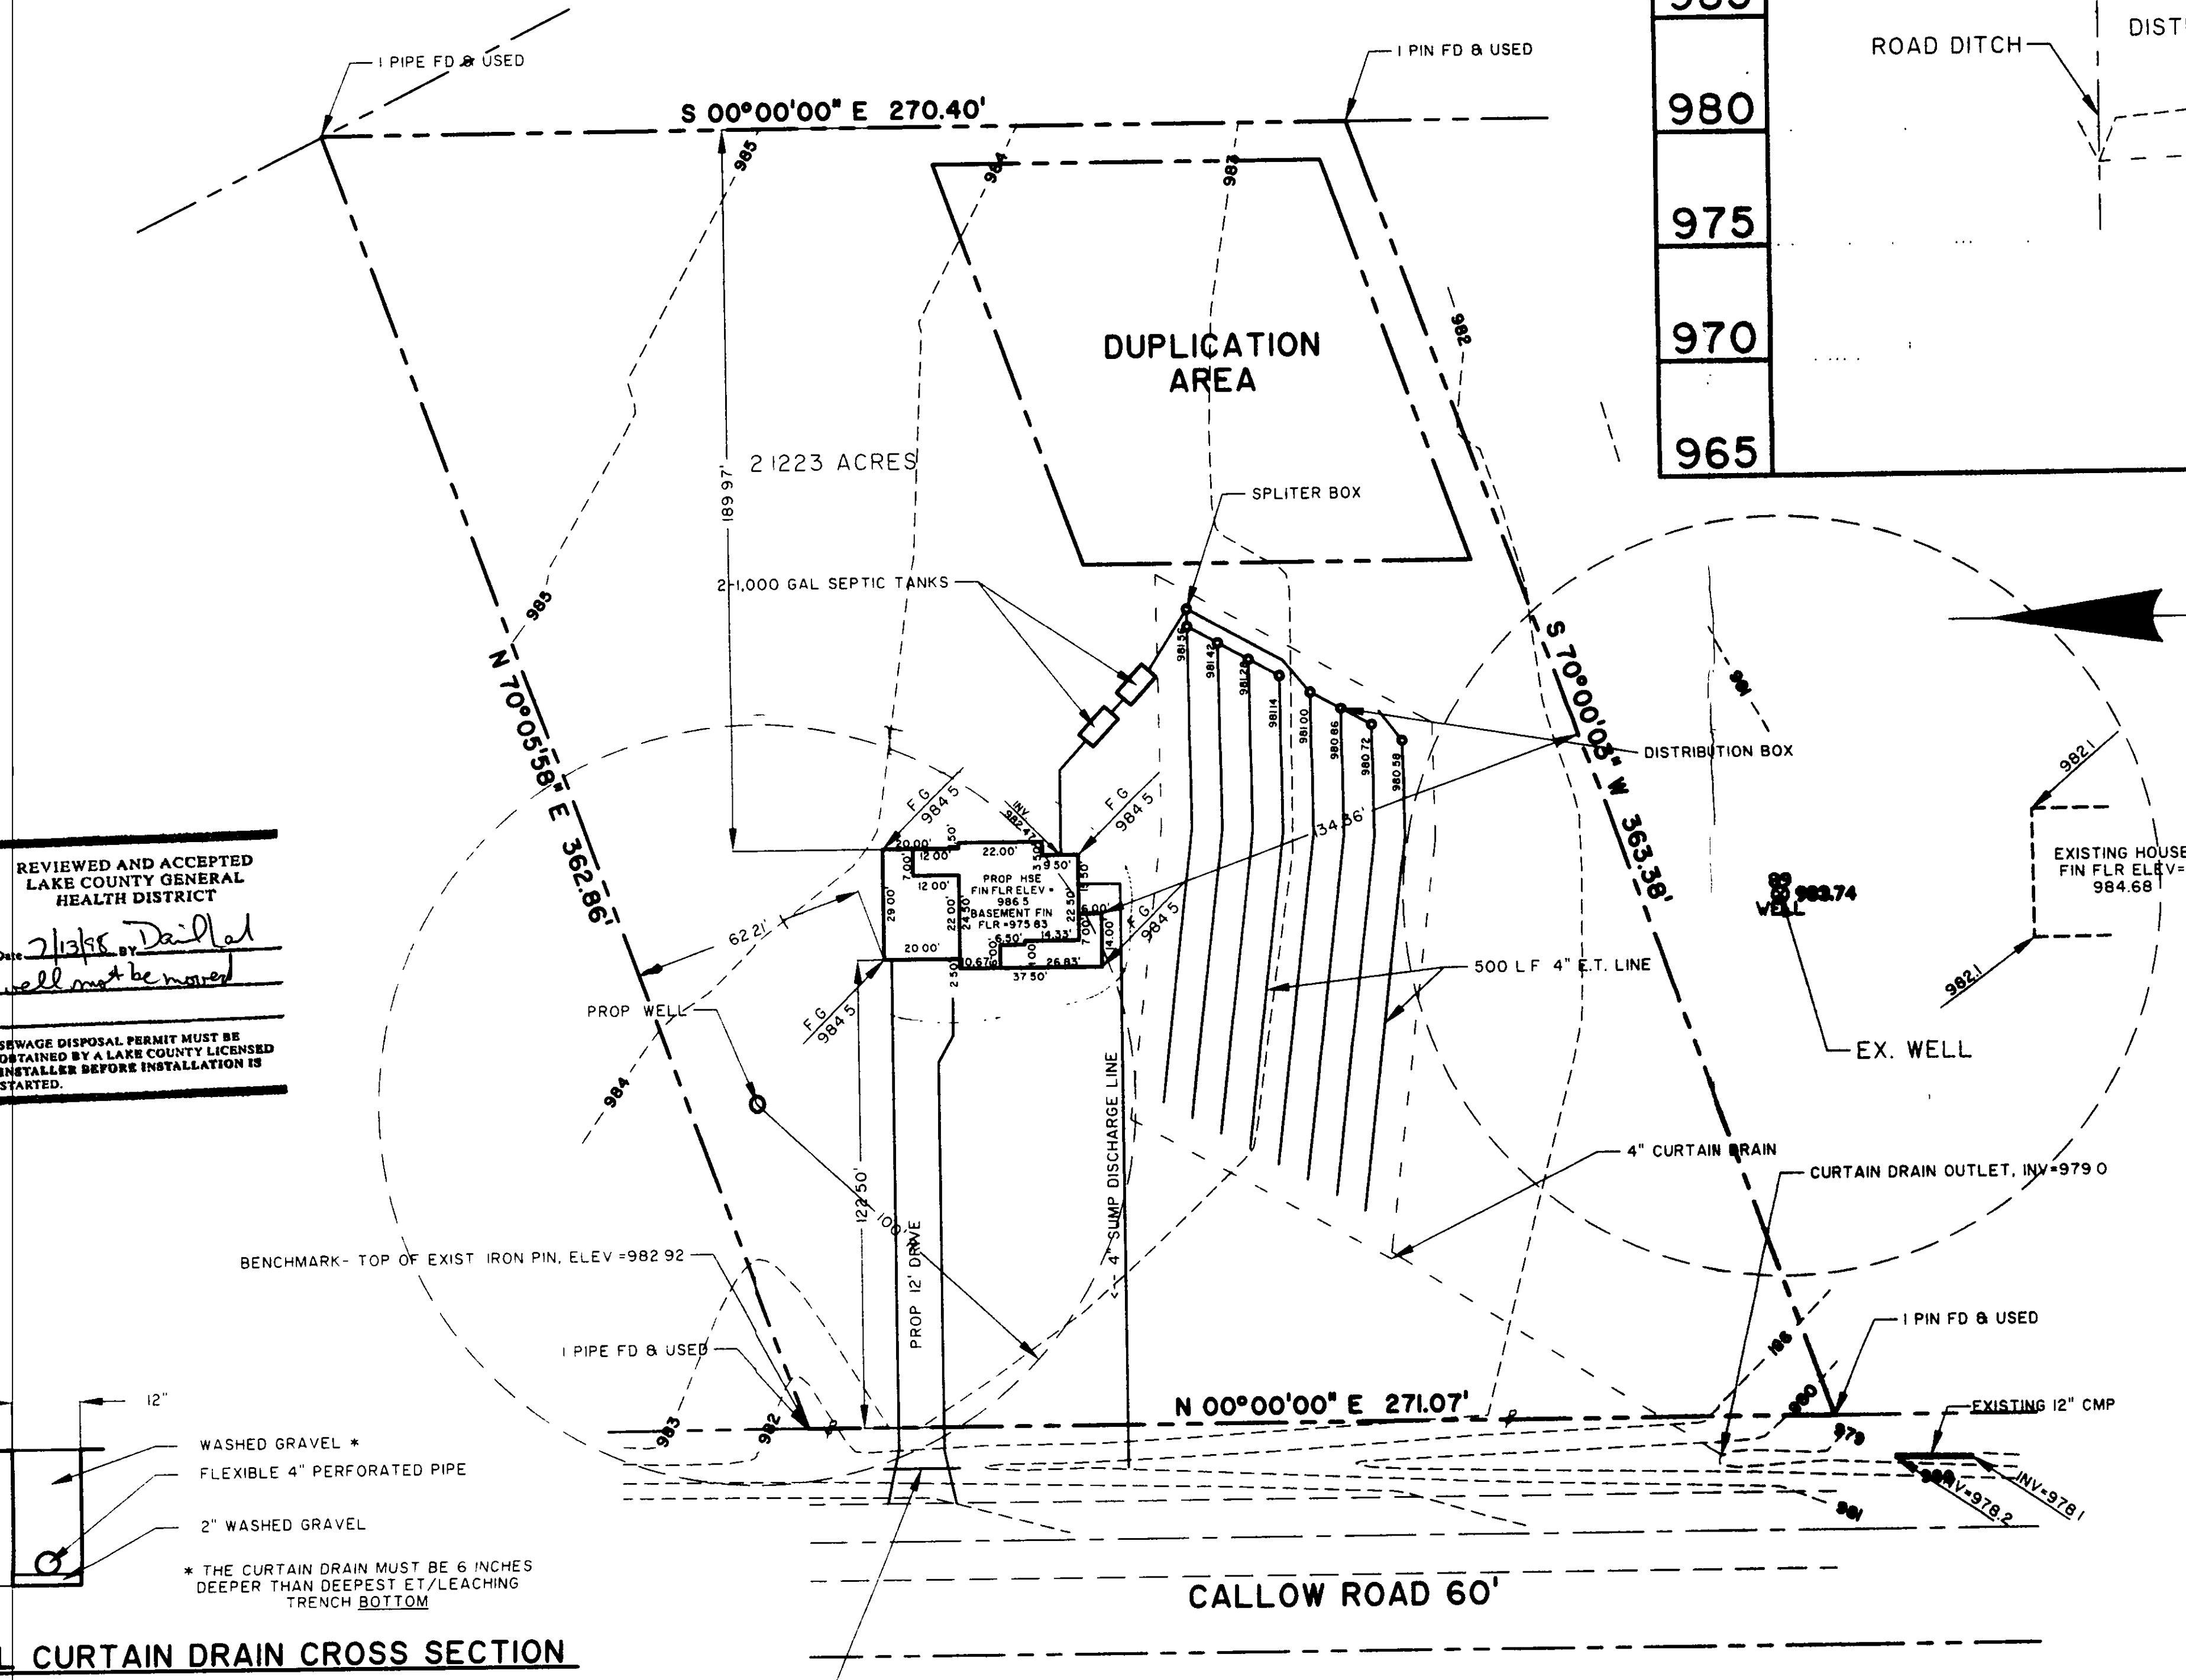

GRAPHIC SCALE

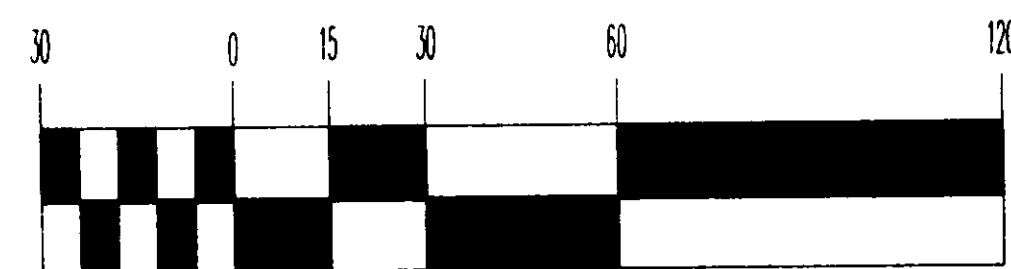

(IN FEET)

1 inch = 30 ft.

GENERAL NOTES:

1. DRIVEWAY APRON TO BE 6" THICK
2. BENCHMARK - TOP OF IRON PIN LOCATED AT NORTH WEST CORNER AS SHOWN, ELEV.=982.92

LEGEND

- EXISTING CONTOUR
- PROPOSED CONTOUR
- EXISTING ELEVATION
- PROPOSED ELEVATION

CERTIFICATION

"I THE UNDERSIGNED HEREBY CERTIFY THAT THIS TO INDICATED BY 'I' CONTOURS AND ELEVATIONS SHOW REPRESENTS AN ACTUAL SURVEY MADE BY ME ON T DAY OF JUNE , 1998 AND THE ELEVATIONS WERE APPROPRIATE INTERVALS AND AS OF THAT DAY THE AS INDICATED HEREON.


"I HEREBY CERTIFY THAT THIS PLAN WAS PREPARED AND IS CORRECT TO THE BEST OF MY KNOWLEDGE"

David W. Novak
DAVID W. NOVAK, P.S. No.

Grading Plan Approved
as shown and/or noted
THOMAS P. GILLES, P.E.
Lake County Engineer
By *G.H.* Date *7.15.98*

CURTAIN DRAIN CROSS SECTION

DESCRIPTION	DATE	BY	CHK'D
SEPTIC SYS AND HOUSE LOCATION	07/10/98	DWN	

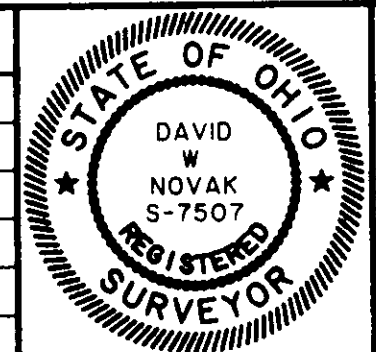

Himebaugh and Novak
Surveyors and Site Consultants
38342 Western Parkway, Unit 10
Willoughby, Ohio 44094
(440) 946-1761, (440) 918-0486

GENTRY HOMES
6358 CONLEY ROAD, CONCORD, OHIO. 44077

DATE: JUNE 11, 1998
DRAWN BY: C.R. KRAFT
CHECKED BY: D.W. NOVAK
APPROVED BY:
P.B. No. PG.

SITEPLAN
SUBLOT NO. 1 CALLOW ROAD, LEROY, OHIO. 44077