
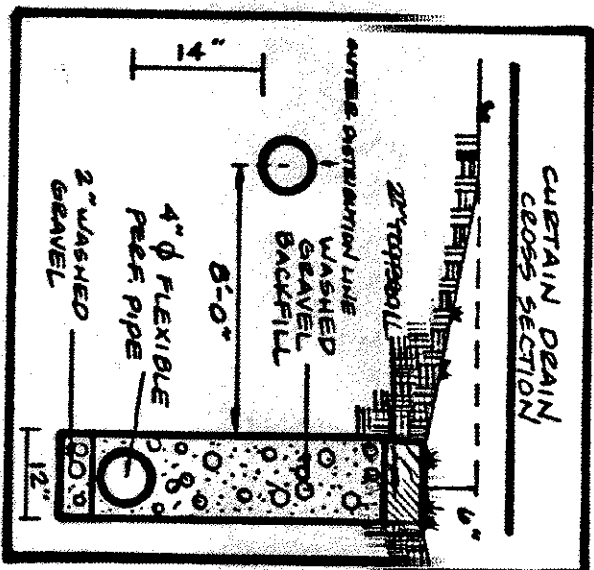


Reviewed and Accepted
LAKE COUNTY GENERAL HEALTH DISTRICT
Date: 9-12-94
JOEL LUGA, R. S., M. P. H.
Health Commissioner
BY: L. L. Jones

SEWAGE DISPOSAL PERMIT MUST BE OBTAINED BY A LAKE COUNTY LICENSED INSTALLER BEFORE INSTALLATION IS STARTED.

- A. To be brought to finished grade**
1. Septic tank manhole covers
2. Splitter box cover
3. Distribution box cover
B. No footer drains or downspouts to be discharged into septic tanks
C. All waste water to be discharged into septic tanks

LOW YIELD WATER FIXTURES REQUIRED ON ALL:
Shower Head
Toilet

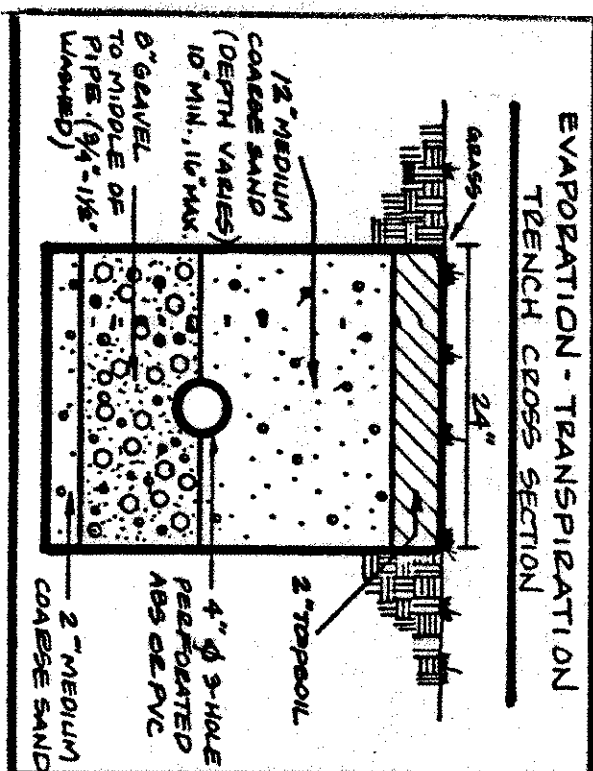

SITE PLAN

Leroy Township, Lake County, Ohio

for: R. L. Moore Homes

ADDRESS: 7021 Willow Rd.

SUBDIVISION: VOL. - REG. NAME: LOT: 21 TRACT: 21
SUBLOT NO.: STREET: PERM. PARCEL NO.: PAGE: 12 of 12
STREET: CITY: ZIP:

LEGEND

SANITARY MANHOLE: WATER VALVE (GAS)
STORM MANHOLE: WATER METER (GAS)
INLET OR CATCH BASIN: AS BUILT ELEVATION
HYDRANT: INDICATES DIRECTION OF PROPOSED CONTOURS
EXIST. ELEV. 100.0 PROP. ELEV. 100.0

REMARKS

ALL BOUNDARY DATA SHOWN WAS OBTAINED FROM IDEEDS, RECORDED SUBDIVISION PLAT OR OTHER PUBLIC RECORDS
LOCATIONS AS SHOWN OF ADJACENT WELLS AND SEPTIC TANKS OBTAINED FROM LAKE COUNTY HEALTH DEPARTMENT


DESIGN CERTIFICATION

THIS PLAT WAS PREPARED BY ME, AND IS CORRECT TO THE BEST OF MY KNOWLEDGE AND BELIEF

NAME: SURVEYOR: REGISTRATION NO. 6345

CHECK LIST

NO. OF BEDROOMS: WATER MAIN SIZE, LOCATION
DIMENSIONS: SEWER SIZE, GR. LOC.
BEARINGS: S.W. M. CAST. ELEV. INV. ELEV.
THE TO NEAREST STREET: S.W. M. CAST. ELEV. INV. ELEV.
SUBLOT NO. PARCEL NO.: S.W. M. CAST. ELEV. INV. ELEV.
SURROUNDING OWNERS: S.W. M. CAST. ELEV. INV. ELEV.
BLDG. DIMENSIONS FIN. GR.: S.W. M. CAST. ELEV. INV. ELEV.
BLDG. TYPE: S.W. M. CAST. ELEV. INV. ELEV.
ARROW TYPE WIDTH THICKNESS: S.W. M. CAST. ELEV. INV. ELEV.
SIDEWALK TYPE WIDTH THICKNESS: S.W. M. CAST. ELEV. INV. ELEV.
CULVERT TYPE DIA. LENGTH: S.W. M. CAST. ELEV. INV. ELEV.
ROCK OUTCROPPINGS: S.W. M. CAST. ELEV. INV. ELEV.

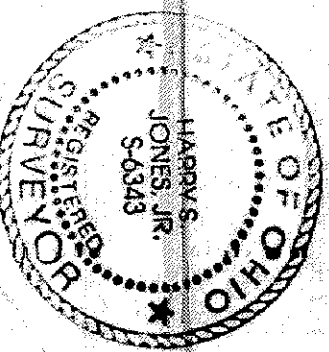

PLAN PREPARED BY: BABCOCK & JONES & ASSOCIATES, INC. PAINESVILLE, OHIO

NO.	DATE	BY
1		
2		
3		
4		
5		

"AS BUILT" CERTIFICATION

I, HEREBY CERTIFY THAT THE CIRCLED GRADES ARE EXISTING FINISH GRADES CHECKED IN THE FIELD ON 19 19 19 AND ARE CORRECT TO THE BEST OF MY KNOWLEDGE AND BELIEF.

REGISTERED SURVEYOR: REG. NO. 6345

TRM - LMC IN FILE

DATE: 9/10/00


Grading Plan Approved as shown and/or noted THOMAS P. GILLES, P.E. Lake County Engineer

By: 6/1/14 Date: 1/14/94

"I, the undersigned hereby certify that this topography indicated by 6", 1" or 2" contours, and elevations shown hereon represent an actual field survey made by me on the 12th day of SEPT., 1994 and that the elevations were taken at appropriate intervals and that as of that date they existed as indicated hereon."

Name: Reg. No. 6345

HYDRAULIC PROFILE
SCALE: HORIZ. 1" = 30'
VERT. 1" = 5'

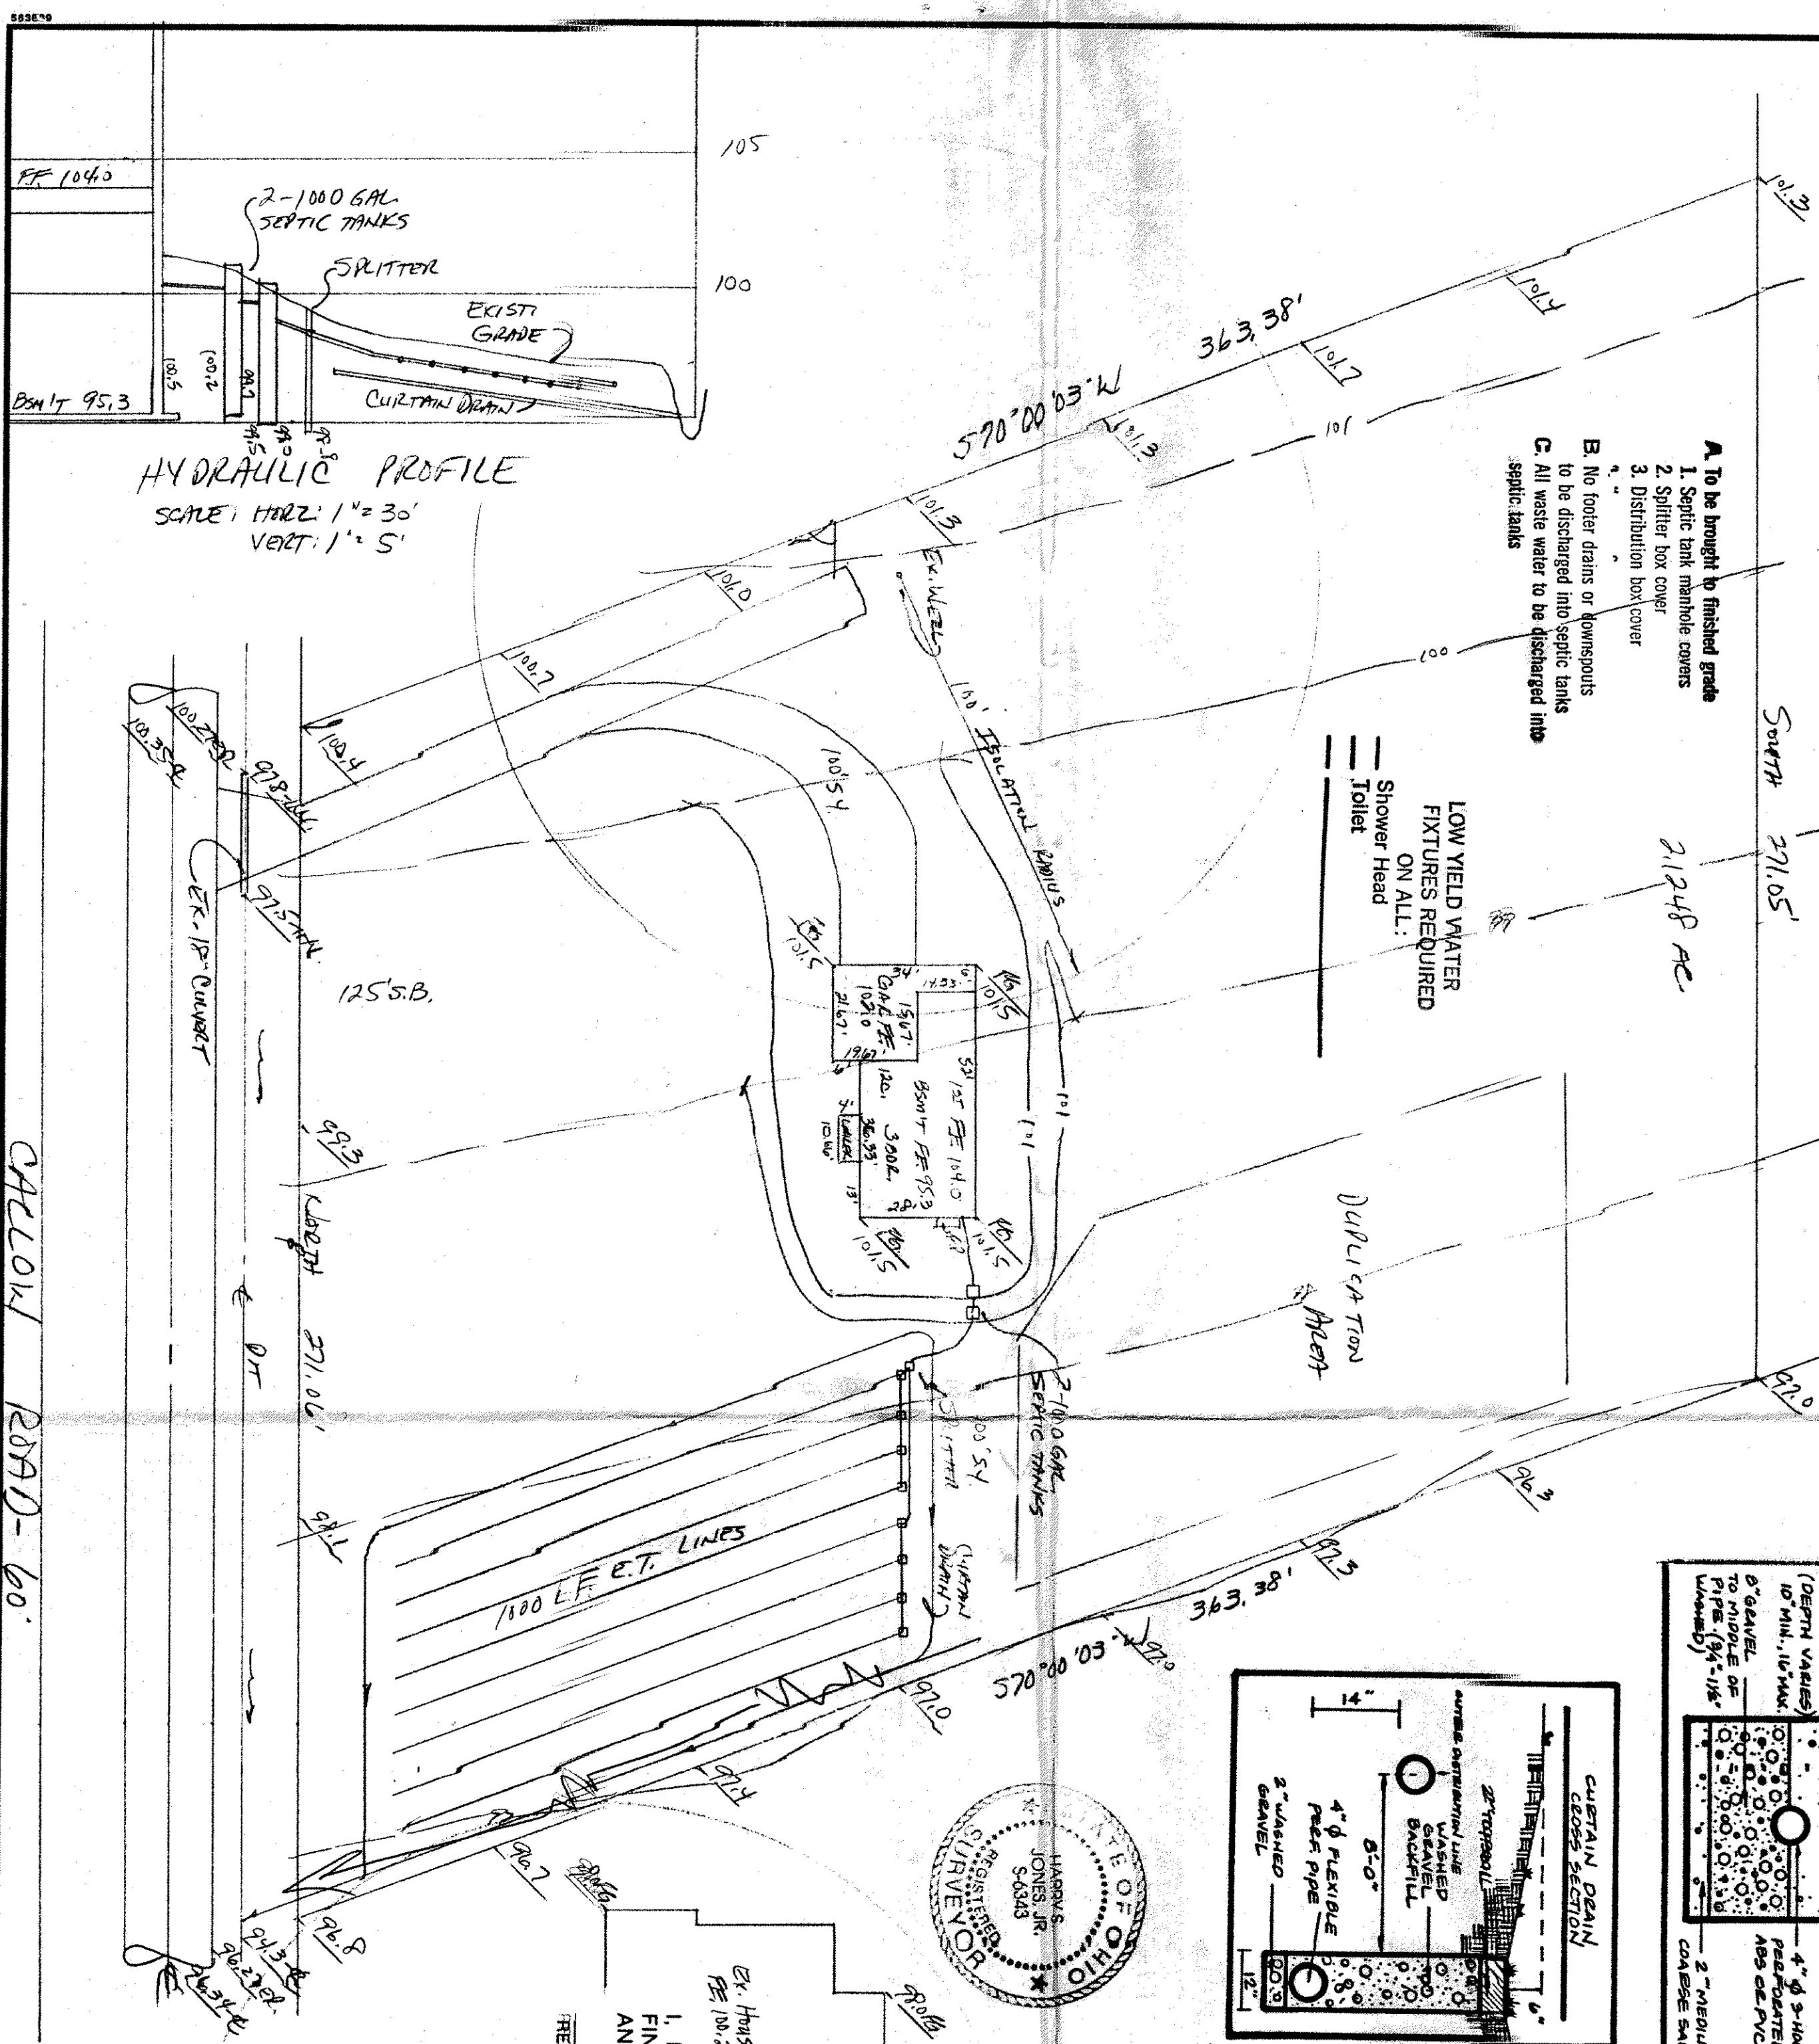

CALCULATED 20790-600