

"I, the undersigned hereby certify that this topographic map, showing 6", 1' or 2' contours, and elevations shown hereon represent an actual field survey made by me on the 20th day of May, 1998, and that the elevations were taken at appropriate intervals and that as of that date they existed as indicated hereon."


Name: Harry S. Jones, Jr. #6343  
Reg. No.

REVIEWED AND ACCEPTED  
LAKE COUNTY GENERAL  
HEALTH DISTRICT

Date: 6/15/98 BY: Daniel Land  
Topsoil must be brought in  
keep trenches shallow

SEWAGE DISPOSAL PERMIT MUST BE  
OBTAINED BY A LAKE COUNTY LICENSED  
INSTALLER BEFORE INSTALLATION IS  
STARTED.

HYDRAULIC PROFILE  
HORIZ. 1" = 30' VERT. 1" = 5'

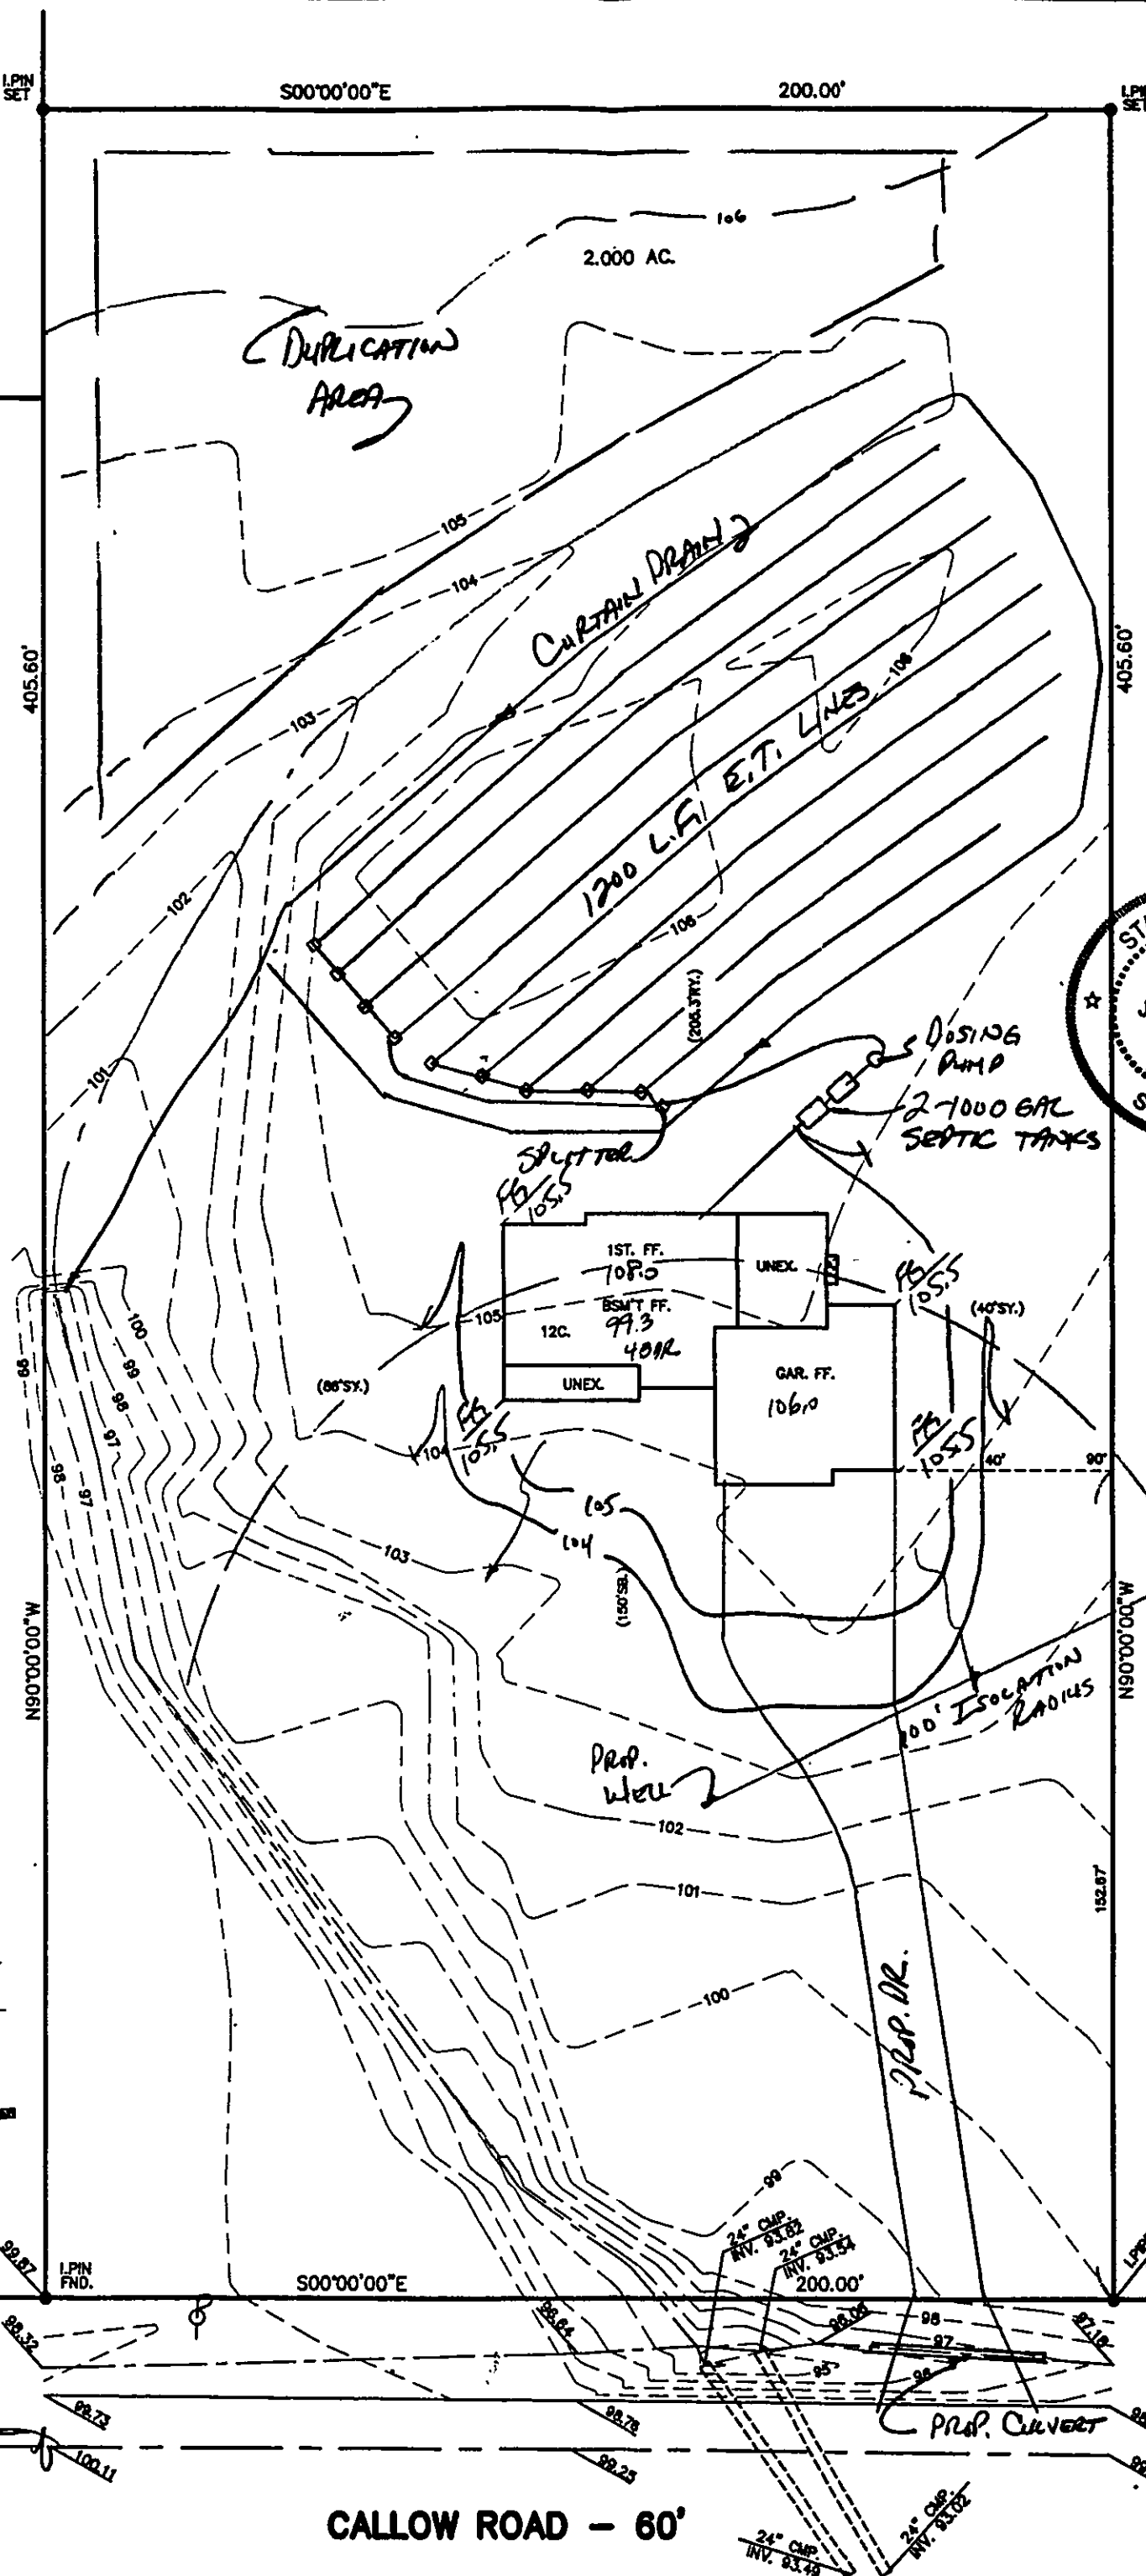

## SITE PLAN

LEROY TOWNSHIP, LAKE COUNTY, OHIO

for: JACK WATERWASH

CLIENT: \_\_\_\_\_ OWNER: \_\_\_\_\_  
ADDRESS: \_\_\_\_\_ STREET: \_\_\_\_\_ CITY: \_\_\_\_\_ ZIP: \_\_\_\_\_

SUBDIVISION: \_\_\_\_\_ NAME: \_\_\_\_\_ LOT: \_\_\_\_\_ TRACT: \_\_\_\_\_  
VOL-Pg. \_\_\_\_\_ VOLUME 7A-5A-66 PAGE CALLOW  
SUBLOT NO. \_\_\_\_\_ STREET: \_\_\_\_\_ PERM. PARCEL NO. \_\_\_\_\_ STREET: \_\_\_\_\_

### LEGEND

SANITARY MANHOLE: EXIST. ELEV. 100.0 PROP. ELEV. 100.0  
STORM MANHOLE: AS BUILT ELEVATION  
INLET OR CATCH BASIN: INDICATES  
HYDRANT: DIRECTION OF  
EXISTING CONTOURS: SURFACE DRAINAGE  
PROPOSED CONTOURS:

### REMARKS

ALL BOUNDARY DATA SHOWN WAS OBTAINED FROM (DEEDS, RECORDED  
SUBDIVISION PLAT OR OTHER PUBLIC RECORDS)

LOCATIONS AS SHOWN OF ADJACENT WELLS AND SEPTIC TANKS OBTAINED FROM  
LAKE COUNTY HEALTH DEPARTMENT

### DESIGN CERTIFICATION

THIS PLAT WAS PREPARED BY ME, AND IS CORRECT  
TO THE BEST OF MY KNOWLEDGE AND BELIEF.

NAME: Harry S. Jones, Jr. #6343  
SURVEYOR: \_\_\_\_\_ REGISTRATION NO. \_\_\_\_\_

### CHECK LIST

NO. OF BEDROOMS \_\_\_\_\_ WATER MAIN SIZE, LOCATION \_\_\_\_\_  
DIMENSIONS \_\_\_\_\_ SAN. SEWER SIZE & GR. LOC. \_\_\_\_\_  
BEARINGS \_\_\_\_\_ SAN. MH. CAST. ELEV. INV. ELEV. \_\_\_\_\_  
TIE TO NEAREST STREET \_\_\_\_\_ SAN. CONN. SIZE, LOC. DEPTH \_\_\_\_\_  
SUBLOT NO. PARCEL NO. \_\_\_\_\_ STORM SEWER SIZE & GR. LOC. \_\_\_\_\_  
SURROUNDING OWNERS \_\_\_\_\_ STORM MH. CAST. ELEV. INV. ELEV. \_\_\_\_\_  
BLDG. DIMENSIONS FIN GR. \_\_\_\_\_ PAV'T TYPE GRADE CURBS \_\_\_\_\_  
BLDG. TIES FL'R. GRADES \_\_\_\_\_ GAS LINE LOC. SIZE PRESSURE \_\_\_\_\_  
APRON TYPE WIDTH THICKNESS \_\_\_\_\_ SEPTIC TANK LOCATION & DUPLICATION AREA \_\_\_\_\_  
SIDEWALK TYPE WIDTH THICKNESS \_\_\_\_\_ WELL LOCATION \_\_\_\_\_  
CULVERT TYPE DIA., LENGTH \_\_\_\_\_ ISOLATION RADIUS FROM WELL \_\_\_\_\_  
ROCK OUTCROPPINGS \_\_\_\_\_

### REVISIONS

NO.	DATE	BY
1		
2		
3		
4		
5		

PLAN PREPARED BY:  
**Bj BABCOCK · JONES & ASSOCIATES, INC.**  
PAINESVILLE, OHIO

DRAWN BY: T.R. SCALE: 1"=30' PHONE NO. 218-357-1811  
CHK'D. H.J. DATE: 5/21/98 DRAWING NO.  
CREW CHIEF: W.B. APP'D: H.J. 98-123

### "AS BUILT" CERTIFICATION

I, HEREBY CERTIFY THAT THE CIRCLED GRADES ARE EXISTING  
FINISH GRADES CHECKED IN THE FIELD ON \_\_\_\_\_, 19\_\_\_\_  
AND ARE CORRECT TO THE BEST OF MY KNOWLEDGE AND BELIEF.

REGISTERED SURVEYOR

REG. NO.

TBM-TOP IRON PIPE  
ELEV.=100.00

