


SYMBOL LEGEND	
	Iron Pin Found
	Power Pole



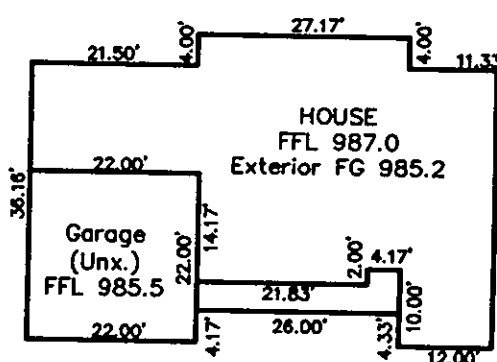


Lot Area = 1.910 A.


REVIEWED AND ACCEPTED
LAKE COUNTY GENERAL
HEALTH DISTRICT

Date 10/19/98 BY D. D. D.


SEWAGE DISPOSAL PERMIT MUST BE
OBTAINED BY A LAKE COUNTY LICENSED
INSTALLER BEFORE INSTALLATION IS
STARTED.

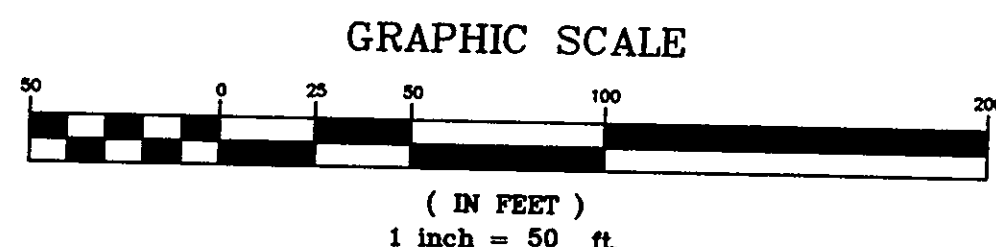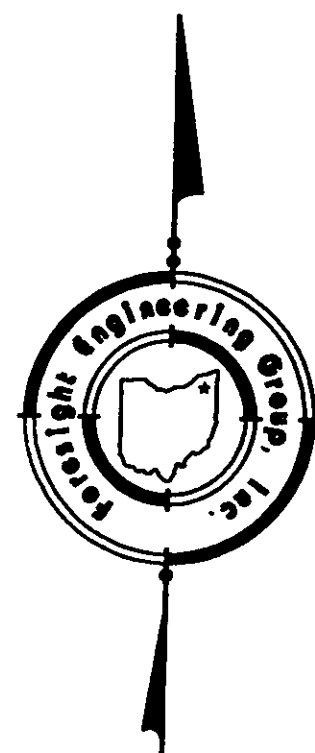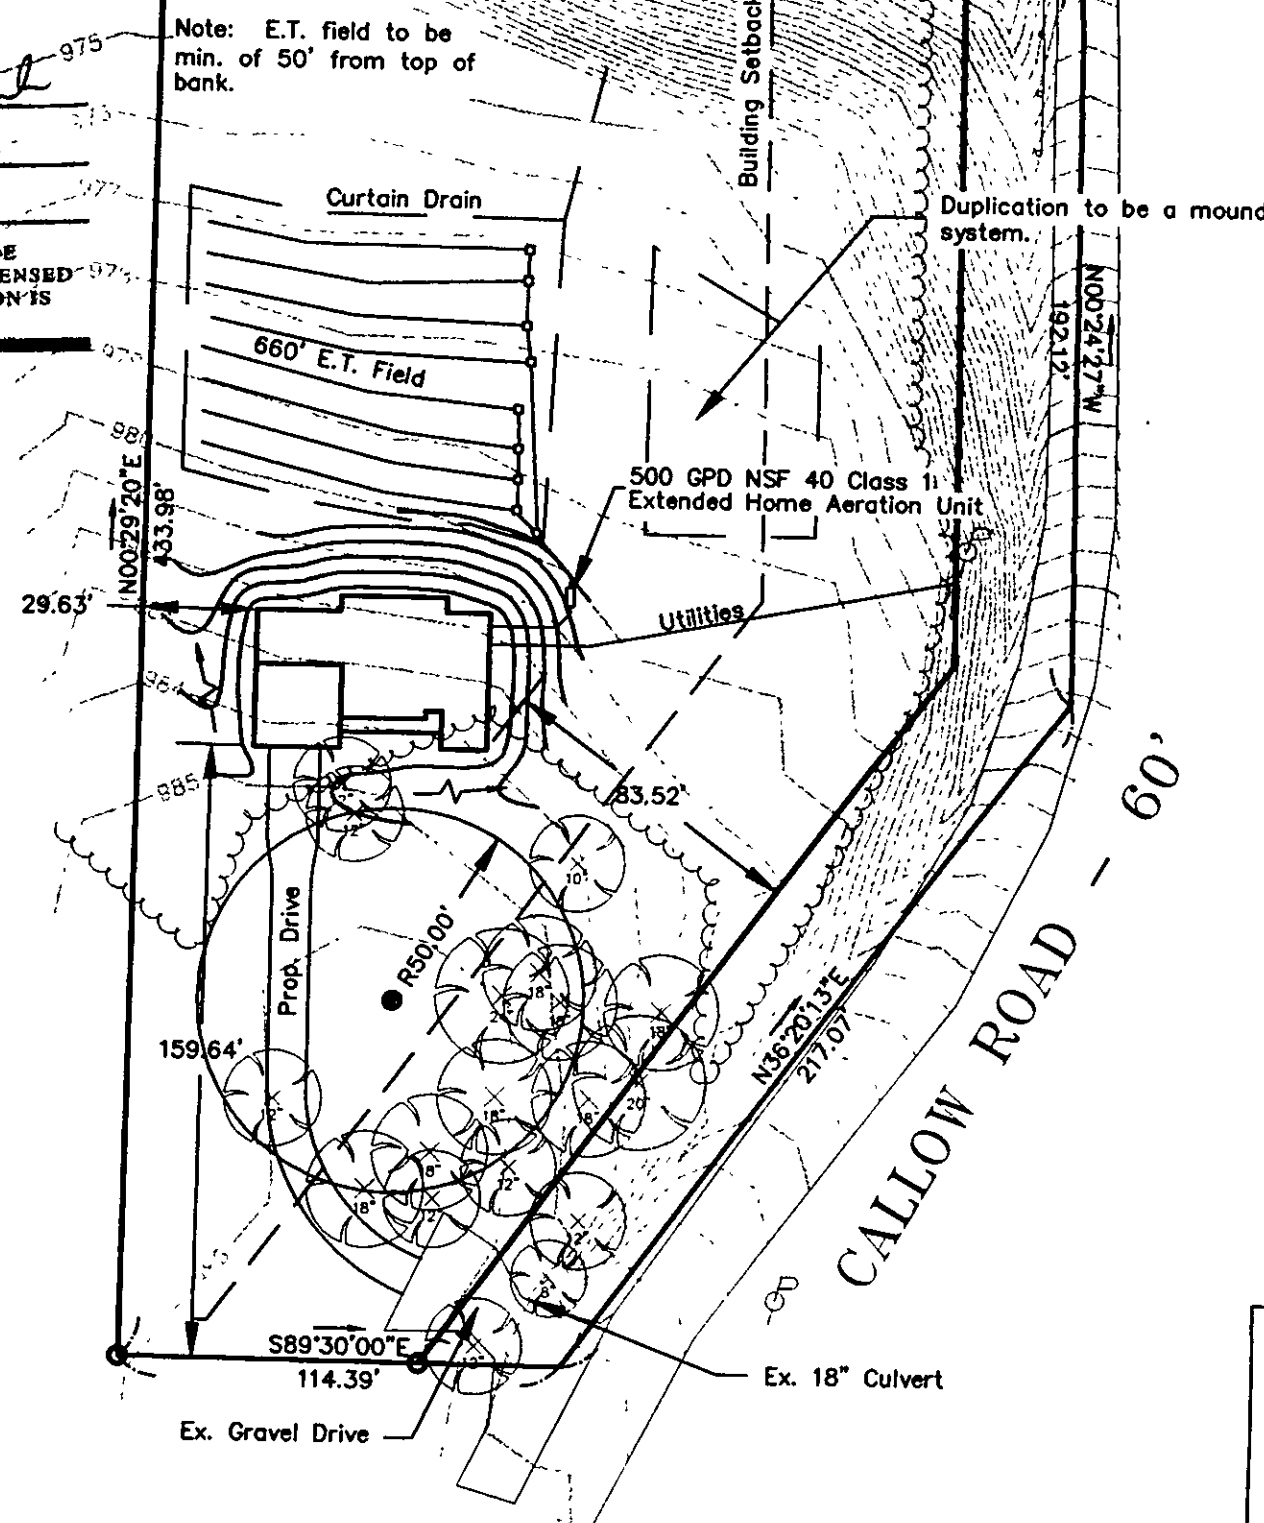


Zoning
Front Setback 50'
Side Setback 20'
Rear Setback 10'

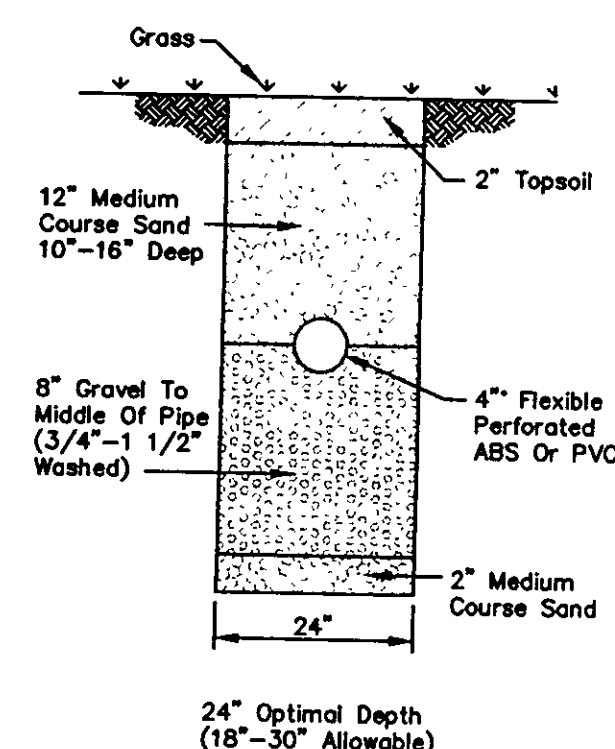

EVAPORATION-TRANSPIRATION
TRENCH CROSS-SECTION
NO SCALE

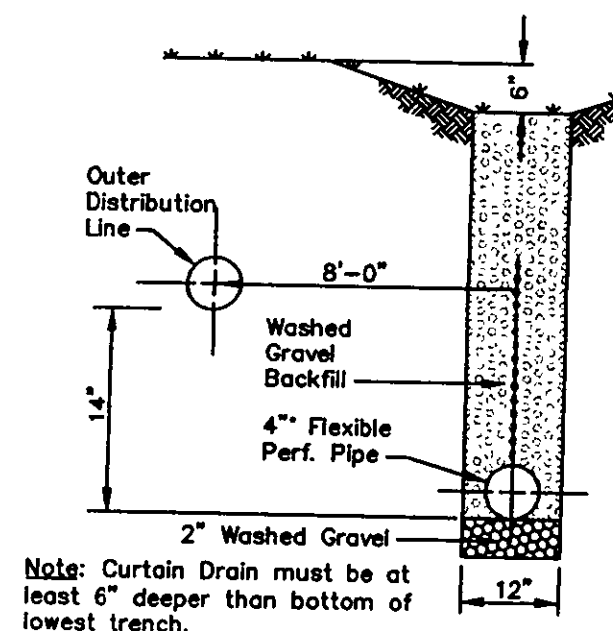

CURTAIN DRAIN CROSS SECTION
NO SCALE

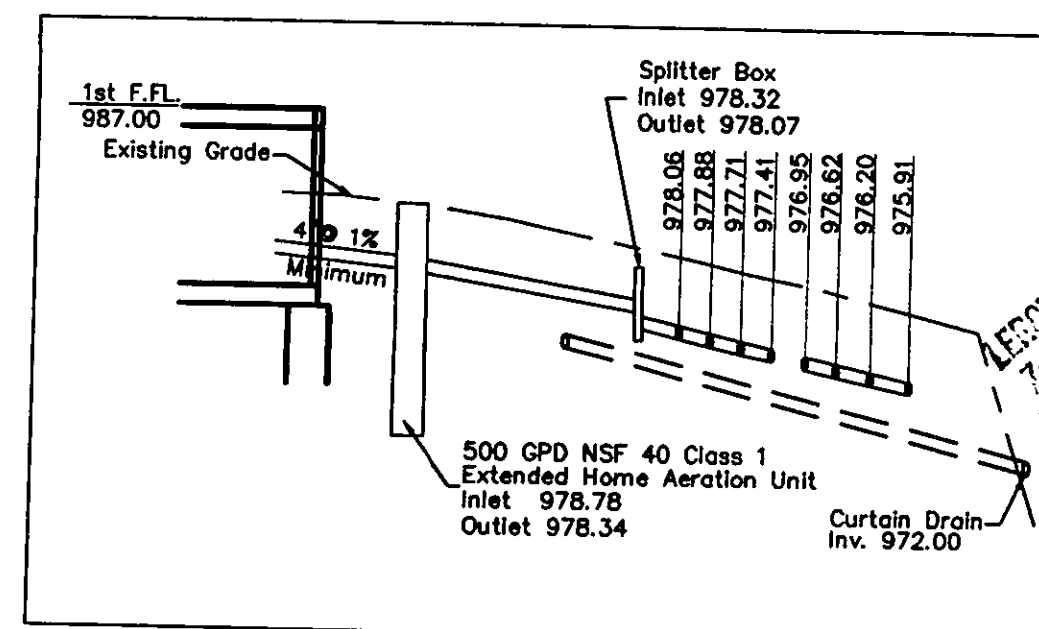

Hydraulic Profile

Grading Plan Approved
as shown and/or noted
THOMAS P. GILLES, P.E.
Lake County Engineer

By GH Date 5-14-98

SITE PLAN

for : Martin Babic
CLIENT
7608 Dewey Road Thompson Ohio 44086
ADDRESS CITY STATE ZIP

SUBLOT No. 8 SUBDIVISION NAME Leroy Twp. VOL. 970027696 PAGE 1
LOT TRACT CITY STATE

Foresight Engineering Group
Engineers & Surveyors
440 286-1010
440 286-1034 fax
320 Center Street, Unit F
Chardon, Ohio 44024

DESIGN CERTIFICATION

This Site Plan was prepared by Foresight Engineering Group, Inc., and is correct to the best of my knowledge and belief.

Sh. A. R.
NAME

CHECK LIST

LOT DIMENSIONS & BEARINGS
TIE TO NEAREST STREET
SUBLOT No. (PARCEL No.)
SURROUNDING OWNERS
BUILDING DIMENSIONS
SETBACK, SIDEYARD, REARYARD
FINISH GRADES
DRIVE & APRON TYPE, WIDTH, THICKNESS
SIDEWALK TYPE, WIDTH, THICKNESS
CULVERT TYPE, DIAM., LENGTH
WATER MAIN SIZE, LOCATION
SAN. SEWER SIZE, % GRADE, LOC.
SAN. MH. CAST. ELEV., INV. ELEV.
SAN. CONN. SIZE, % GRADE, LOC.
STORM SEWER SIZE, % GRADE, LOC.
STORM MH. CAST. ELEV., INV. ELEV.
PAVT TYPE, GRADE, CURBS
GAS LINE LOC., SIZE
SEPTIC SYSTEM & DUPLICATION
WELL LOCATION & ISOLATION RADIUS



STATE SEAL

"AS BUILT" CERTIFICATION

I hereby certify that the circled information is existing as obtained on the site _____ 19____ and is correct to the best of my knowledge and belief.

NAME _____

SCALE : 1" = 50'	1
FILE NAME: I: \BAB39801\Base.dwg	2
DATE : May. 5, 1998	3

BENCHMARK: North end of 18" CMP Inv. Elev. = 981.33

"I, the undersigned hereby certify that this topography, indicated by 6", 1' or 2' contours, and the elevations shown hereon represent an actual field survey made by Foresight Engineering Group, Inc. on the 30 day of April 1998 and that the elevations were taken at appropriate intervals and that as of that date they existed as indicated hereon."

Sh. A. R.
NAME

2 WORKING DAYS
BEFORE YOU DIG
CALL TOLL FREE 800-362-2764
OHIO OFFSHORE PROTECTION SERVICE

EXISTING UNDERGROUND UTILITIES NOTES:
The location both horizontal and vertical of the underground utilities shown hereon, have been obtained by a diligent and comprehensive search of available records. Verification by field observation, has been conducted where practical. However, Foresight Engineering Group, Inc. does not guarantee the completeness nor accuracy thereof.