



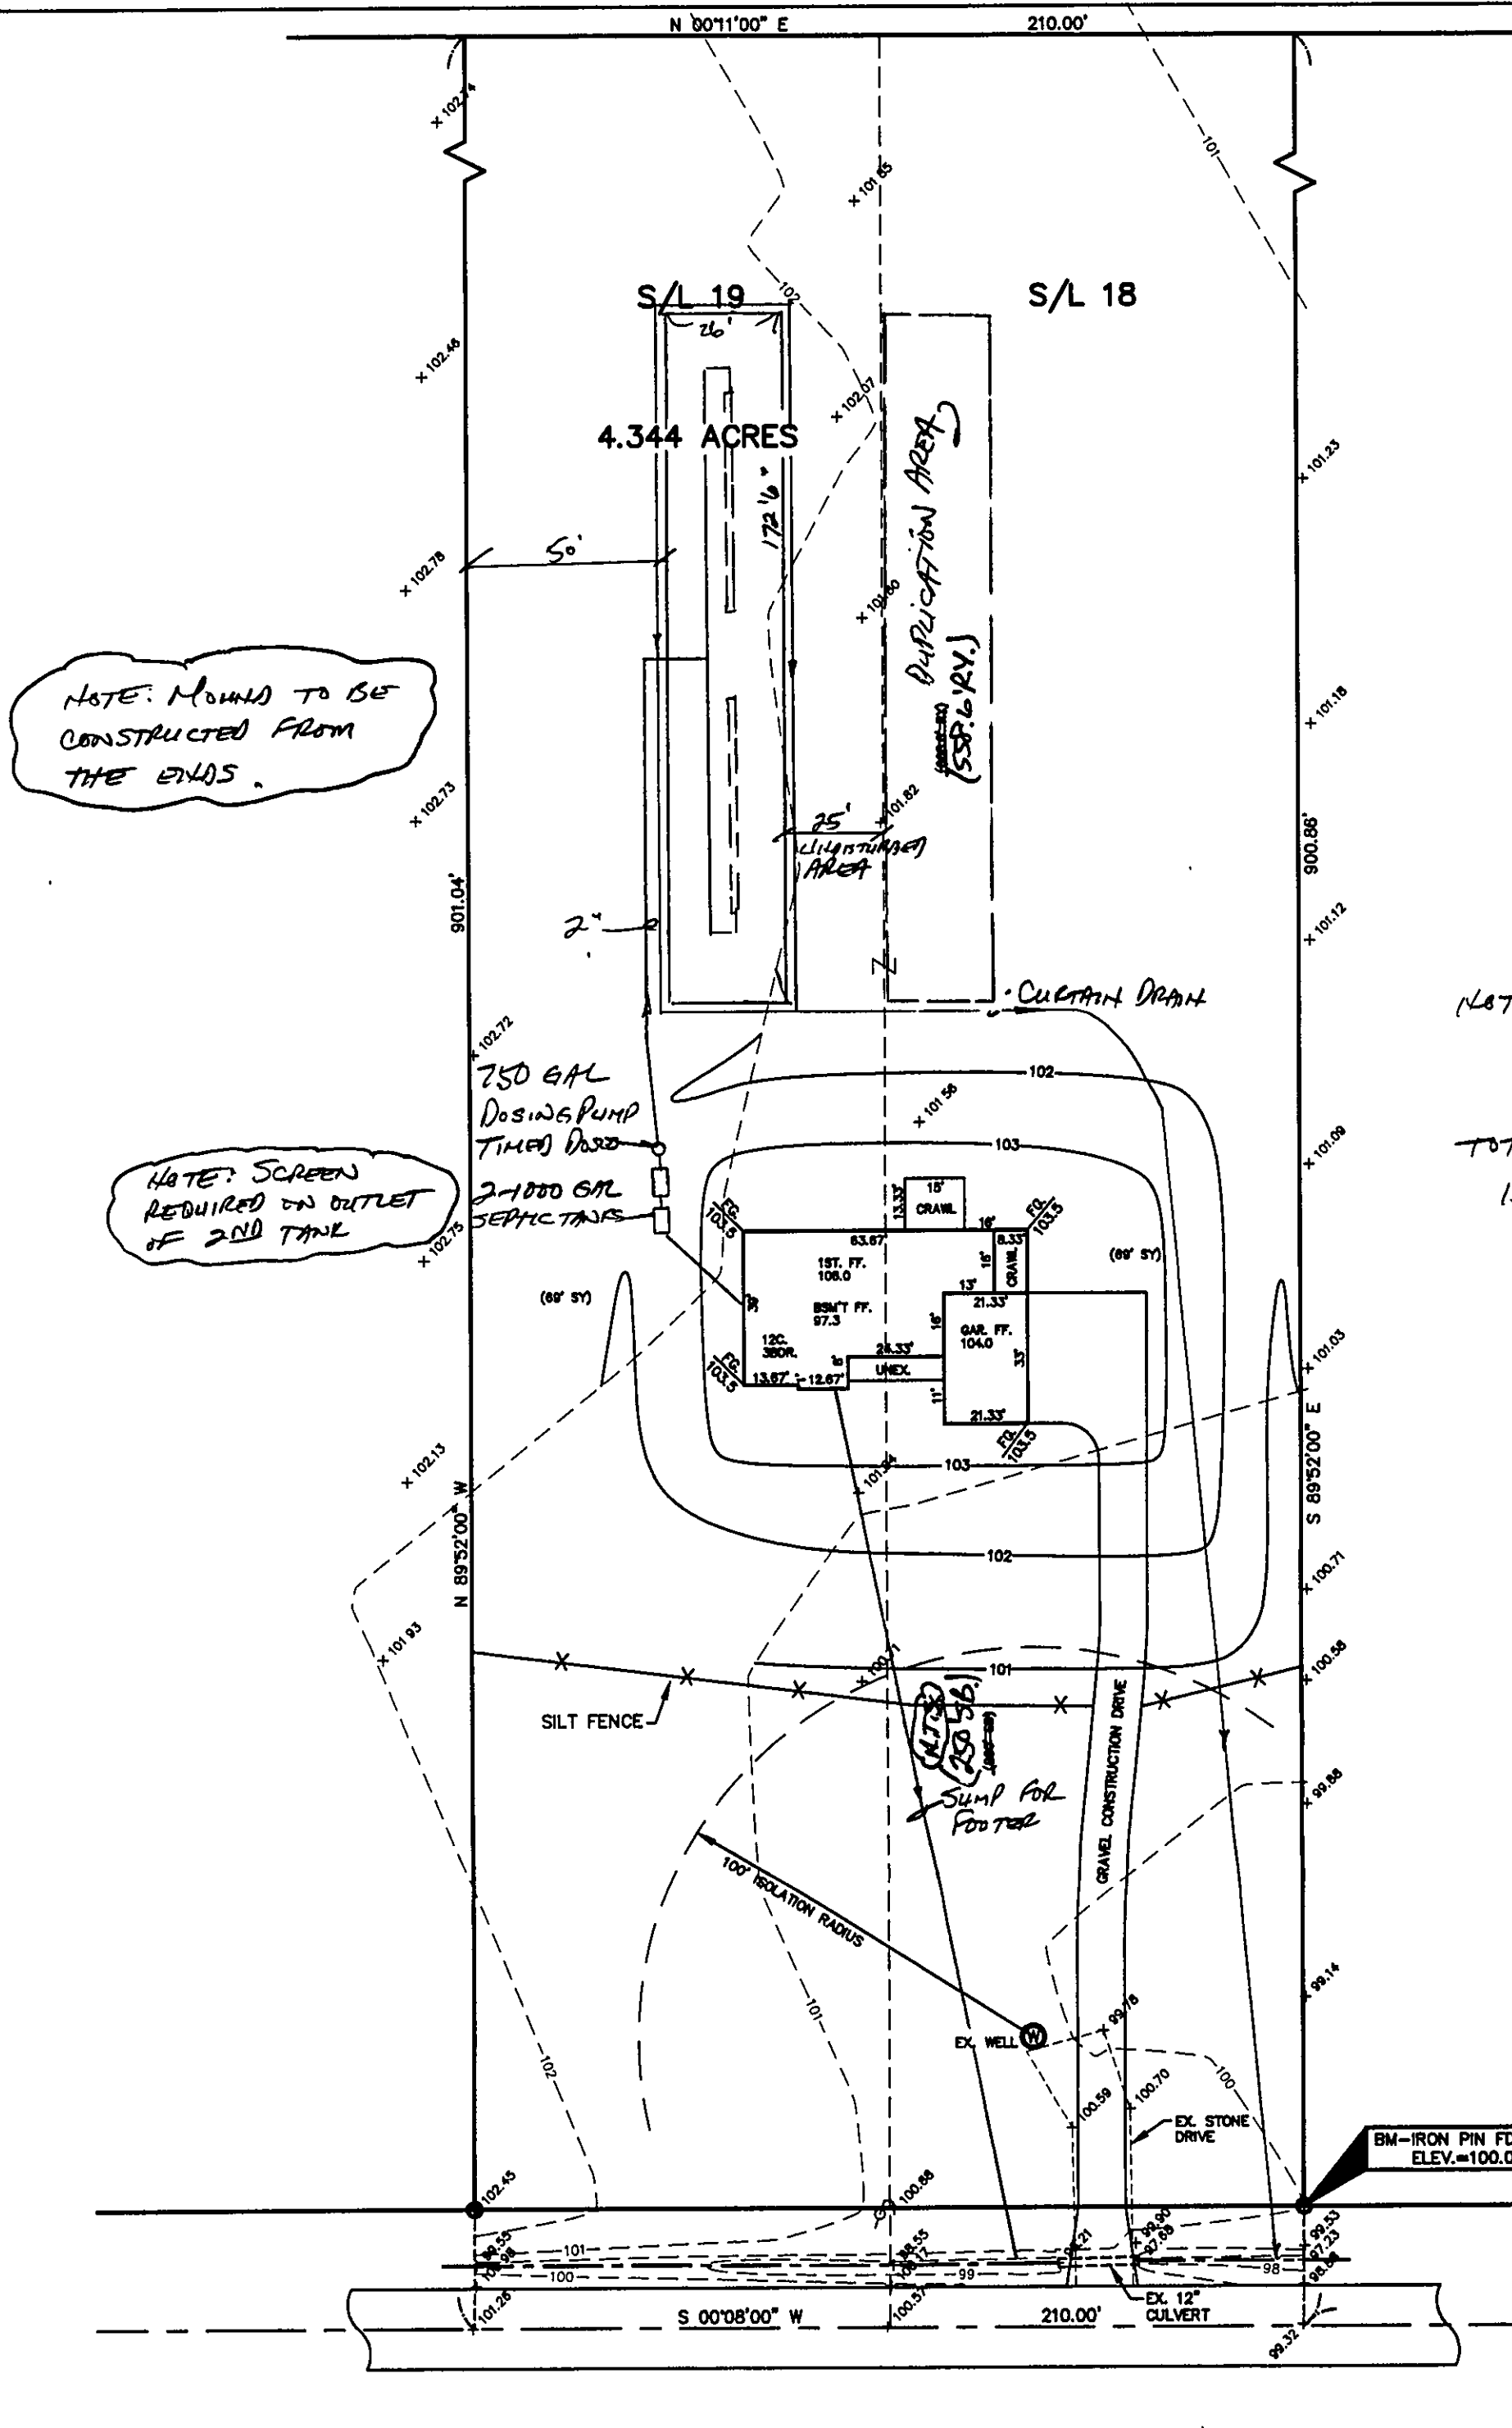

NOTE: MOUND TO BE CONSTRUCTED FROM THE ENDS.

NOTE: SCREEN REQUIRED ON OUTLET OF 2ND TANK

NOTE: LINEAR LOADING RATE =  $\frac{360}{24} = 150'$   
TOTAL LENGTH MOUND =  $150' + 12.5' + 12.5' = 175'$

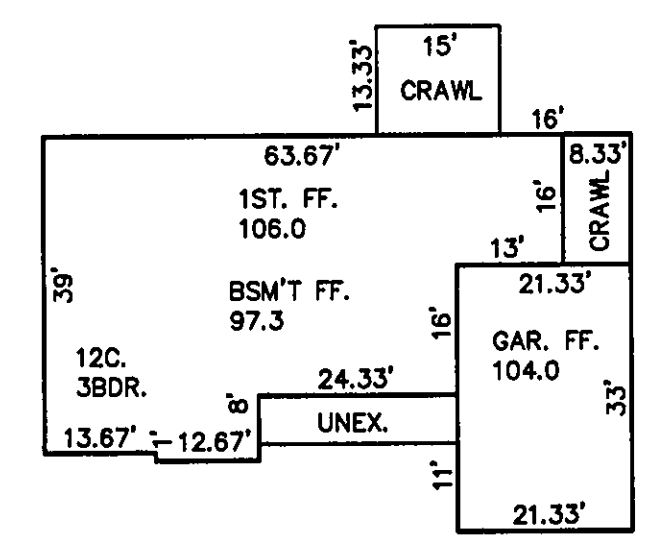

Grading Plan Approved as shown and/or noted  
JAMES R. GILLS, P.E.  
Lake County Engineer  
By GH Date 03/05/02  
15" min. Drive Culvert

SITE PLAN

LEROY TOWNSHIP, LAKE COUNTY, OHIO

for: VAN WINKLE

CLIENT OWNER

ADDRESS STREET CITY ZIP

GLENHAVEN

SUBDIVISION L-39 NAME TRACT STREET

18.19 VOL-PG CALLOW RD. LOT 13

SUBLOT NO. STREET VOL-PG PERM. PARCEL NO. 7A-3A-1-5.6

LEGEND

SANITARY MANHOLE --- 100.0 EXST. ELEV. --- 100.0 PROP. ELEV.

STORM MANHOLE --- 100.0 AS BUILT ELEVATION

INLET OR CATCH BASIN --- 100.0 INDICATES DIRECTION OF SURFACE DRAINAGE

HYDRANT --- 100.0

EXISTING CONTOURS --- 100.0

PROPOSED CONTOURS --- 100.0

DESIGN CERTIFICATION

THIS PLAT WAS PREPARED BY ME, AND IS CORRECT TO THE BEST OF MY KNOWLEDGE AND BELIEF.

NAME SURVEYOR REGISTRATION NO. #6343

PLAN PREPARED BY: BABCOCK JONES & ASSOCIATES, INC. PAINESVILLE, OHIO

REVISIONS

NO. DATE BY

1 12/17/01 H.J.

2 1/21/02 H.J.

3 2/6/02 H.J.

4 2/24/02 H.J.

5

DRAWN BY T.R. SCALE 1"=40' PHONE NO. 440-357-1811

CHK'D. H.J. DATE 12/13/01 DRAWING NO. 01-257

APP'D. H.J.

CREW CHIEF R.B.

"AS BUILT" CERTIFICATION

I, HEREBY CERTIFY THAT THE CIRCLED GRADES ARE EXISTING FINISH GRADES CHECKED IN THE FIELD ON 20 12/13/01 AND ARE CORRECT TO THE BEST OF MY KNOWLEDGE AND BELIEF.

REGISTERED SURVEYOR REG. NO.

NOTE: TEMPORARY SEEDING REQUIRED IN DISTURBED AREAS.

"I, the undersigned hereby certify that this topography indicated by 6", 1", or 2" contours, and elevations shown hereon represent an actual field survey made by me on the 11TH day of DEC., 20 01 and that the elevations were taken at appropriate intervals and that as of that date they existed as indicated hereon."

Harry S. Jones, Jr. #6343  
Name Reg. No.

