

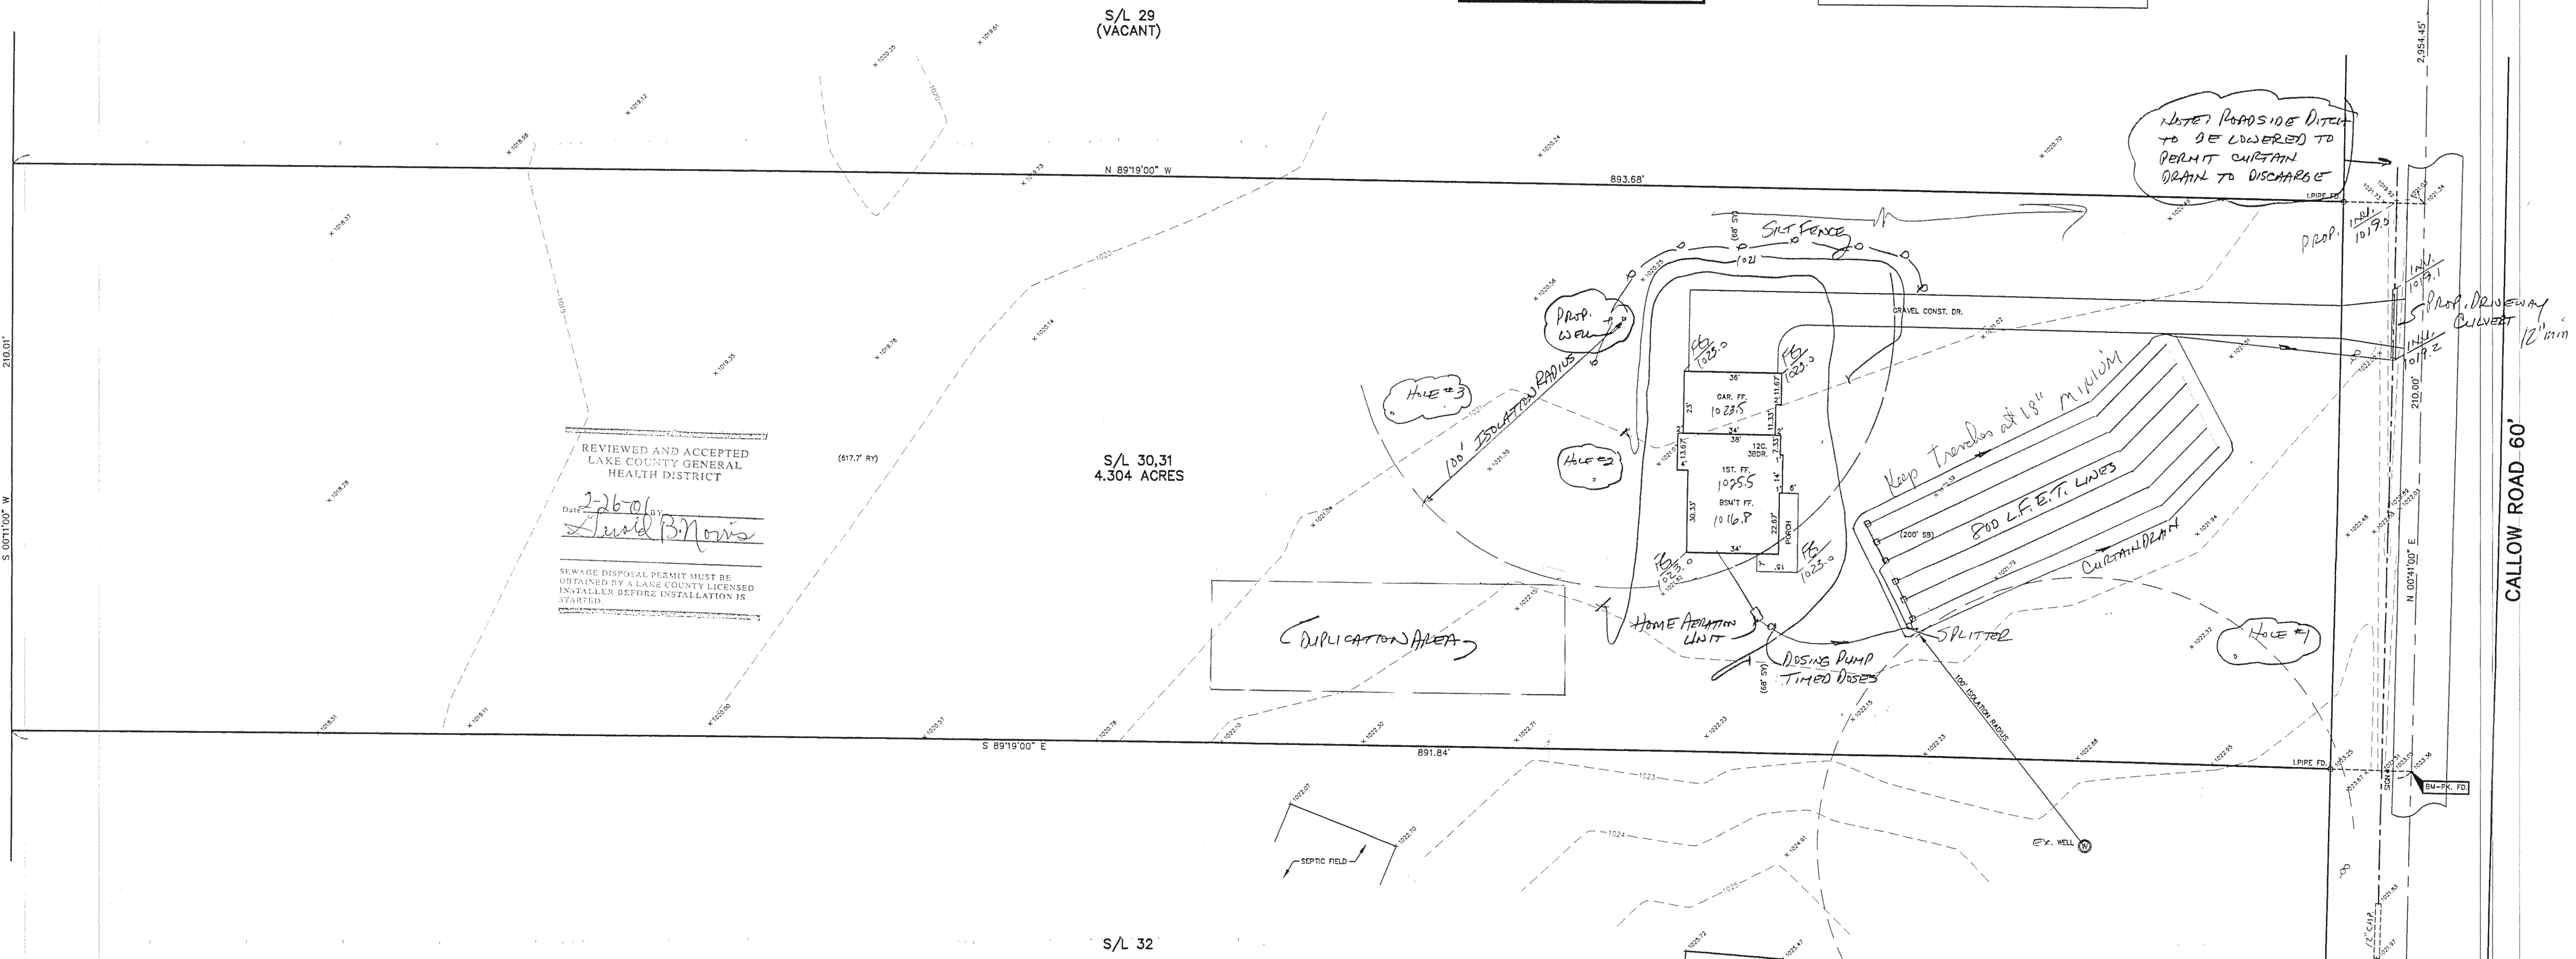
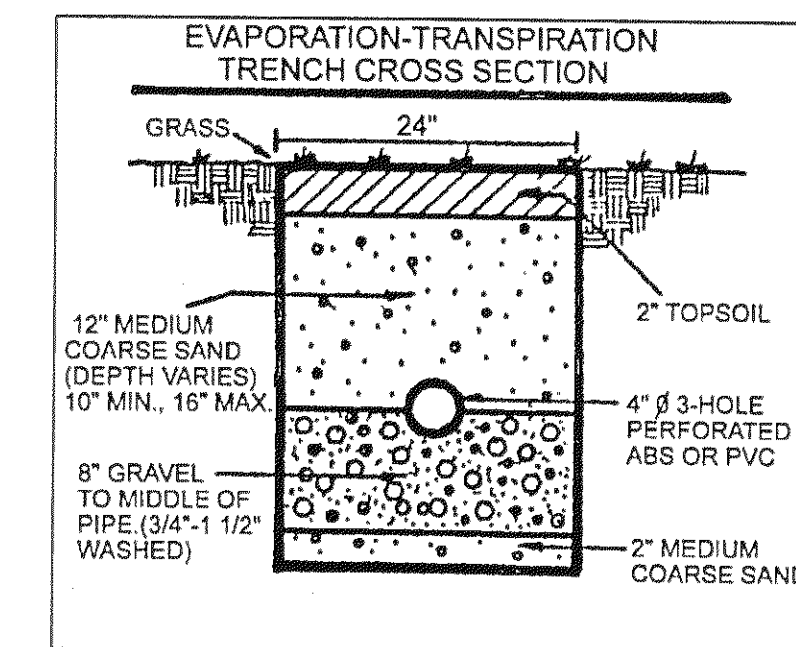


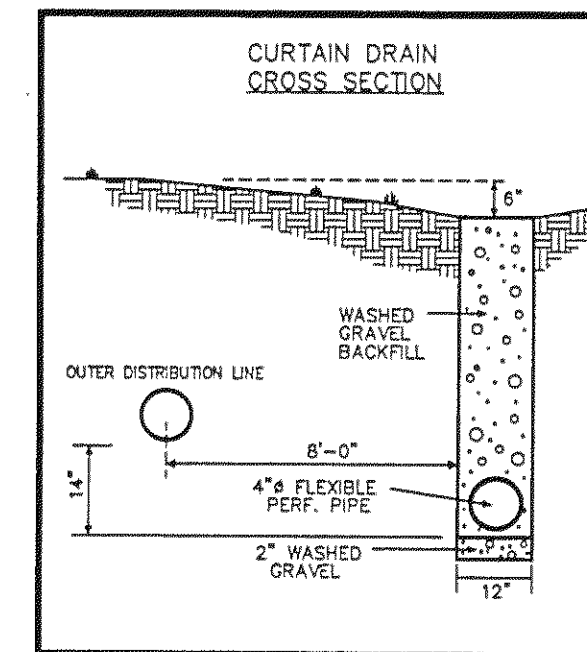

REVIEWED AND ACCEPTED
LAKE COUNTY GENERAL
HEALTH DISTRICT
Date: 2-26-01
By: David B. Novak
SEWAGE DISPOSAL PERMIT MUST BE
OBTAINED BY A LAKE COUNTY LICENSED
INSTALLER BEFORE INSTALLATION IS
STARTED.

NOTE: ROADSIDE DITCH
TO BE LOWERED TO
PERMIT CURTAIN
DRAIN TO DISCHARGE

Grading Plan Approved
as shown and/or noted
JAMES R. GILLS, P.E.
Lake County Engineer
By: T. A. R. Date: 3/15/01
Swile as shown

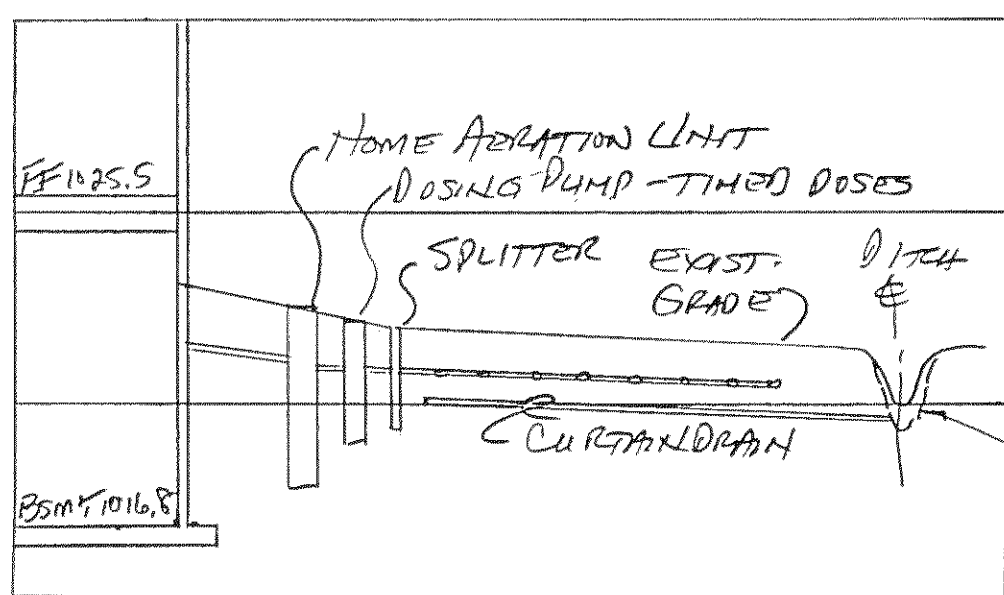


HYDRAULIC PROFILE
HORIZ: 1"=30' VERT: 1"=5'

NOTE: TEMPORARY SEEDING REQUIRED
IN DISTURBED AREAS.

"I, the undersigned hereby certify that
this topography indicated by 6", 1", or 2"
contours, and elevations shown hereon
represent an actual field survey made by
me on the 19th day of FEB, 2001
and that the elevations were taken at
appropriate intervals and that as of that
date they existed as indicated hereon."

Harry Jones #6343
Name Reg. No.

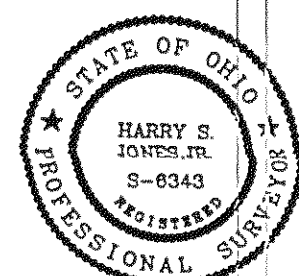

REV NO.	DESCRIPTION	DATE	BY	CHK'D

bj BABCOCK, JONES AND ASSOCIATES, INC
CIVIL ENGINEERS - SURVEYORS - LAND PLANNERS
PAINESVILLE OHIO 44077

DATE	2/21/01
DESIGN BY	H.J.
DRAWN BY	T.R.
APPROVED BY	H.J.

SITE PLAN
FOR
FERRITTO HOMES
S/L 30,31 GLENHAVEN DEVELOPMENT
LEROY TOWNSHIP LAKE COUNTY

SCALE:	1"=30'
JOB NO	01-020
SHEET	1
OF	1