


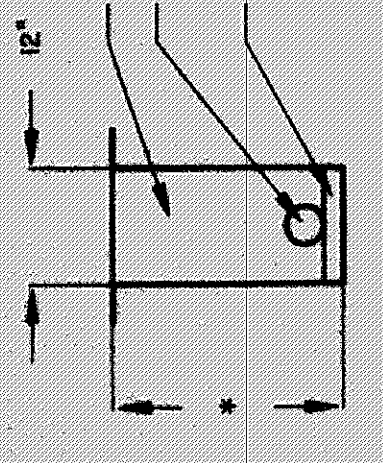


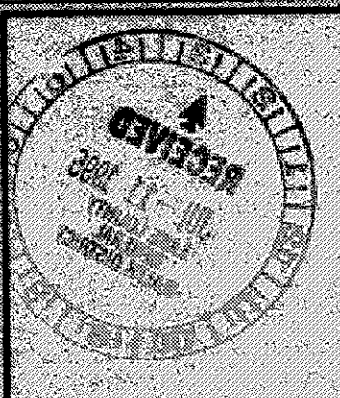

TYPICAL CURTAIN DRAIN CROSS SECTION

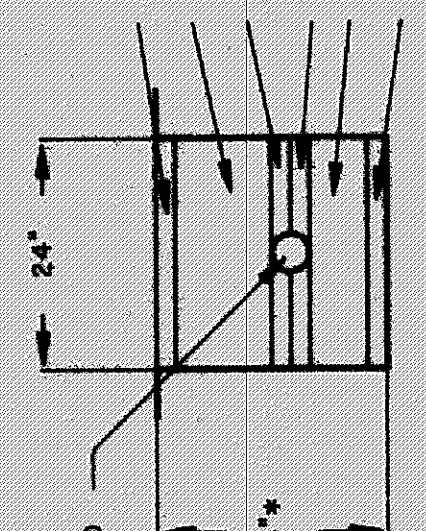

TYPICAL EVAPOTRANSPIRATION TRENCH CROSS SECTION

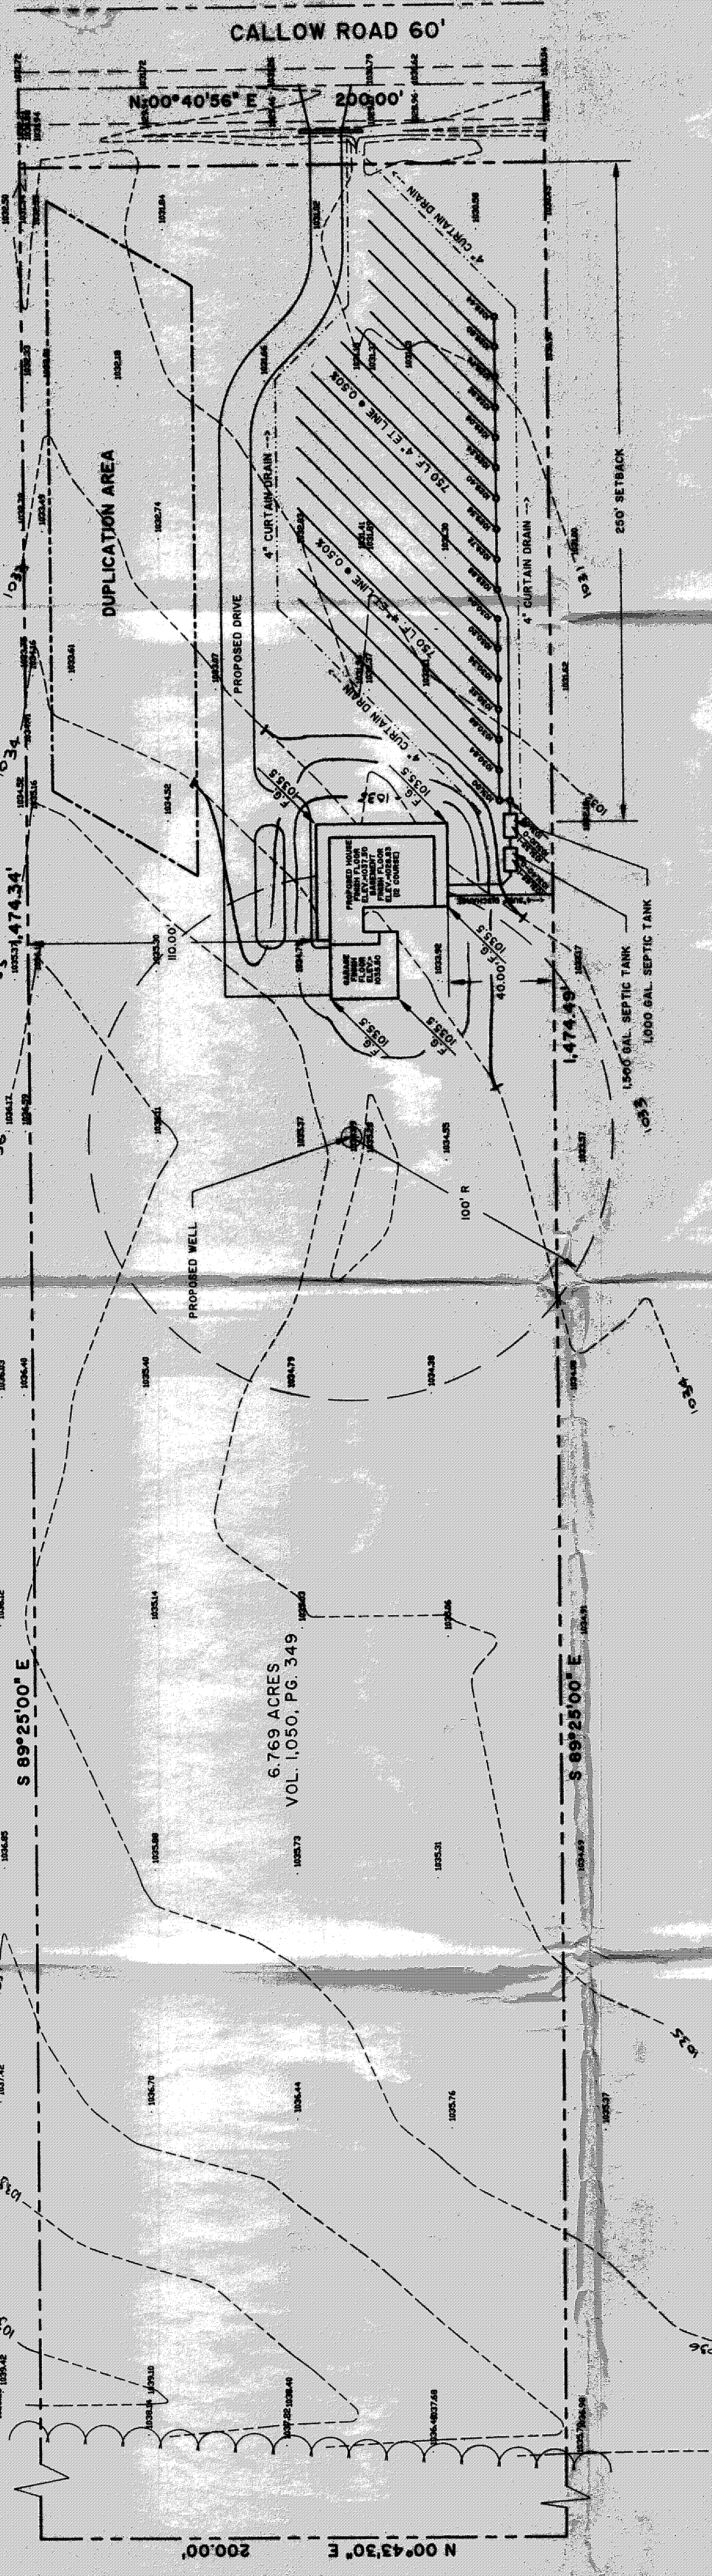

GENERAL NOTES:

1. DRIVEWAY APRON TO BE 6" THICK
2. BENCHMARK-"PK" NAIL SET IN CENTERLINE OF CALLOW ROAD AT THE S.W. PROPERTY CORNER, ELEV.=1031.72

LEGEND


- EXISTING CONTOUR
- PROPOSED CONTOUR
- EXISTING ELEVATION
- PROPOSED ELEVATION

CERTIFICATION


"I, THE UNDERSIGNED, HEREBY CERTIFY THAT THIS TOPOGRAPHY INDICATED BY 1' CONTOURS AND ELEVATIONS SHOWN HEREON REPRESENTS AN ACTUAL SURVEY MADE BY ME ON THE 12TH DAY OF JUNE, 1995 AND THE ELEVATIONS WERE TAKEN AT APPROPRIATE INTERVALS AND AS OF THAT DAY THEY EXISTED AS INDICATED HEREON.

"I HEREBY CERTIFY THAT THIS PLAN WAS PREPARED BY ME AND IS CORRECT TO THE BEST OF MY KNOWLEDGE"


David W. Novak
DAVID W. NOVAK, P.E. No. 7507

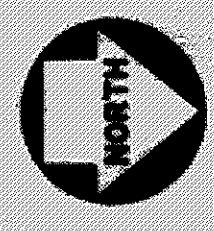

GRAPHIC SCALE

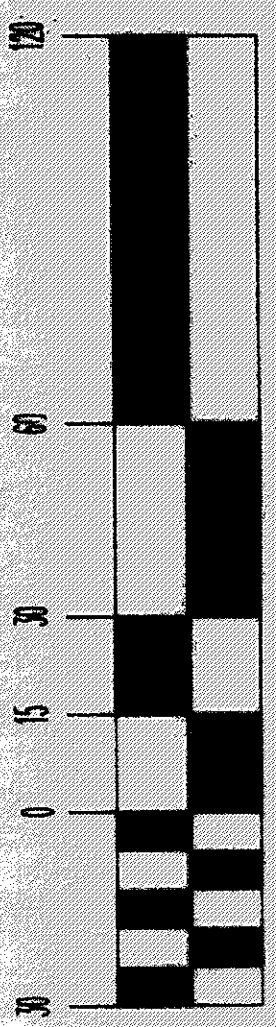

NOTE: ADJUST TANKS, SPLITTER BOX AND DISTRIBUTION BOXES TO GRADE.

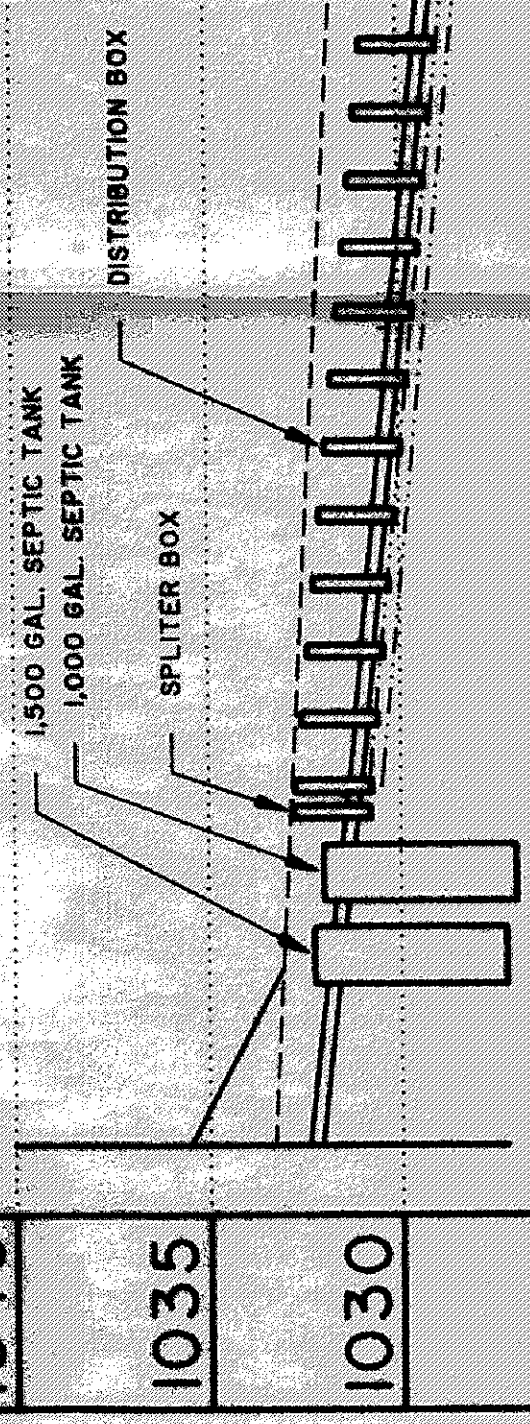

HYDRAULIC PROFILE

- A. To be brought to finished grade
1. Septic tank manhole covers
 2. Splitter box cover
 3. Distribution box cover
- B. 1/2" front drains or downspouts to be discharged into septic tanks
- C. All waste water to be discharged into septic tanks

LOW YIELD WATER FIXTURES REQUIRED ON ALL:


- Shower Head
- Toilet

SEWAGE DISPOSAL PERMIT MUST BE OBTAINED BY LANE COUNTY LICENSED INSTALLER BEFORE INSTALLATION IS STARTED.

Grading Plan Approved as shown and/or noted
THOMAS P. GILLES, P.E.
Lake County Engineer
By: *6/14* Date: *7/23/95*
1) MINIMUM DRIVE CULVERT

Reviewed and Accepted
LANE COUNTY GENERAL HEALTH DISTRICT
Date: *7-23-95*
BY: *J. L. L. L.*
JULIE L. L. L., R. E., P. E.
Health Commissioner

REV.	DESCRIPTION	DATE	BY	CHKD.

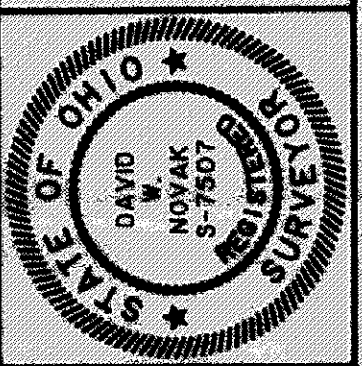

Himebaugh and Novak
Surveyors and Site Consultants
8663 Tyler Boulevard
Mentor, Ohio 44060-4346
(216) 974-7670, (216) 255-5900 FAX.

RICHARD and VICTORIA DOLES
660 BABBITT ROAD, EUCLID, OH 44123

DATE: JUNE 22, 1995
DRAWN BY: D. W. NOVAK
CHECKED BY: DWN
APPROVED BY: *[Signature]*
P.E. No. 7507

SITE PLAN
7765 CALLOW ROAD, LEROY TOWNSHIP

SCALE: HORIZ. 1" = 50'
VERT. 1" = 5'
CONTRACT NO.: 95033
SHEET NO.: 1 OF 1