

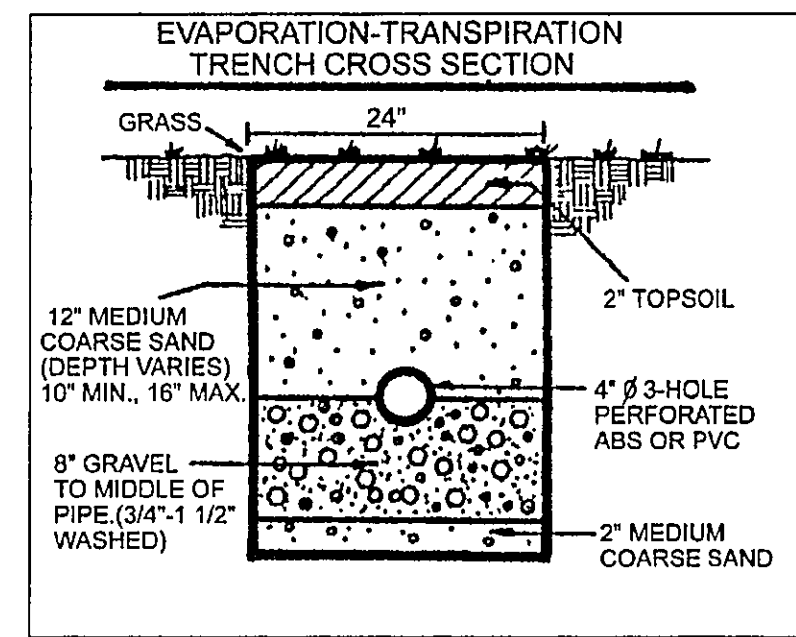


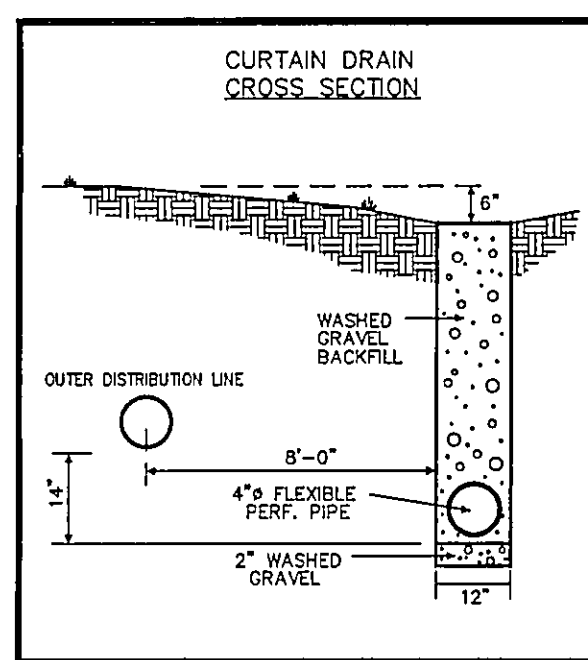


REVIEWED AND ACCEPTED
LAKE COUNTY GENERAL
HEALTH DISTRICT
5-3-04
June 13, 2004
SEWAGE DISPOSAL PERMIT MUST BE
OBTAINED BY A LAKE COUNTY LICENSED
INSTALLER BEFORE INSTALLATION IS
STARTED

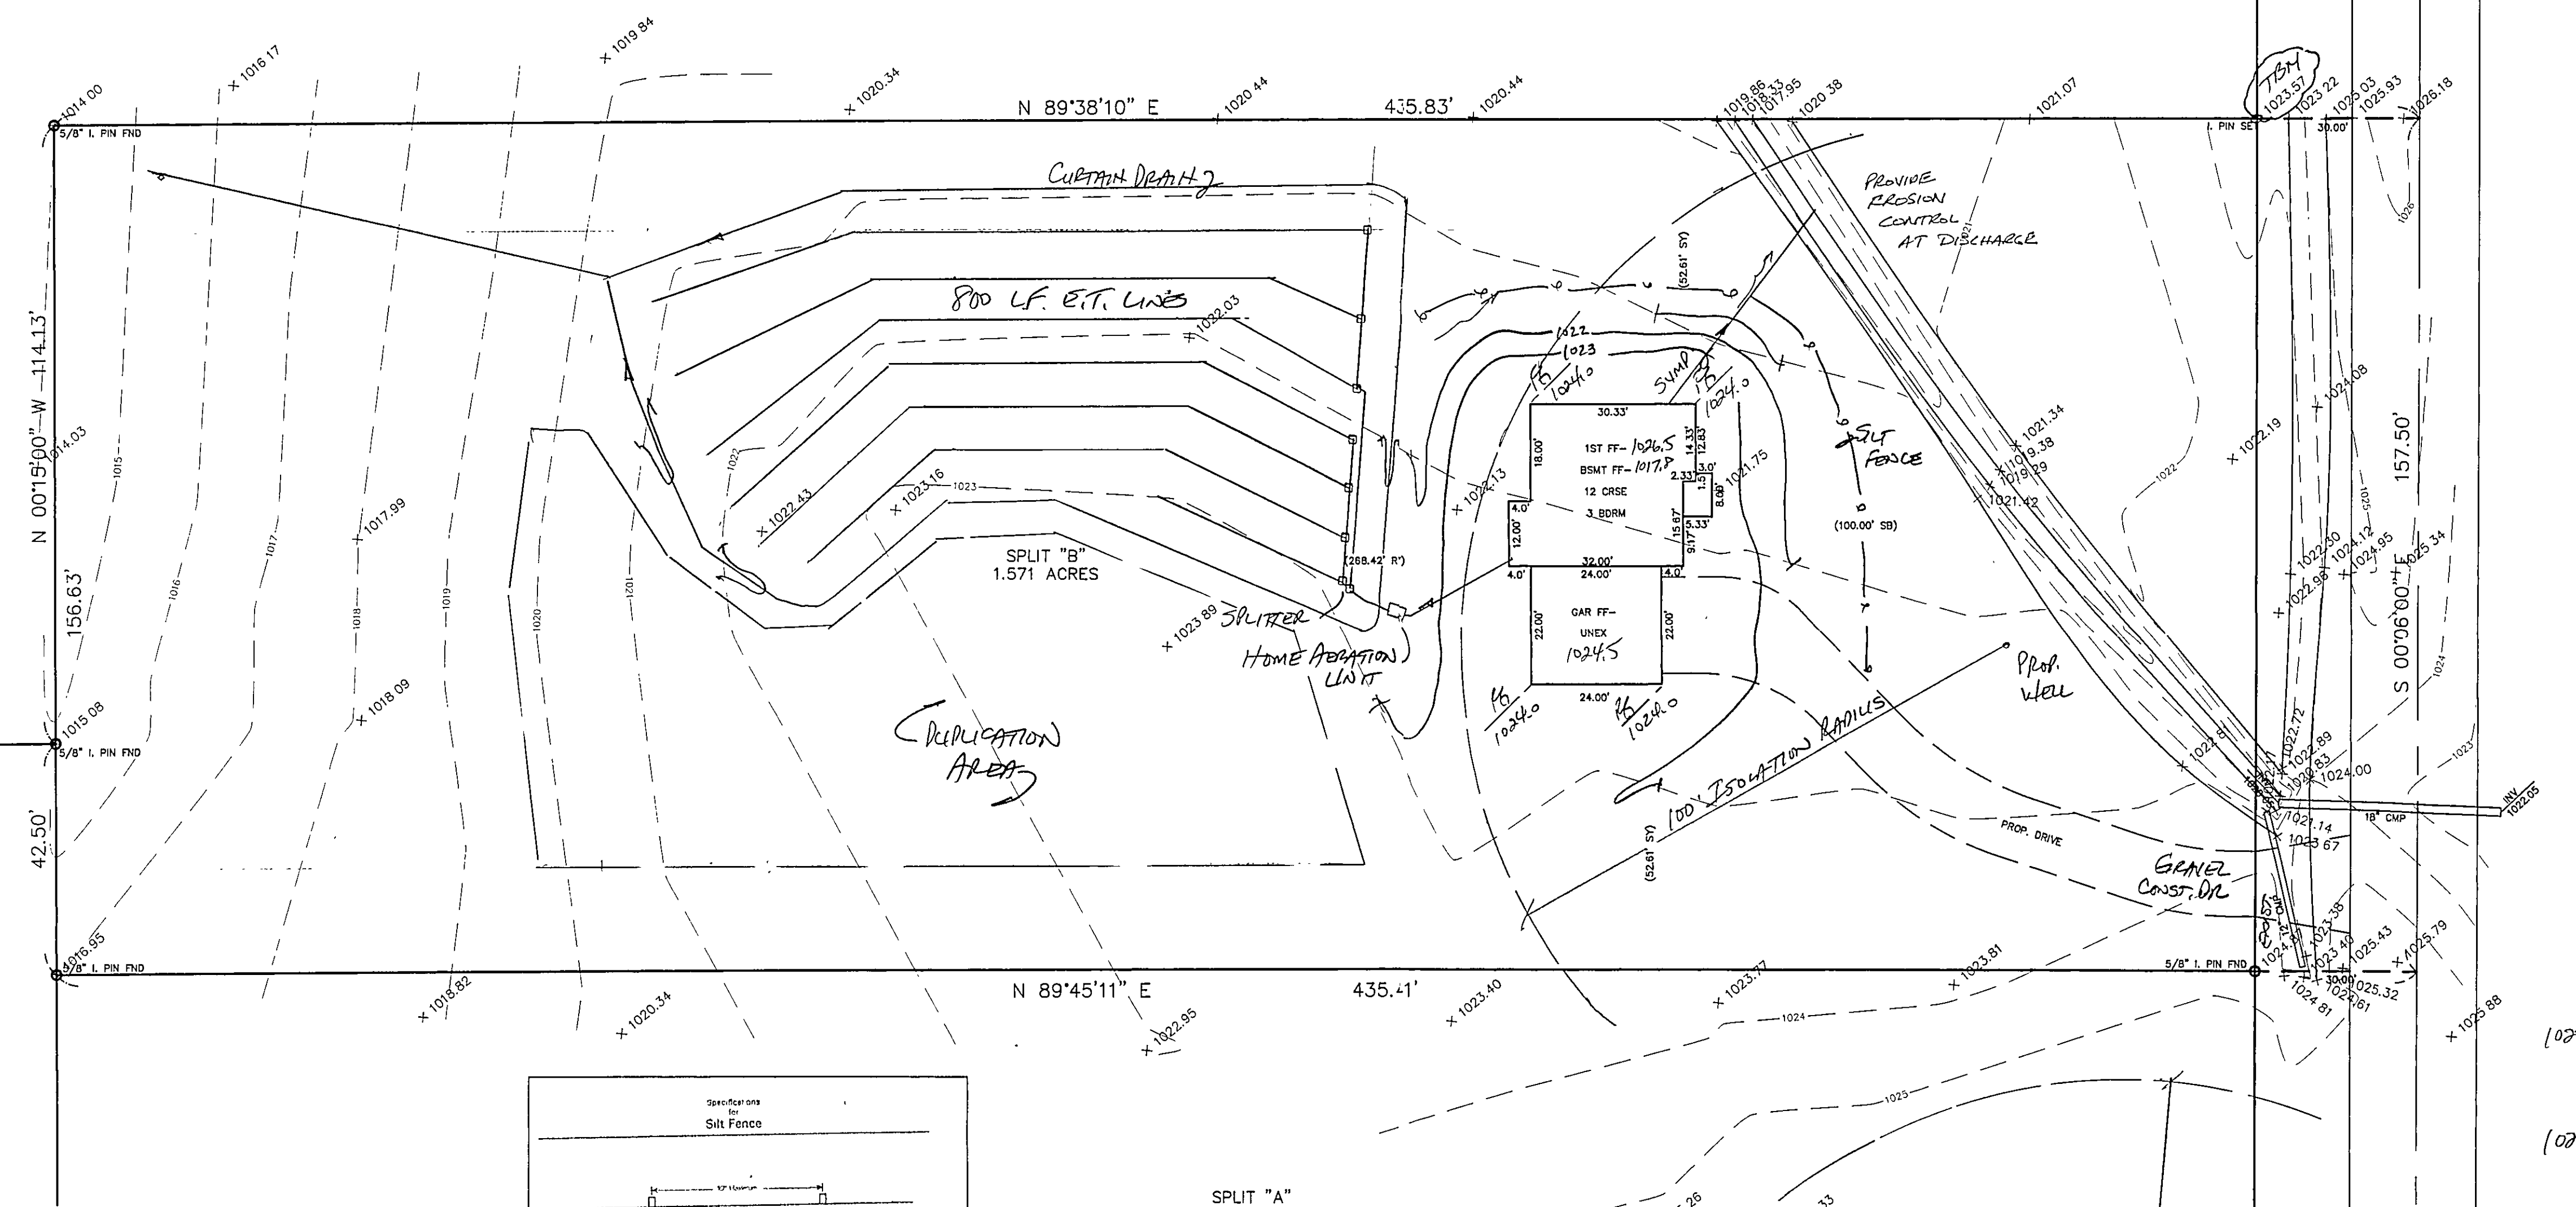



CALLOW ROAD - 60'

This project is exempt from
FSC Plan Review
Date 5-11-04
Lake SWCD

"I, the undersigned hereby certify that
this topography indicated by 6", 1" or 2"
contours, and elevations shown hereon
represent an actual field survey made by
me on the 2nd day of Feb., 2004,
and that the elevations were taken at
appropriate intervals and that as of that
date they existed as indicated hereon."
Name: Holly Jones, P.E. Reg. No. 26343

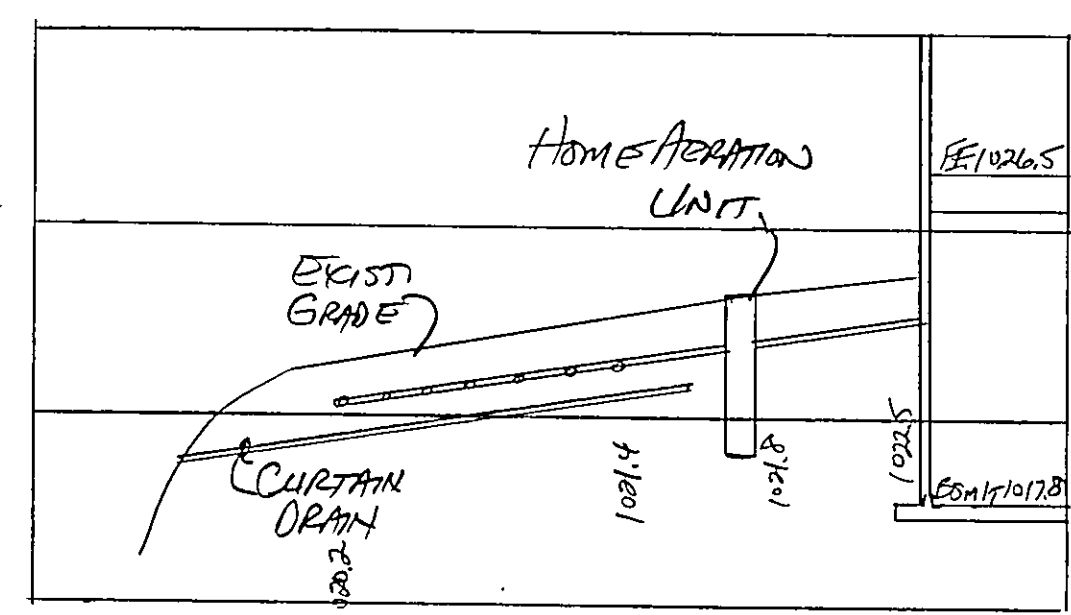

Temporary Seeding Species Selection			
Seeding Dates	Species	Lb./1,000 ft. ²	Per. Ac.
March 1 to August 15	Oats	3	4 bushel
	Tall Fescue	1	40 lb.
	Annual Ryegrass	1	40 lb.
	Perennial Ryegrass	1	40 lb.
	Tall Fescue	1	40 lb.
August 16 to November 1	Rye	3	2 bushel
	Tall Fescue	1	40 lb.
	Annual Ryegrass	1	40 lb.
	Perennial Ryegrass	1	40 lb.
	Tall Fescue	1	40 lb.
November 1 to Spring Seeding	Whorl	3	2 bushel
	Tall Fescue	1	40 lb.
	Annual Ryegrass	1	40 lb.
	Perennial Ryegrass	1	40 lb.
	Tall Fescue	1	40 lb.
Use mulch only, sodding practices or dormant seeding.			
Note: Other approved seed species may be substituted.			

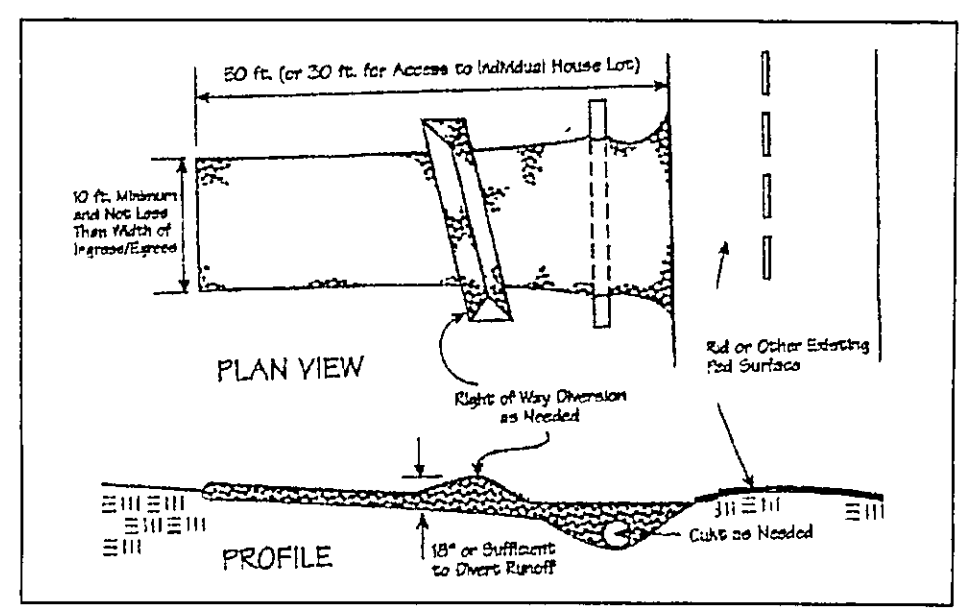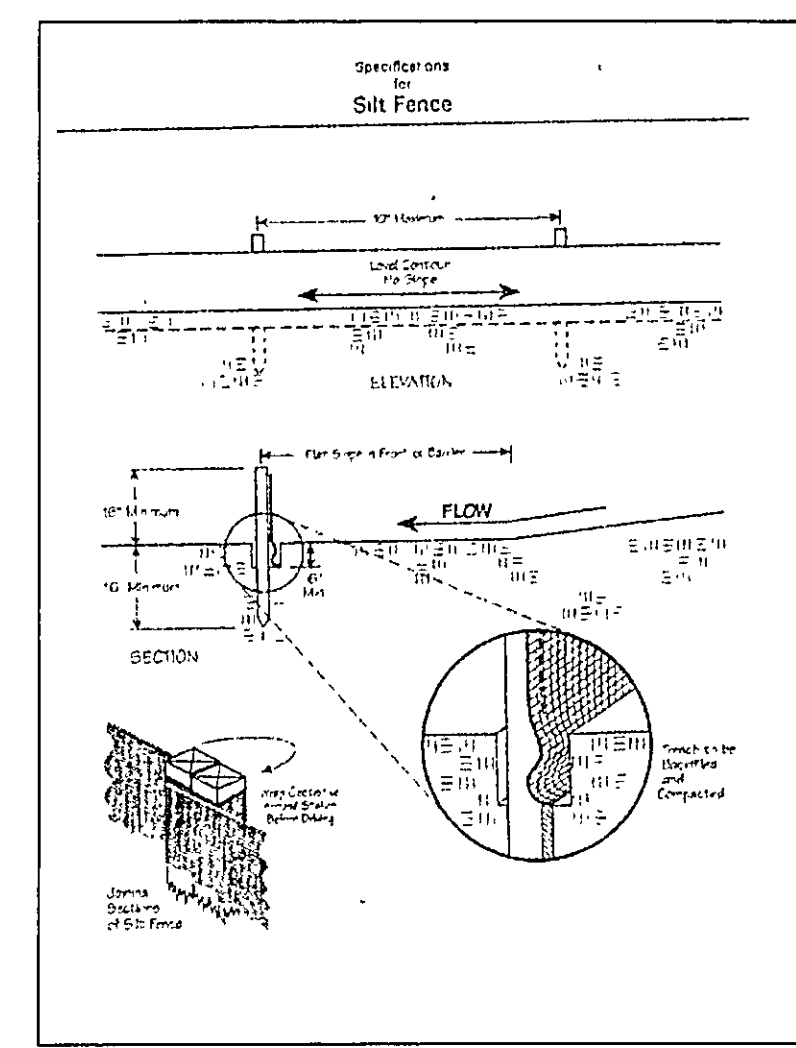

NO.	DESCRIPTION	DATE	BY	CHK'D

ROOF DRAINS
SHALL DISCHARGE
TO SPLASH BLOCKS.

Stormwater Management Plan
Approved as shown and/or noted
JAMES R. GILLS, P.E.
County Drainage Engineer
By: L.S. Date: 5/13/04

babcock BABCOCK, JONES AND ASSOCIATES, INC
CIVIL ENGINEERS - SURVEYORS - LAND PLANNERS
PAINESVILLE OHIO 44077

DATE 2/4/04
DESIGN BY HJ
DRAWN BY NS
APPROVED BY HJ

SITE PLAN 440 254.2204
FOR 216 978 5757
JACK WATERWASH
7800 CALLOW ROAD PARCEL 7A-3-30
LEROY TOWNSHIP LAKE COUNTY STATE OF OHIO



SCALE 1"=20'
JOB NO. 03-116-B
SHEET 1 OF 1