

SITE PLAN

LeRoy Township, Lake County, Ohio

For: Katherine Close

134 W. GILDED ROAD LeRoy, Ohio

ALSO DIVISION VOL. - PG. LOT 10 1/2
SUBLOT NO. STREET TRACT 1/2
PAGE 1/2
REMARKS: As BUILT

LEGEND

SANITARY MANHOLE ---
STORM MANHOLE ---
INLET OR CATCH BASIN ---
HYDRANT ---
EXISTING CONTOURS ---
PROPOSED CONTOURS ---
EXIST. ELEV. ---
PROP. ELEV. ---
INDICATES DIRECTION OF SURFACE DRAINAGE

REMARKS

ALL BOUNDARY DATA SHOWN WAS OBTAINED FROM IDEEDS, RECORDED SUBDIVISION PLAT OR OTHER PUBLIC RECORDS.
LOCATIONS AS SHOWN OF ADJACENT WELLS AND SEPTIC TANKS OBTAINED FROM LAKE COUNTY HEALTH DEPARTMENT

DESIGN CERTIFICATION

THIS PLAN WAS PREPARED BY ME, AND IS CORRECT TO THE BEST OF MY KNOWLEDGE AND BELIEF

CHECK LIST

NO. OF BEDROOMS
SEPTIC TANKS
TIE TO NEAREST STREET
SUBLOT NO. PARCEL NO.
ADJACENT OWNERS
BLDG. DIMENSIONS FIN. OR
ALSO, TYPE & SIZE OF SEPTIC TANKS
SEPTIC TANK LOCATION
WELL LOCATION
ISOLATION RADII FROM WELL

PLAN PREPARED BY:

BABCOCK • JONES & ASSOCIATES, INC.

NO.	DATE	BY
1	4/21/79	HT
2	7/26/79	HT
3		
4		
5		

"AS BUILT" CERTIFICATION

I, HEREBY CERTIFY THAT THE CIRCLED GRADES ARE EXISTING FINISH GRADES CHECKED IN THE FIELD ON 19 1989 AND ARE CORRECT TO THE BEST OF MY KNOWLEDGE AND BELIEF.

REGISTERED SURVEYOR REG. NO. 357-1811


LOW YIELD WATER

FIXTURES REQUIRED

Shower Head
Toilet

JOEL LUCA, R. S., M. P., H.
Health Commissioner
Date 7-27-89

SEWAGE DISPOSAL PERMIT MUST BE OBTAINED BY A LAKE COUNTY LICENSED INSTALLER BEFORE INSTALLATION IS STARTED.

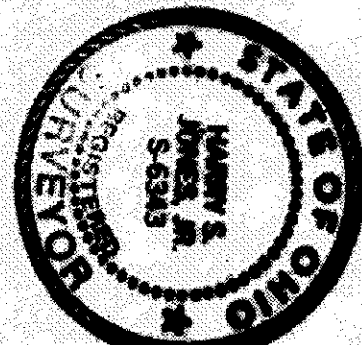


HYDRAULIC PROFILE

SCALE: HORIZ: 1"=30'
VERT: 1"=5'

Existing From Approved
Sanitary Sewer and
Storm Sewer
THOMAS P. GILLES, P.E.
Lake County Engineer
G.S.H. 13189

1.24" DRIVE CULVERT REQUIRED
2 SWALE AS SHOWN

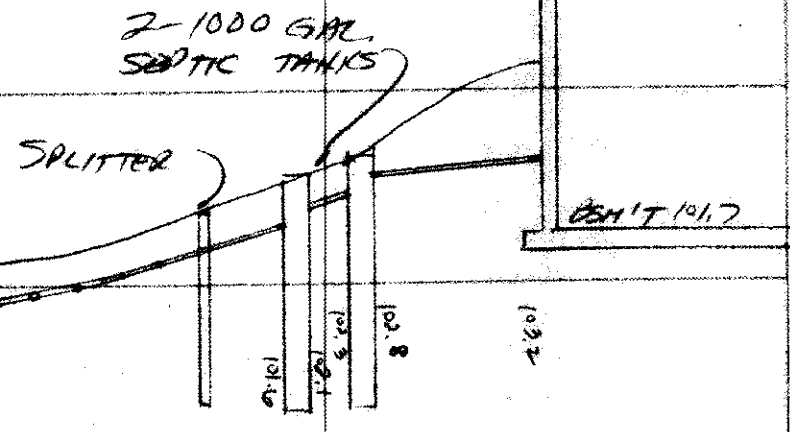

GILDED ROAD - 60'

JOEL LUCA
#10099