


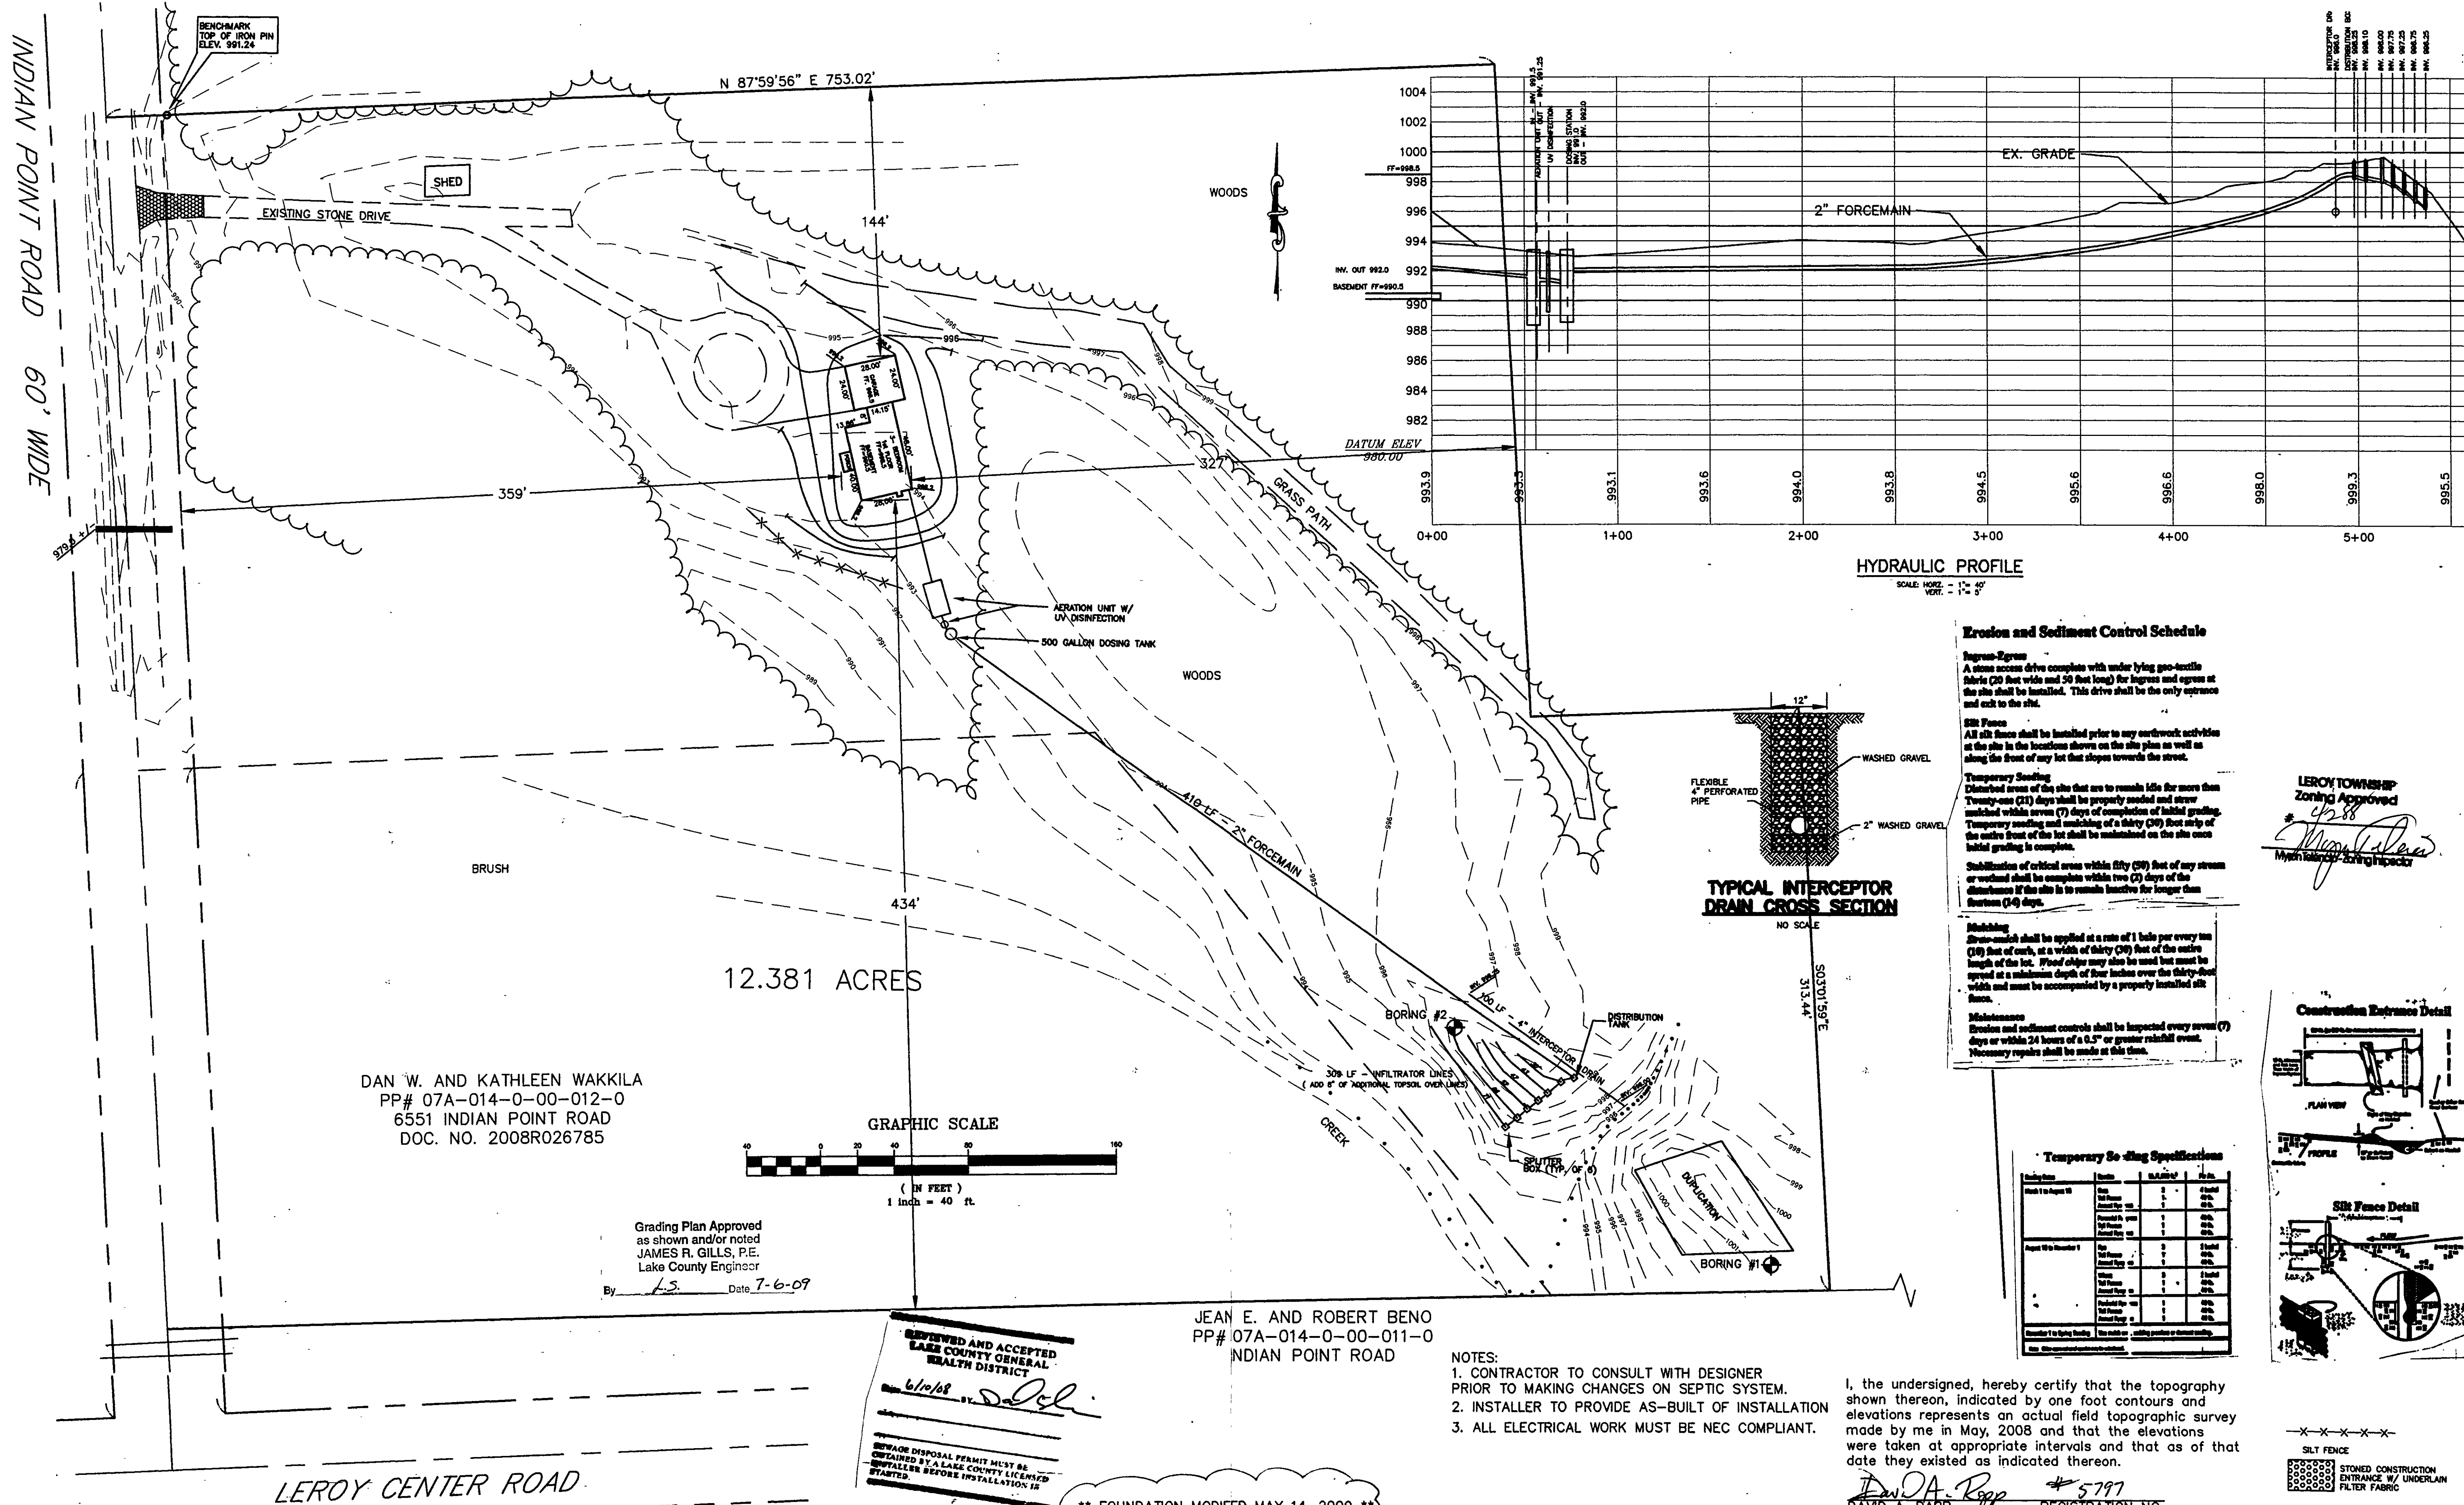

Erosion and Sediment Control Schedule

Access-Egress
A stone access drive compliant with under lying geo-textile fabric (20 feet wide and 50 feet long) for ingress and egress at the site shall be installed. This drive shall be the only entrance and exit to the site.

Silt Fence
All silt fence shall be installed prior to any earthwork activities at the site in the locations shown on the site plan as well as along the front of any lot that slopes towards the street.



Temporary Seeding
Disturbed areas of the site that are to remain idle for more than Twenty-one (21) days shall be properly seeded and mowed within seven (7) days of completion of initial grading. Temporary seeding and mulching of a thirty (30) foot strip of the entire front of the lot shall be maintained on the site once initial grading is complete.

Stabilization of critical areas within fifty (50) feet of any stream or wetland shall be completed within two (2) days of the disturbance if the site is to remain inactive for longer than fourteen (14) days.

Mulching
Grass-mulch shall be applied at a rate of 1 bale per every ten (10) feet of curb, at a width of thirty (30) feet of the entire length of the lot. Flood chips may also be used but must be spread at a minimum depth of four inches over the thirty-foot width and must be accompanied by a properly installed silt fence.

Maintenance
Erosion and sediment controls shall be inspected every seven (7) days or within 24 hours of a 0.5" or greater rainfall event. Necessary repairs shall be made at this time.

LEROY TOWNSHIP
Zoning Approved
4/28/08
Myra J. Davis
Municipal Zoning Inspector

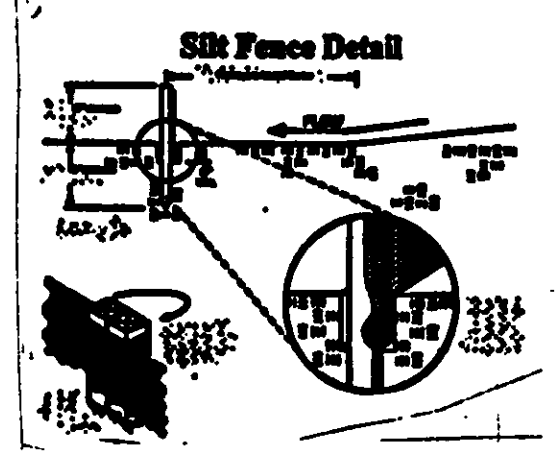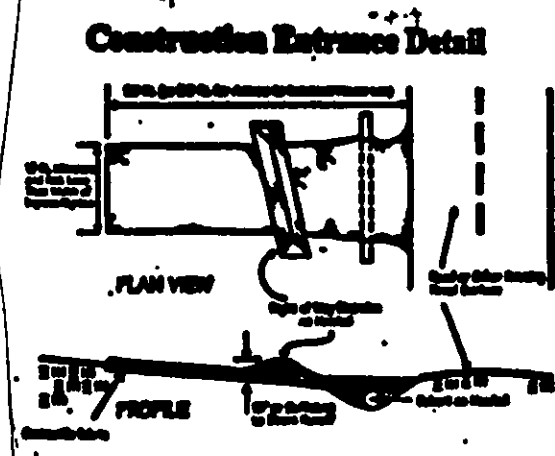

Temporary Seeding Specifications


Seeding Area	Rate	Material	Notes
Grass	100 lbs/acre	Grass Seed	Grass Seed
Grass	100 lbs/acre	Grass Seed	Grass Seed
- NOTES:
1. CONTRACTOR TO CONSULT WITH DESIGNER PRIOR TO MAKING CHANGES ON SEPTIC SYSTEM.
 2. INSTALLER TO PROVIDE AS-BUILT OF INSTALLATION
 3. ALL ELECTRICAL WORK MUST BE NEC COMPLIANT.

I, the undersigned, hereby certify that the topography shown thereon, indicated by one foot contours and elevations represents an actual field topographic survey made by me in May, 2008 and that the elevations were taken at appropriate intervals and that as of that date they existed as indicated thereon.

DAVID A. RAPP #5797
REGISTRATION NO.

DAVID RAPP SERVICES
3406 DAYTON ROAD
MADISON, OHIO 44057
440-983-1607

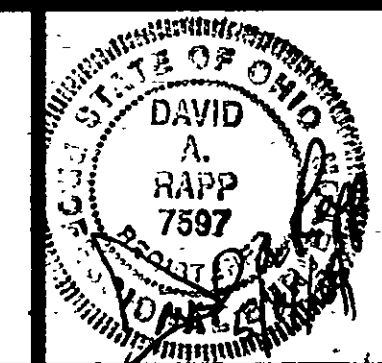

DATE: May, 2008
DRAWN BY: DAR
CHECKED BY:
APPROVED BY:
PE No. P.E. NO. 62081

DAN WAKKILA
PP# 07A-014-0-00-012-0
LEROY TOWNSHIP, OHIO

**SITE PLAN AND
SEPTIC SYSTEM IMPROVEMENTS**

Hor. Scale 1" = 40'
Vert. Scale 1" = 5'
CONTRACT No. 28027
SHEET No. 1 OF 2