
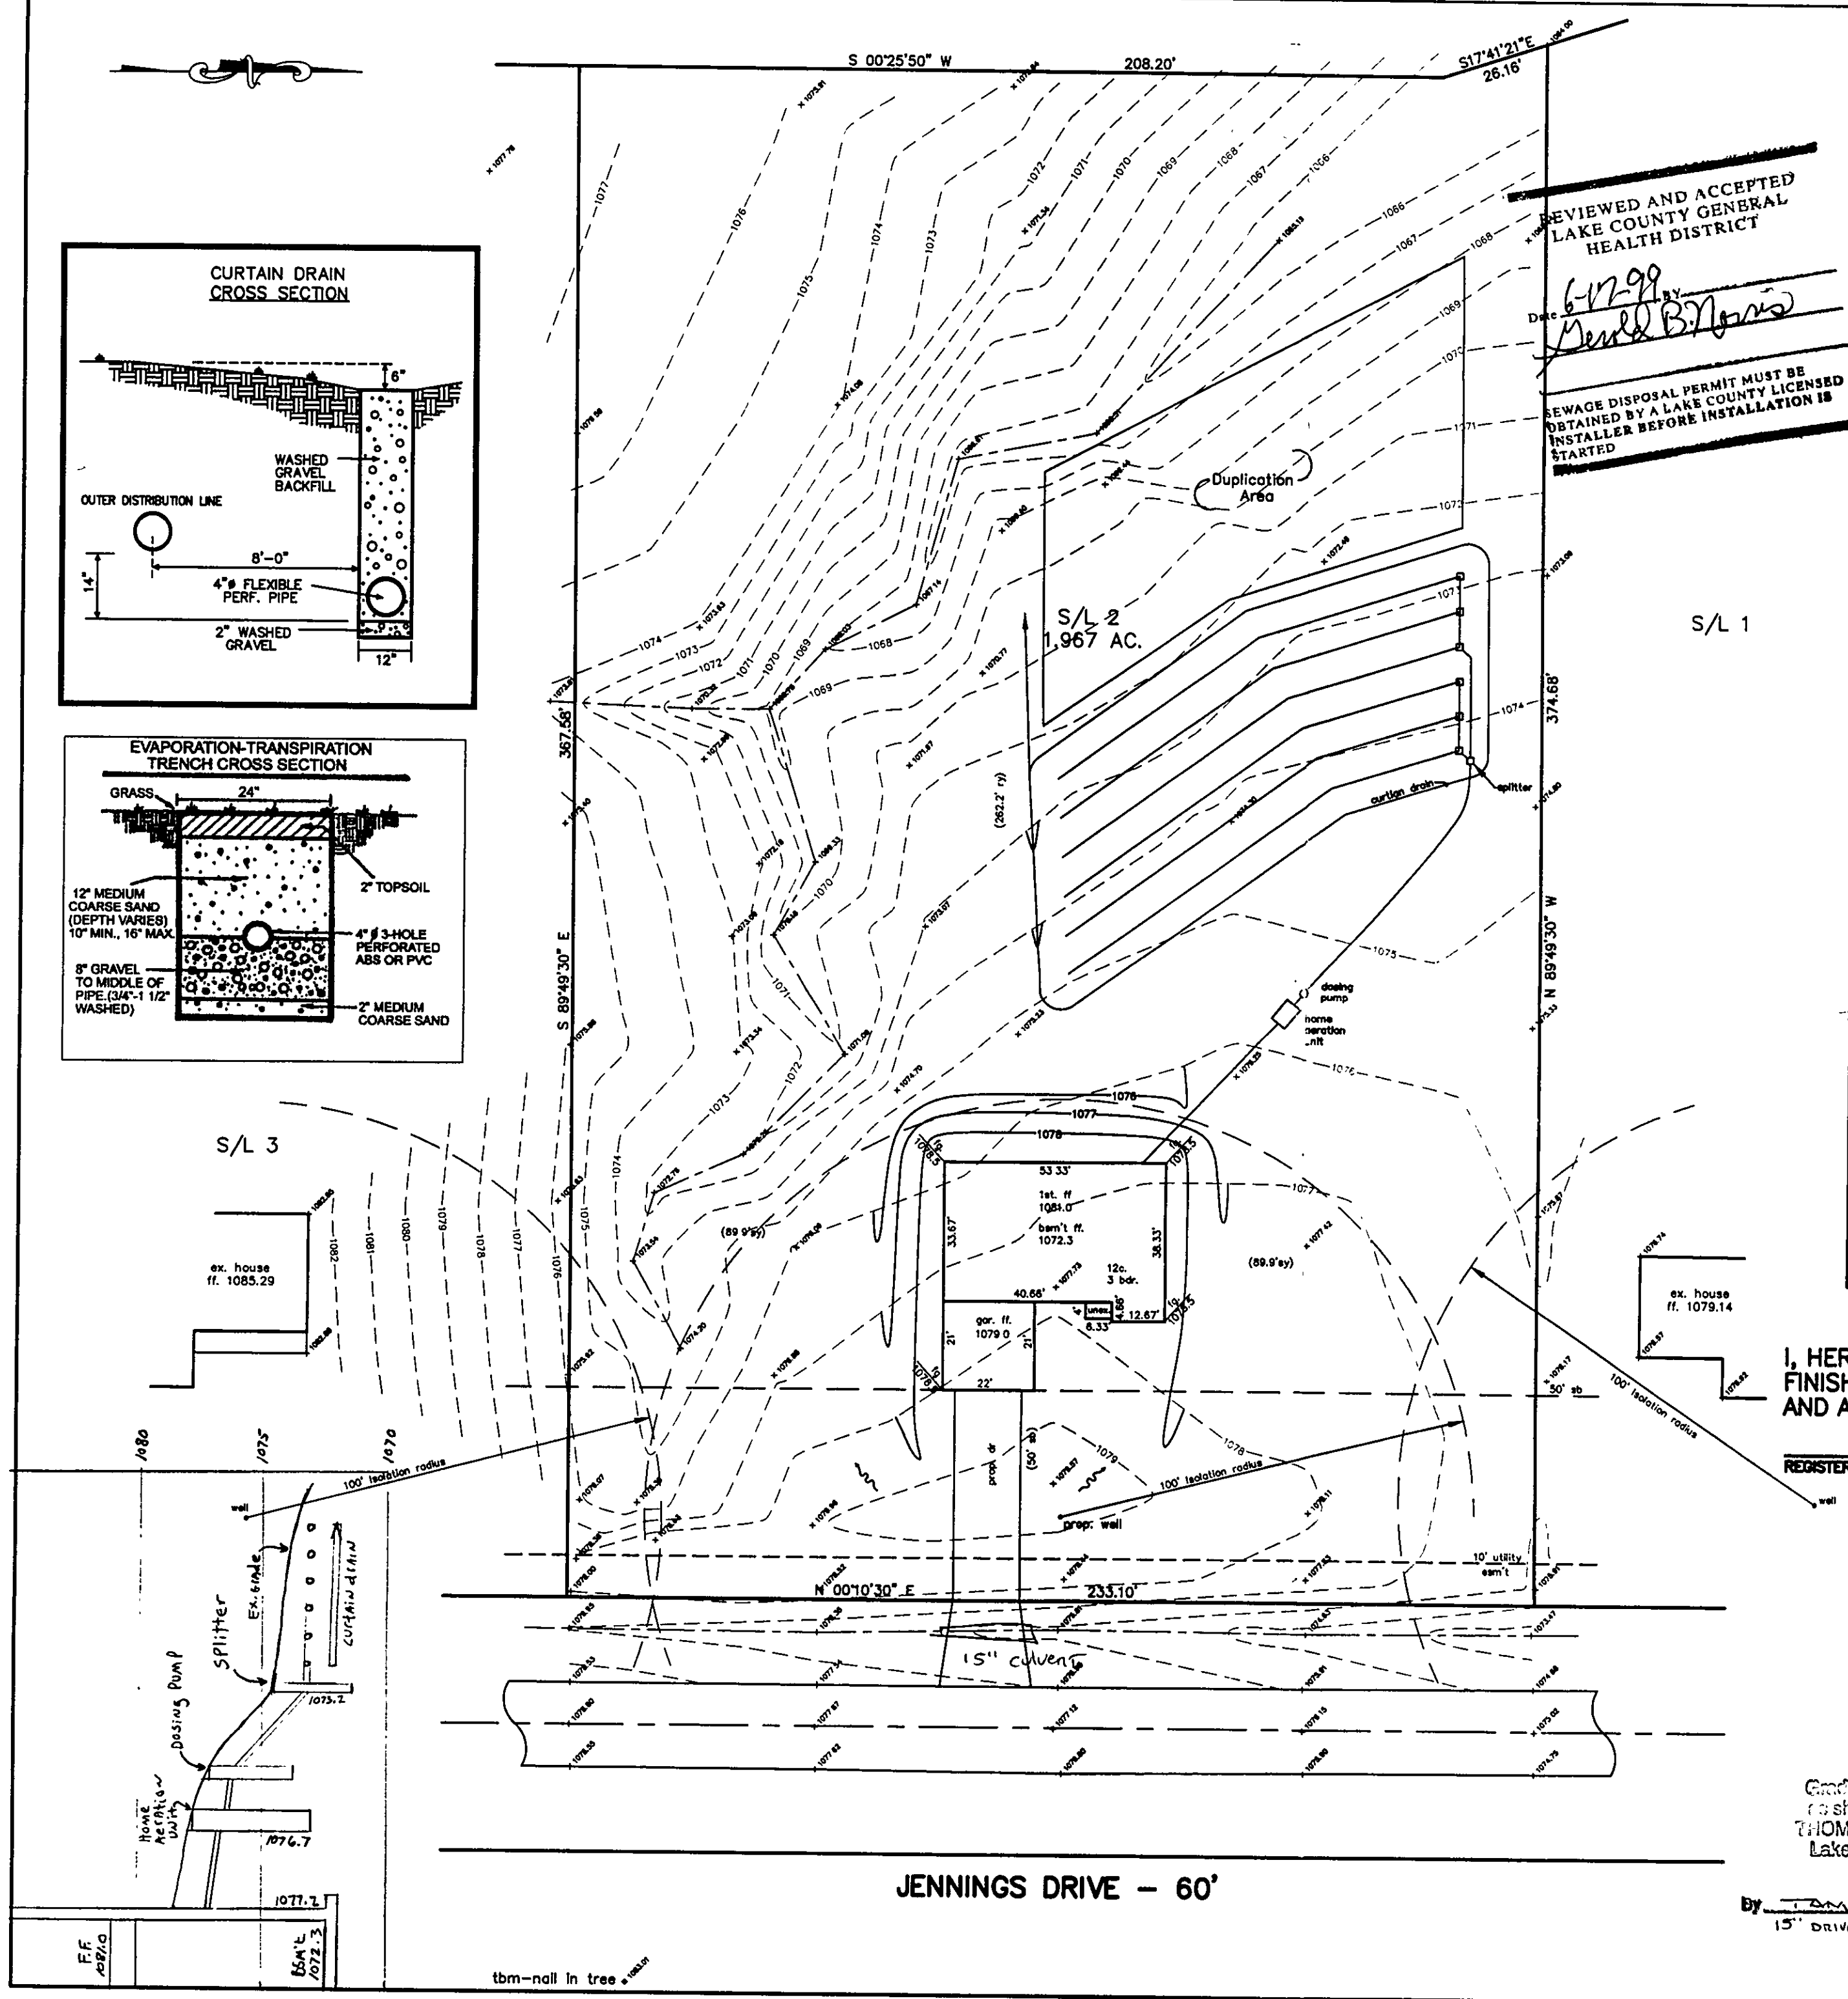
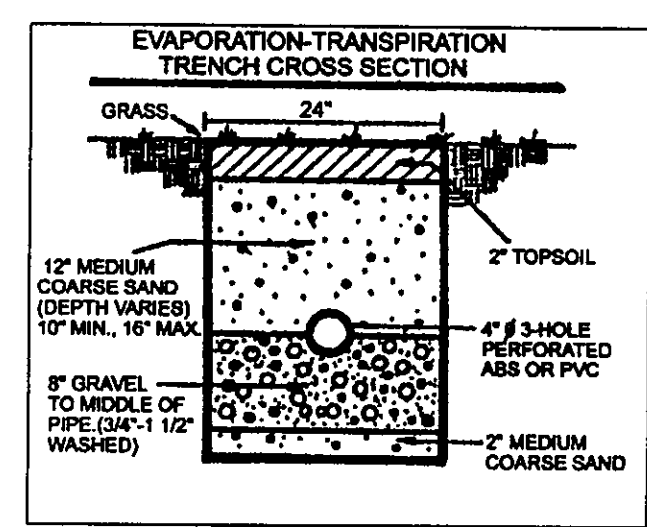


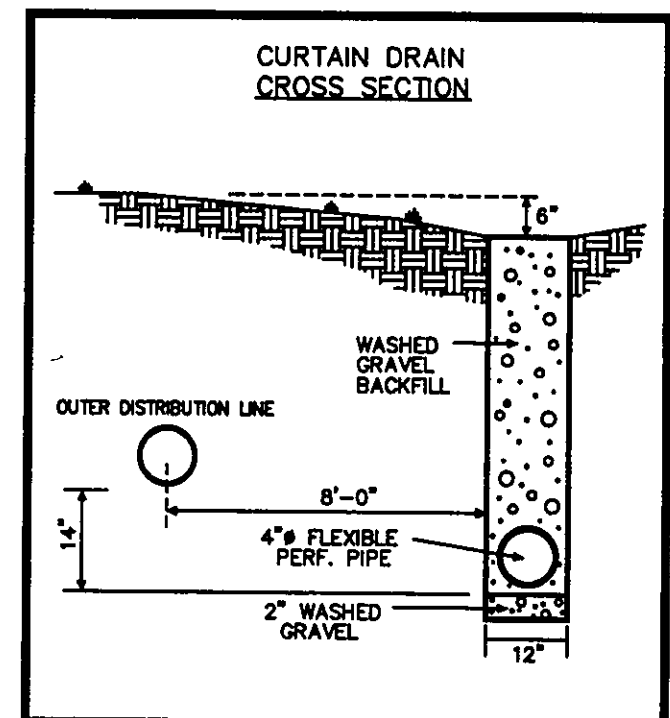

SITE PLAN

LEROY TOWNSHIP, LAKE COUNTY, OHIO

for: WILSHIRE HOMES, INC.

CLIENT: _____ OWNER: _____

ADDRESS: _____ STREET: _____ CITY: _____ ZIP: _____

EAGLEBROOK

SUBDIVISION: **24-7** NAME: _____ TRACT: _____ STREET: _____

2 VOL-PG. **JENNINGS DR.** LOT: _____

SUBLOT NO. _____ STREET: _____ VOL-PG. _____ PERM. PARCEL NO. _____

LEGEND

SANITARY MANHOLE: EXIST. ELEV. $\rightarrow$ 100.0 AS BUILT ELEVATION $\rightarrow$ 100.0 $\rightarrow$ PROP. ELEV.

STORM MANHOLE:

INLET OR CATCH BASIN:

HYDRANT:

EXISTING CONTOURS:

PROPOSED CONTOURS:

INDICATES DIRECTION OF SURFACE DRAINAGE:

REMARKS

ALL BOUNDARY DATA SHOWN WAS OBTAINED FROM (DEEDS, RECORDED SUBDIVISION PLAT OR OTHER PUBLIC RECORDS)

LOCATIONS AS SHOWN OF ADJACENT WELLS AND SEPTIC TANKS OBTAINED FROM LAKE COUNTY HEALTH DEPARTMENT

DESIGN CERTIFICATION

THIS PLAN WAS PREPARED BY ME, AND IS CORRECT TO THE BEST OF MY KNOWLEDGE AND BELIEF.

William C. Babcock PS#6528

NAME: _____ SURVEYOR: _____ REGISTRATION NO. _____

CHECK LIST

NO. OF BEDROOMS	WATER MAIN SIZE, LOCATION
DIMENSIONS	SAN. SEWER SIZE & GR. LOC.
BEARINGS	SAN. MH. CAST. ELEV. INV. ELEV.
TIE TO NEAREST STREET	SAN. CONN. SIZE, LOC. DEPTH
SUBLOT NO. PARCEL NO.	STORM SEWER SIZE & GR. LOC.
SURROUNDING OWNERS	STORM MH. CAST. ELEV. INV. ELEV.
BLDG. DIMENSIONS FIN GR.	PAV'T TYPE GRADE CURBS
BLDG. TIES FL'R. GRADES	GAS LINE LOC. SIZE PRESSURE
APRON TYPE WIDTH THICKNESS	SEPTIC TANK LOCATION & DUPLICATION AREA
SEWER TYPE WIDTH THICKNESS	WELL LOCATION
CULVERT TYPE DIA., LENGTH	ISOLATION RADIUS FROM WELL
ROCK OUTCROPPINGS	

REVISIONS

NO.	DATE	BY
1		
2		
3		
4		
5		

PLAN PREPARED BY:

babcock JONES & ASSOCIATES, INC.

PAINESVILLE, OHIO

DRAWN BY: T.R. SCALE: 1"=30' PHONE NO. 440-357-1811

CHK'D: H.J. DATE: 5/27/99 DRAWING NO. 95-027-02

CREW CHIEF: K.J. APP'D: W.B.

"AS BUILT" CERTIFICATION

I, HEREBY CERTIFY THAT THE CIRCLED GRADES ARE EXISTING FINISH GRADES CHECKED IN THE FIELD ON _____, 19____, AND ARE CORRECT TO THE BEST OF MY KNOWLEDGE AND BELIEF.

REGISTERED SURVEYOR: _____ REG. NO. _____

TBM-NAIL IN TREE ELEV.=1083.00

STATE OF OHIO

WILLIAM C. BABCOCK

S-6528

REGISTERED SURVEYOR

William C. Babcock #6528

Name: _____ Reg. No. _____

Grading Plan Approved as shown and/or noted by: **THOMAS P. GILLES, P.E.** Lake County Engineer

By: *Tom* Date: 7/27/99

15' DRIVE CULVERT req'd.

"I, the undersigned hereby certify that this topography, indicated by 6", 1", or 2" contours, and elevations shown hereon represent an actual field survey made by me on the 26 day of MAY, 1999, and that the elevations were taken at appropriate intervals and that as of that date they existed as indicated hereon."