

SITE PLAN

LERROY TOWNSHIP, LAKE COUNTY, OHIO

for: WILSHIRE HOMES

ADDRESS STREET CITY ZIP

EAGLE BROOK SUB. NAME LOT TRACT

SUBDIVISION VOL. PG. JENNINGS DR. VOLUME PAGE

SUBLOT NO. STREET PERM. PARCEL NO. STREET

LEGEND

EXIST. ELEV. 5'-100.8 ± PROP. ELEV.

AS BUILT ELEVATION

INDICATES DIRECTION OF SURFACE DRAINAGE

SANITARY MANHOLE

STORM MANHOLE

INLET OR CATCH BASIN

HYDRANT

EXISTING CONTOURS

PROPOSED CONTOURS

REMARKS

ALL BOUNDARY DATA SHOWN WAS OBTAINED FROM (DEEDS, RECORDED SUBDIVISION PLAT OR OTHER PUBLIC RECORDS) LOCATIONS AS SHOWN OF ADJACENT WELLS AND SEPTIC TANKS OBTAINED FROM LAKE COUNTY HEALTH DEPARTMENT

DESIGN CERTIFICATION

THIS PLAN WAS PREPARED BY ME, AND IS CORRECT TO THE BEST OF MY KNOWLEDGE AND BELIEF.

NAME SURVEYOR REGISTRATION NO.

CHECK LIST

NO. OF BEDROOMS
DIMENSIONS
BEARINGS
THE TO NEAREST STREET
SUBLOT NO. PARCEL NO.
SURROUNDING OWNERS
BLDG. DIMENSIONS FIN GR.
BLDG. TIES F.L.R. GRADES
APPROX. TYPE WIDTH THICKNESS
SEWER TYPE WIDTH THICKNESS
CURVE TYPE DIA. LENGTH
ROCK OUTCROPPINGS
WATER MAIN SIZE, LOCATION
SAN. SEWER SIZE & GR. LOC.
SAN. MH. CAST. ELEV. INV. ELEV.
SAN. CONN. SIZE, LOC. DEPTH
STORM SEWER SIZE & GR. LOC.
STORM MH. CAST ELEV. INV. ELEV.
PAV'T TYPE GRADE CURVES
GAS LINE LOC. SIZE PRESSURE
SEPTIC TANK LOCATION & DUPLICATION AREA
WELL LOCATION
ISOLATION RADIUS FROM WELL

NO. DATE BY

1 2 3 4 5

DATE BY

1 2 3 4 5

DATE BY

1 2 3 4 5


DATE BY

1 2 3 4 5




DATE BY

1 2 3 4 5

DATE BY

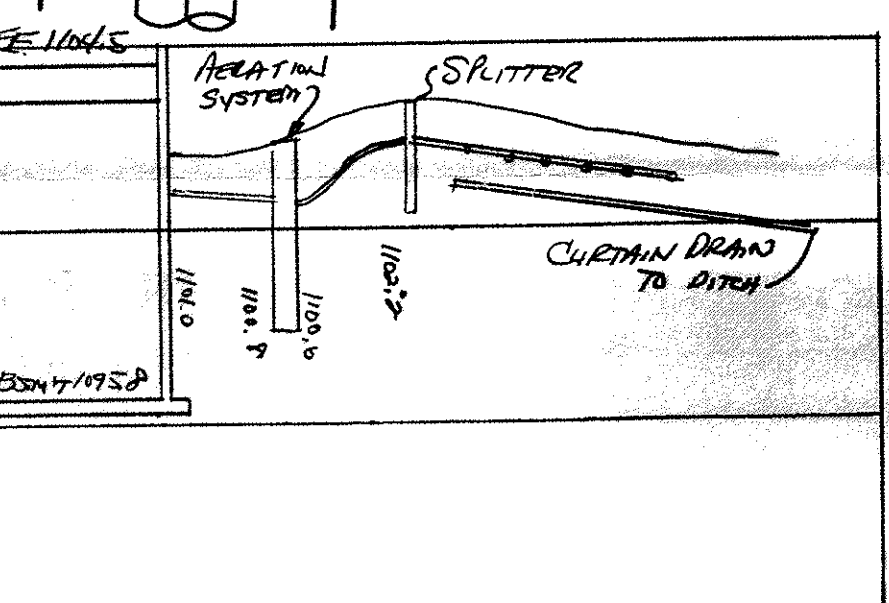

HYDRAULIC PROFILE

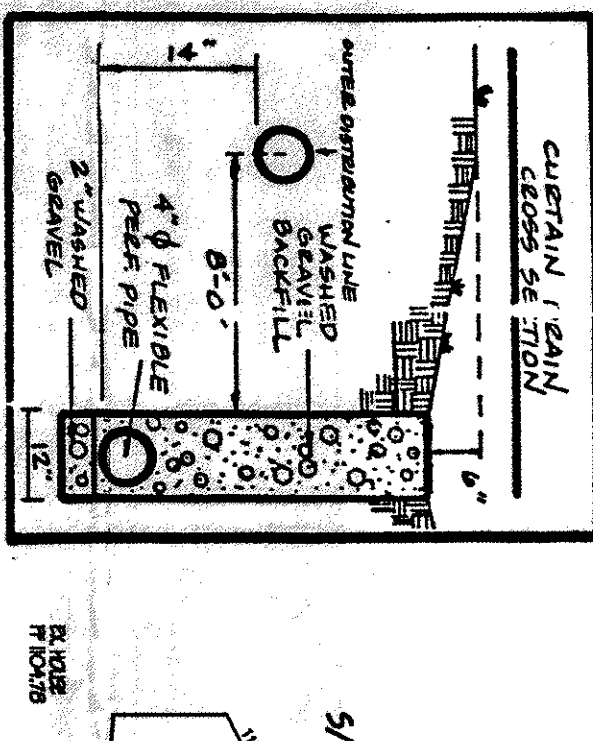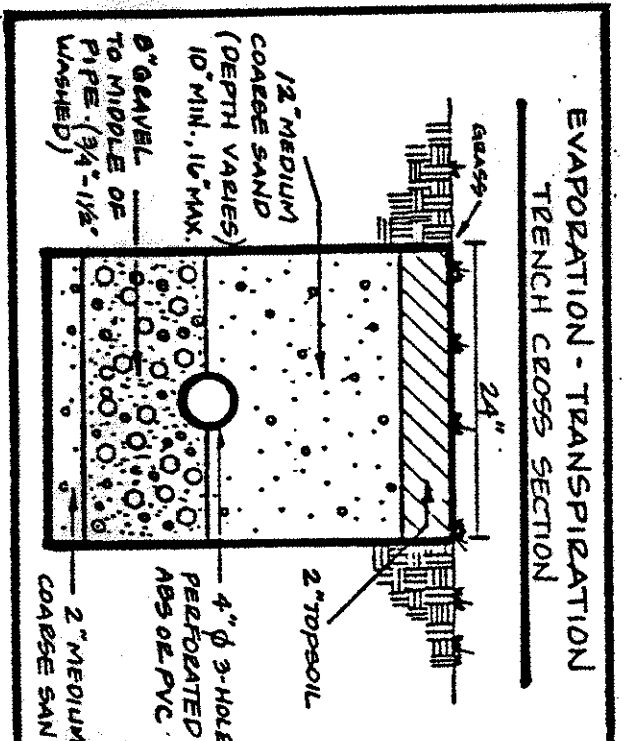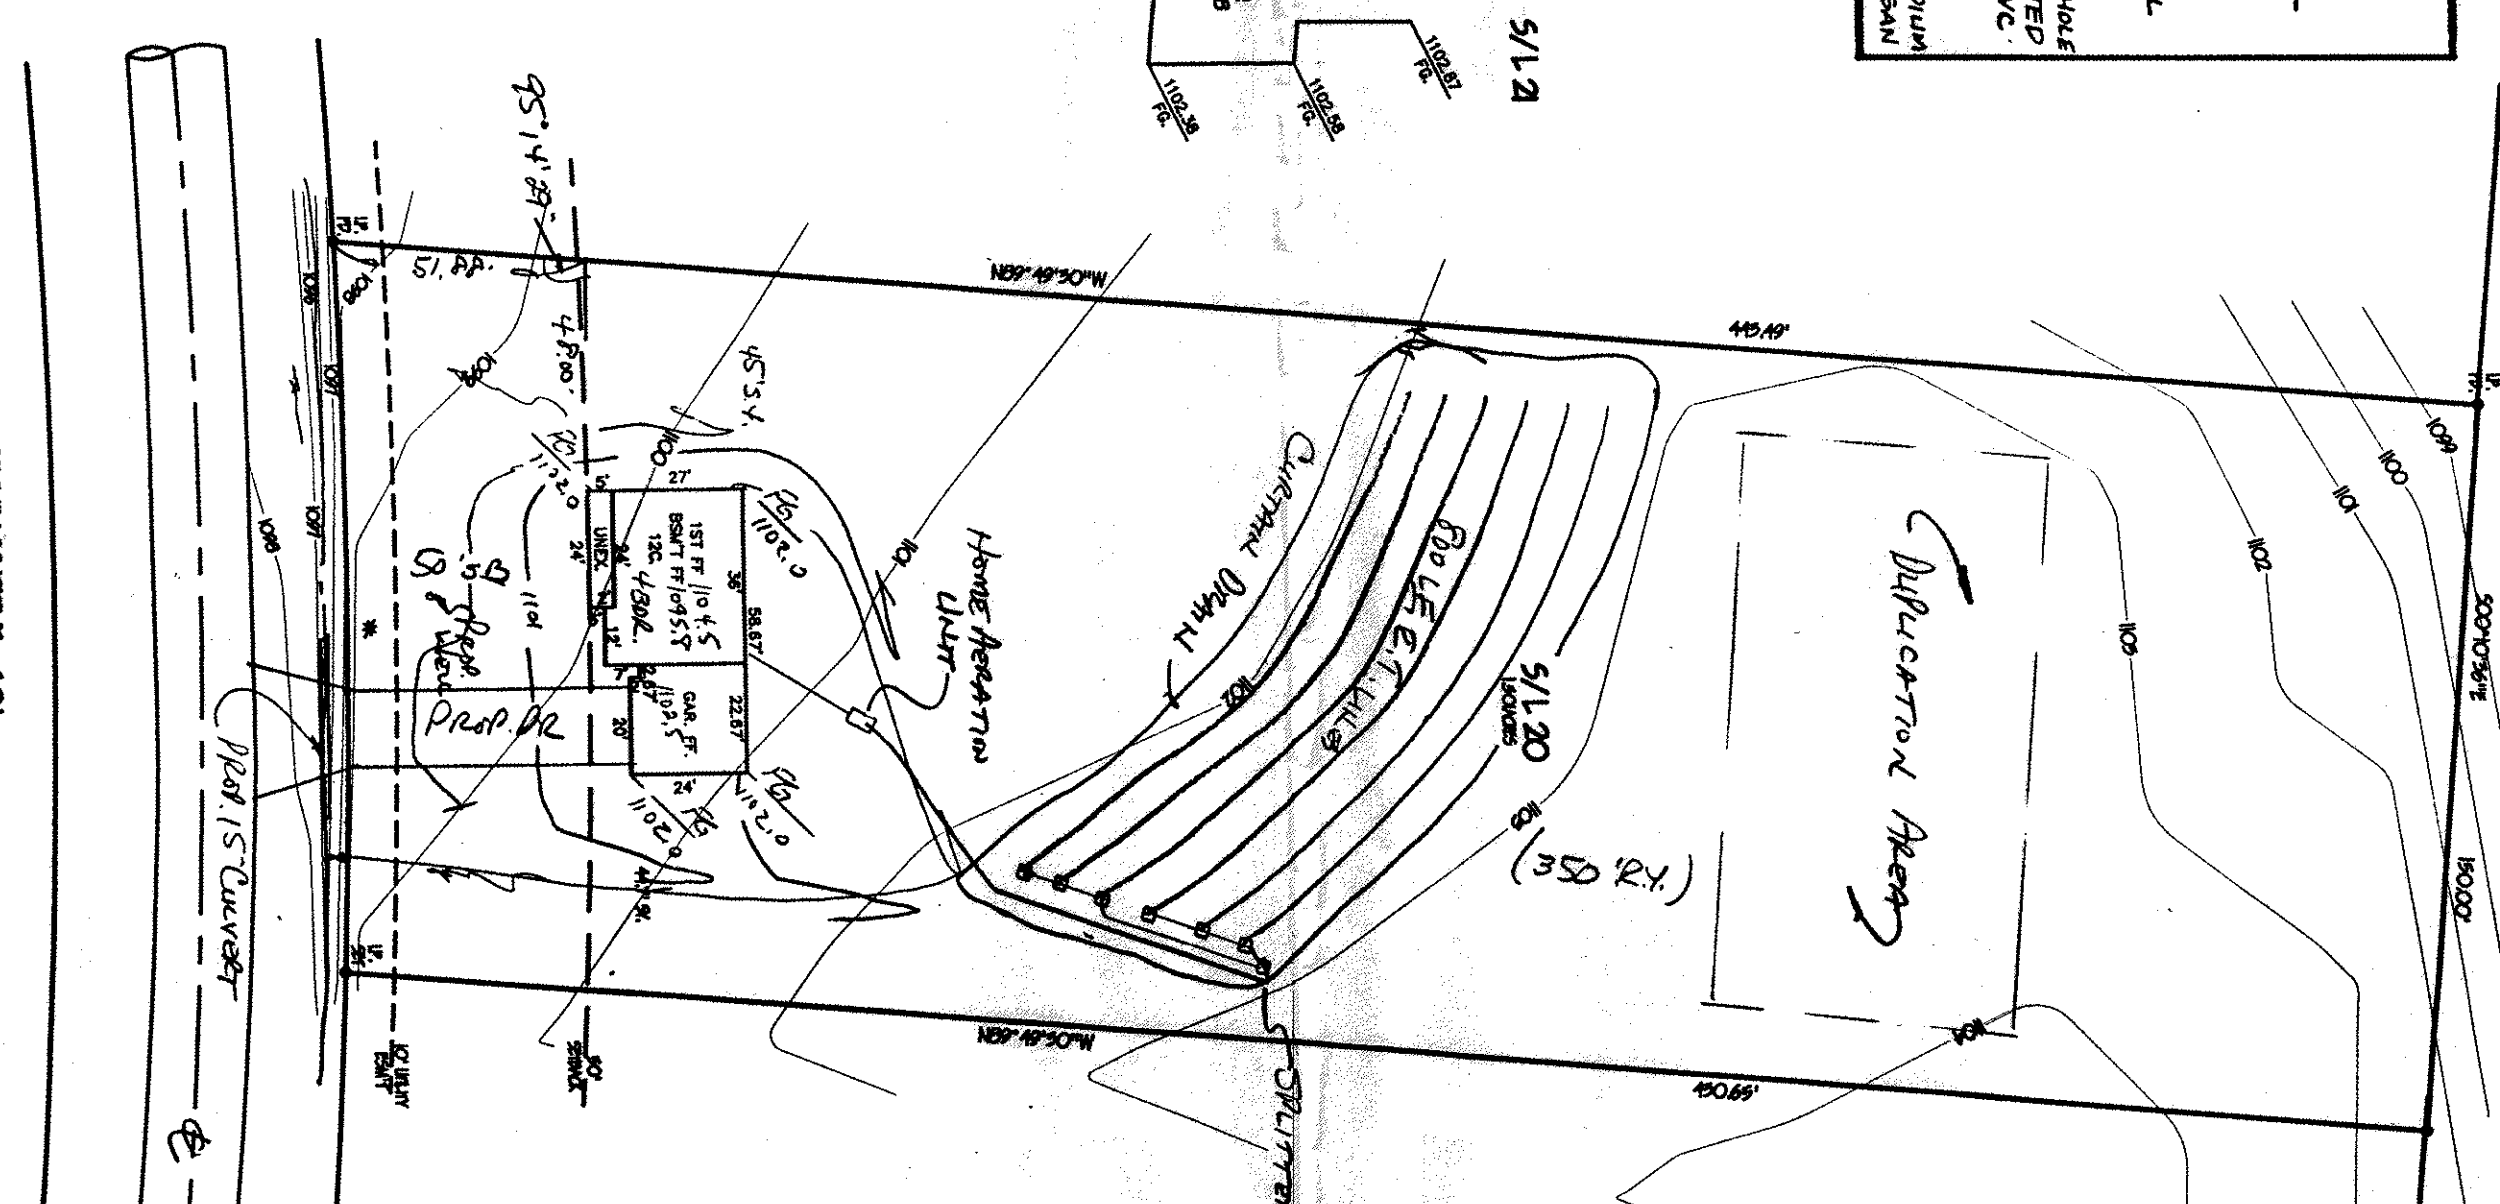

REVIEWED AND ACCEPTED
LAKE COUNTY GENERAL
HEALTH DISTRICT
Date: 11/17/97 by Donald L. Loepp
Loop handle 18' deep

SEWAGE DISPOSAL PERMIT MUST BE
OBTAINED BY A LICENSED INSTALLER
BEFORE INSTALLATION IS
STARTED.

"AS BUILT" CERTIFICATION
I, HEREBY CERTIFY THAT THE CIRCLED GRADES ARE EXISTING
FINISH GRADES CHECKED IN THE FIELD ON 19
AND ARE CORRECT TO THE BEST OF MY KNOWLEDGE AND BELIEF.

REGISTERED SURVEYOR REG. NO.

TRIM-NAL PD IN TREE S/L
21 ELEV. = 1098.00

Grading Plan Approved
as shown and/or noted
THOMAS P. GILLES, P.E.
Lake County Engineer
By: J.H. Date: 12-1-97
Name: J.H. Reg. No. 6343

LERROY TOWNSHIP
Zoning 40
Zoning Inspector

