
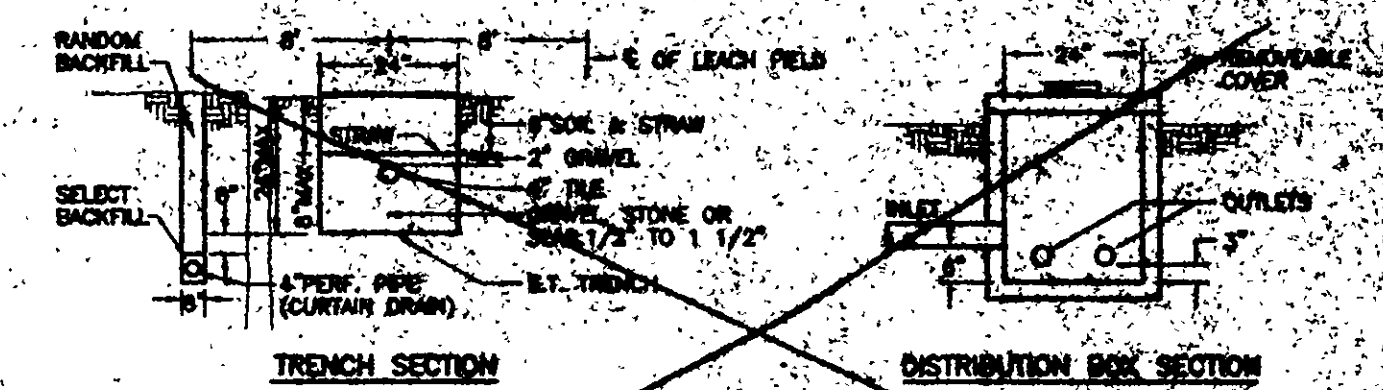


1" = 40'

NOTES: 1. LAKE COUNTY HEALTH DISTRICT AND EPA RULES AND STANDARDS ARE TO BE USED

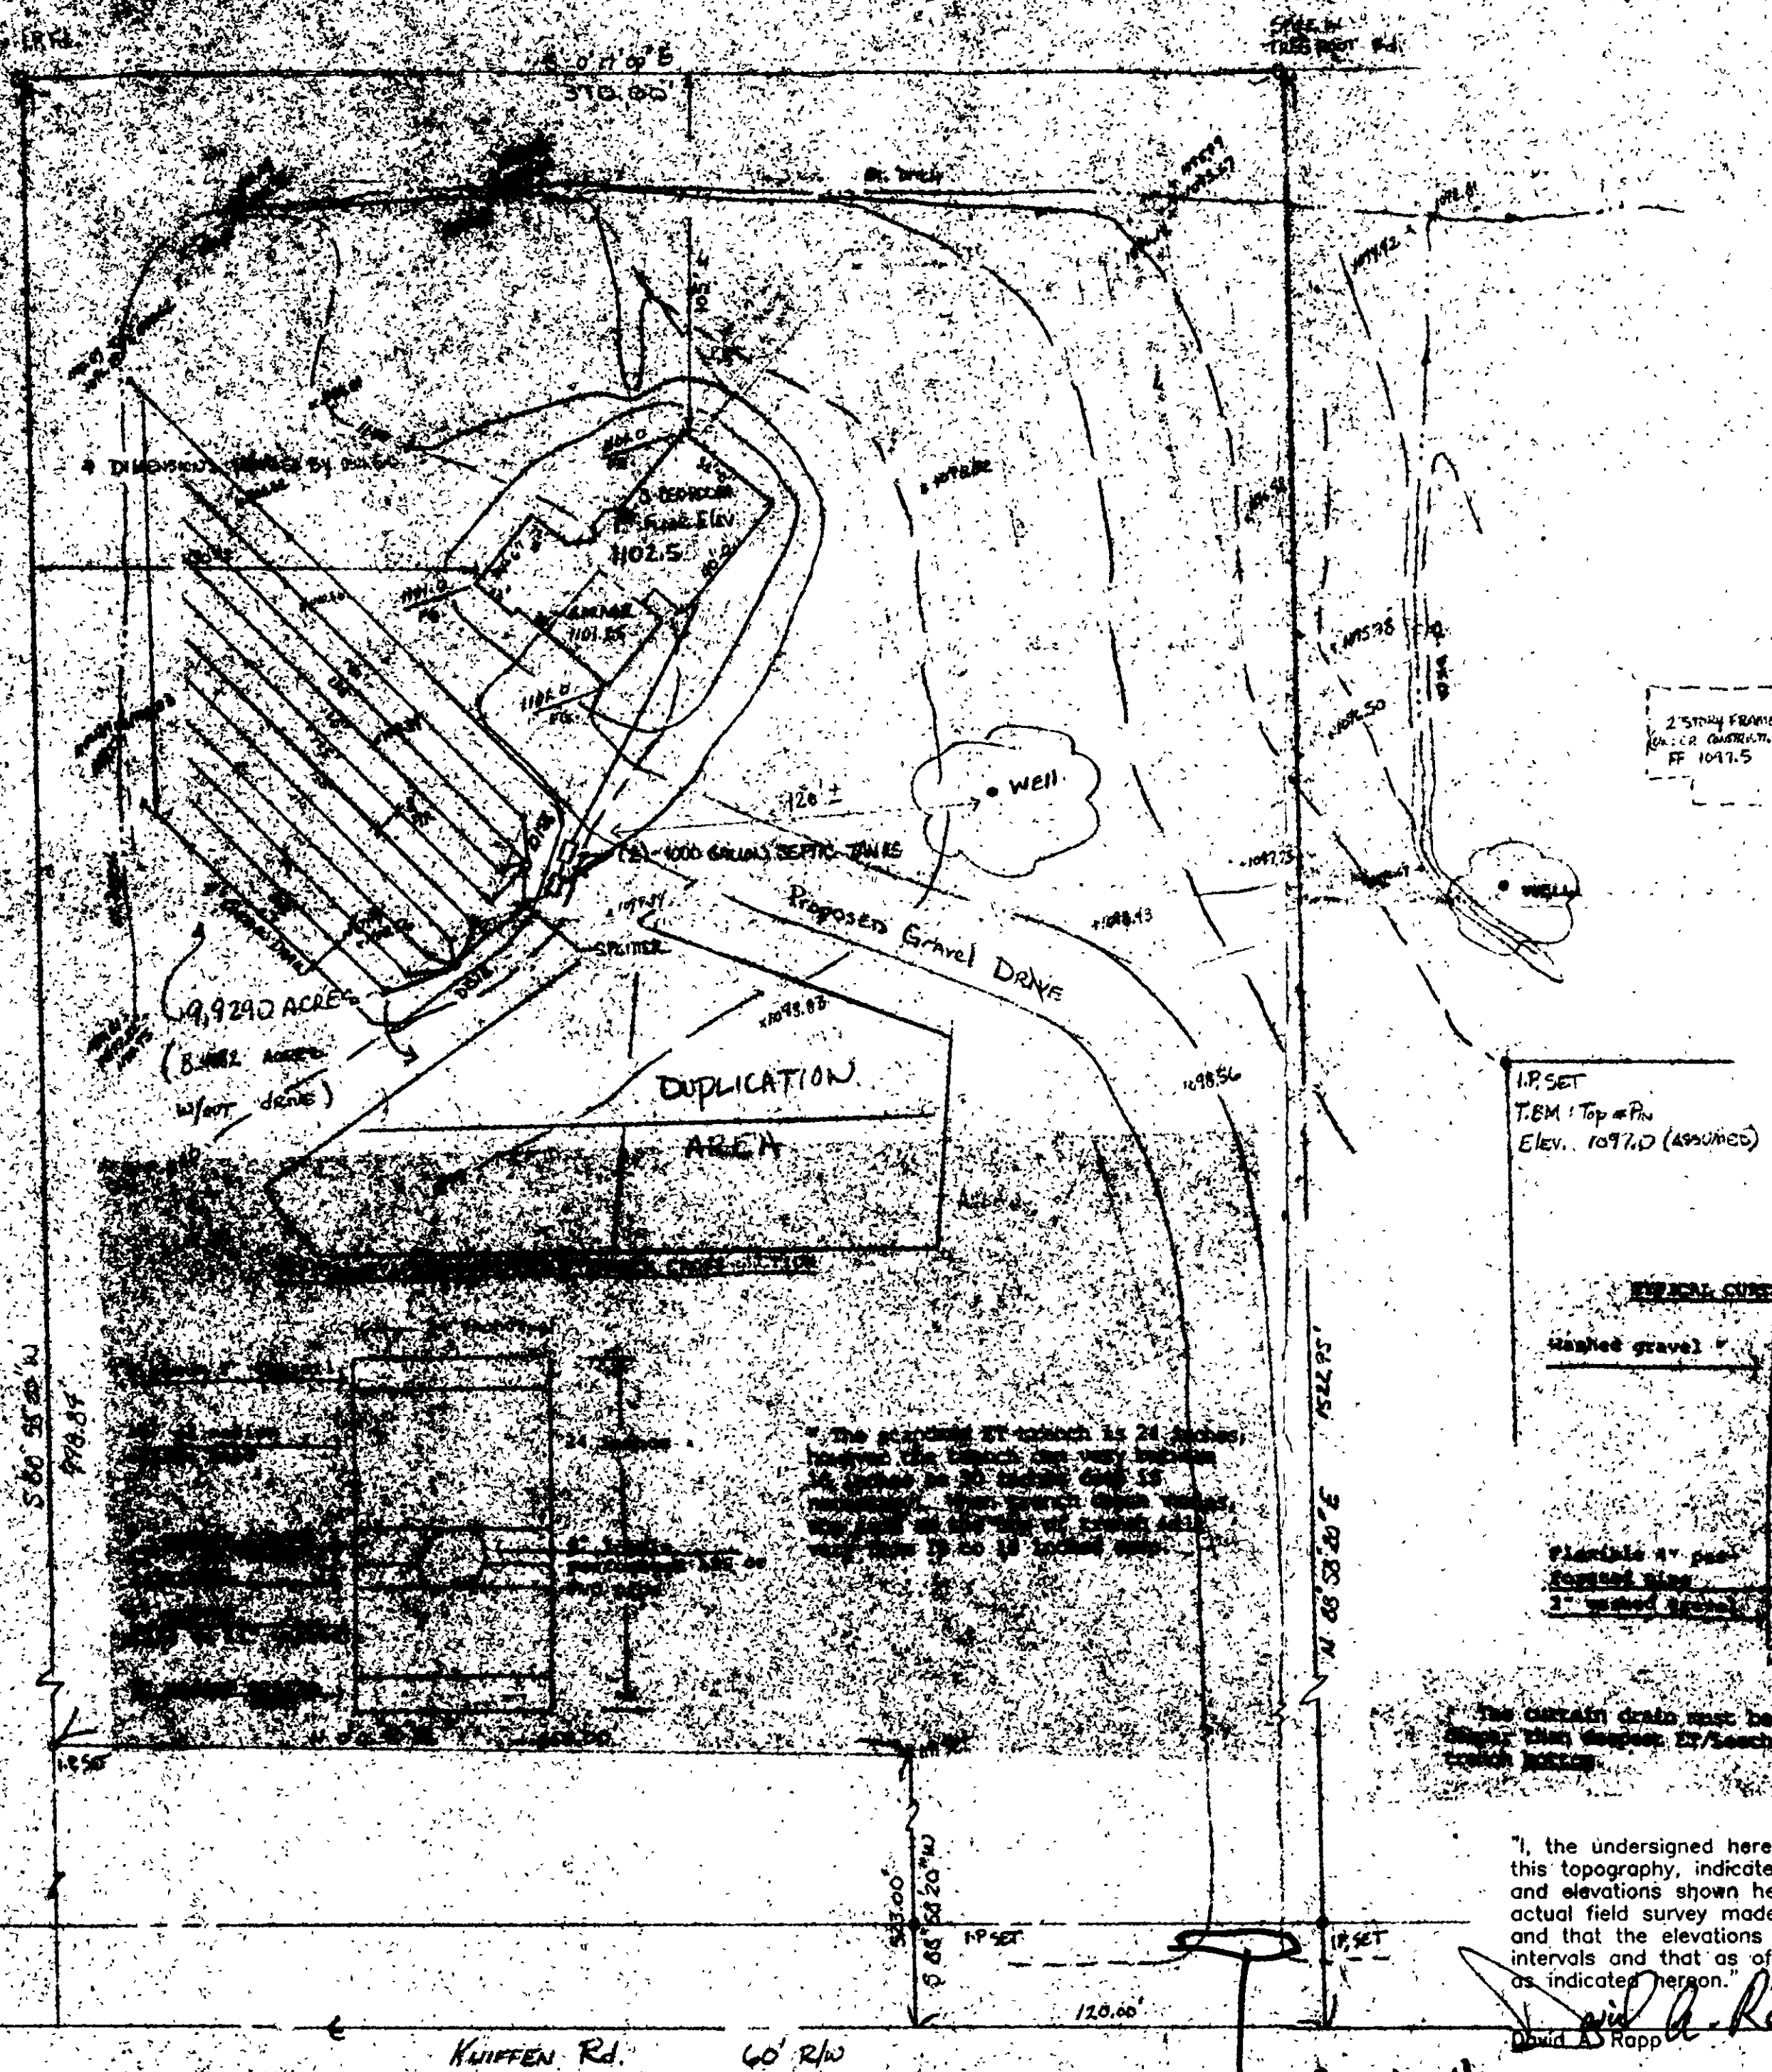

EVAPOTRANSPIRATION TILE FIELD

REVIEWED AND ACCEPTED
LAKE COUNTY GENERAL
HEALTH DISTRICT

Date: 8/12/95 By: David Lal


SEWAGE DISPOSAL PERMIT MUST BE
OBTAINED BY A LAKE COUNTY LICENSED
INSTALLER BEFORE INSTALLATION IS
STARTED

IP SET
T.E.M. Top of Pin
Elev. 1097.0 (assumed)



Grading Plan Approved
as shown and/or noted
THOMAS P. GILLES, P.E.
Lake County Engineer

HYDRAULIC PROFILE
SCALE: 1" = 40' Horiz
1" = 4' Vert

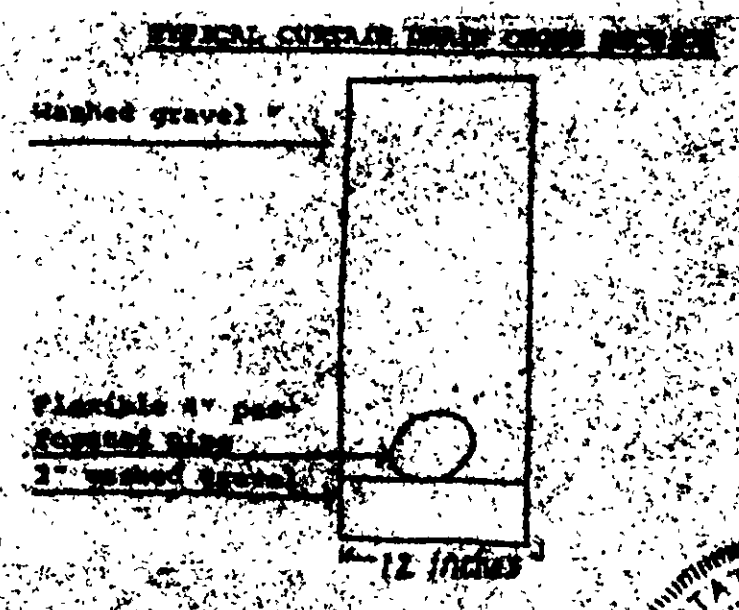

The curtain drain must be 6 inches
thick than flagstone or geotextile
fabric lining

"I, the undersigned hereby certify that
this topography, indicated by 1' contours
and elevations shown hereon represents an
actual field survey made by me in November, 1996
and that the elevations were taken at appropriate
intervals and that as of that date they existed
as indicated hereon.



David A. Rapp 7597 Reg. No.

SITE PLAN	
LAKE COUNTY, OHIO	
for: Mary Ann	client
7410. KUIFFEN RD., LeRoy, Ohio	owner
N/A	subdivision name
plot volume and page	
sublot no.	street