



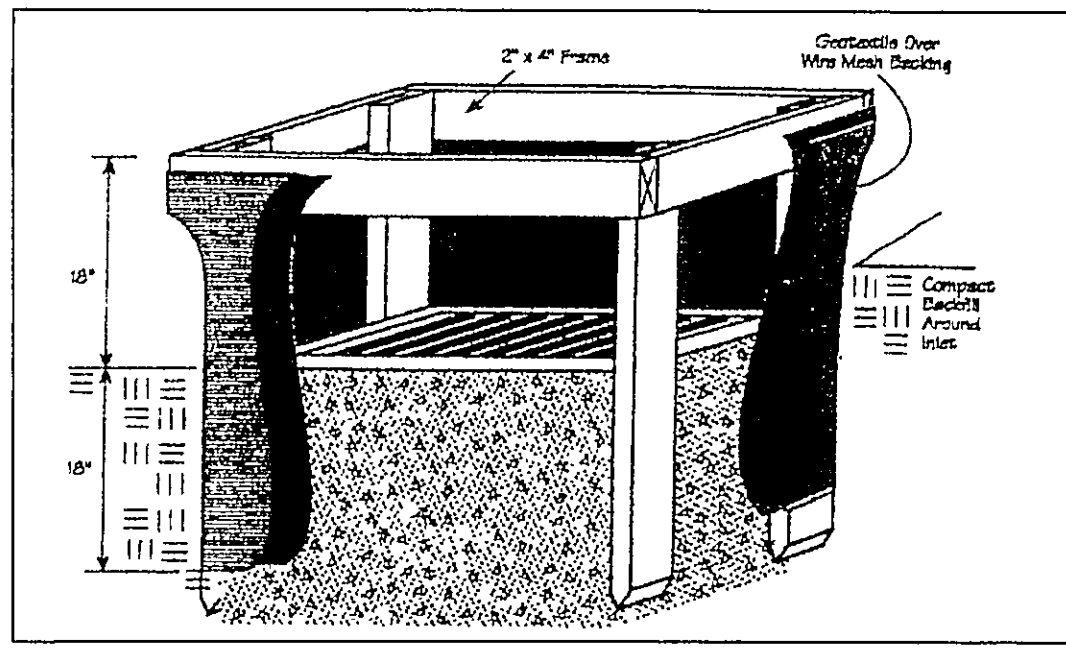

Name Henry Jones # 6343 Reg. No.

Note: Other approved seed species may be substituted.

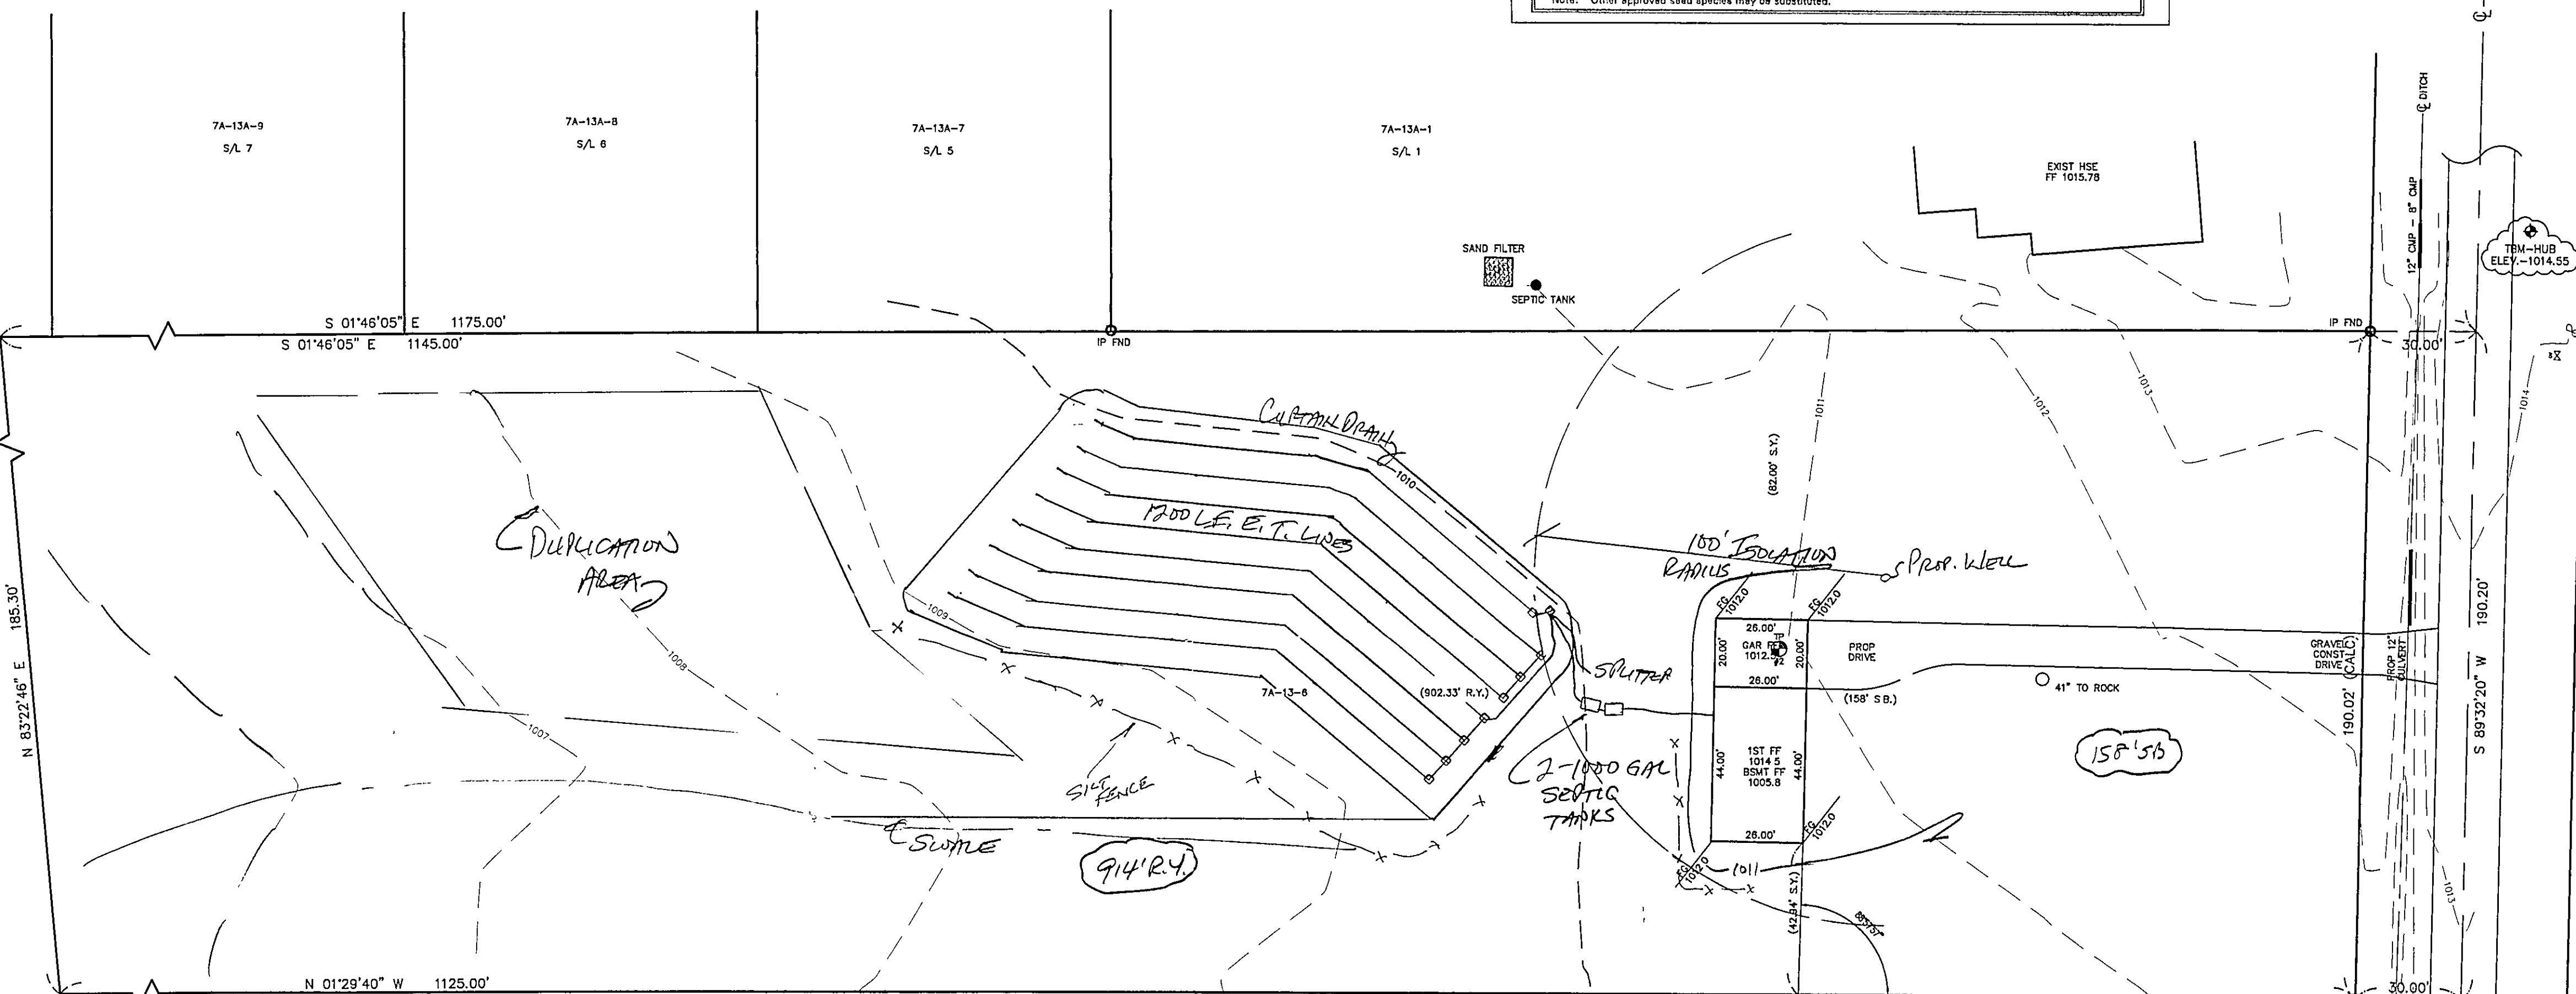

WASTE DISPOSAL PERMIT MUST BE OBTAINED BY A LAKE COUNTY LICENSED INSTALLER BEFORE INSTALLATION IS STARTED

SCALE	1"=30'
JOB NO	04-213
SHEET	OF
1	1