

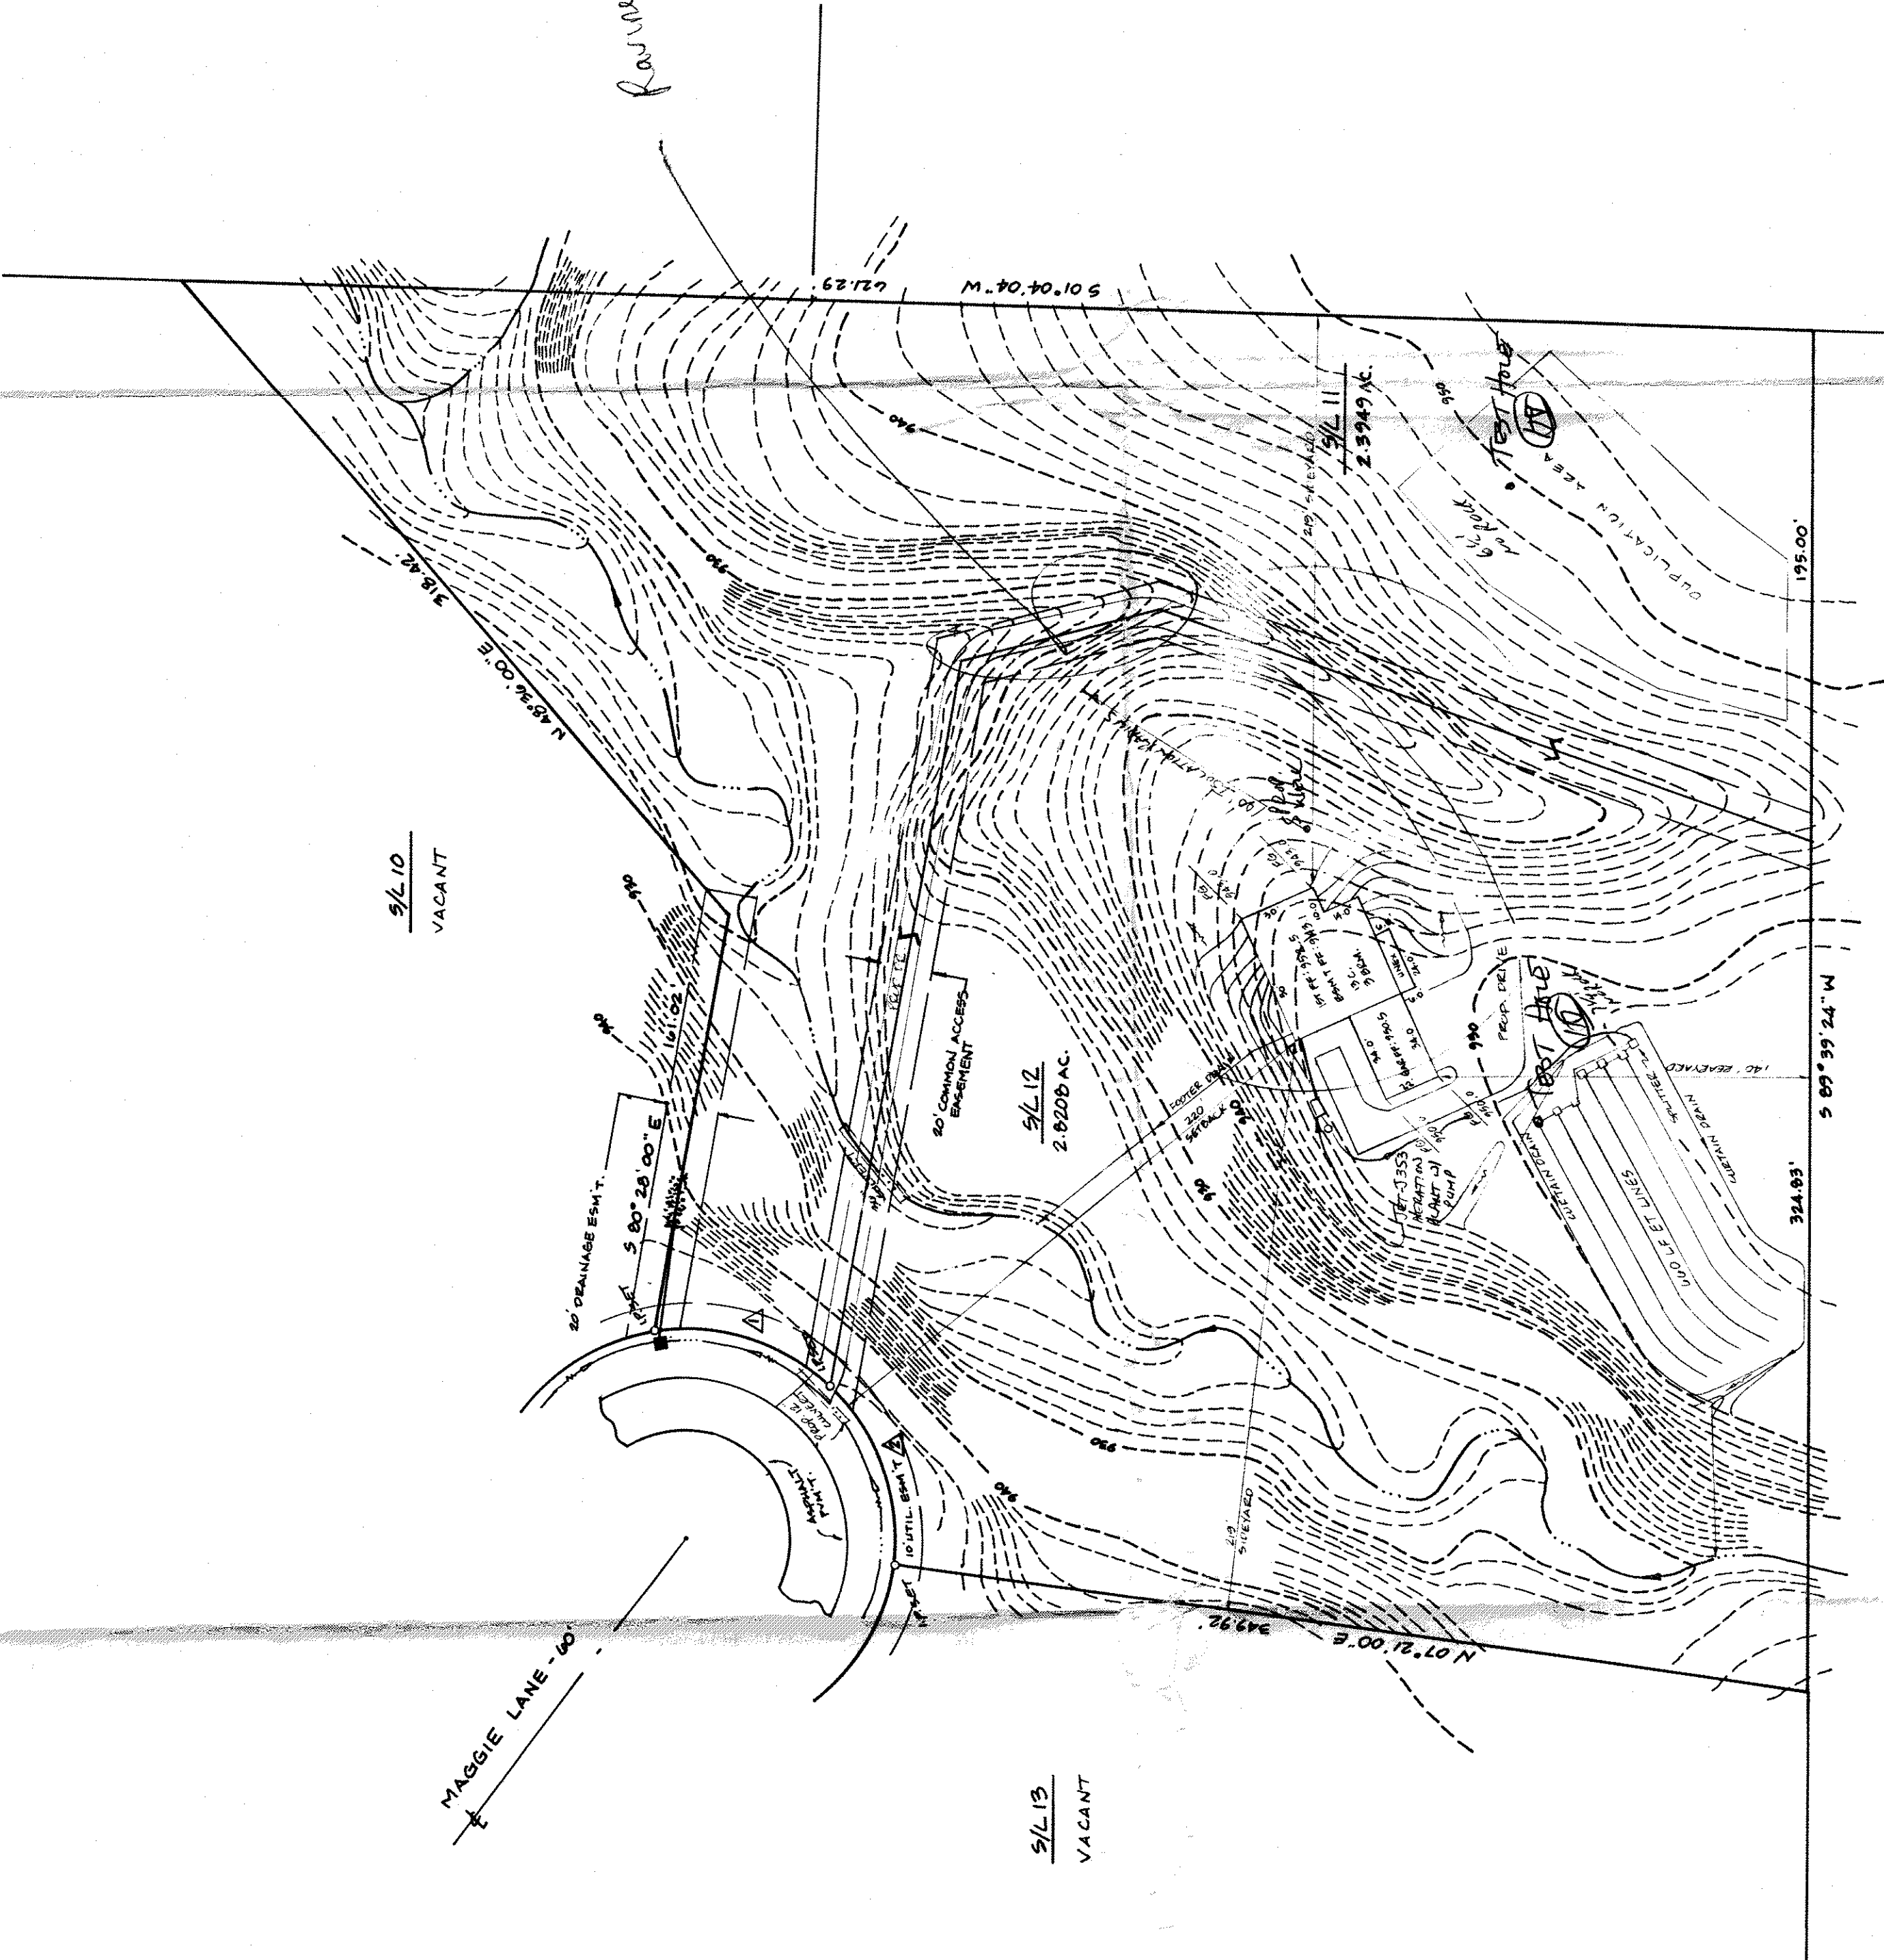


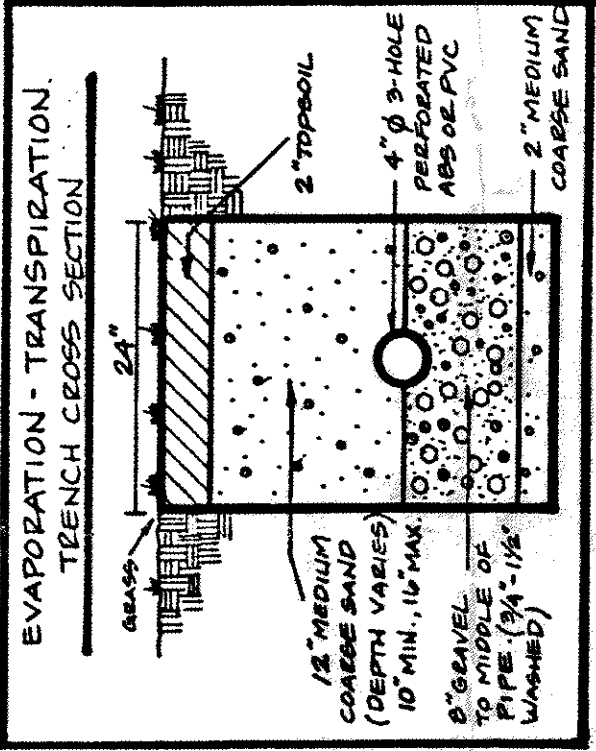


CURVE DATA	
Δ	E = 80.00' A = 75.00' C = 72.29' N 10° 46' 30" E Δ = 89° 43' 00"
Δ	E = 80.00' A = 75.00' C = 72.29' N 70° 29' 30" E Δ = 89° 43' 00"

Reviewed and Accepted
LAKE COUNTY GENERAL HEALTH DISTRICT
Date 8-2-95
JOEL LUDKA R. S. M. P. H.
Health Commissioner
BY J. Ludka

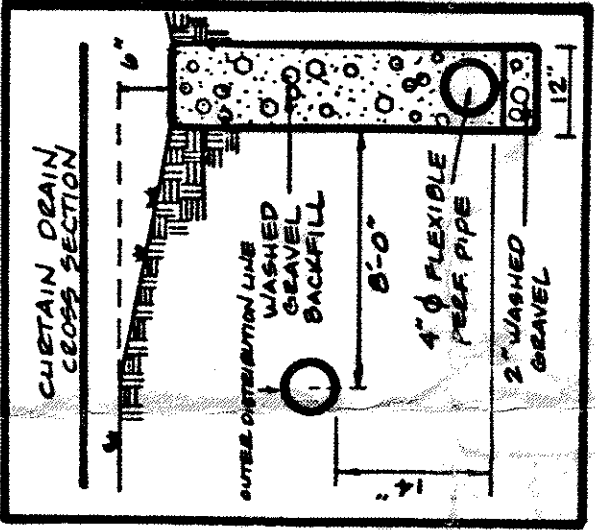

- A. To be brought to finished grade
1. Septic tank manhole covers
2. Shifter box cover
3. Distribution box cover
- B. No frater drains or downspouts
to be discharged into septic tanks
- C. All waste water to be discharged into
septic tanks

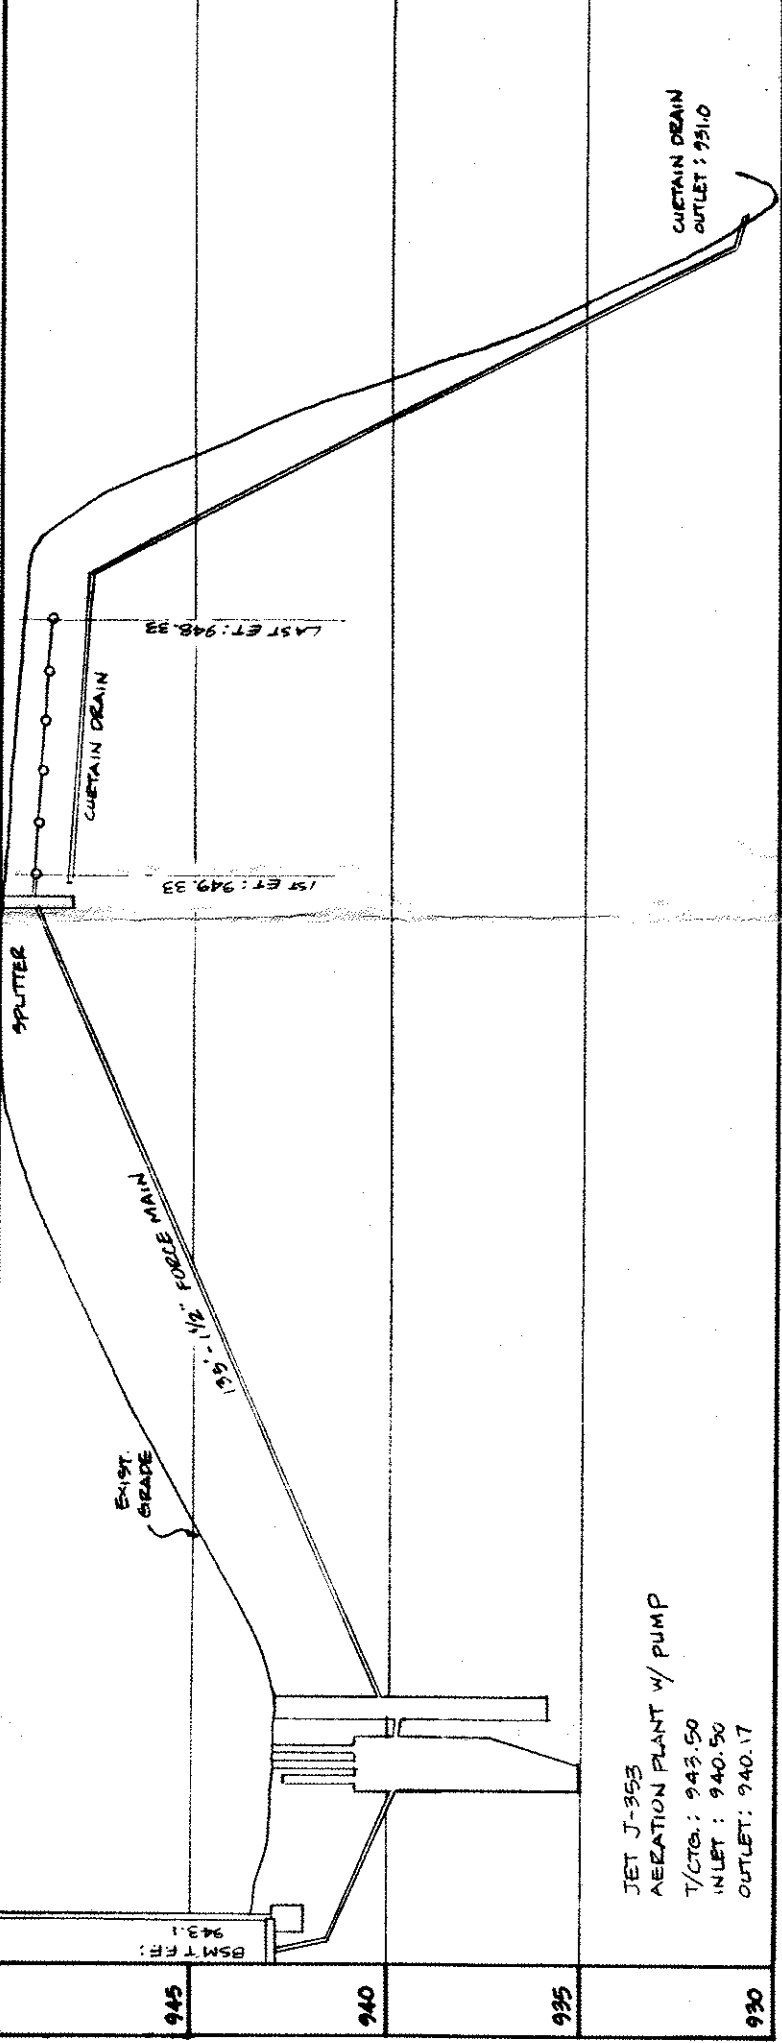


HYDRAULIC PROFILE
HORIZ. 1" = 30', VERT. 1" = 5'

"I, the undersigned hereby certify that
the topography indicated by 6", 1" or 2"
scale, and elevations shown hereon
are a true and correct copy of the
original on file in the office of the
Surveyor of the State of Ohio, and that
the same have been used in the
preparation of the plan hereon, and that
the date they existed as indicated hereon."

RECOMMENDED
FOR
APPROVAL
BY [Signature]
DATE 8/1/95

62H 82195
Natural Famine cannot be
blocked.

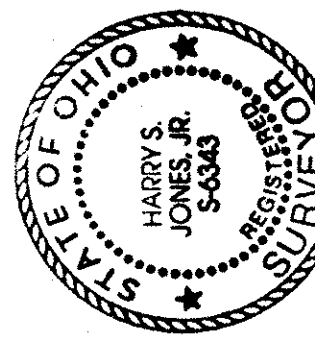

SEWAGE DISPOSAL PERMIT MUST BE
OBTAINED BY A LAKE COUNTY LICENSED
INSTALLER BEFORE INSTALLATION IS
STARTED.

LOW YIELD WATER
FIXTURES REQUIRED
ON ALL:
— Shower Head
— Toilet

REV NO.	1	DESCRIPTION	HOUSE SEPTIC, REEL DULICATION	DATE	8-2-95	BY	HT	CHK'D	HT
DATE	JULY 1995	DESIGN BY	HT	APPROVED BY	HT				
B' BABCOCK, JONES AND ASSOCIATES, INC. CIVIL ENGINEERS - SURVEYORS - LAND PLANNERS PAINESVILLE OHIO 44077				13760 Maggie Lane					
SITE PLAN FOR R.L. MOORE HOMES				5/2 11/2 PINEY HOLLOW SUBDIVISION PLAT Vol. 18 - Pg. 15 LEROY TOWNSHIP - LAKE COUNTY - STATE OF OHIO					
SCALE 1" = 50'				JOB NO. 95-080					
SHEET 11				OF 1					