
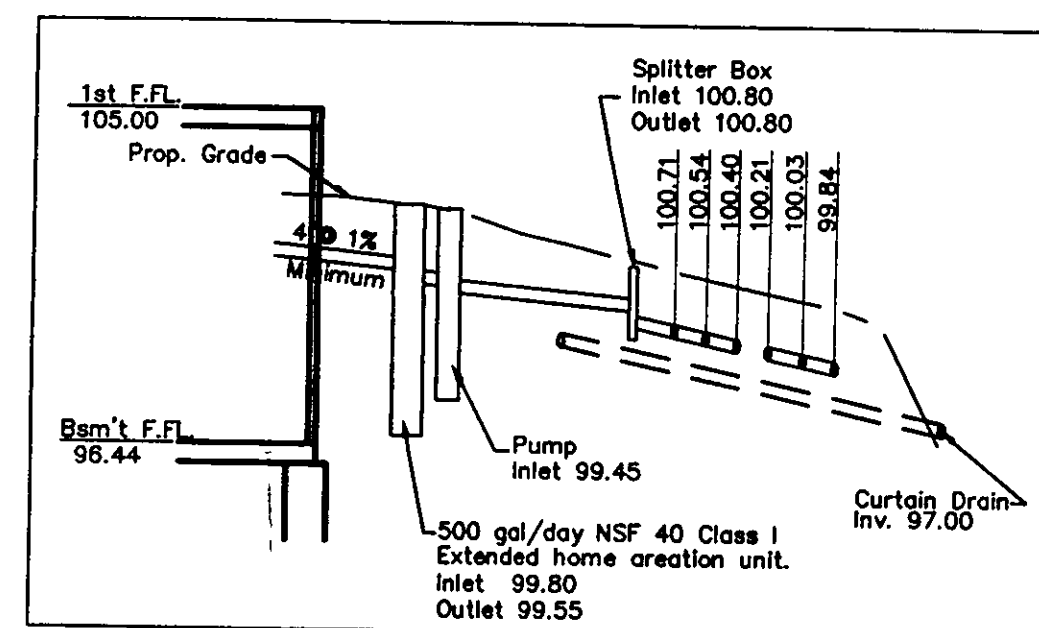
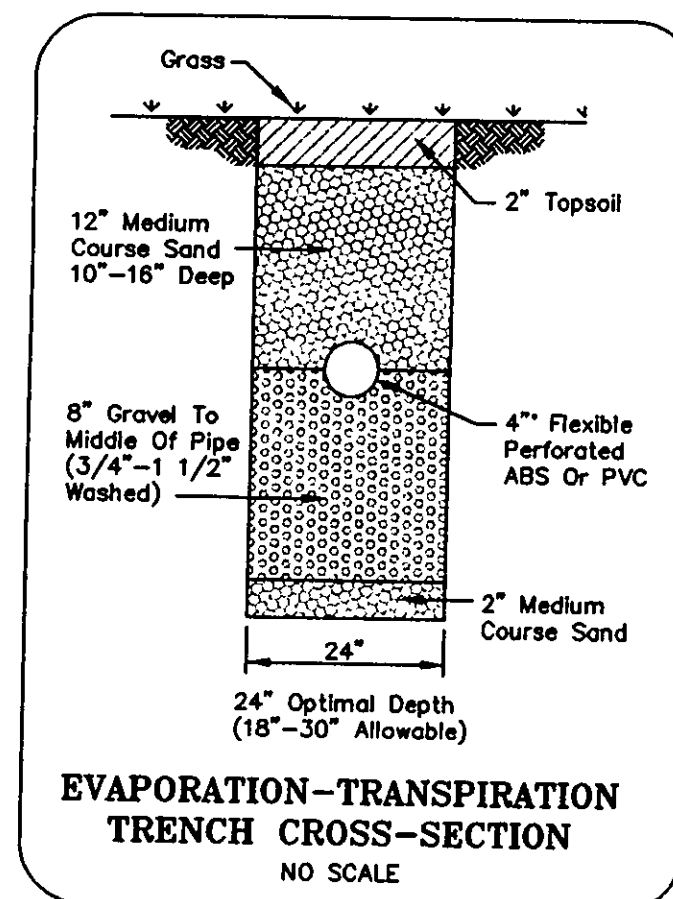
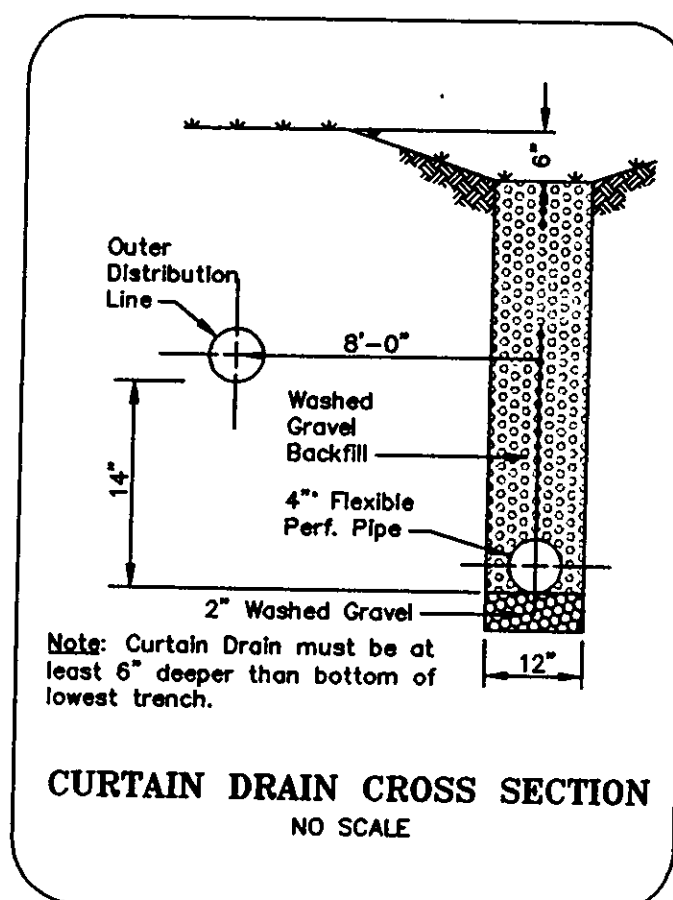


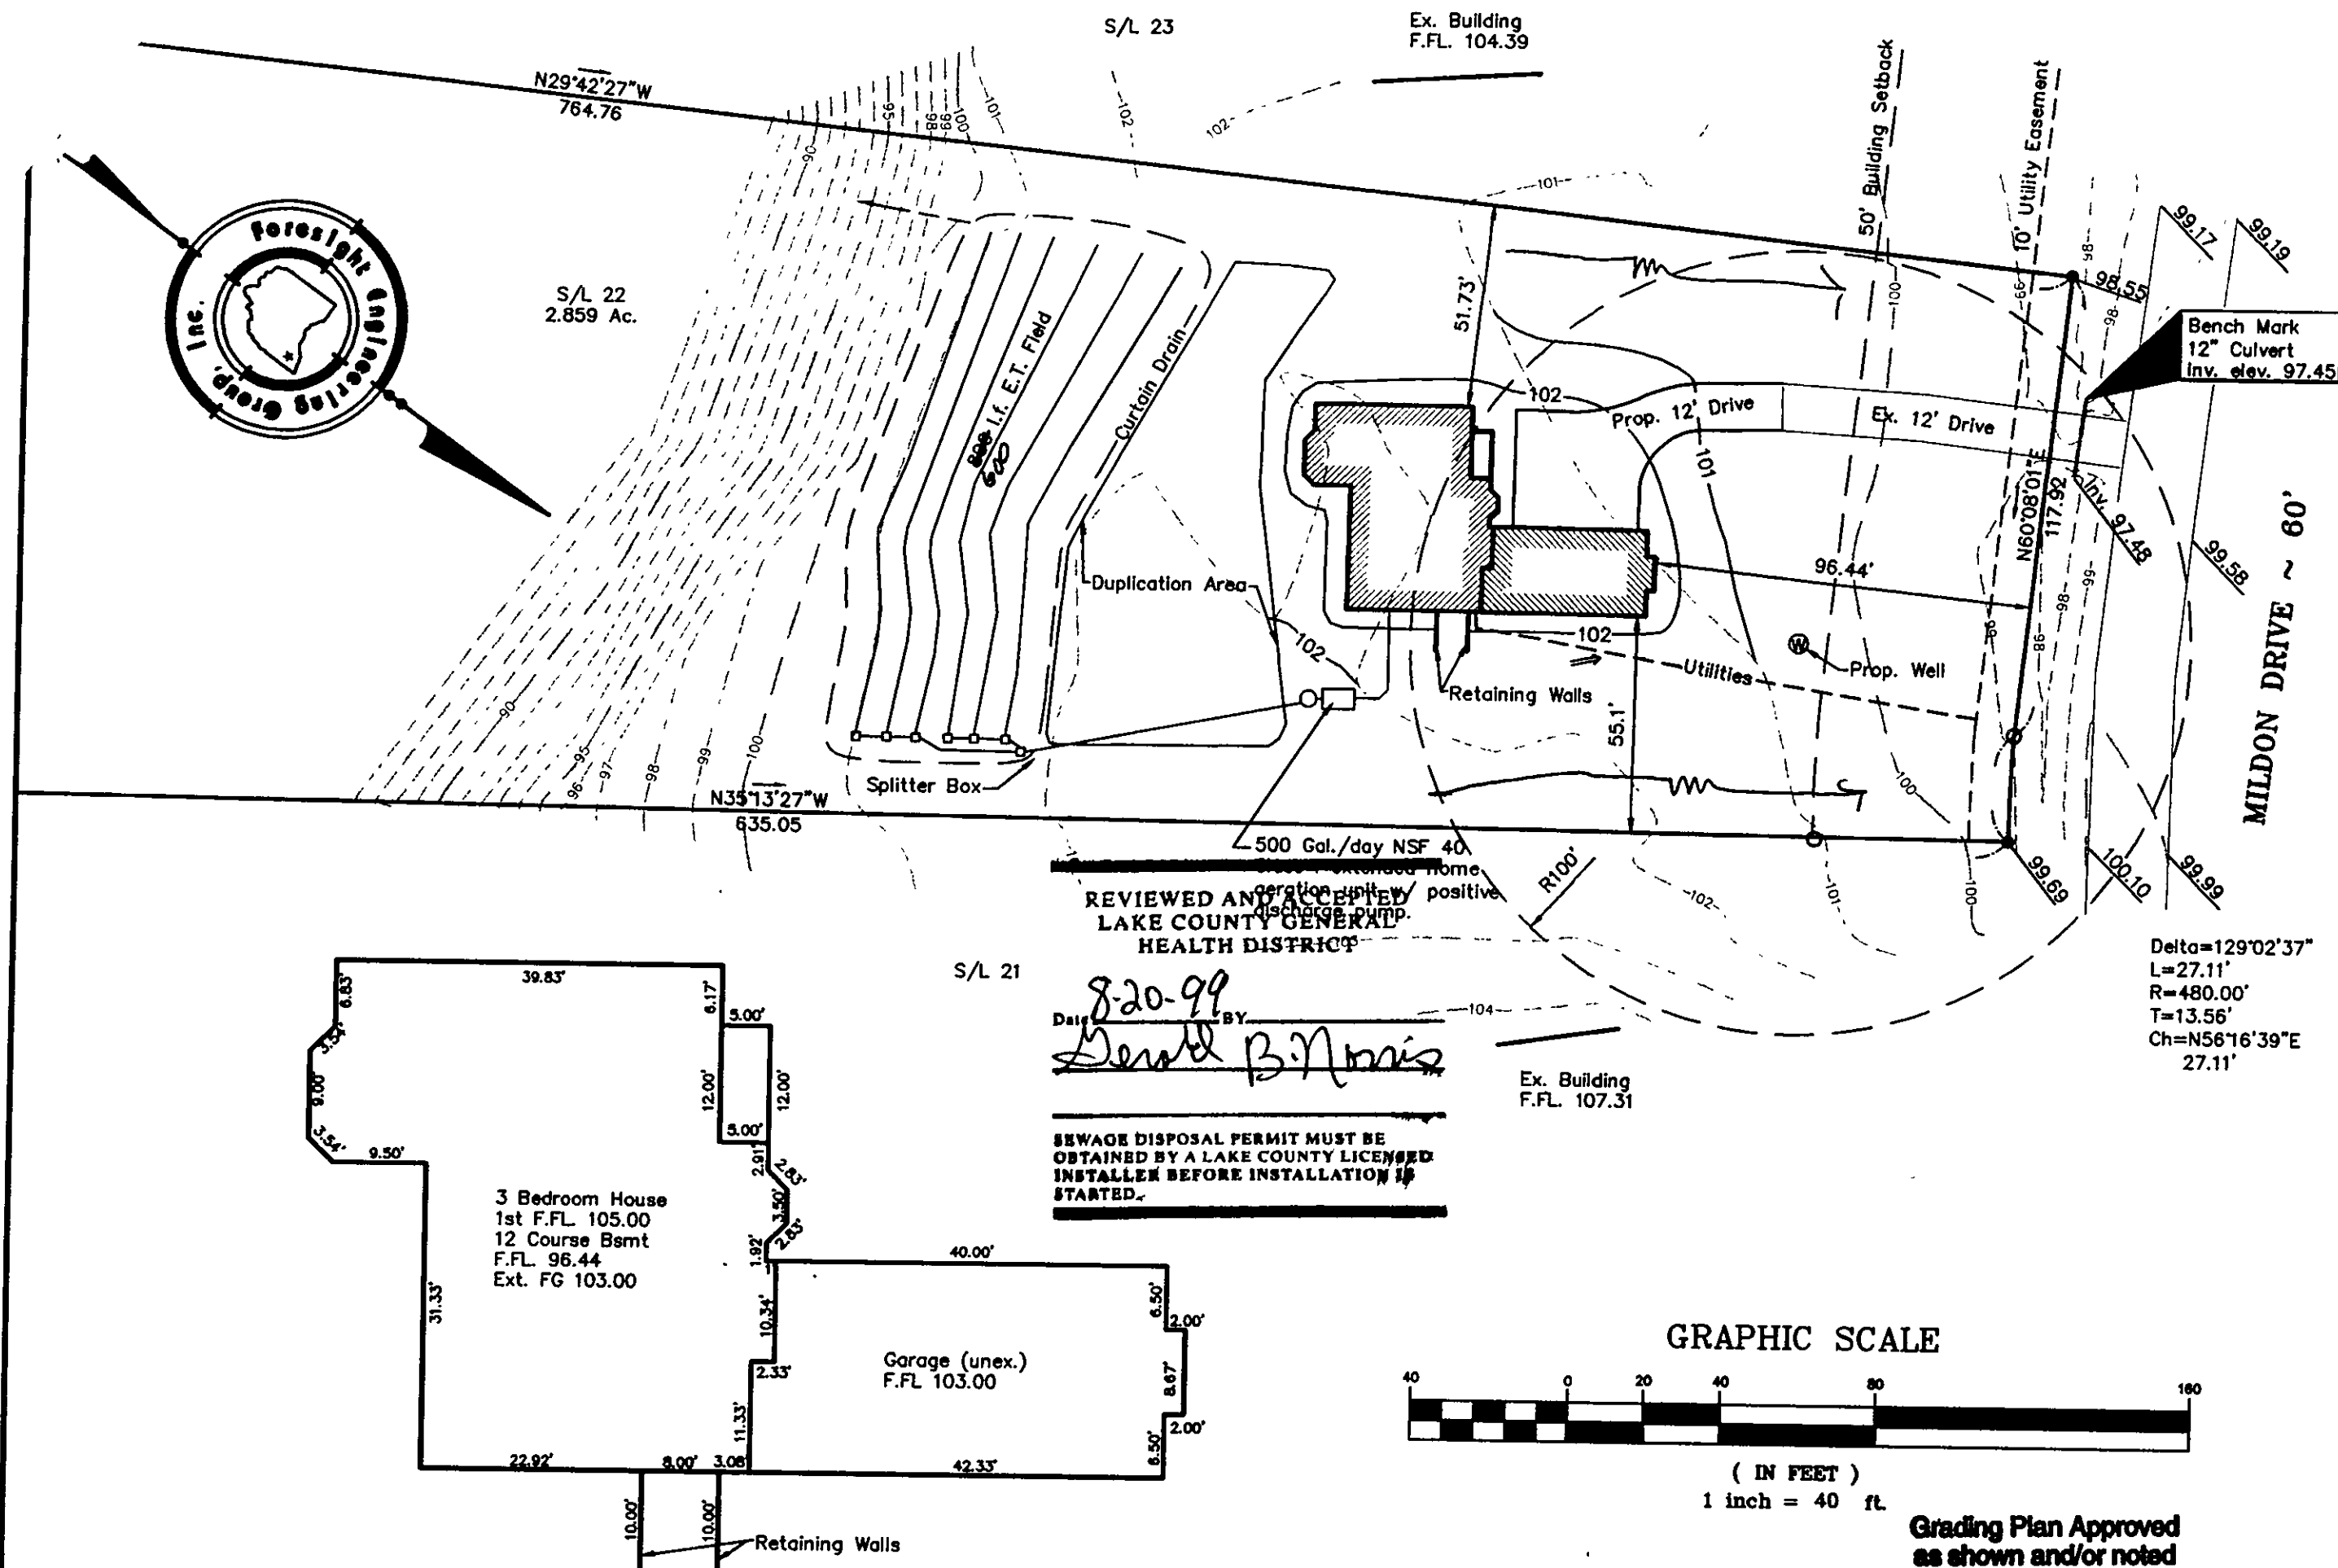

SITE PLAN

for : Dennis Peine
CLIENT

322 W Parkway Blvd. Madison OH 44057
ADDRESS CITY STATE ZIP

22	Cascade Ridge	980017636
SUBLOT No.	SUBDIVISION NAME	VOL. PAGE

LOT _____ TRACT _____ Leroy Twp. CITY _____ OH STATE _____

Foresight Engineering Group

440 286-1010
440 286-1034 fax
320 Center Street, Unit F
Chardon, Ohio 44024

Engineers & Surveyors


DESIGN CERTIFICATION

This Site Plan was prepared by Foresight Engineering Group, Inc.,
and is correct to the best of my knowledge and belief.

NAME Stan A. R...

CHECK LIST

LOT DIMENSIONS & BEARINGS
TIE TO NEAREST STREET
SUBLOT NO. (PARCEL NO.)
SURROUNDING OWNERS
BUILDING DIMENSIONS
SETBACK, SIDEYARD, REARYARD
FINISH GRADES
DRIVE & APRON TYPE, WIDTH, THICKNESS
SIDEWALK TYPE, WIDTH, THICKNESS
CULVERT TYPE, DIAM., LENGTH
WATER MAIN SIZE, LOCATION
SAN. SEWER SIZE, % GRADE, LOC.
SAN. MH. CAST. ELEV., INV. ELEV.
SAN. CONN. SIZE, % GRADE, LOC.
STORM SEWER SIZE, % GRADE, LOC.
STORM MH. CAST. ELEV., INV. ELEV.
PAVT TYPE, GRADE, CURBS
GAS LINE LOC., SIZE
SEPTIC SYSTEM & DUPLICATION
WELL LOCATION & ISOLATION RADIUS

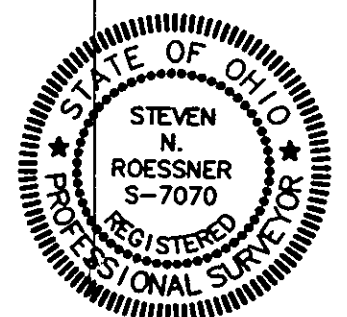

STATE SEAL

"AS BUILT" CERTIFICATION

I hereby certify that the circled information is existing as obtained on the site _____ 19____ and is correct to the best of my knowledge and belief.

NAME _____

SCALE : 1" = 40'

FILE NAME:
I:\Pen29901\field

DATE : July 19, 1999

BENCHMARK: 12" Culvert Inv. Elev. = 97.45

"I, the undersigned hereby certify that this topography, indicated by 6", 1' or 2' contours, and the elevations shown hereon represent an actual field survey made by Foresight Engineering Group, Inc. on the 1 day of July 19 99 and that the elevations were taken at appropriate intervals and that as of that date they existed as indicated hereon."

NAME John R. [Signature]

LEWIS TOWNSHIP
Zoning Approved
2639
[Signature]
Zoning Inspector

**2 WORKING DAYS
BEFORE YOU DIG**

CALL TOLL FREE 800-362-2764

ONCE YOU'VE STARTED YOUR SERVICE

EXISTING UNDERGROUND UTILITIES NOTES:
The location both horizontal and vertical of the underground utilities shown hereon, have been obtained by a diligent and comprehensive search of available records. Verification by field observation, has been conducted where practical. However, Foresight Engineering Group, Inc. does not guarantee the completeness nor accuracy thereof.