
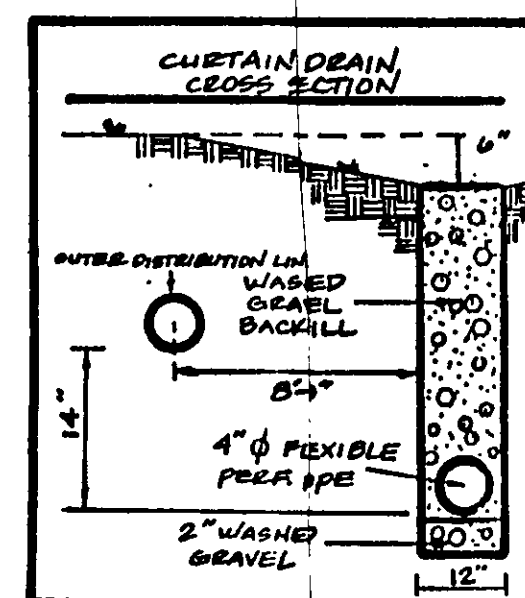
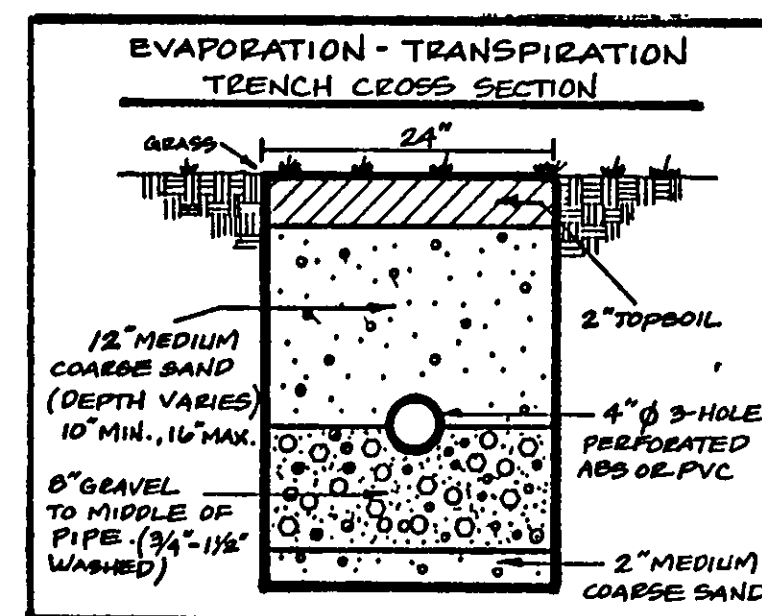
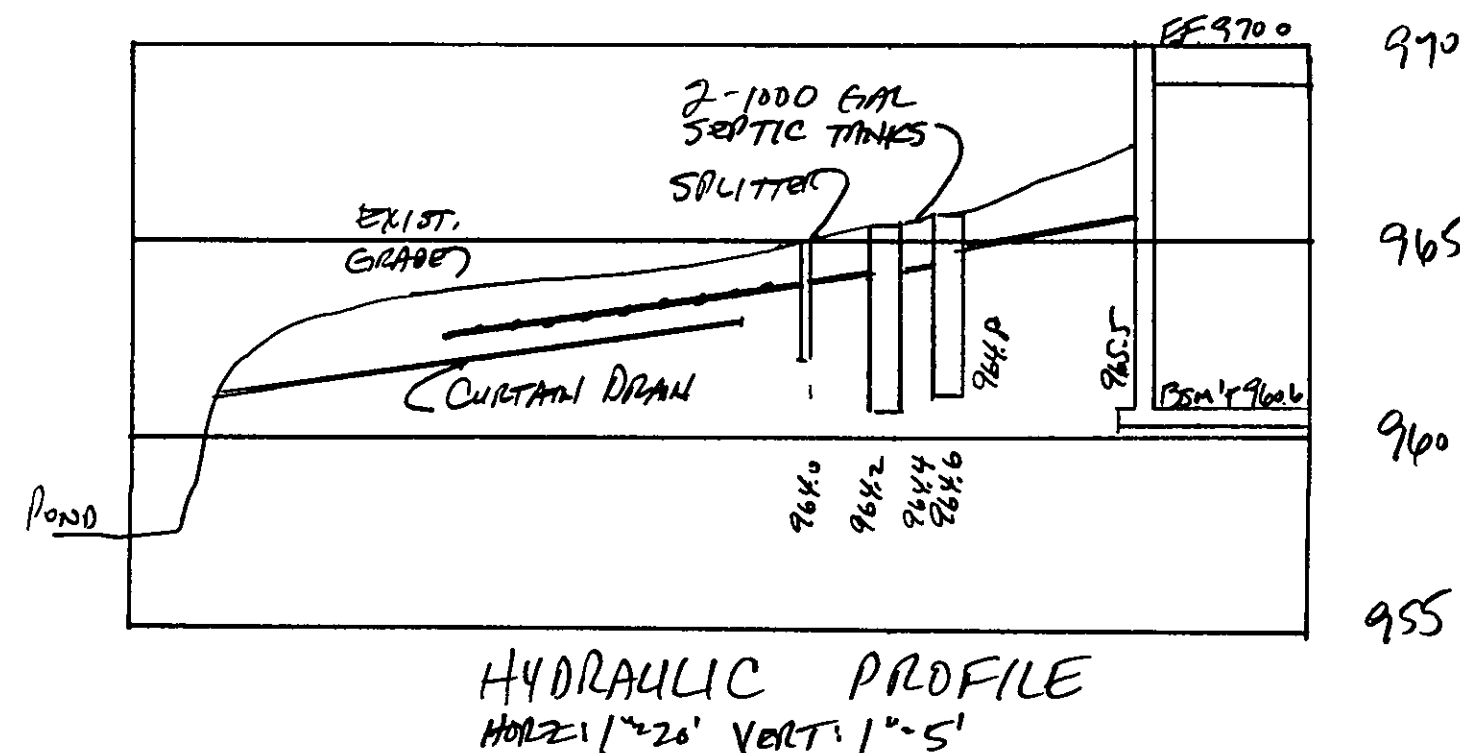


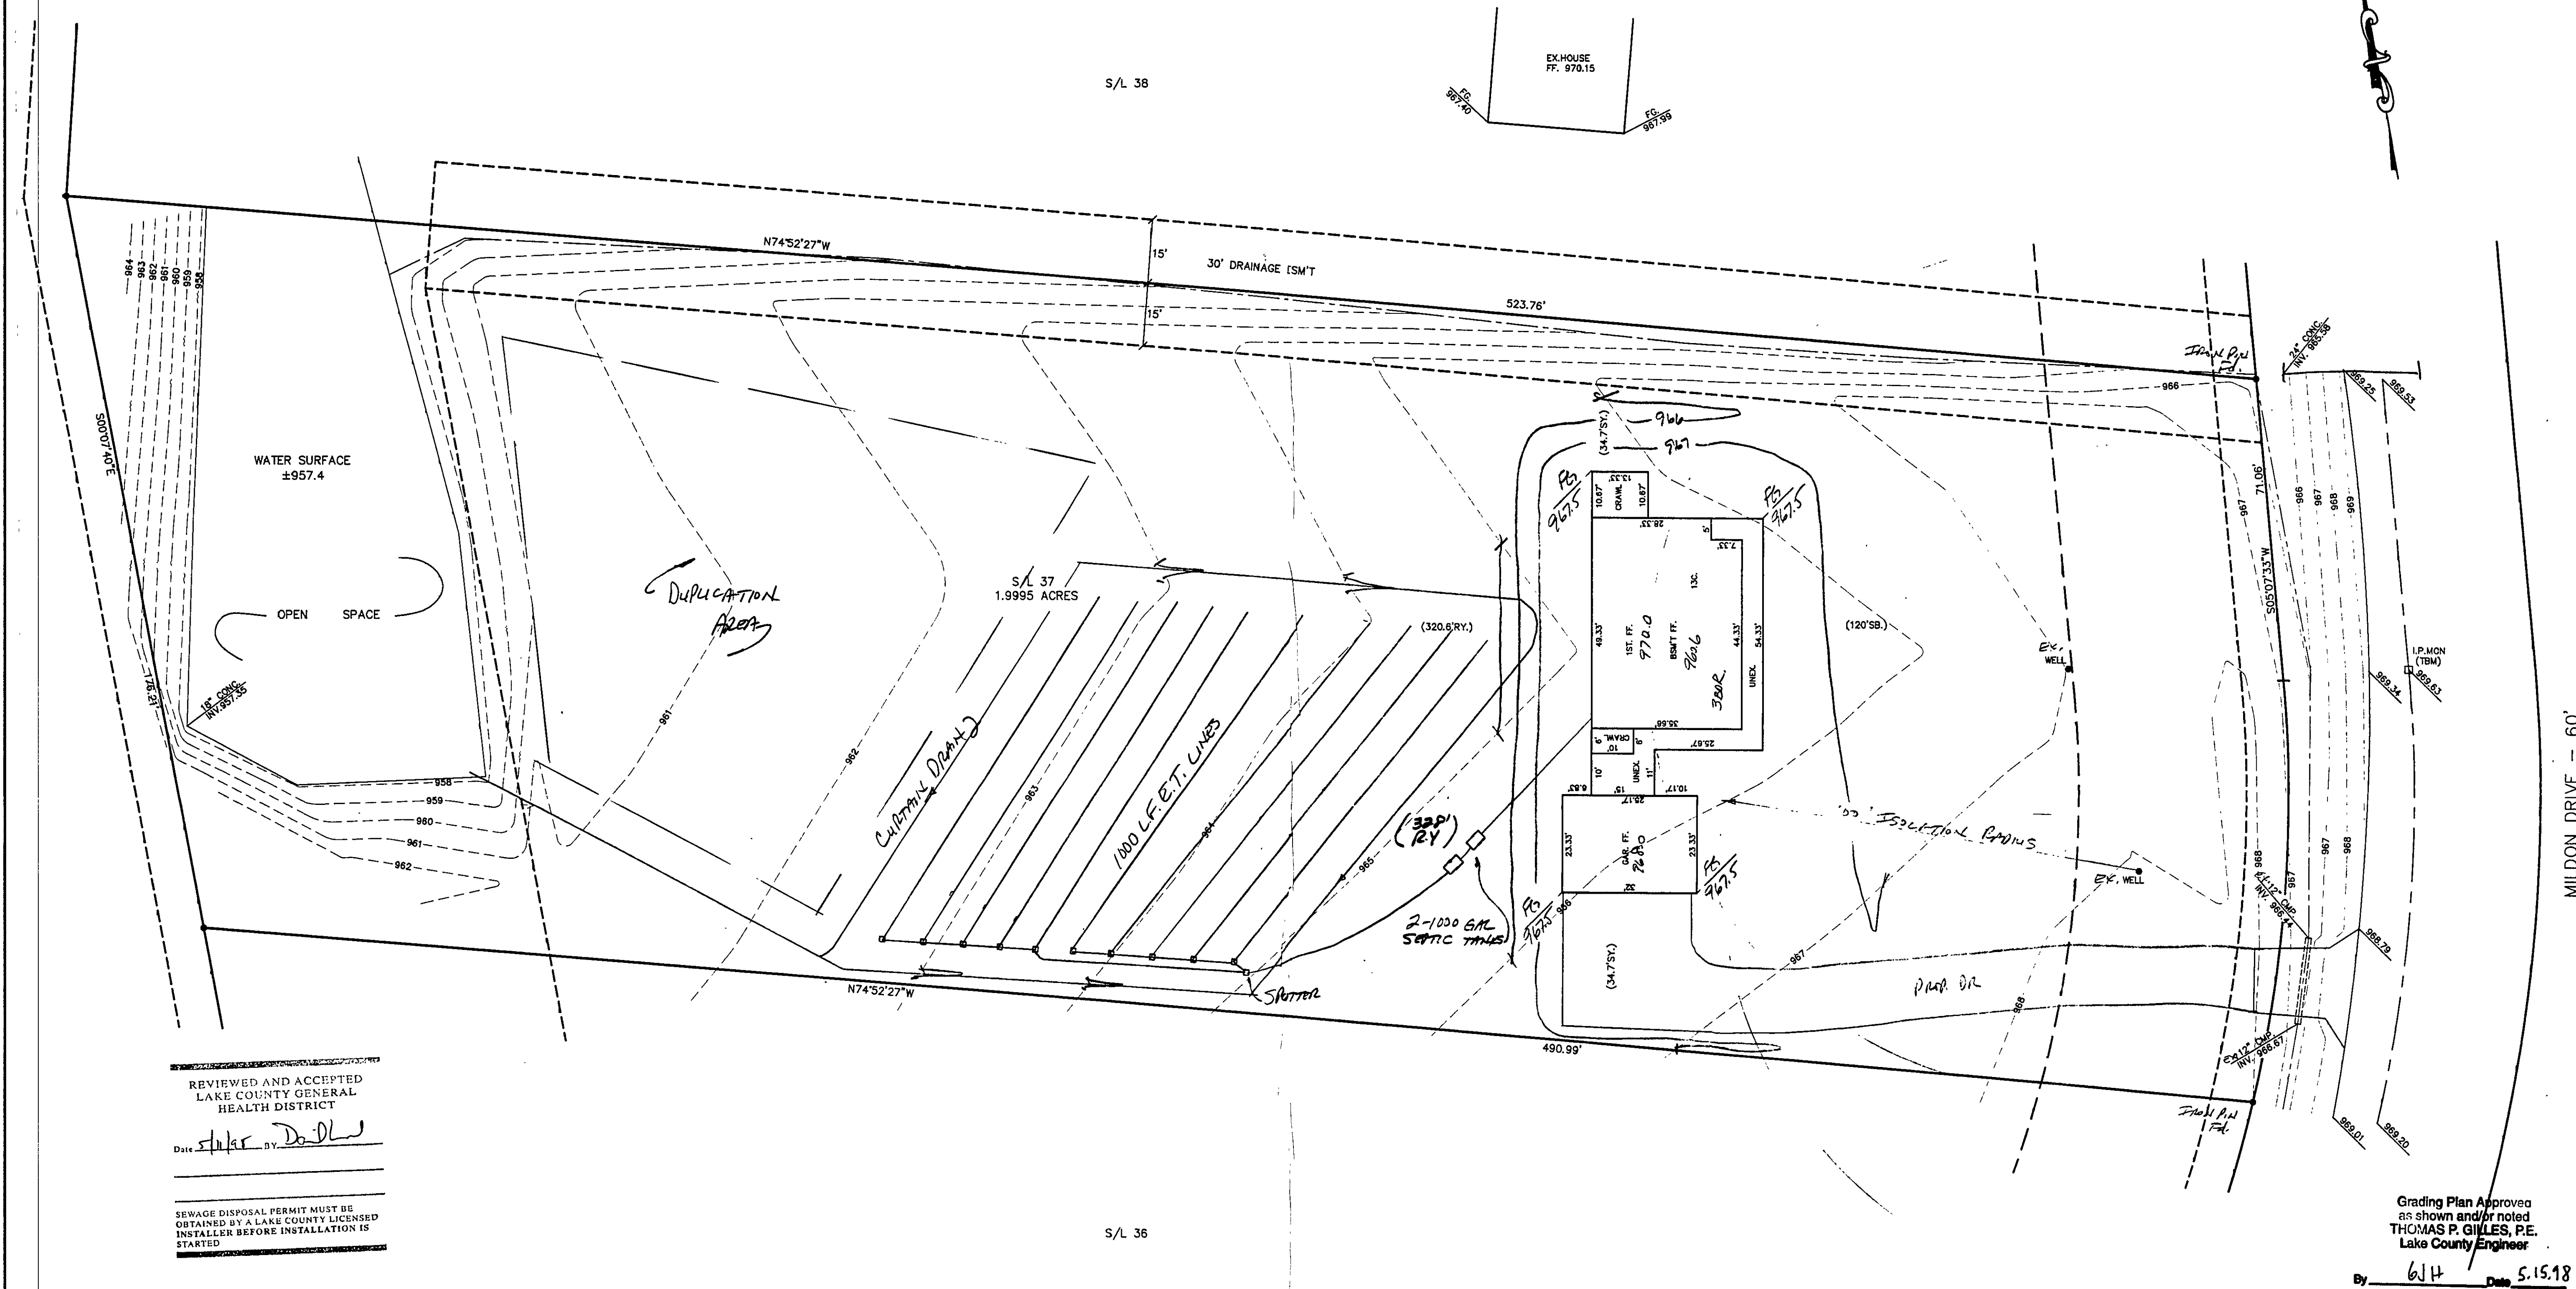

"I, the undersigned, hereby certify that this report was prepared by G-6, 1' or 2' contours, and was drawn hereon represent an aerial field survey made by me on the 27th day of March, 1974 and that the observations were taken at appropriate intervals and that as of that date they existed as indicated hereon."

Henry J. Jones #6343

Name	Reg. No.
------	----------

$\Delta = 18^{\circ}34'06''$
 $R = 310.00'$
 $L = 100.46'$
 $C = 100.03'$
 $N14^{\circ}24'36''E$

TBM-I.P. MON. .
ELEV.=969.63

[illegible]

bj BABCOCK, JONES AND ASSOCIATES, INC
CIVIL ENGINEERS – SURVEYORS – LAND PLANNERS
PAINESVILLE OHIO 44077

DATE	4/28/98
DESIGN BY	H.J.
DRAWN BY	T.R.
APPROVED BY	H.J.

SITE PLAN
FOR
ROB LEBER

LERROY TOWNSHIP

LAKE COUNTY

SCALE	1" = 20'	
JOB NO.	90-022-37	
SHEET		OF
1		1