



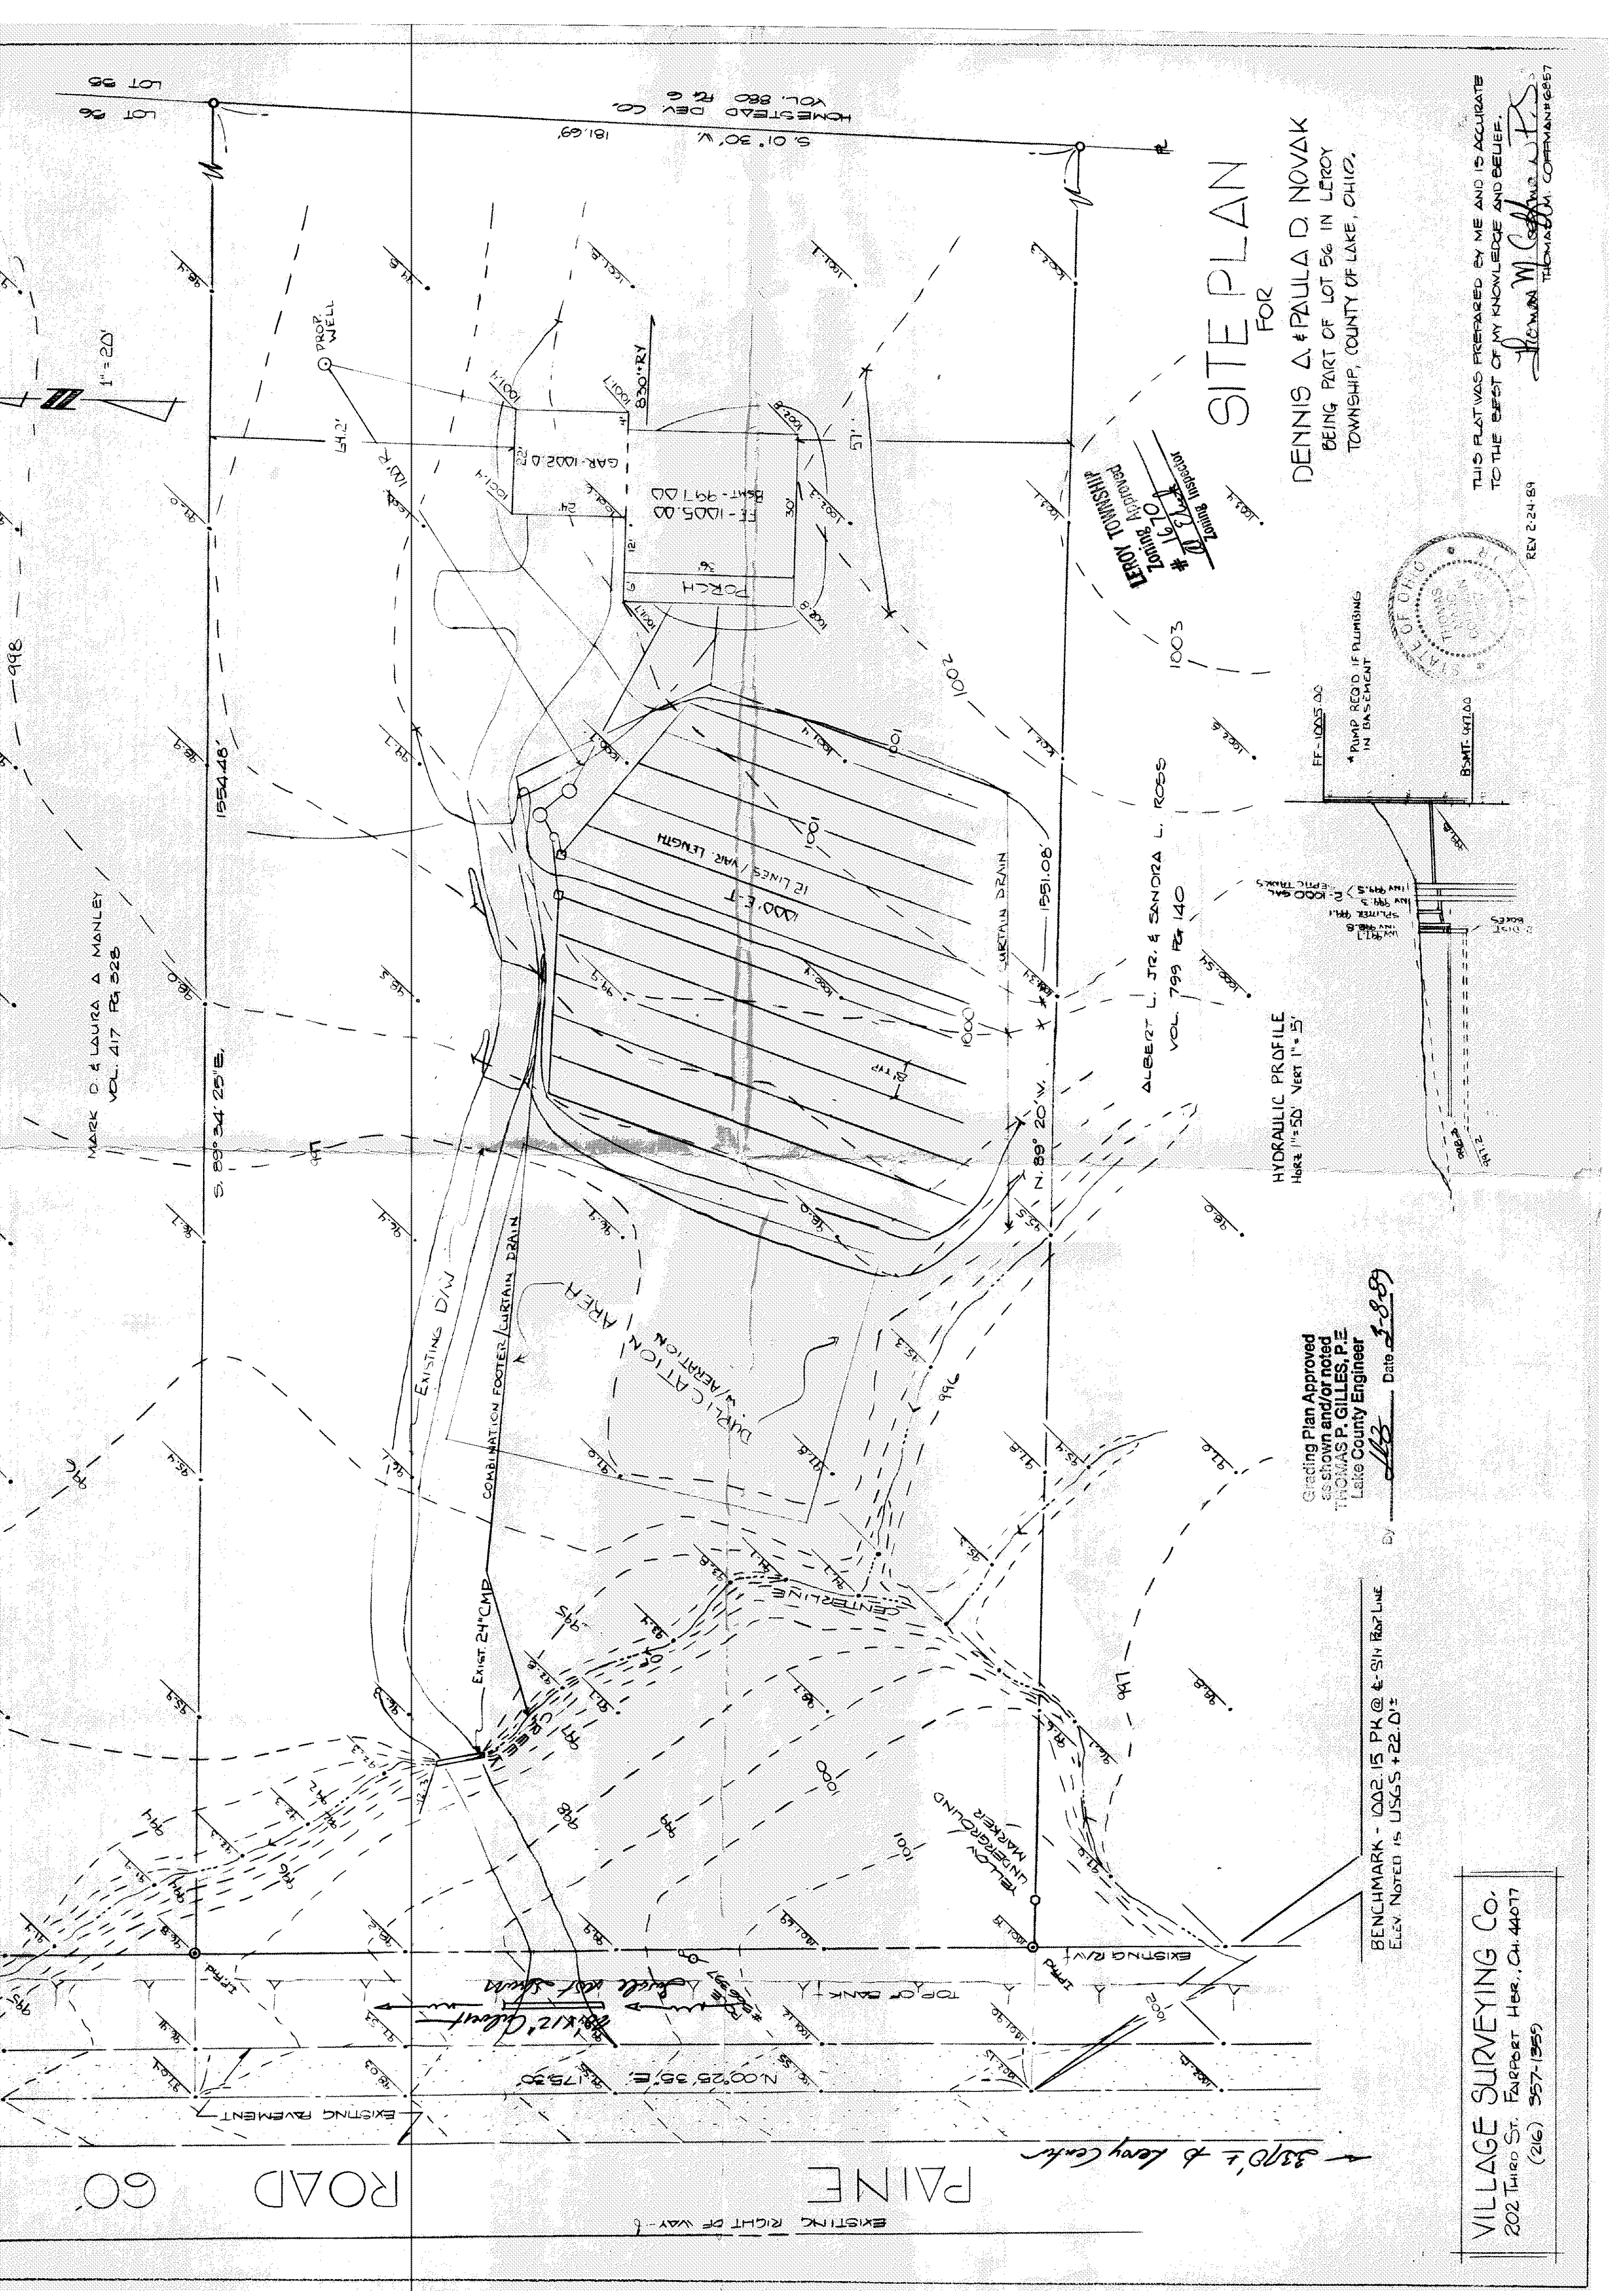

SITE PLAN

FOR

DENNIS A. & PAULA D. NOVAK
BEING PART OF LOT 56 IN LEROY
TOWNSHIP, COUNTY OF LAKE, OHIO.

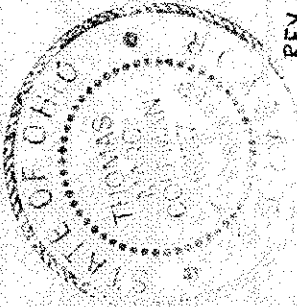

THIS PLAN WAS PREPARED BY ME AND IS ACCURATE
TO THE BEST OF MY KNOWLEDGE AND BELIEF.

THOMAS P. GILLES, P.E.
10000
10/1/00
10000
10/1/00

REV 2-24-89

Grading Plan Approved
as shown and/or noted
THOMAS P. GILLES, P.E.
Lake County Engineer

By dlb Date 3-8-89

BENCHMARK - 1002.15 PK @ E-SH BAR LINE
ELEV. NOTED IS USGS +22.0'±

VILLAGE SURVEYING CO.
202 Third St. Fairport Harbor, OH 44077
(216) 357-1355