



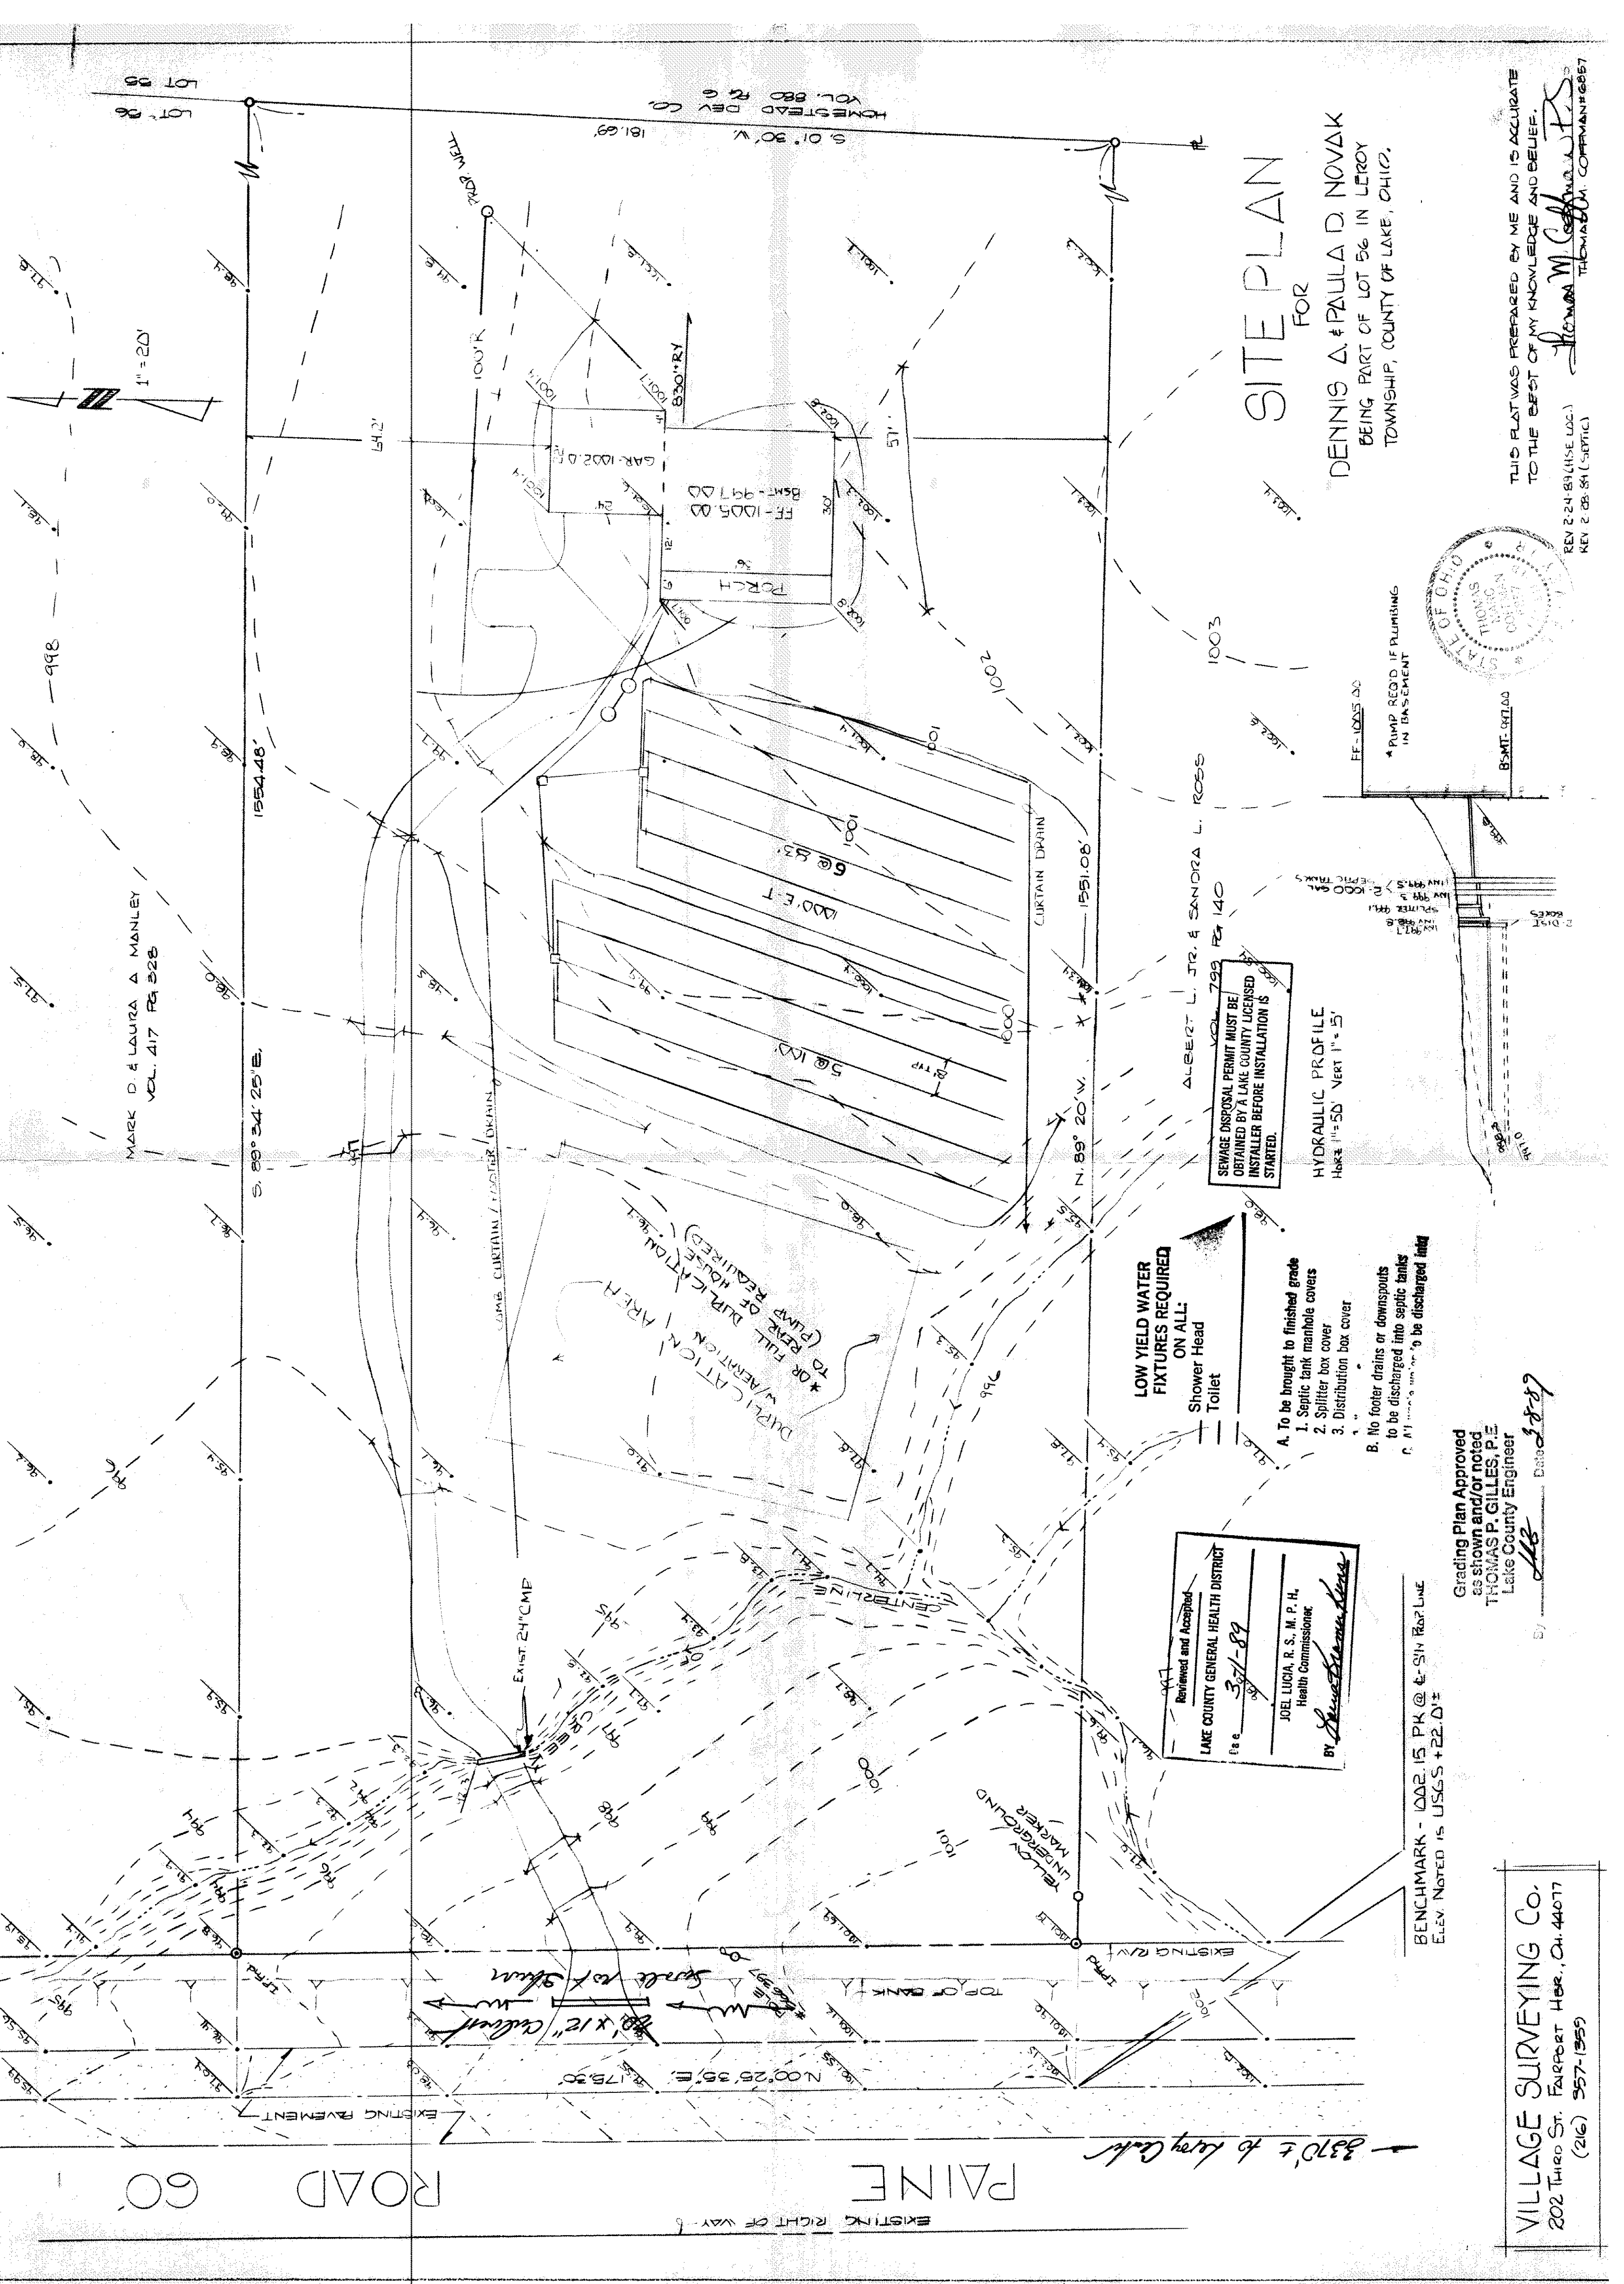

SITE PLAN
FOR

DENNIS A. & PAULA D. NOVAK
BEING PART OF LOT 56 IN LEROY
TOWNSHIP, COUNTY OF LAKE, OHIO.

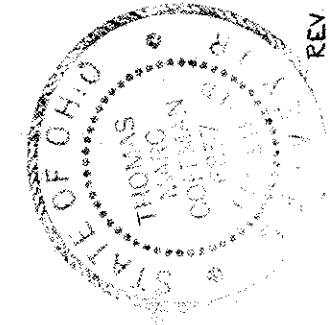

THIS PLAN WAS PREPARED BY ME AND IS ACCURATE
TO THE BEST OF MY KNOWLEDGE AND BELIEF.
THOMAS P. GILLES, P.E.
REV 2-24-89 (HSE LOC.)
KEY 2-28-84 (SEPTIC)

SEWAGE DISPOSAL PERMIT MUST BE
OBTAINED BY A LAKE COUNTY LICENSED
INSTALLER BEFORE INSTALLATION IS
STARTED.

HYDRAULIC PROFILE
HORIZ. 1"=50' VERT. 1"=5'

LOW YIELD WATER
FIXTURES REQUIRED
ON ALL:
Shower Head
Toilet

- A. To be brought to finished grade
1. Septic tank manhole covers
 2. Splitter box cover
 3. Distribution box cover
- B. No footer drains or downspouts
to be discharged into septic tanks
C. All surface water to be discharged into

Reviewed and Accepted
LAKE COUNTY GENERAL HEALTH DISTRICT
Date 3/1-89
BY Joel Lucia, R.S., M.P.H.
Health Commissioner

BENCHMARK - 1002.15 PK @ E-SIN ROAD LINE
ELEV. NOTED IS USGS +22.01'

Grading Plan Approved
as shown and/or noted
THOMAS P. GILLES, P.E.
Lake County Engineer

VILLAGE SURVEYING CO.
202 Third St. Fairport Harbor, OH 44017
(216) 957-1359