


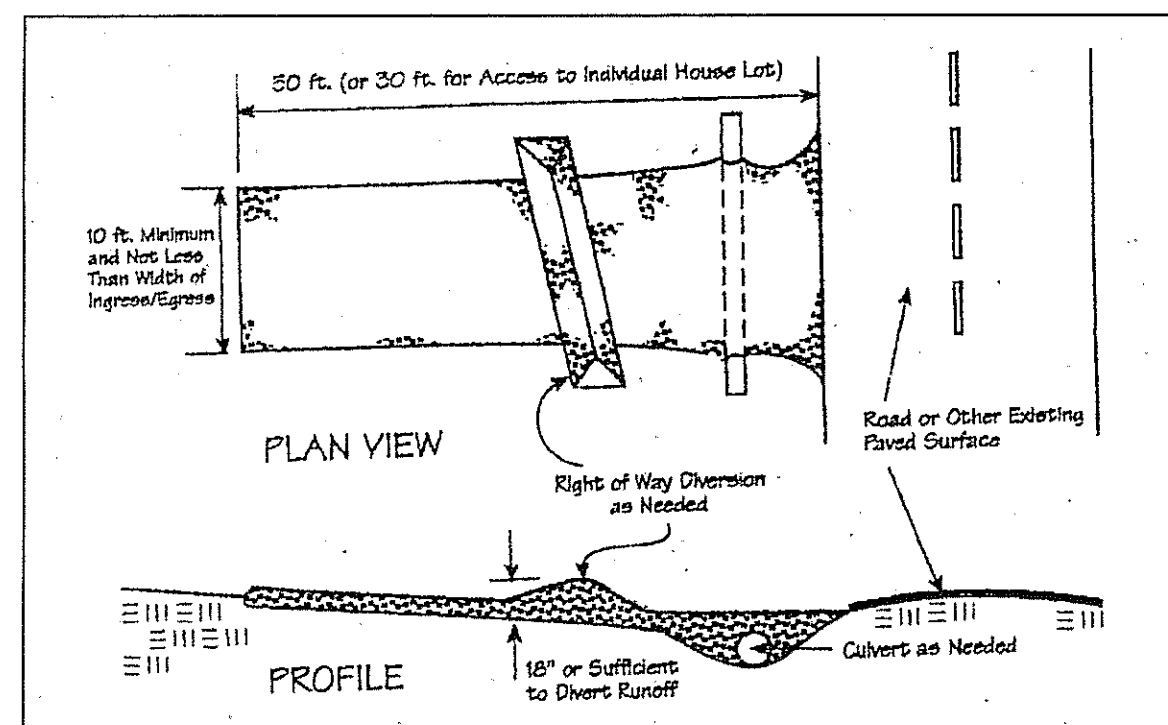

| Temporary Seeding Species Selection |                                                      |                            |          |
|-------------------------------------|------------------------------------------------------|----------------------------|----------|
| Seeding Dates                       | Species                                              | Lb./1,000 ft. <sup>2</sup> | Per Ac.  |
| March 1 to August 15                | Oats                                                 | 3                          | 4 bushel |
|                                     | Tall Fescue                                          | 1                          | 40 lb.   |
|                                     | Annual Ryegrass                                      | 1                          | 40 lb.   |
|                                     | Perennial Ryegrass                                   | 1                          | 40 lb.   |
|                                     | Tall Fescue                                          | 1                          | 40 lb.   |
|                                     | Annual Ryegrass                                      | 1                          | 40 lb.   |
| August 16 to November 1             | Rye                                                  | 3                          | 2 bushel |
|                                     | Tall Fescue                                          | 1                          | 40 lb.   |
|                                     | Annual Ryegrass                                      | 1                          | 40 lb.   |
|                                     | Wheat                                                | 3                          | 2 bushel |
|                                     | Tall Fescue                                          | 1                          | 40 lb.   |
|                                     | Annual Ryegrass                                      | 1                          | 40 lb.   |
|                                     | Perennial Ryegrass                                   | 1                          | 40 lb.   |
|                                     | Tall Fescue                                          | 1                          | 40 lb.   |
| November 1 to Spring Seeding        | Annual Ryegrass                                      | 1                          | 40 lb.   |
|                                     | Use much only, sodding practices or dormant seeding. |                            |          |

Note: Other approved seed species may be substituted.

Erosion and Sediment Control Schedule

Ingress-Egress  
A stone access drive complete with under lying geo-textile fabric (20 feet wide and 50 feet long) for ingress and egress at the site shall be installed. This drive shall be the only entrance and exit to the site.



Silt Fence  
A silt fence shall be installed prior to any earthwork activities at the site in the locations shown on the site plan as well as along the front of any lot that slopes towards the street.

Temporary Seeding  
Disturbed areas of the site that are to remain idle for more than twenty-one(21) days shall be properly seeded and straw mulched within seven(7) days of completion of initial grading.  
Temporary seeding and mulching as a thirty(30) foot strip of the entire front of the lot shall be maintained on the site once initial grading is complete.

Stabilization of critical areas within fifty(50) feet of any stream or wetland shall be complete within two(2) days of the disturbance if the site is to remain inactive for longer than fourteen(14) days.

Mulching  
Straw-mulch shall be applied at a rate of 1 bale per every ten (10) feet of curb, at a width of thirty(30) feet to the entire length of the lot. Wood chips may also be used but must be spread at a minimum depth of four inches over the thirty-foot width and must be accompanied by a properly installed silt fence.

Maintenance  
Erosion and sediment controls shall be inspected every seven(7) days or within 24 hours of a 0.5" or greater rainfall event. Necessary repairs shall be made at this time.

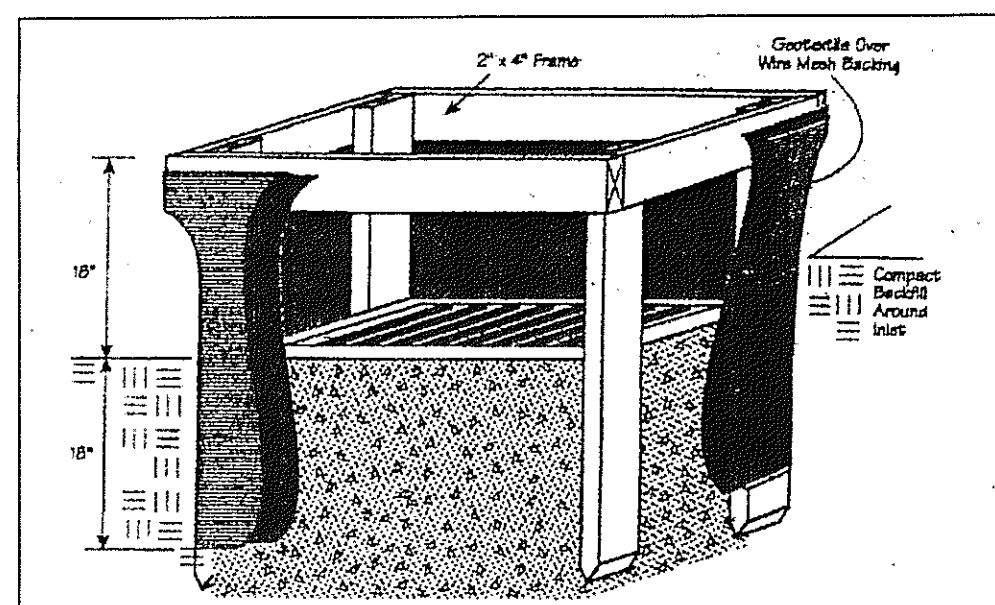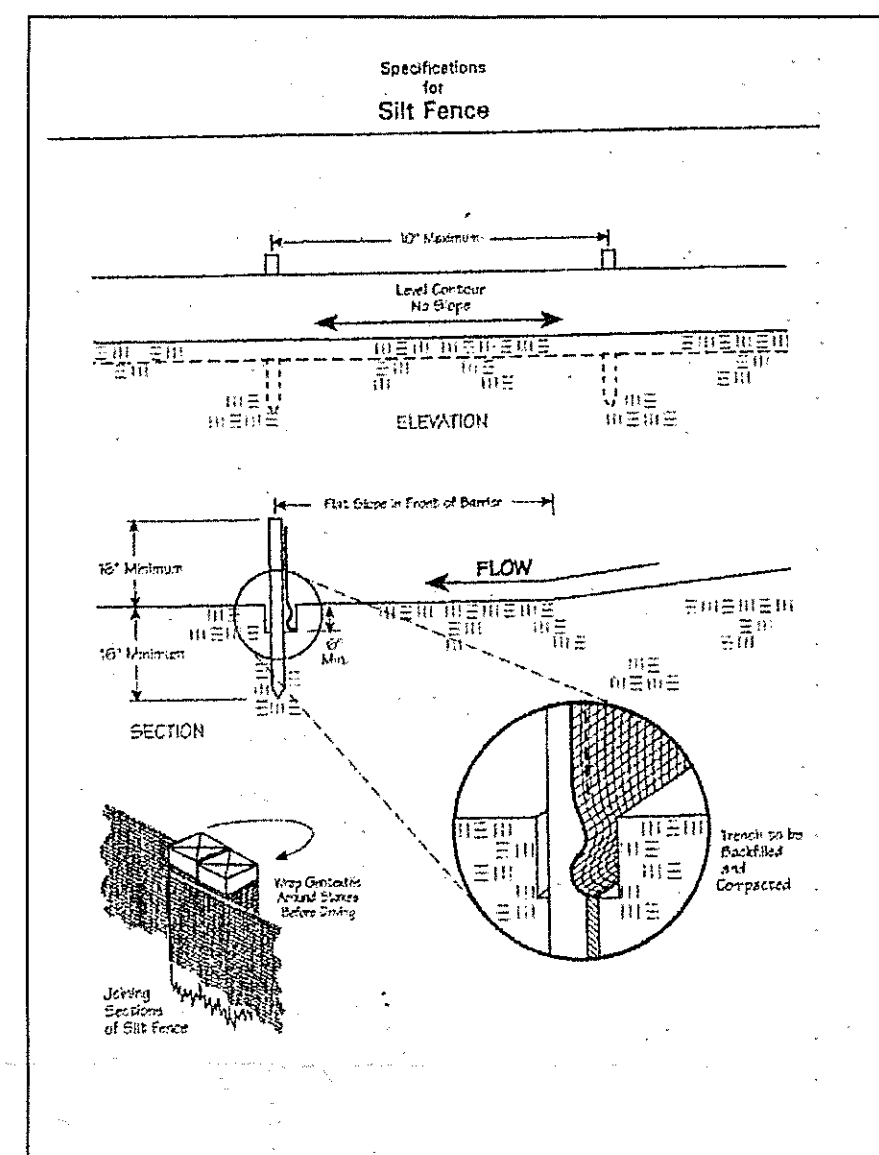

"I, the undersigned hereby certify that this topography indicated by 6", 1", or 2" contours, and elevations shown hereon represent an actual field survey made by me on the 9th day of Aug., 2003 and that the elevations were taken at appropriate intervals and that as of that date they existed as indicated hereon."

Name Larry Jones # 6343 Reg. No. \_\_\_\_\_

REVIEWED AND ACCEPTED  
LAKE COUNTY GENERAL  
HEALTH DISTRICT

Date 11/25/15 BY [Signature]

SEWAGE DISPOSAL PERMIT MUST BE  
OBTAINED BY A LAKE COUNTY LICENSED  
INSTALLER BEFORE INSTALLATION IS  
STARTED.

45'

32'

1ST FF 996.2

BSMT FF 997.3

3 BDRM

12 c.

24'

UNEX

21'





21.33'

21.33'

21'

1"=20'

NOTE:  
CONTACT O.D.O.T. (440) 354-2191  
ABOUT PERMIT

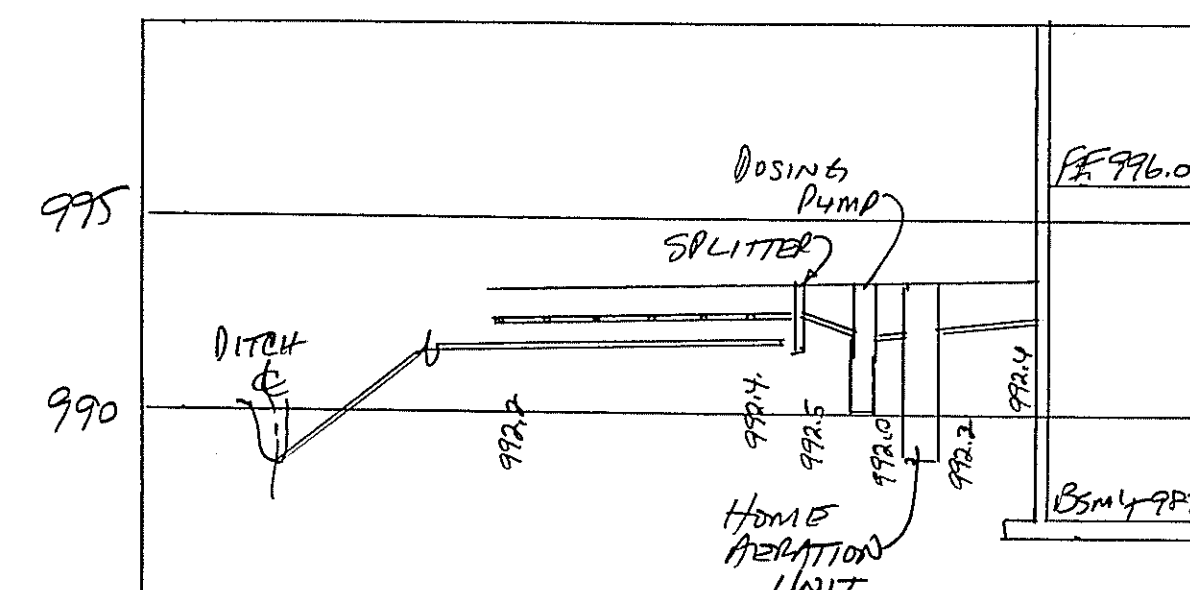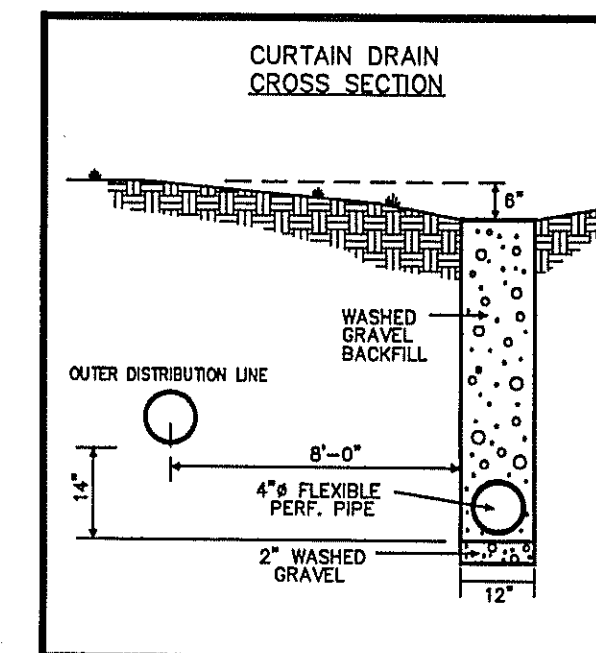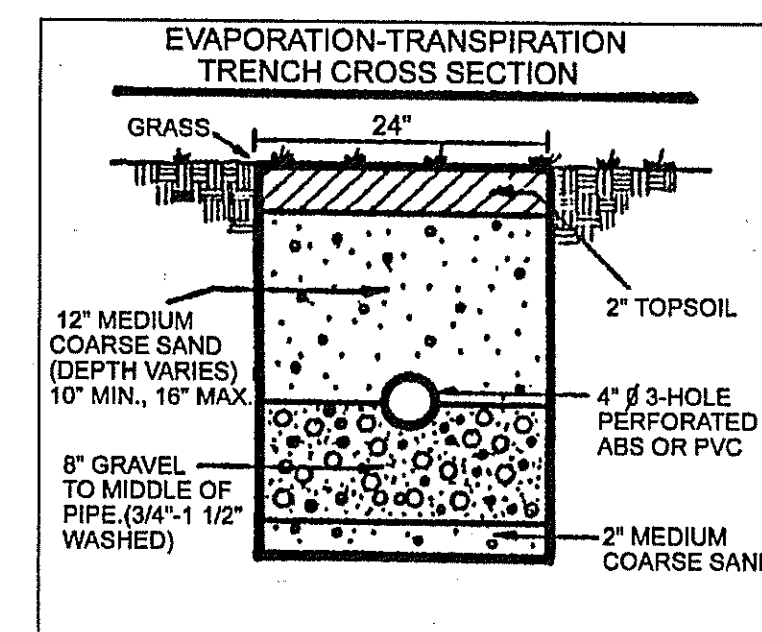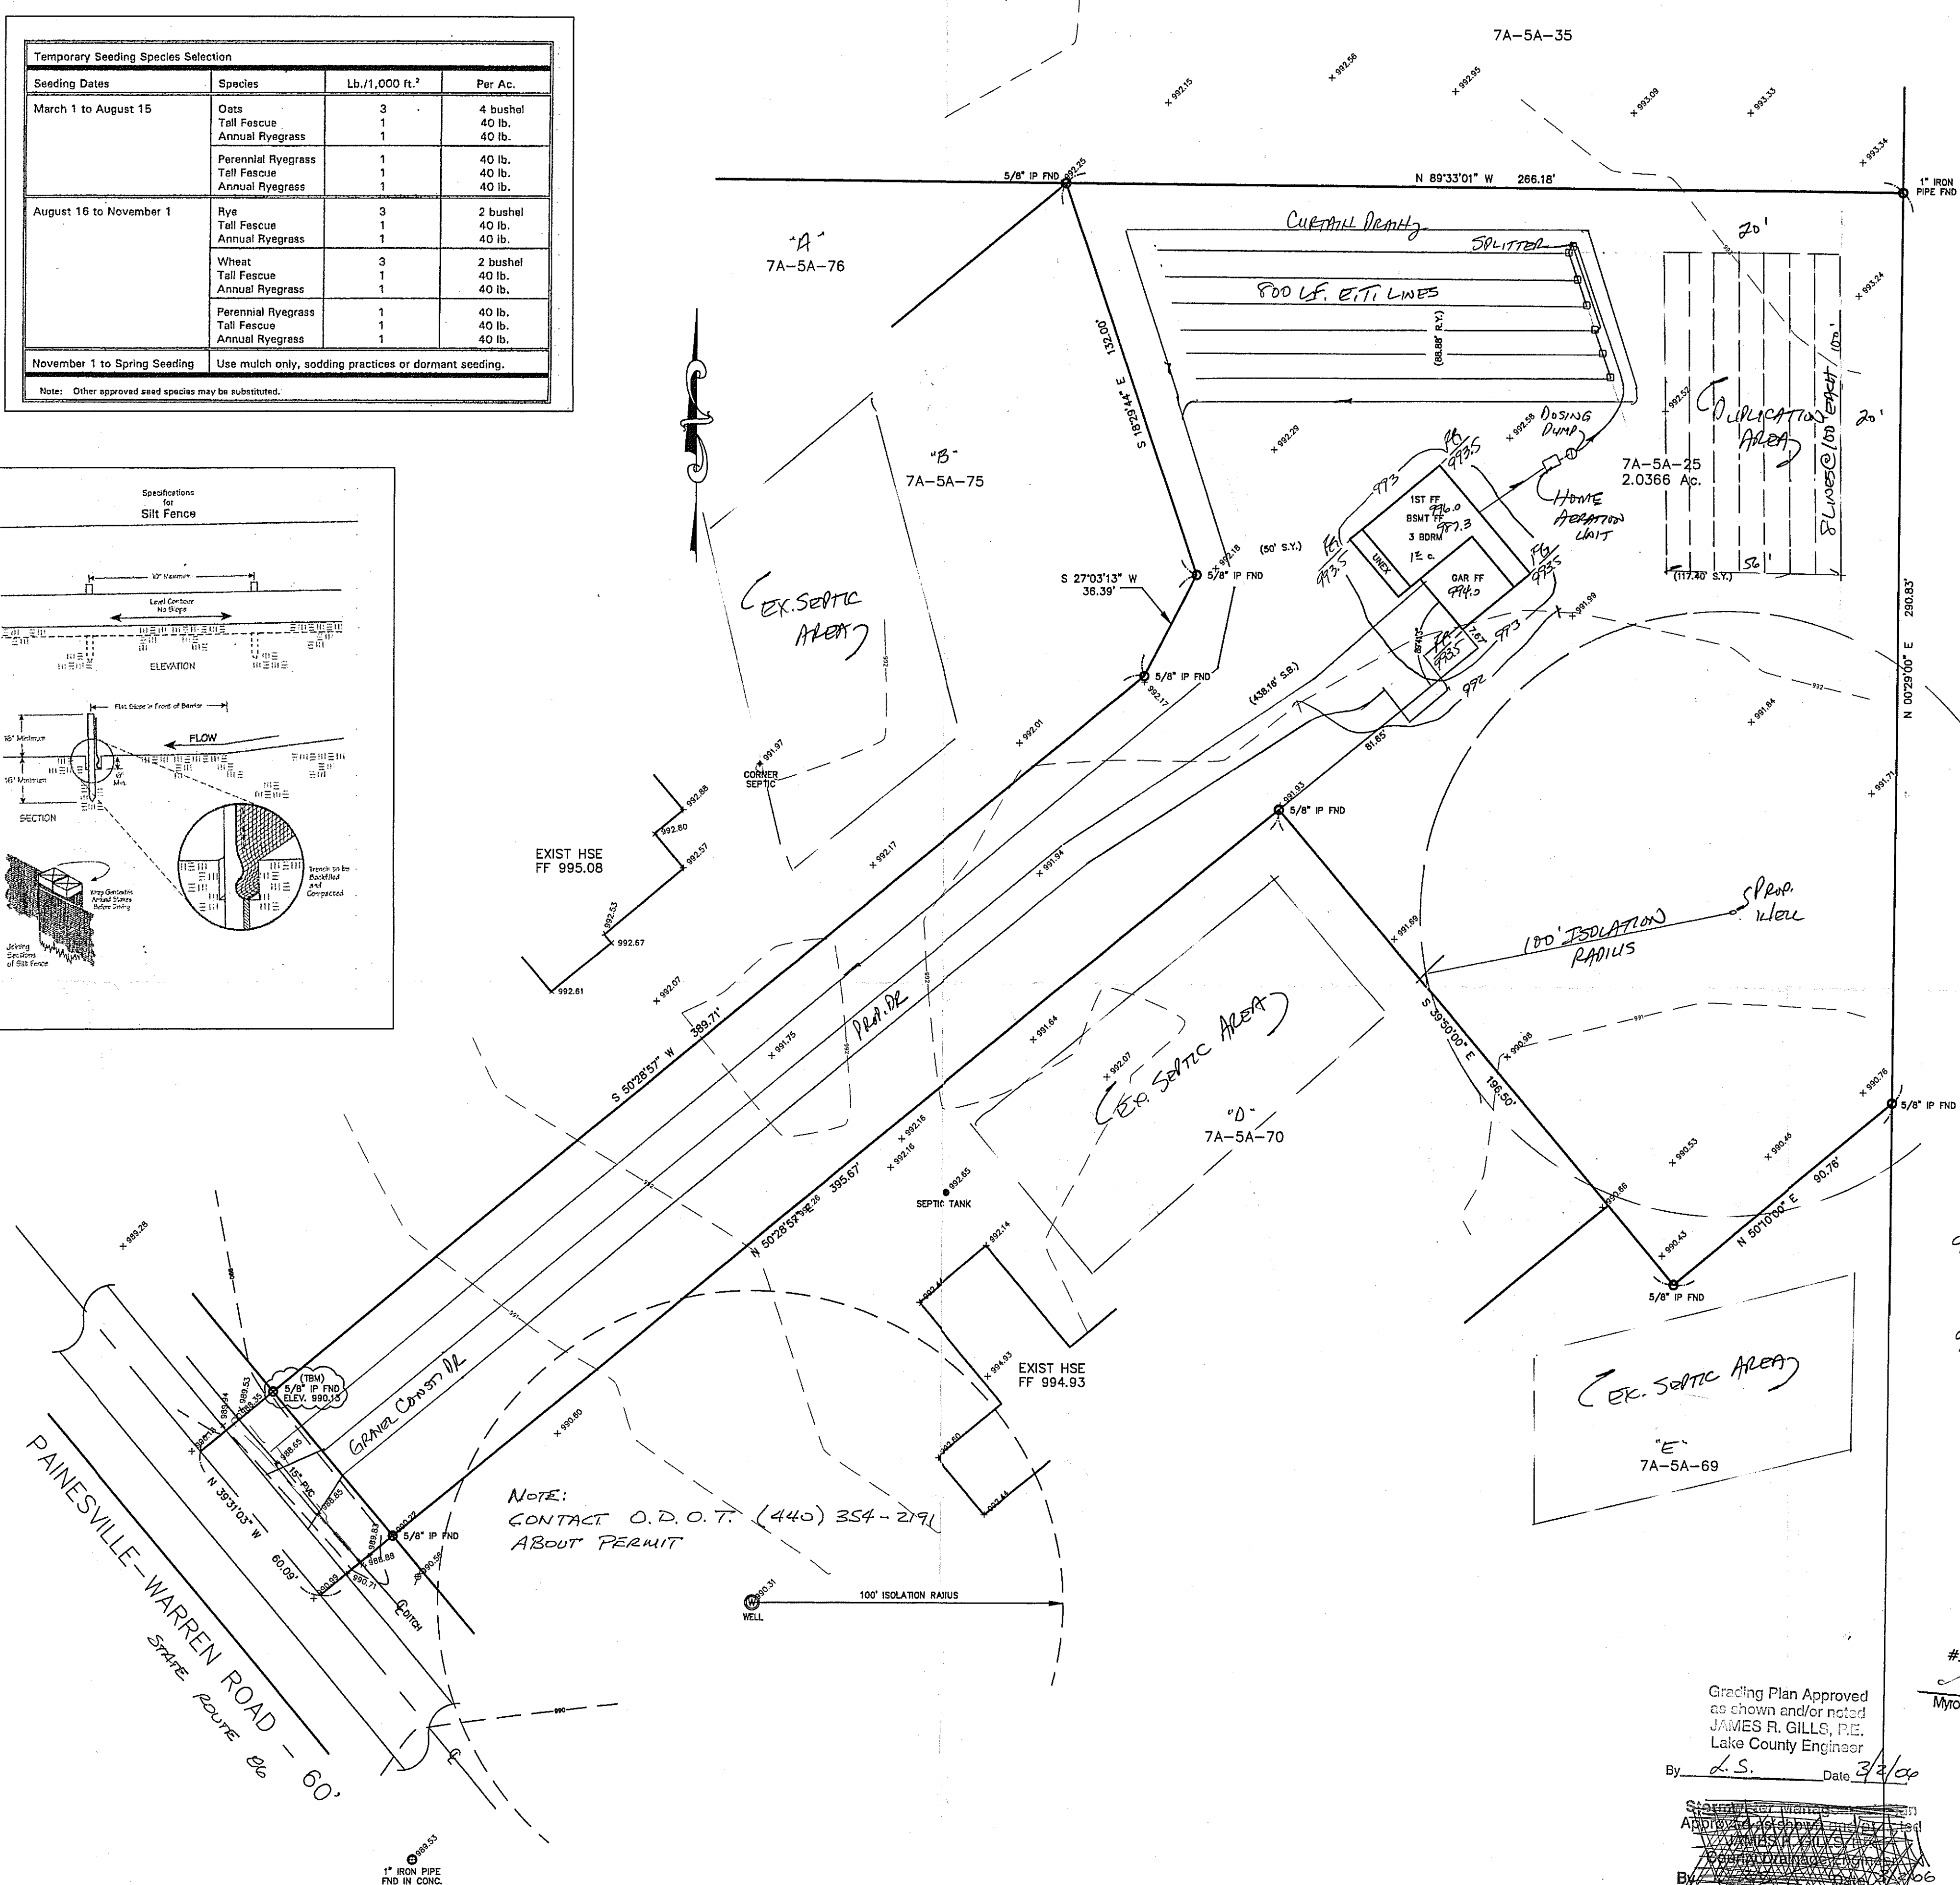

HYDRAULIC PROFILE  
HORIZ: 1"=30' VERT: 1"=5'

LEROY TOWNSHIP  
 Zoning Approved  
 # 4120  
*Myron Telieps*  
 Myron Telieps - Zoning Inspector

TBM - 5/8" IRON PIN FOUND  
ELEV - 990.13

Grading Plan Approved  
as shown and/or noted  
JAMES R. GILLS, P.E.  
Lake County Engineer

By L.S. Date 3/2/04


3. ~~\_\_\_\_\_~~

~~Approved by~~

~~JAMES R. GILS~~

By ~~\_\_\_\_\_~~

EXISTING UTILITIES NOTE:  
THE SIZE AND LOCATION, BOTH HORIZONTAL AND VERTICAL  
OF THE UNDERGROUND UTILITIES SHOWN HEREON, HAVE BEEN  
OBTAINED BY A SEARCH OF AVAILABLE RECORDS.  
VERIFICATION BY FIELD OBSERVATION HAS BEEN CONDUCTED  
WHERE PRACTICAL, HOWEVER, BABCOCK, JONES AND ASSOCIATE  
INC. DOES NOT GUARANTEE THE COMPLETENESS NOR ACCURACY  
THEREOF.

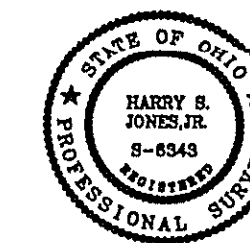

| REV NO. | DESCRIPTION                  | DATE     | BY | CHK'D |
|---------|------------------------------|----------|----|-------|
| 1       | REVISION PER L.C. HENRY DEPT | 11-15-05 | HT | HT    |
|         |                              |          |    |       |
|         |                              |          |    |       |
bj

BABCOCK, JONES AND ASSOCIATES, INC

CIVIL ENGINEERS - SURVEYORS - LAND PLANNERS  
PAINESVILLE OHIO 44077

DATE 8/12/05

DESIGN BY 11

DRAWN BY R. E.

APPROVED BY \_\_\_\_\_

|            |     |
|------------|-----|
| CREW CHIEF | W F |
|------------|-----|

SITE PLAN  
FOR  
JACK WATERWASH

PAINESVILLE WARREN ROAD (P.P.# 7A-5A-25)  
LEROY TOWNSHIP LAKE COUNTY STATE OF OHIO

SCALE 1"=30'

|        |    |     |     |
|--------|----|-----|-----|
| JOB NO | 01 | 011 | ... |
|--------|----|-----|-----|

SHEET / OF

1 / 1