


Grading Plan Approved
as shown and/or noted
JAMES R. GILLS, P.E.
Lake County Engineer

- By TAM Date 3/27/01
1. SUBJECT TO LEROY TWP ZONING APPROVAL
 2. A PERMIT MAY BE REQUIRED FROM ODOT FOR WORK WITHIN R/W. CULVERT SUBJECT TO ODOT APPROVAL.
 3. SWALE AS SHOWN

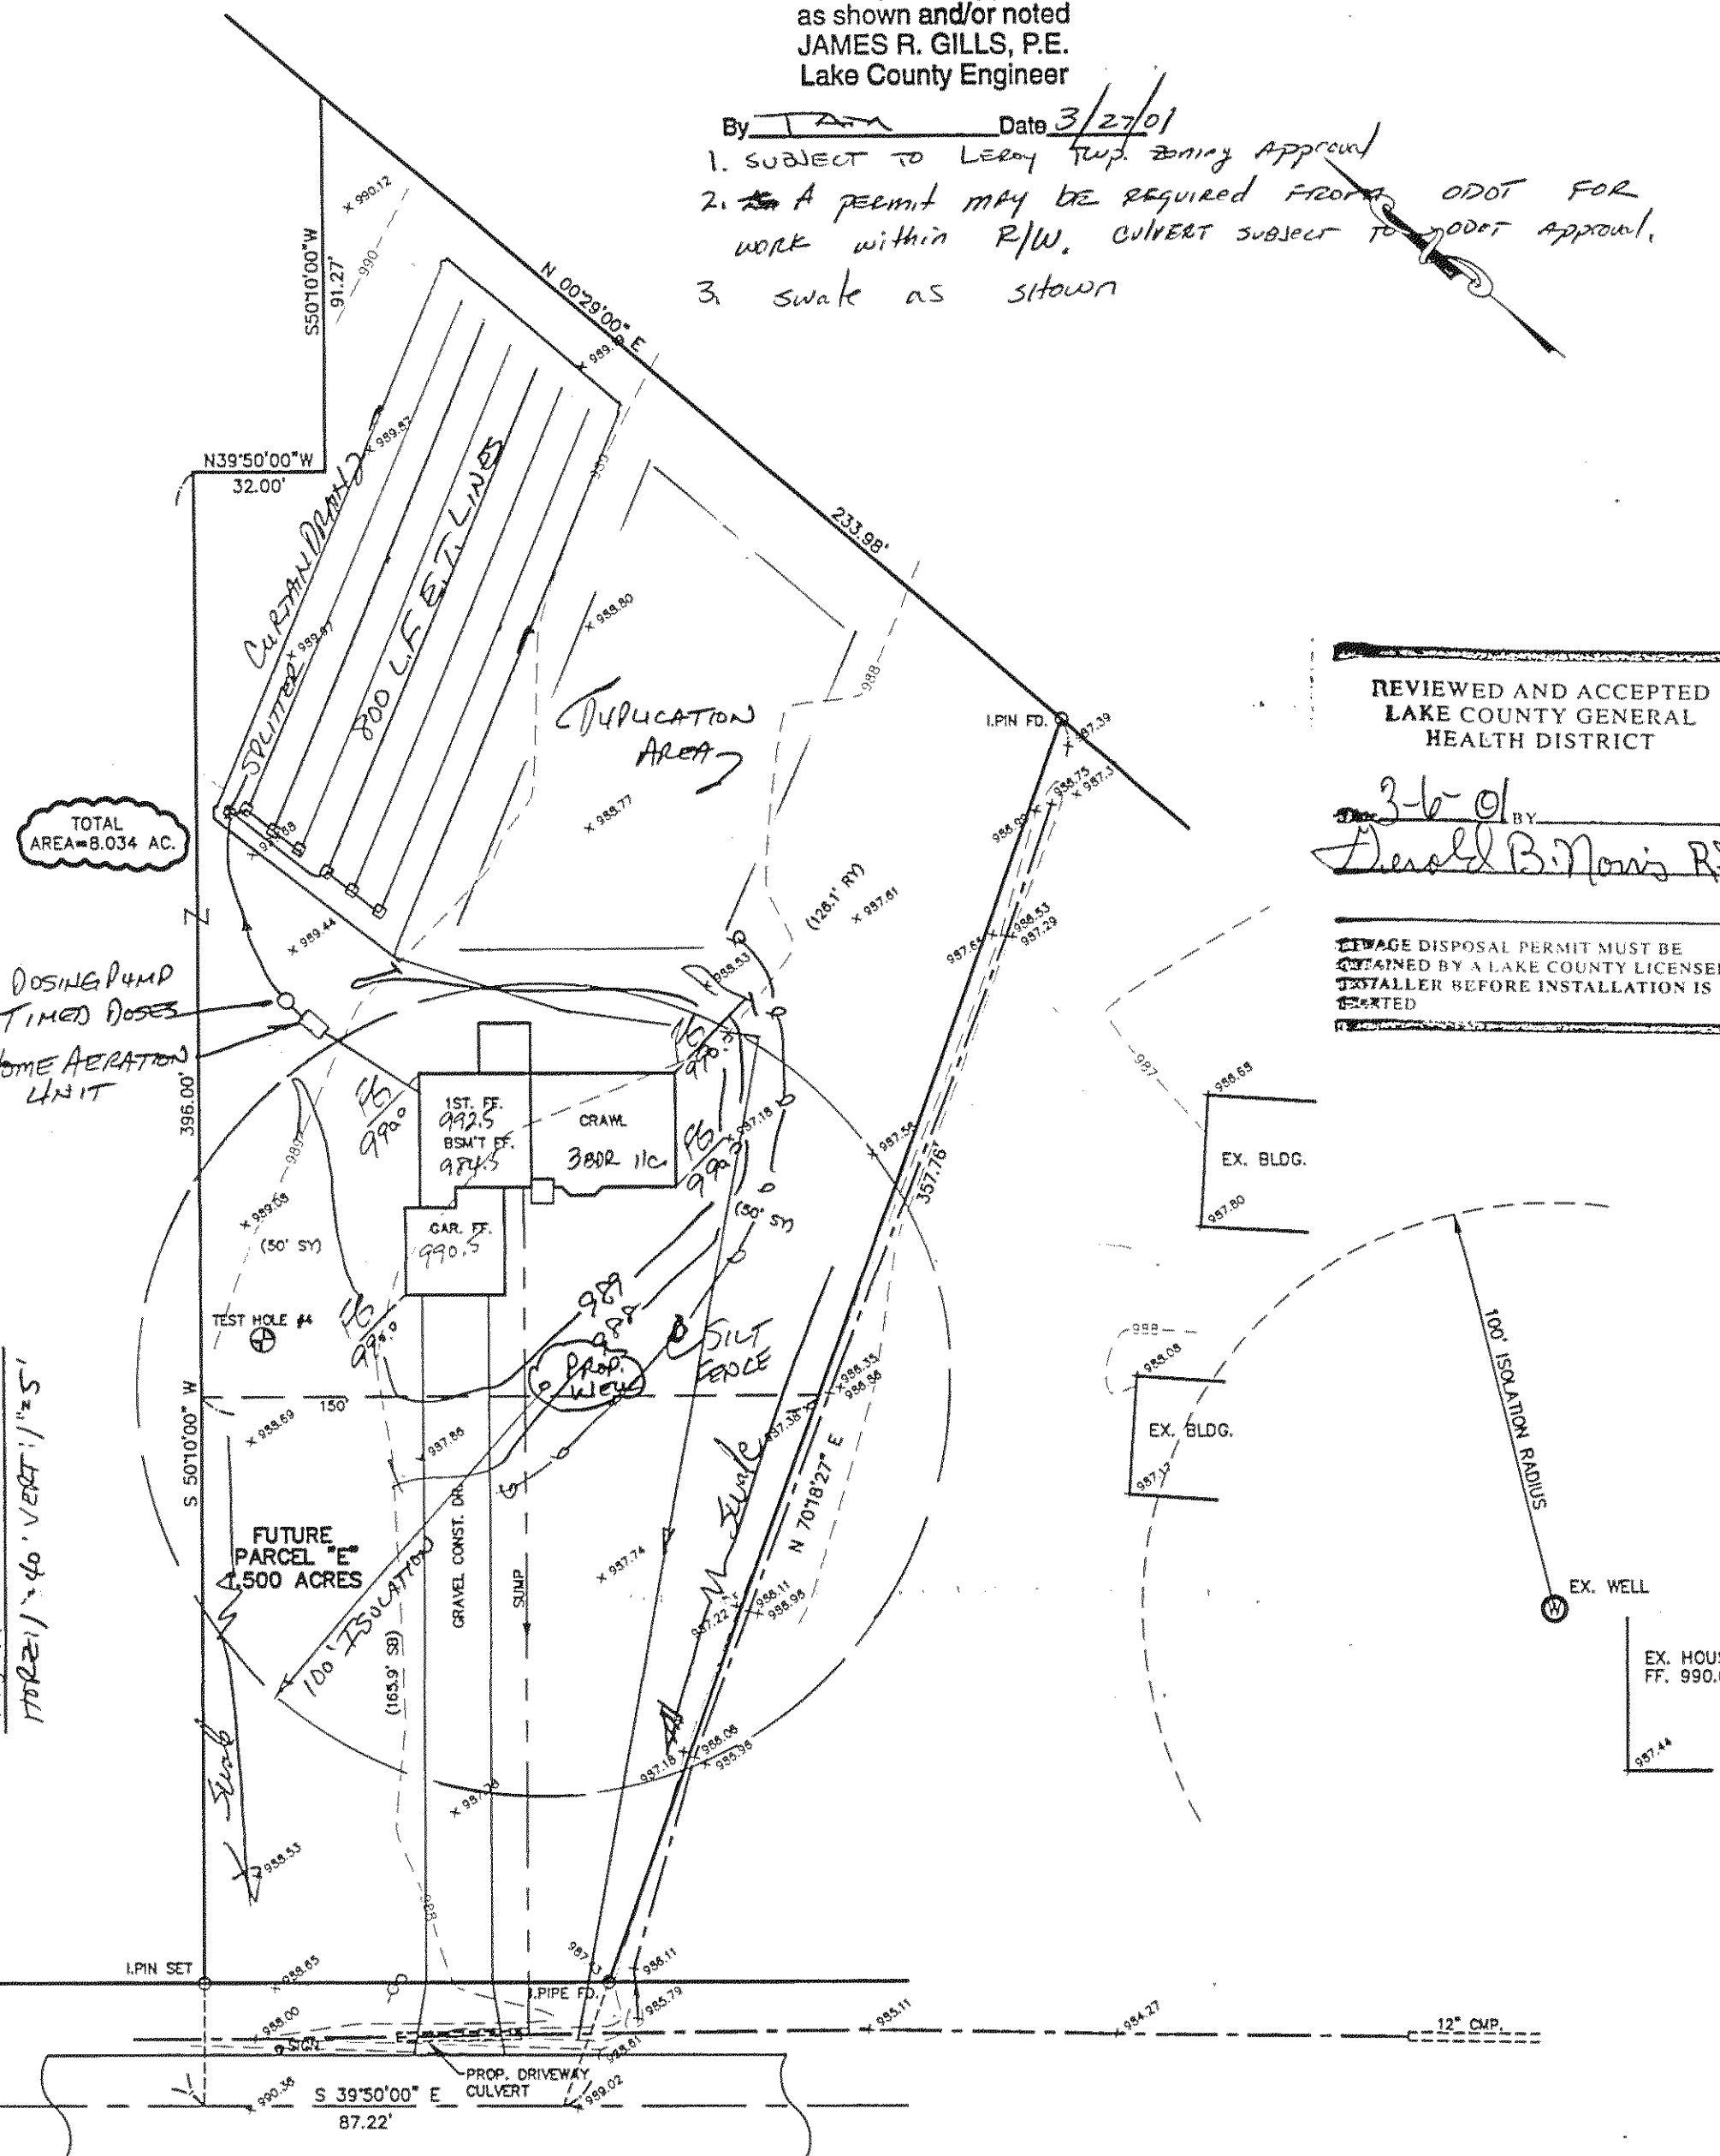

REVIEWED AND ACCEPTED
LAKE COUNTY GENERAL
HEALTH DISTRICT

3-6-01 BY
Dorell B. Norris RS

SEWAGE DISPOSAL PERMIT MUST BE
OBTAINED BY A LAKE COUNTY LICENSED
INSTALLER BEFORE INSTALLATION IS
COMPLETED

SITE PLAN

LEROY TOWNSHIP, LAKE COUNTY, OHIO
for: JACK WATERWASH

ADDRESS	STREET	CITY	ZIP
SUBDIVISION	NAME	TRACT	STREET
SUBLOT NO.	STREET	VOL.-PG.	PERM. PARCEL NO.

LEGEND

SANITARY MANHOLE	1	EXIST. ELEV. 100.0	PROP. ELEV. 100.0
STORM MANHOLE	2		
INLET OR CATCH BASIN	3		
HYDRANT	4		
EXISTING CONTOURS	5		
PROPOSED CONTOURS	6		

REMARKS

ALL BOUNDARY DATA SHOWN WAS OBTAINED FROM (DEEDS, RECORDED
SUBDIVISION PLAT OR OTHER PUBLIC RECORDS)
LOCATIONS AS SHOWN OF ADJACENT WELLS AND SEPTIC TANKS OBTAINED FROM
LAKE COUNTY HEALTH DEPARTMENT

DESIGN CERTIFICATION

THIS PLAN WAS PREPARED BY ME, AND IS CORRECT
TO THE BEST OF MY KNOWLEDGE AND BELIEF.

NAME HARRY S. JONES, JR. SURVEYOR REGISTRATION NO. 6343

CHECK LIST

NO. OF BEDROOMS	WATER MAIN SIZE, LOCATION
DIMENSIONS	SAN. SEWER SIZE & GR. LOC.
BEARINGS	SAN. MH. CAST. ELEV. INV. ELEV.
TIE TO NEAREST STREET	SAN. CONN. SIZE, LOC. DEPTH
SUBLOT NO. PARCEL NO.	STORM SEWER SIZE & GR. LOC.
SURROUNDING OWNERS	STORM MH. CAST. ELEV. INV. ELEV.
BLDG. DIMENSIONS FIN GR.	PAVT TYPE GRADE CURBS
BLDG. TIES FL'R. GRADES	GAS LINE LOC. SIZE PRESSURE
APRON TYPE WIDTH THICKNESS	SEPTIC TANK LOCATION & DUPLICATION AREA
SIDEWALK TYPE WIDTH THICKNESS	WELL LOCATION
CULVERT TYPE DIA. LENGTH	ISOLATION RADIUS FROM WELL
ROCK OUTCROPPINGS	

NO.	DATE	BY	PLAN PREPARED BY:
1	3/16/01	HJ	BABCOCK JONES & ASSOCIATES, INC.
2			PAINESVILLE, OHIO
3			DRAWN BY T.R. SCALE 1"=40' PHONE NO. 440-357-1811
4			CHK'D. H.J. DATE 2/17/01 DRAWING NO. 01-011-E
5			CREW CHIEF W.B. APP'D H.J.



"AS BUILT" CERTIFICATION
I, HEREBY CERTIFY THAT THE CIRCLED GRADES ARE EXISTING
FINISH GRADES CHECKED IN THE FIELD ON 20
AND ARE CORRECT TO THE BEST OF MY KNOWLEDGE AND BELIEF.

REGISTERED SURVEYOR

REG. NO.

"I, the undersigned hereby certify that
this topography indicated by 6", 1", or 2"
contours, and elevations shown hereon
represent an actual field survey made by
me on the 16th day of FEB, 2001
and that the elevations were taken at
appropriate intervals and that as of that
date they existed as indicated hereon."

Name HARRY S. JONES, JR. #6343
Reg. No.

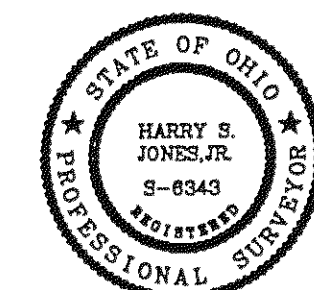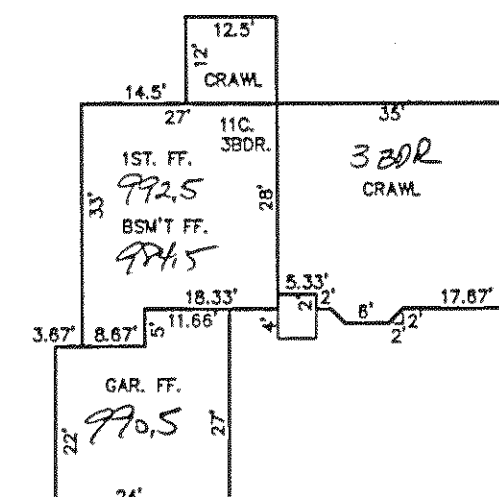

NOTE: TEMPORARY SEEDING REQUIRED
IN DISTURBED AREAS.