

SITE PLAN

for: **Edward Fisher**
OWNER
19700 Painesville-Warren Rd., Leroy
CLIENT
TOWNSHIP
LEROY
LAKE COUNTY, OHIO

SUBDIVISION
NAME
VOL. - PG.
LOT
TRACT
PAGE
PERM. PARCEL NO.
STREET
CITY
ZIP

LEGEND
INDICATES
DIRECTION OF
SURFACE DRAINAGE
AS BUILT ELEVATION
WATER METER (GAS)
WATER VALVE (GAS)
STORM MANHOLE
INLET OR CATCH BASIN
HYDRANT
EXISTING CONTOURS
PROPOSED CONTOURS
EXIST. ELEV. 100.0
PROP. ELEV. 100.0

REMARKS
ALL BOUNDARY DATA SHOWN WAS OBTAINED FROM (DEEDS, RECORDED
SUBDIVISION PLAT OR OTHER PUBLIC RECORDS)
LOCATIONS AS SHOWN OF ADJACENT WELLS AND SEPTIC TANKS OBTAINED FROM
LAKE COUNTY HEALTH DEPARTMENT

DESIGN CERTIFICATION
THIS PLAT WAS PREPARED BY ME, AND IS CORRECT
TO THE BEST OF MY KNOWLEDGE AND BELIEF.
SURVEYOR REGISTRATION NO. 6393

CHECK LIST
NO. OF BEDROOMS
DIMENSIONS
TIE TO NEAREST STREET
SUBLOT NO., PARCEL NO.
BLDG. DIMENSIONS FIN. GR.
BLDG. TIES F.T.M. GRADES
APRON TYPE WIDTH THICKNESS
SIDEWALK TYPE DIA., LENGTH
ROCK OUTCROPPINGS
WATER MAIN SIZE, LOCATION
SAN. SEWER SIZE % GR. LOC.
SAN. MH. CAST. ELEV. INV. ELEV. *
SAN. CONN. SIZE, LOC. DEPTH
STORM SEWER SIZE % GR. LOC.
STORM MH. CAST ELEV. INV. ELEV.
PAVT TYPE GRADE CURBS
GAS LINE LOC. SIZE PRESSURE
SEPTIC TANK LOCATION & DUPLICATION AREA
WELL LOCATION
ISOLATION RADIUS FROM WELL

REVISIONS		PLAN PREPARED BY:	
NO.	DATE	BY	
1	5/2/85	HT	
BABCOK • JONES & ASSOCIATES, INC.			
PAINESVILLE, OHIO			
2			
3			
4			
5			
DRAWN BY		SCALE	
HT		1" = 50'	
DATE		PHONE NO.	
9-16-85		357-1811	
CHK'D.		DRAWING NO.	
HT		85-005	
APP'D.			
HT			

"AS BUILT" CERTIFICATION
I, HEREBY CERTIFY THAT THE CIRCLED GRADES ARE EXISTING
FINISH GRADES CHECKED IN THE FIELD ON
AND ARE CORRECT TO THE BEST OF MY KNOWLEDGE AND BELIEF.
REG. NO. 19

T.B.M. - TOP OF IRON PIN GLE
DETAIL OF PAPER




LERROY TOWNSHIP
Zoning Approved
#1461-10-17-85
Zoning Inspector



Grading Plan Approved
as shown and/or noted
THOMAS P. GILLES, P.E.
Lake County Engineer
Date 11.4.85

FREDERICK LEININGER
(VACANT)

PAINESVILLE WARREN ROAD

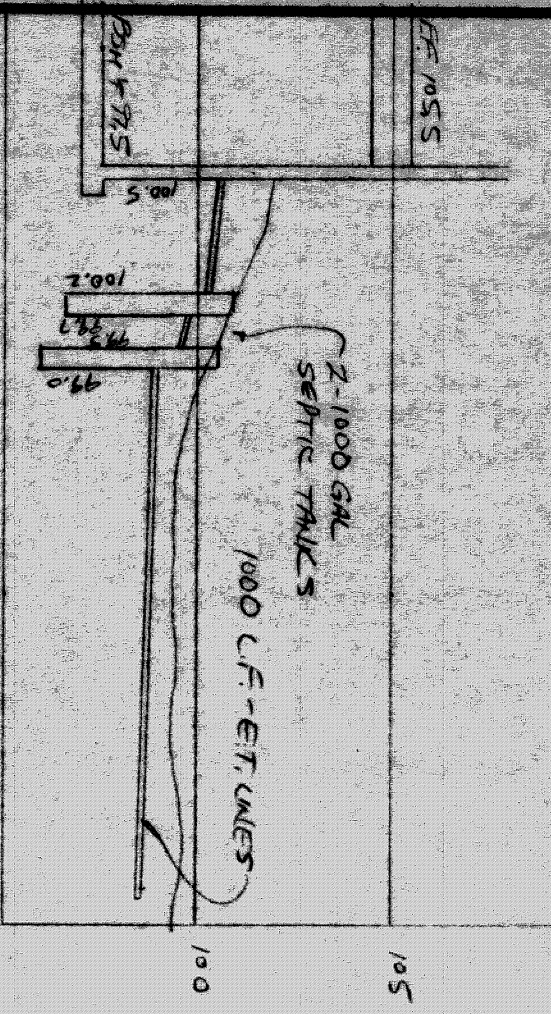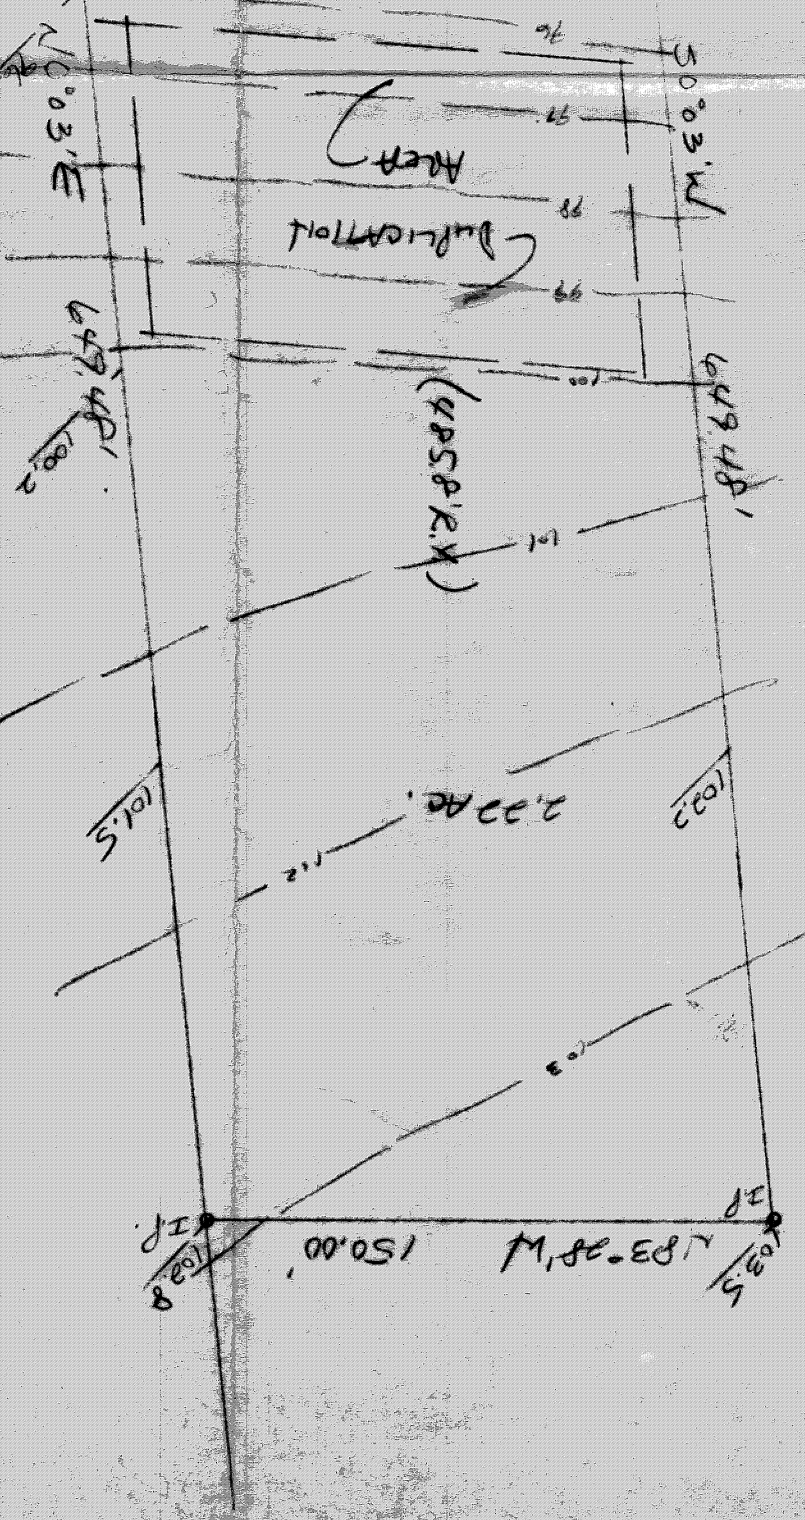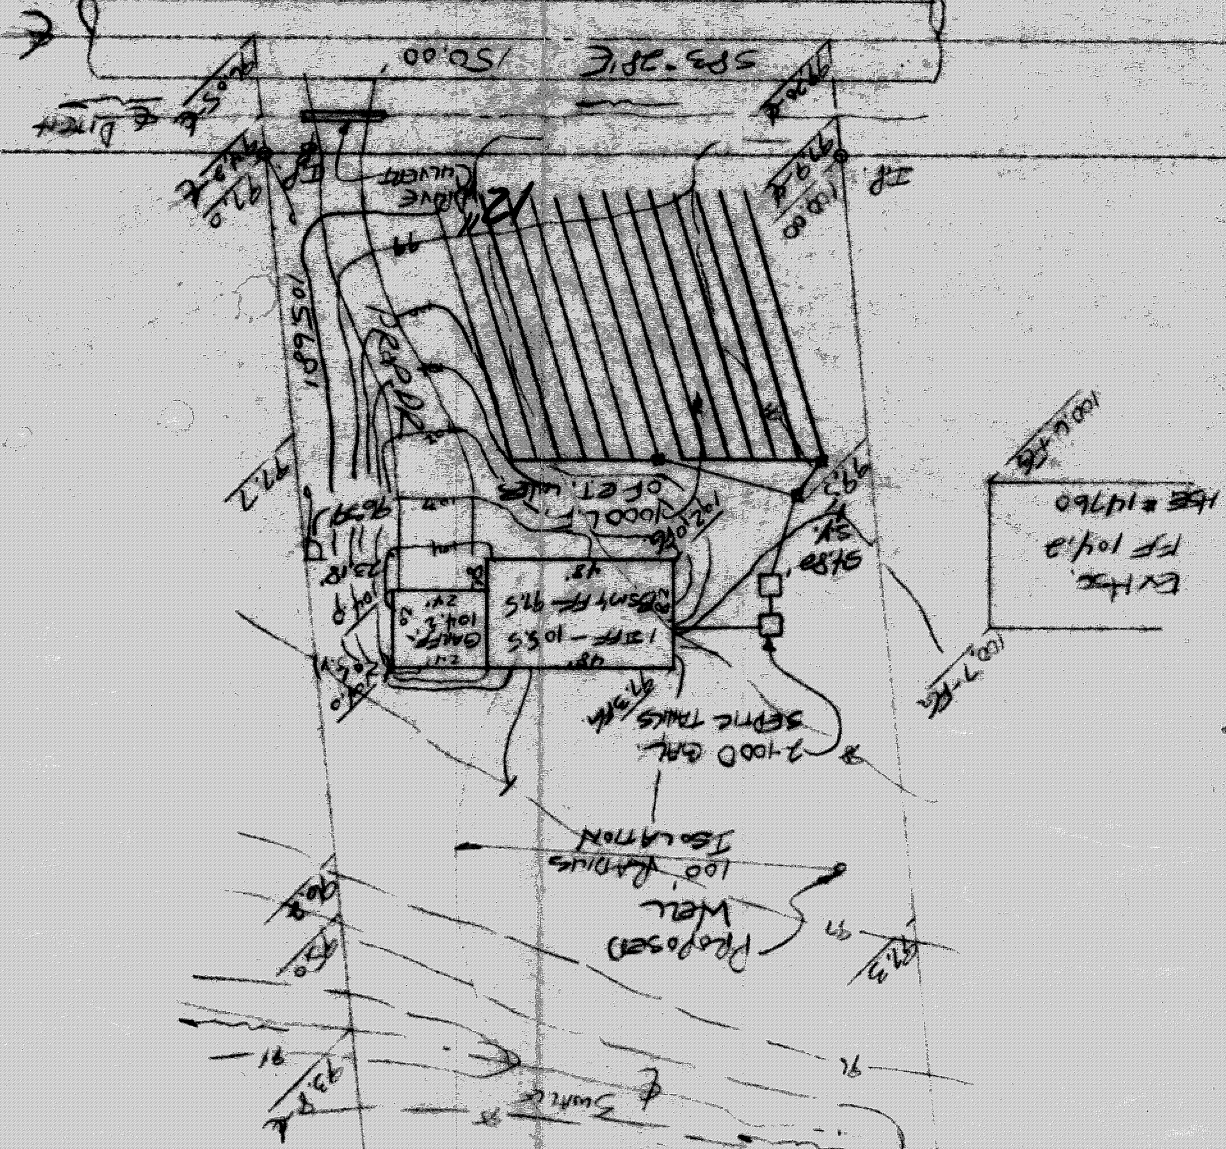

HYDRAULIC PROFILE
SCALE: HORIZ. 1" = 50'
VERT. 1" = 5'

EDWARD FISHER
VA. L68-PG. 579