


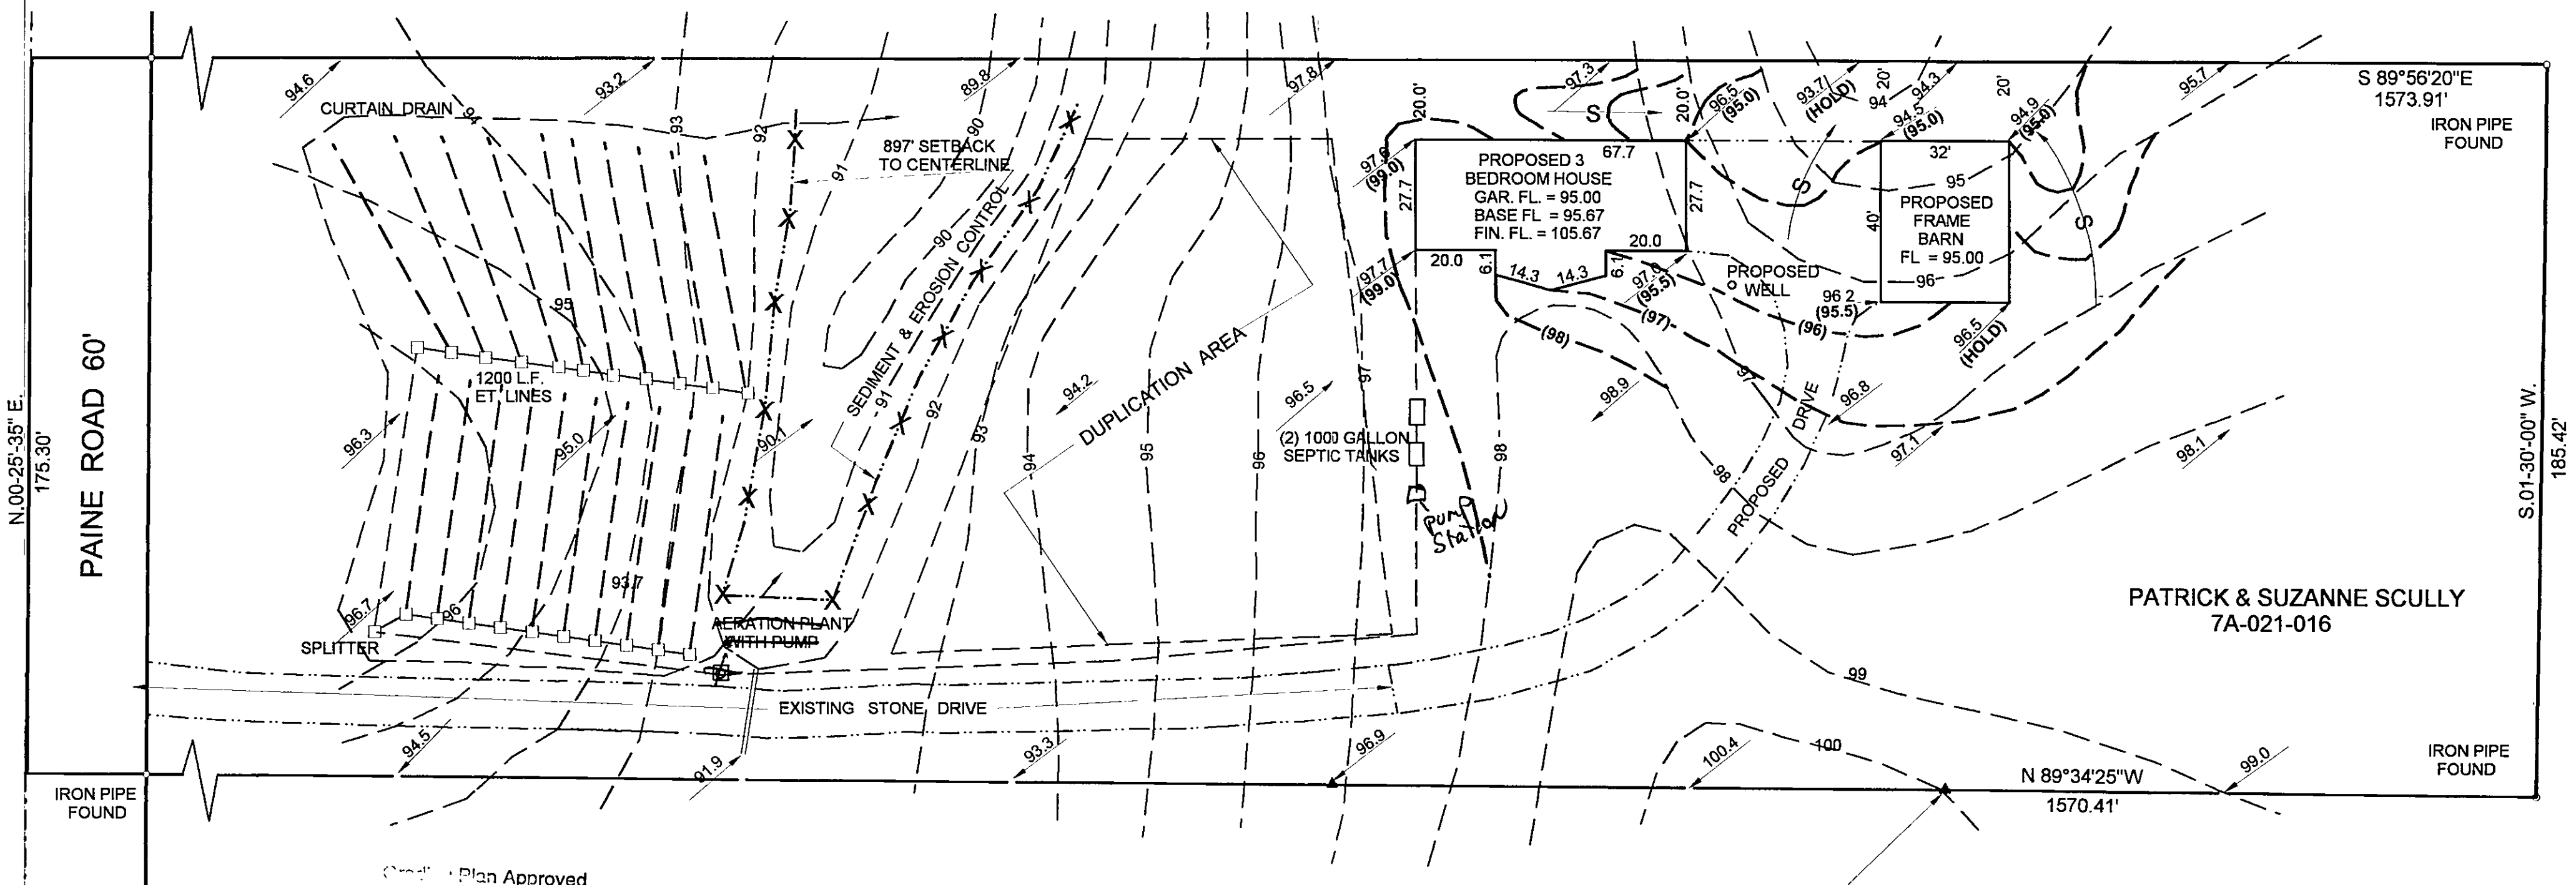

Conditional Plan Approved
 By: *[Signature]* Date: 3/6/2003
 JAMES R. GILLS, P.E.
 Lake County Engineer

SITE PLAN
 FOR
PATRICK & SUZANNE SCULLY
 KNOWN AS BEING PART OF LOT 56
 IN RANGE 7, TOWNSHIP 10 OF THE
 CONNECTICUT WESTERN RESERVE
 TOWNSHIP OF LEROY
 COUNTY OF LAKE STATE OF OHIO


- NOTES: 1.) WATER SAVING TOILETS AND SHOWER HEADS TO BE INSTALLED.
 2.) DOWNSPOUTS AND FOOTER DRAINS TO BE DIRECTED AWAY FROM SEPTIC SYSTEM
 3.) SEDIMENT AND EROSION CONTROL IS TO BE INSTALLED ADJACENT TO DITCH AND IS TO BE MAINTAINED THROUGHOUT CONSTRUCTION.

REVIEWED AND ACCEPTED
 LAKE COUNTY GENERAL
 HEALTH DISTRICT


Date: 12-11-02 BY: *[Signature]*
 David B. Morris

SEWAGE DISPOSAL PERMIT MUST BE
 OBTAINED BY A LAKE COUNTY LICENSED
 INSTALLER BEFORE INSTALLATION IS
 STARTED

BENCH MARK
 TOP OF HUB
 ELEV. 100.00

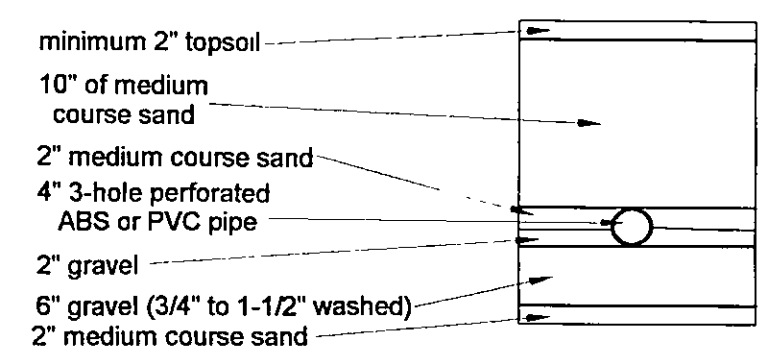


TYPICAL EVAPOTRANSPIRATION TRENCH CROSS SECTION

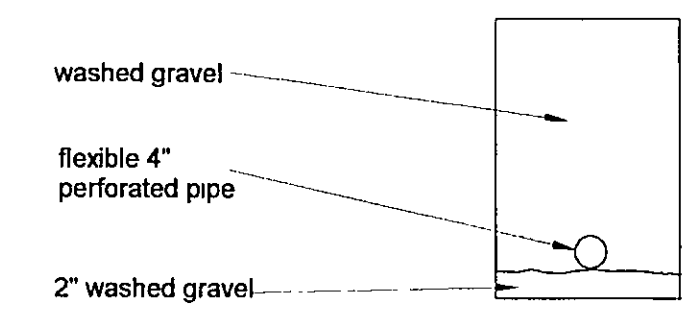

TYPICAL CURTAIN DRAIN CROSS SECTION

HYDRAULIC PROFILE


SCALE
 VERTICAL 1" = 4'
 HORIZONTAL 1" = 30'

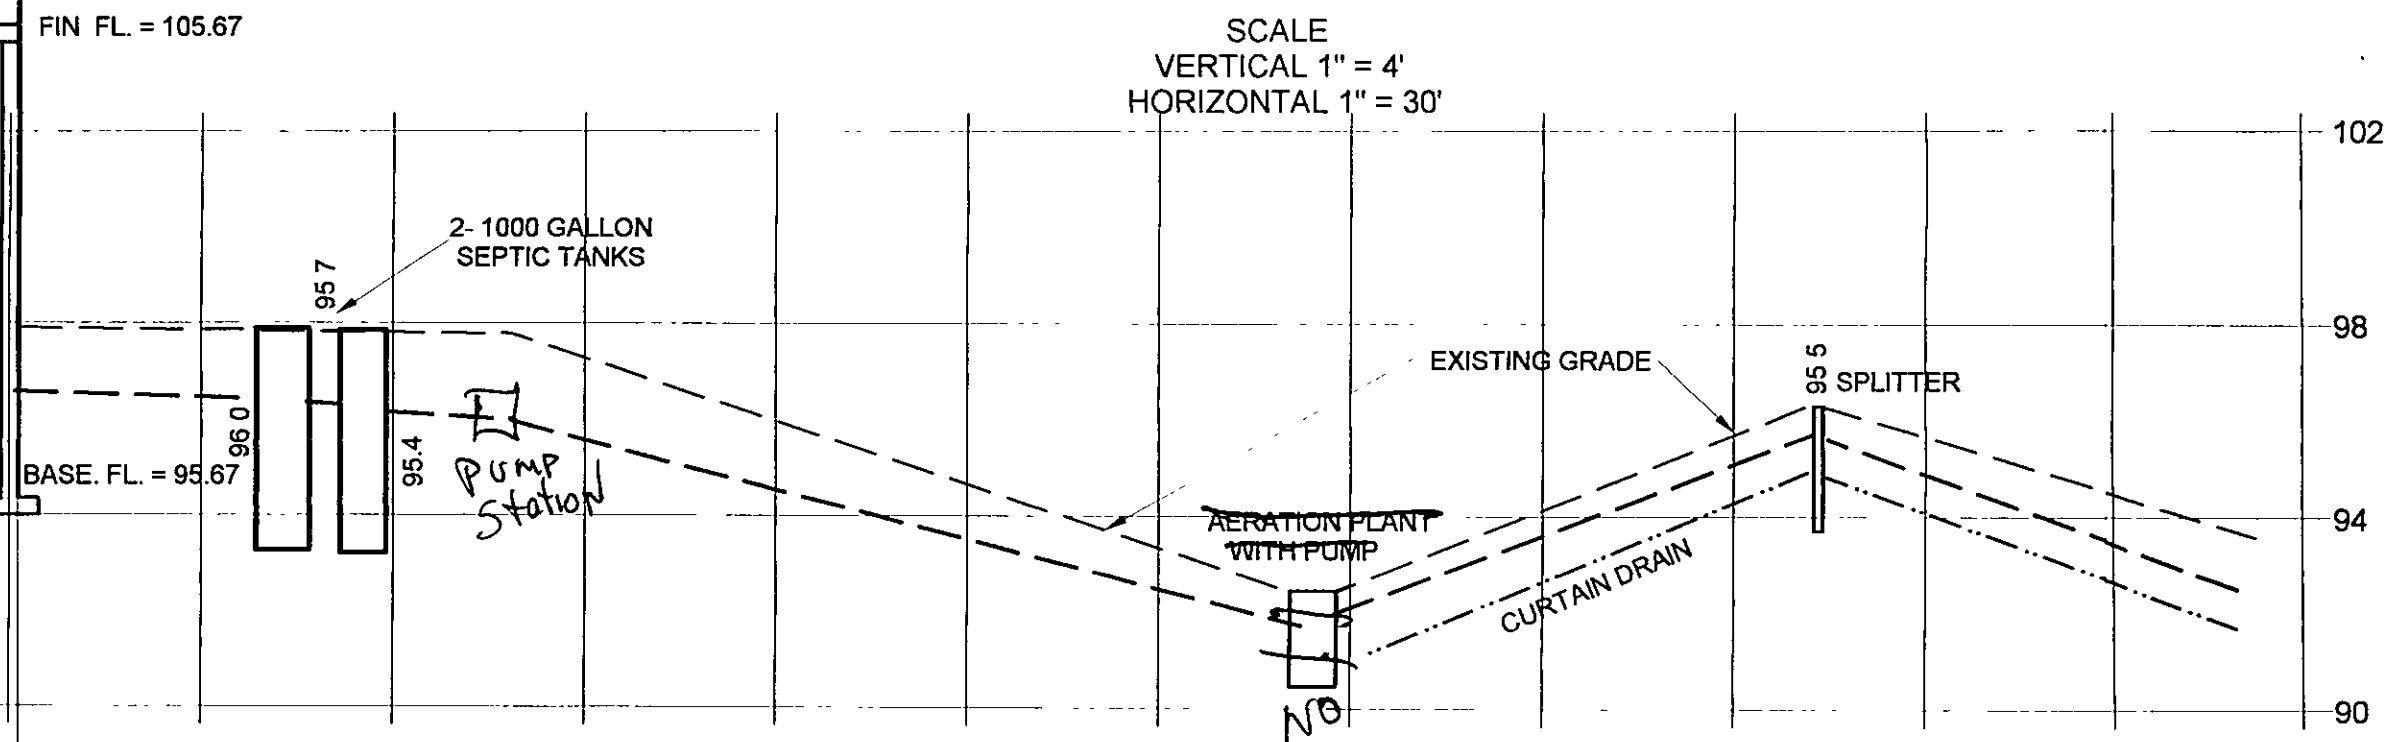

"I, THE UNDERSIGNED HEREBY CERTIFY THAT THE TOPOGRAPHY SHOWN HEREON, INDICATED BY 1 FOOT CONTOURS AND ELEVATIONS REPRESENTS AN ACTUAL FIELD TOPOGRAPHIC SURVEY MADE BY ME ON THE 18th DAY OF NOVEMBER, 2002 AND THAT THE ELEVATIONS WERE TAKEN AT APPROPRIATE INTERVALS AND THAT AS OF THAT DATE THEY EXISTED AS INDICATED HEREON"

[Signature]
 JAMES A. ZIEMBA, PROFESSIONAL SURVEYOR #7094

LEROY TOWNSHIP
 Zoning Inspector
 11/20/02

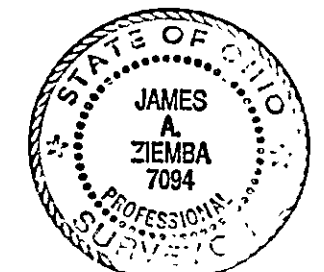

BENCHMARK SURVEY COMPANY
 5964 SOUTH RIDGE ROAD
 MADISON, OHIO 44057-9741
 NOVEMBER 18, 2002

