


**LOW YIELD WATER
FIXTURES REQUIRED
ON ALL:**

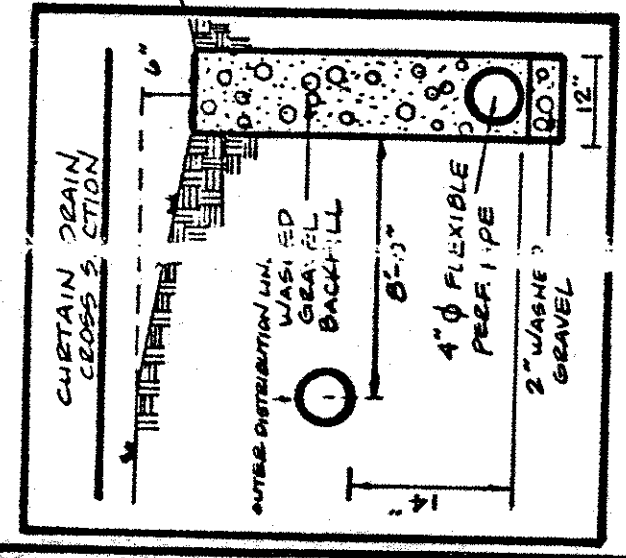

Reviewed and Accepted _____
LAKE COUNTY GENERAL HEALTH DISTRICT
Date 10-25-95 Lt. St. John
JOEL LUCIA, R. S. M. P. H.
Health Commissioner
BY J. Lucia