


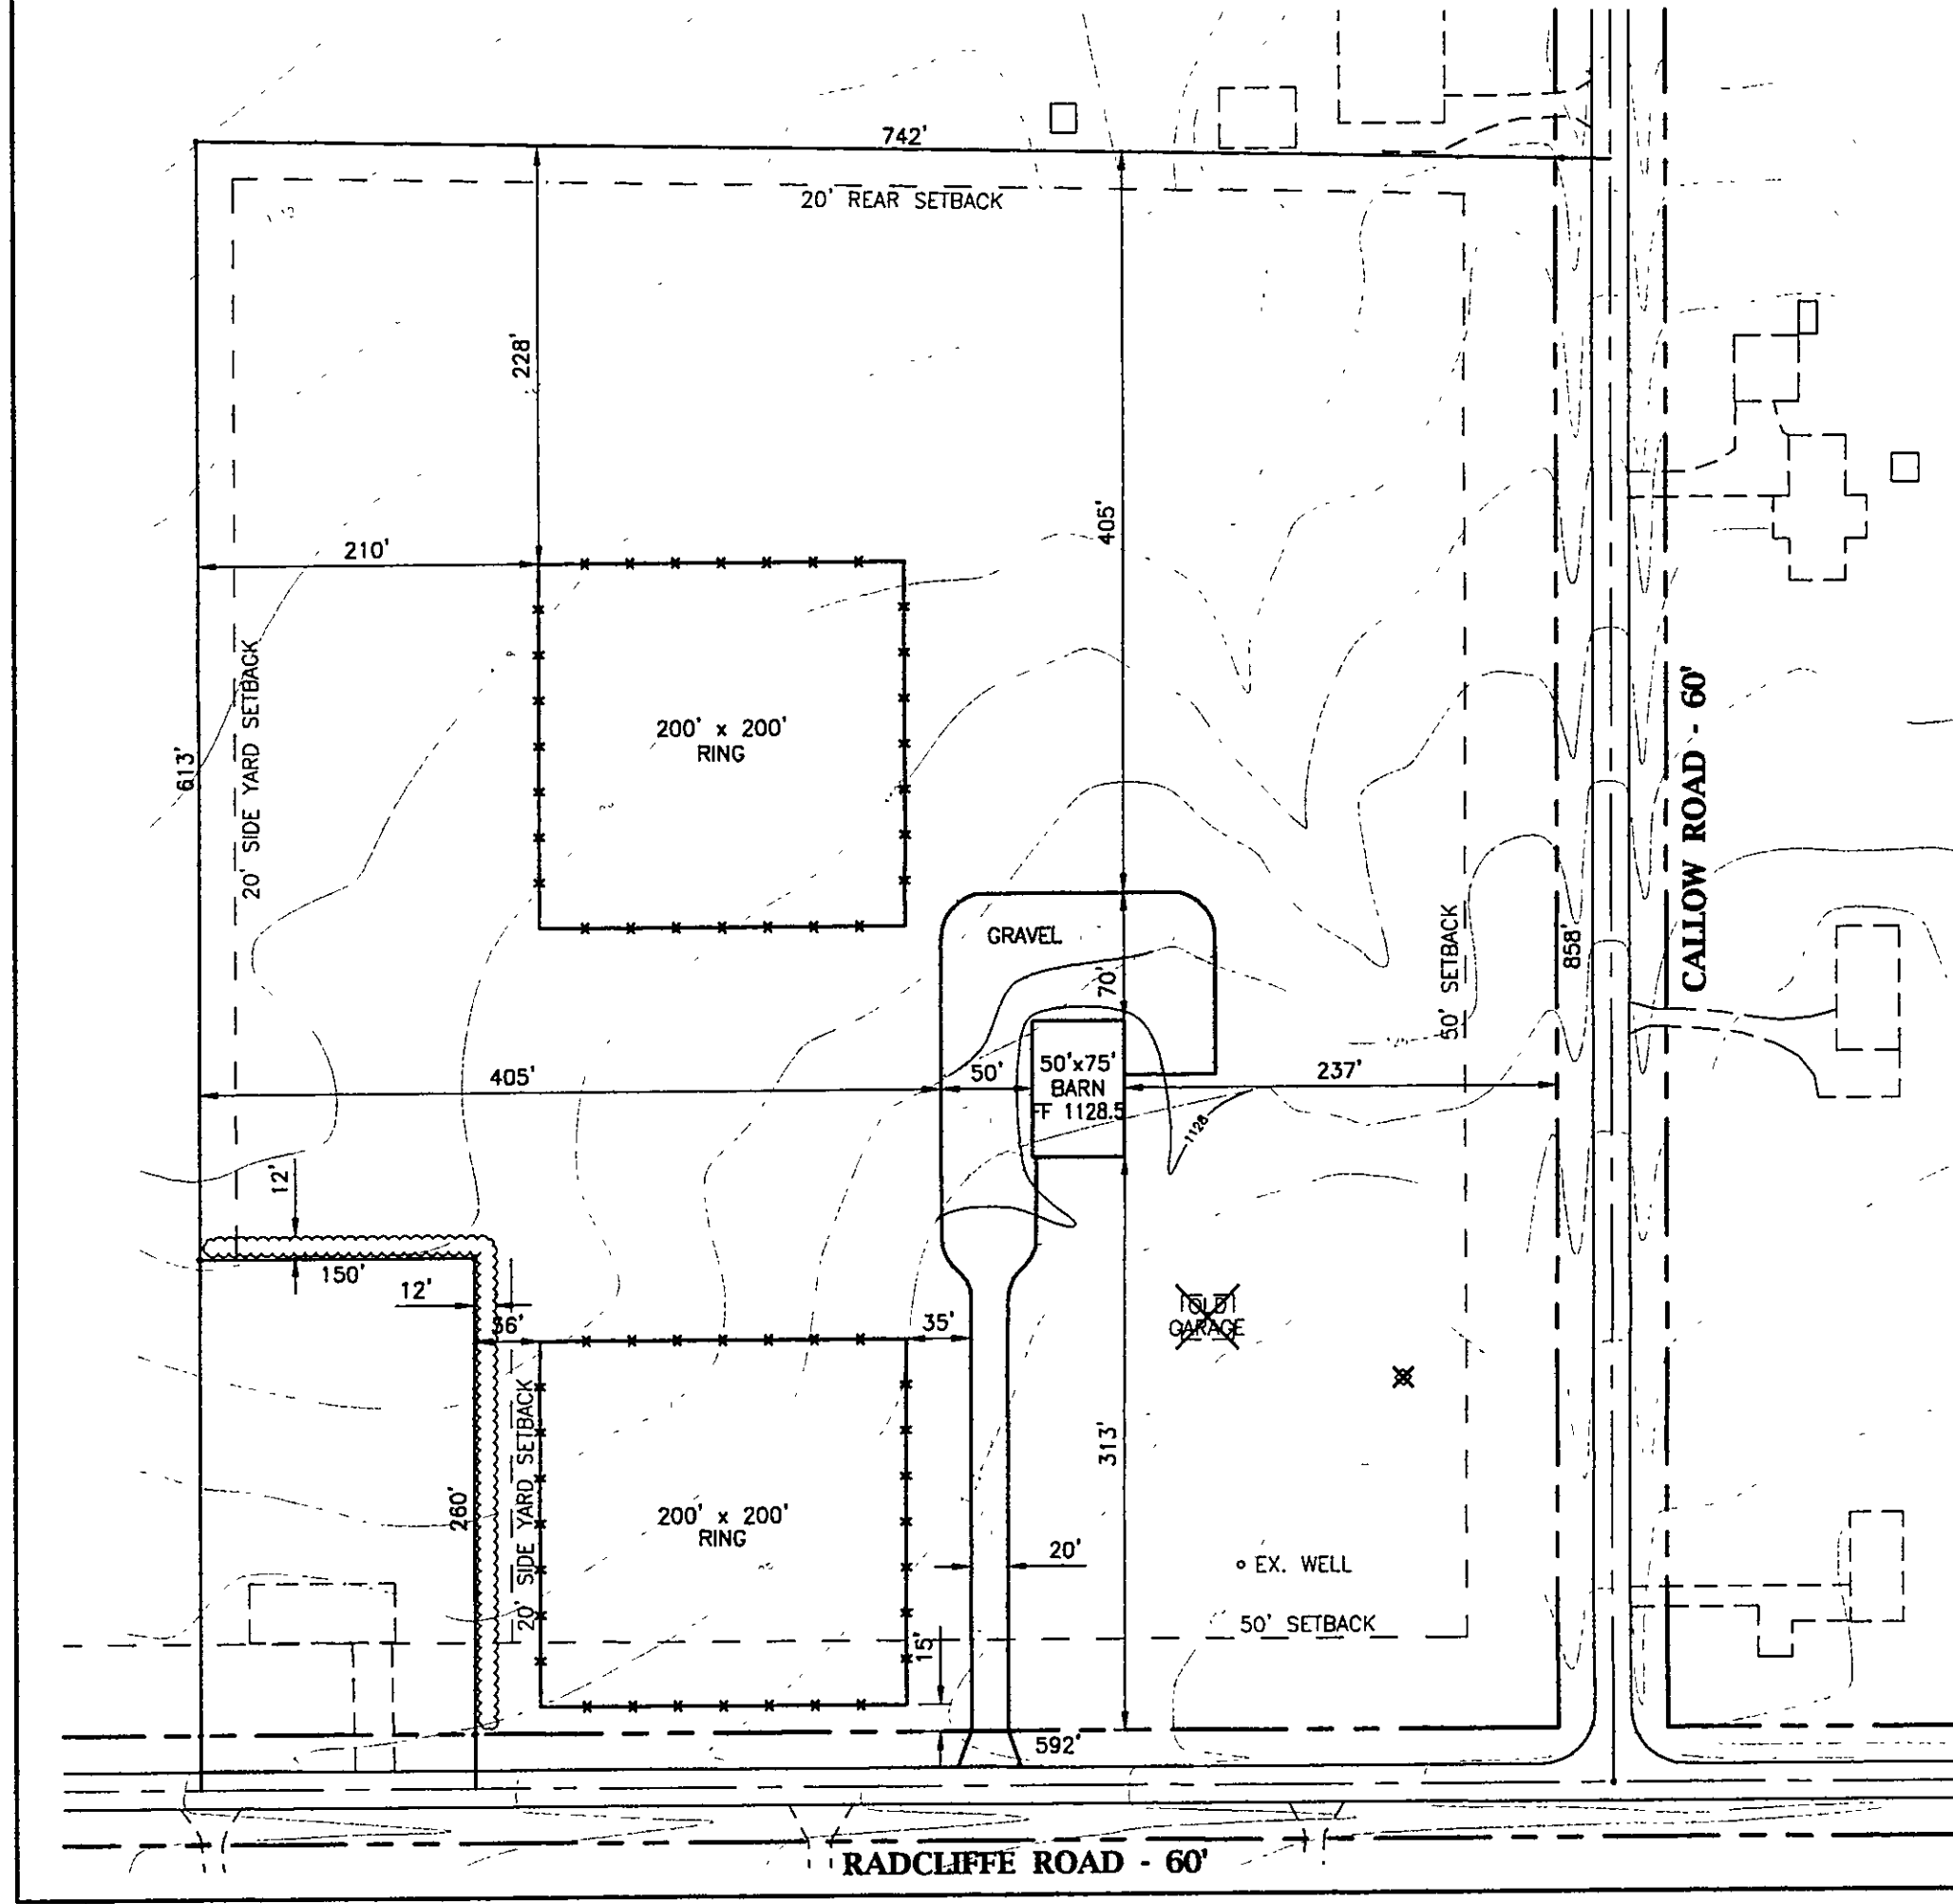

CONSTRUCTION OF A BARN
FOR AGRICULTURAL PURPOSES

PERMANENT PARCEL NO:
07A003E000120


ZONING:
R-1

LOT SIZE:
14.8692 ACRES

Grading Plan Approved
as shown and/or noted
JAMES R. GILLS, P.E.
Lake County Engineer

By ELH D. 08/20/08

This project is exempt from
ESC Plan Review
Date 8-19-08
Lake SWCD lets

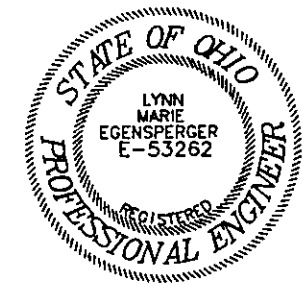

L.M. Egensperger 8/18/08
LYNN M. EGENSPERGER P.E. E-53262 DATE

 SCALE 1"=100' DATE BY CHECKED APPROVED	<u>egens</u> Lynn Marie Egensperger, P.E. 13098 Radcliffe Road Leroy Township - Lake County - Ohio	DAVID AND AMY JENNINGS 13098 RADCLIFFE ROAD LEROY TOWNSHIP - LAKE COUNTY - OHIO
		SITE PLAN
		1 1