


"I, the undersigned, certify that this map, plan, or report, with its contours, represents an actual survey made by me on the 20th day of April, 1998, and that the elevations were taken at appropriate intervals and that as of that date they existed as indicated hereon."



Name Harry S. Jones Reg. No. 6343

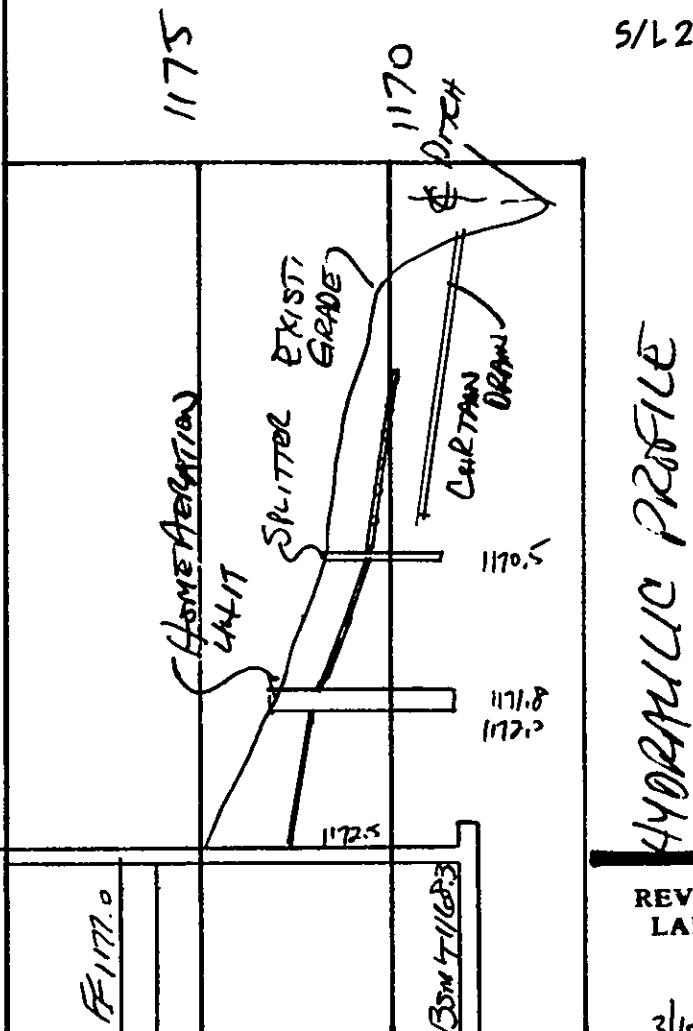

REVIEWED AND ACCEPTED  
LAKE COUNTY GENERAL  
HEALTH DISTRICT

Date 3/18/98 BY Daniel D. [Signature]

EX. HOUSE  
SEWAGE DISPOSAL PERMIT MUST  
OBTAINED BY A LAKE COUNTY  
INSTALLER BEFORE INSTALLATION  
IS  
STARTED

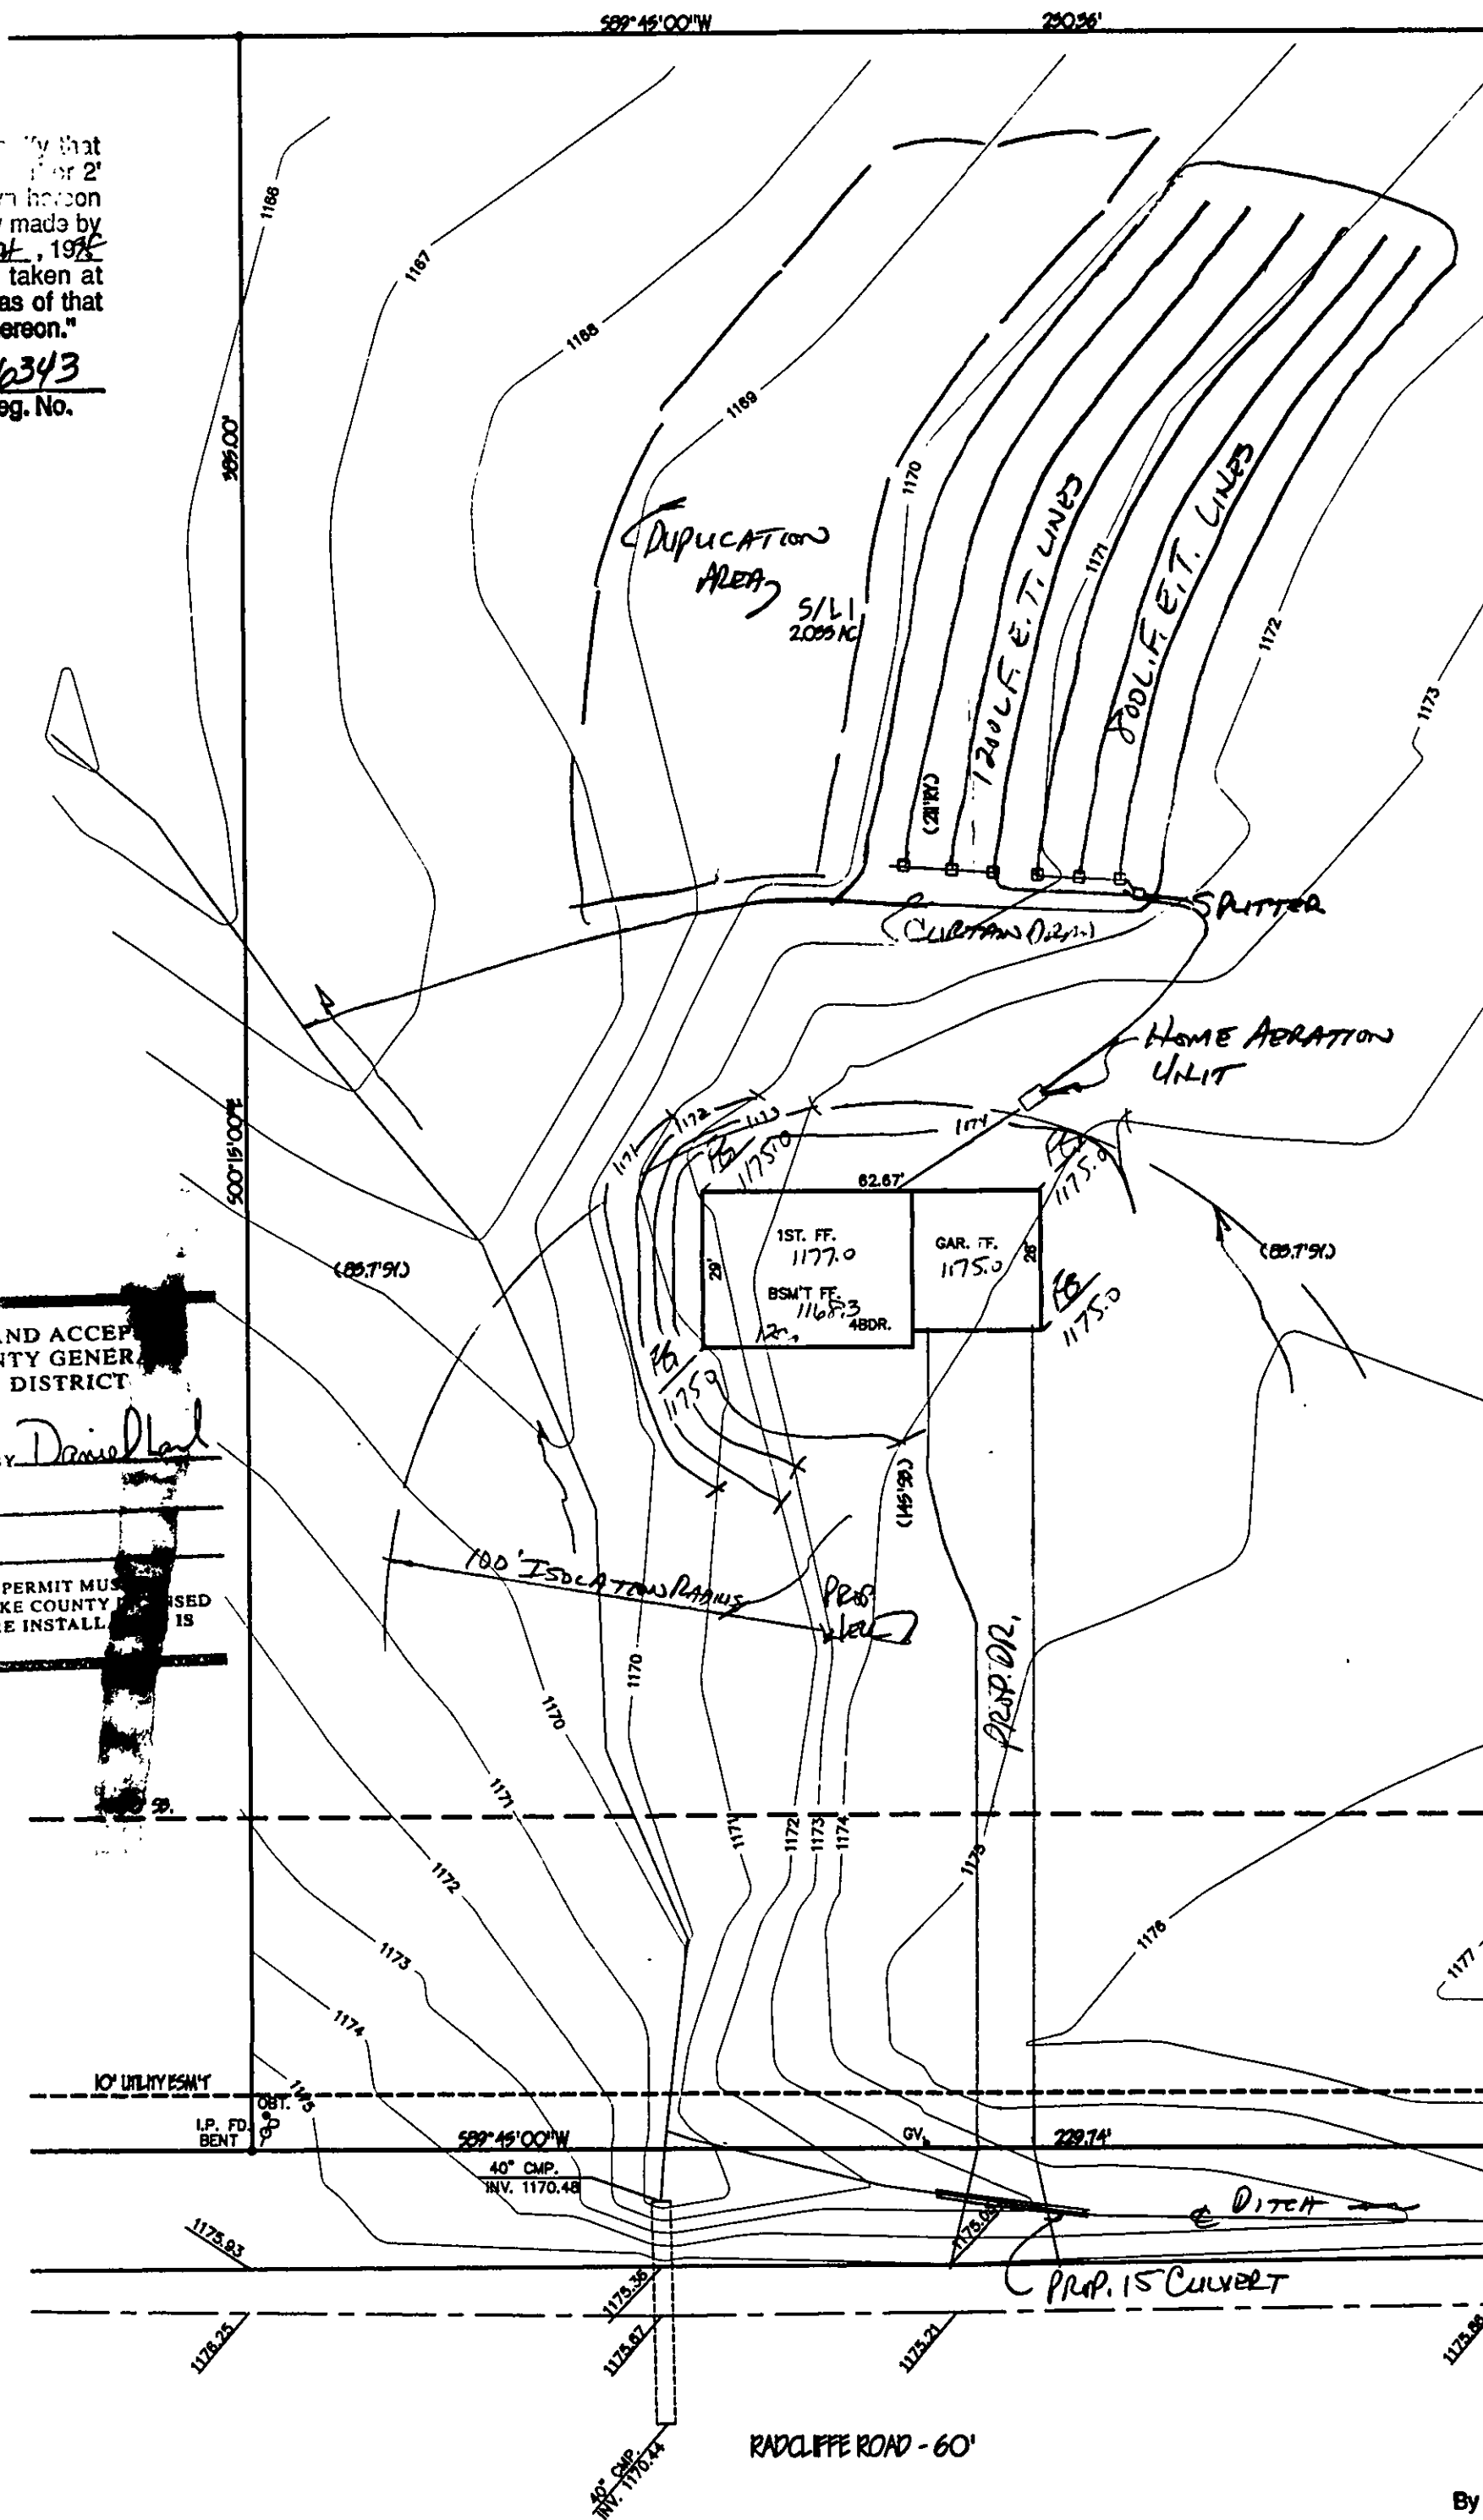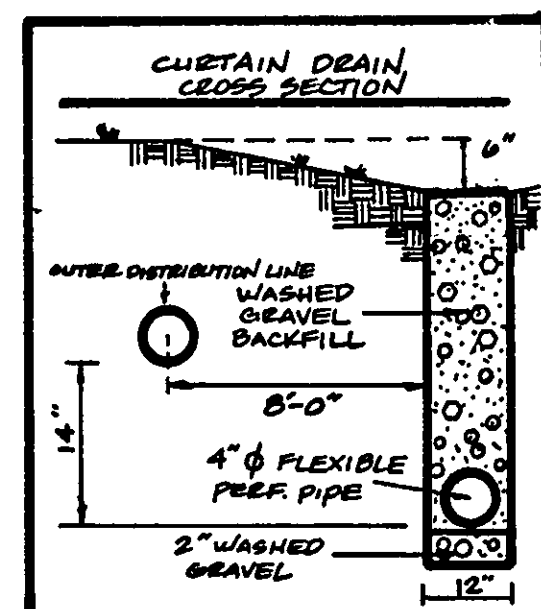

# SITE PLAN

LERROY TOWNSHIP, LAKE COUNTY, OHIO


for: MARK KONTE

ADDRESS STREET CITY ZIP

HIGHLAND TRAILS  
SUBDIVISION NAME LOT TRACT  
VOL-Pg. RADCLIFFE RD VOLUME PAGE  
SUBLOT NO. STREET PERM. PARCEL NO. STREET

LEGEND  
SANITARY MANHOLE  
STORM MANHOLE  
INLET OR CATCH BASIN  
HYDRANT  
EXISTING CONTOURS  
PROPOSED CONTOURS  
EXIST. ELEV. 100.0  
100.0 22 PROP. ELEV.  
AS BUILT ELEVATION  
INDICATES DIRECTION OF SURFACE DRAINAGE

REMARKS  
ALL BOUNDARY DATA SHOWN WAS OBTAINED FROM (DEEDS, RECORDED SUBDIVISION PLAT OR OTHER PUBLIC RECORDS)  
LOCATIONS AS SHOWN OF ADJACENT WELLS AND SEPTIC TANKS OBTAINED FROM LAKE COUNTY HEALTH DEPARTMENT

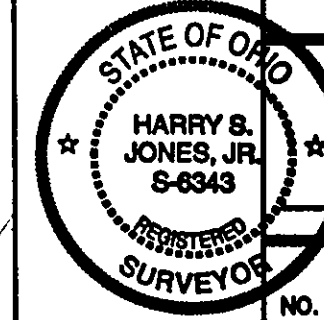

DESIGN CERTIFICATION  
THIS PLAT WAS PREPARED BY ME, AND IS CORRECT TO THE BEST OF MY KNOWLEDGE AND BELIEF.

NAME Harry S. Jones SURVEYOR REGISTRATION NO. 6343


CHECK LIST  
NO. OF BEDROOMS  
DIMENSIONS  
BEARINGS  
TIE TO NEAREST STREET  
SUBLOT NO. PARCEL NO.  
SURROUNDING OWNERS  
BLDG. DIMENSIONS FIN GR.  
BLDG. TIES FL'R. GRADES  
APRON TYPE WIDTH THICKNESS  
SIDEWALK TYPE WIDTH THICKNESS  
CULVERT TYPE DIA., LENGTH  
ROCK OUTCROPPINGS  
WATER MAIN SIZE, LOCATION  
SAN. SEWER SIZE & GR. LOC.  
SAN. MH. CAST. ELEV. INV. ELEV.  
SAN. CONN. SIZE, LOC. DEPTH  
STORM SEWER SIZE & GR. LOC.  
STORM MH. CAST ELEV. INV. ELEV.  
PAV'T TYPE GRADE CURBS  
GAS LINE LOC. SIZE PRESSURE  
SEPTIC TANK LOCATION & DUPLICATION AREA  
WELL LOCATION  
ISOLATION RADIUS FROM WELL

REVISIONS			PLAN PREPARED BY:		
NO.	DATE	BY	BABCOCK JONES & ASSOCIATES, INC.		
1	3/16/98	HT	PAINESVILLE, OHIO		
2					
3			DRAWN BY	T.R.	SCALE 1"=30'
4			CHK'D.	H.J.	DATE 3/3/98
5			CREW CHIEF	W.B.	APP'D H.J.
			PHONE NO. 216-357-1811		
			DRAWING NO. 98-047		

"AS BUILT" CERTIFICATION  
I, HEREBY CERTIFY THAT THE CIRCLED GRADES ARE EXISTING FINISH GRADES CHECKED IN THE FIELD ON \_\_\_\_\_, 19\_\_\_\_, AND ARE CORRECT TO THE BEST OF MY KNOWLEDGE AND BELIEF.

REGISTERED SURVEYOR REG. NO.

TBM-TOP IRON PIN  
ELEV. =1175.58

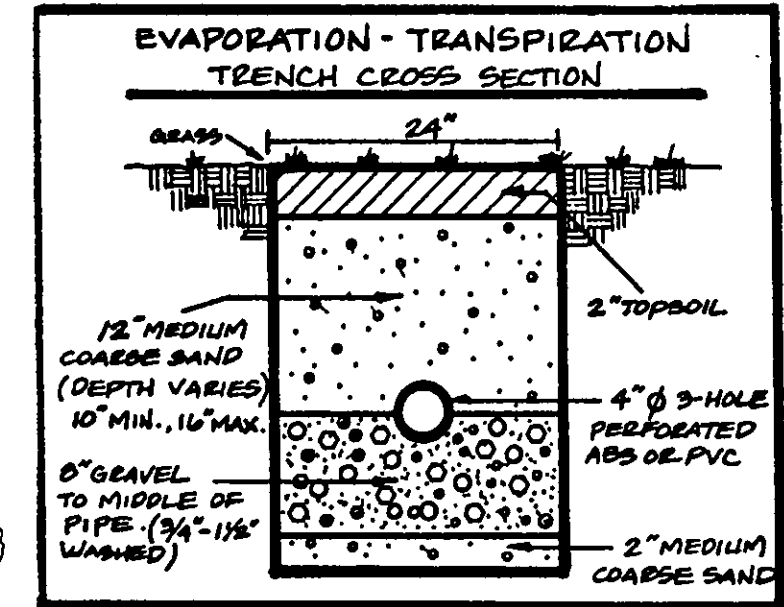

Grading Plan Approved as shown and/or noted  
THOMAS P. GILLES, P.E.  
Lake County Engineer

By HT Date 3-20-98