
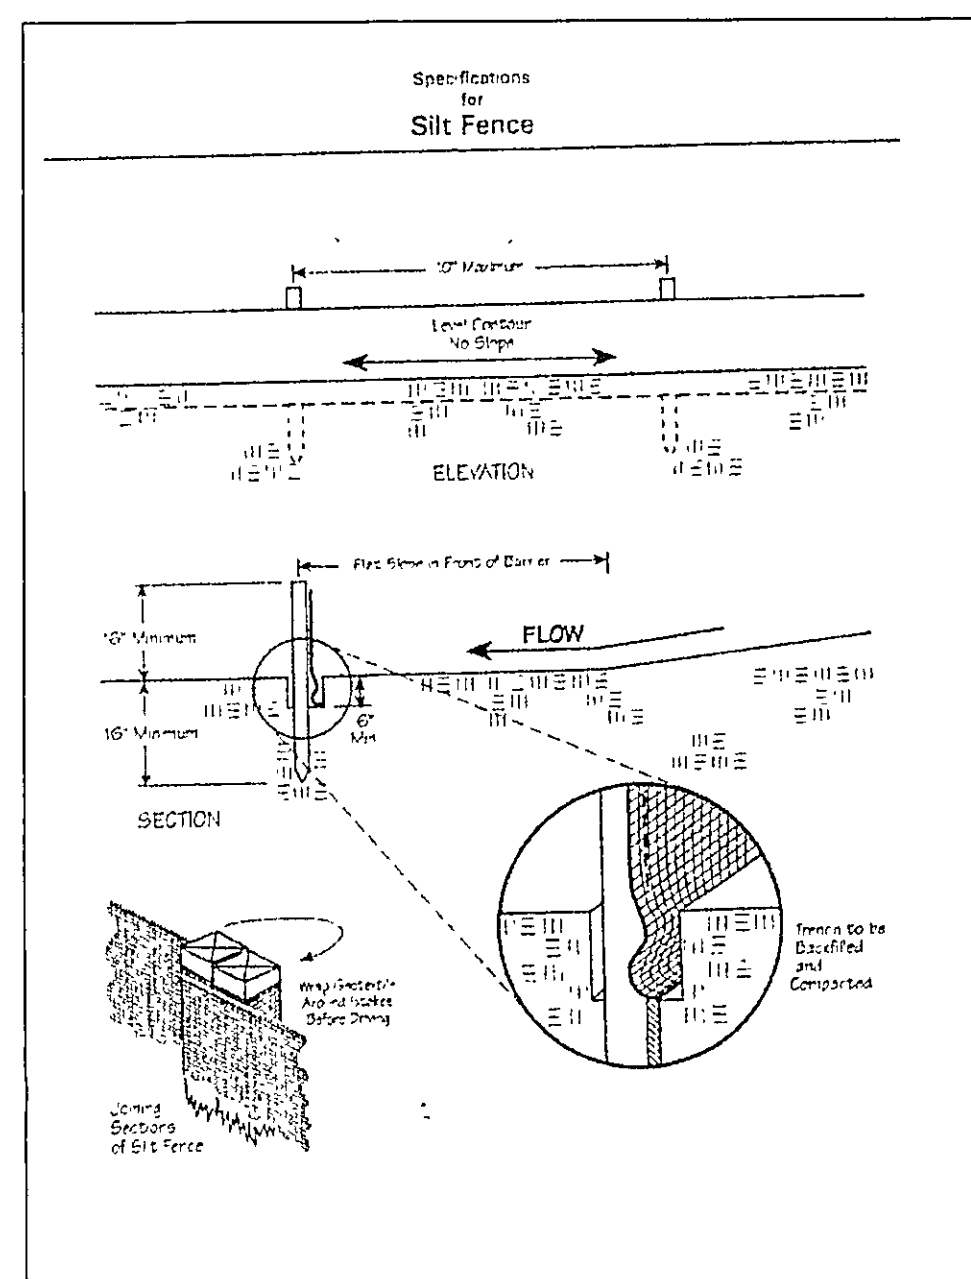


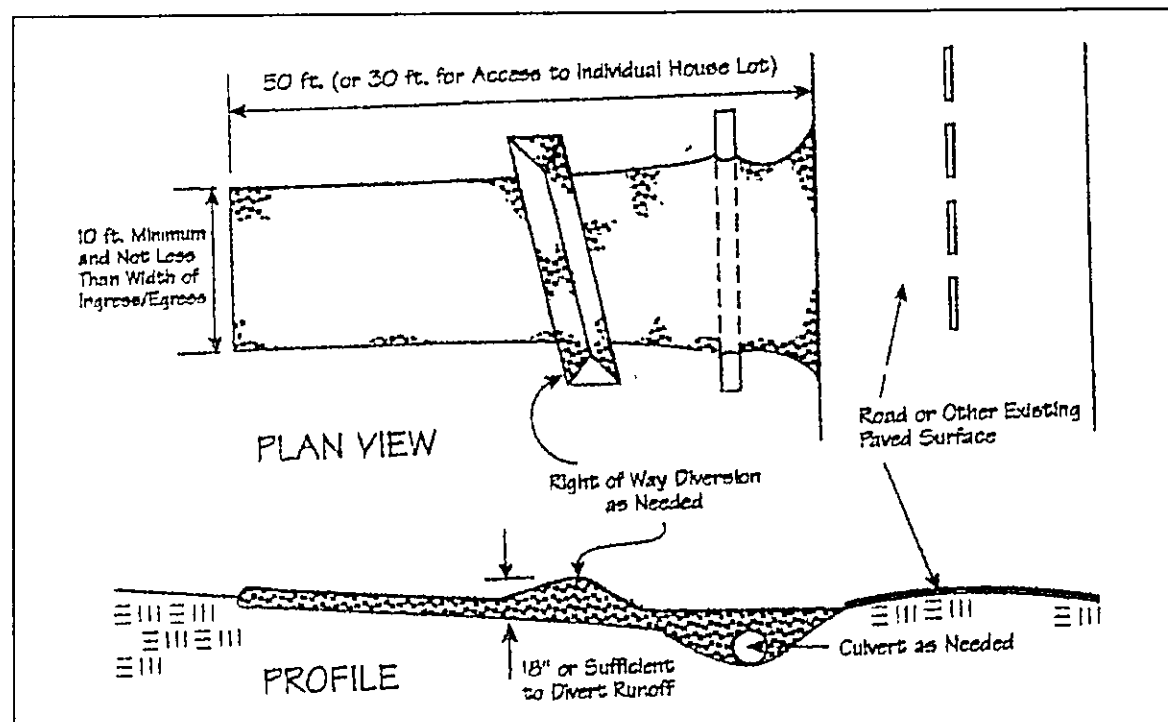





| Temporary Seeding Species Selection |                    |                            |          |
|-------------------------------------|--------------------|----------------------------|----------|
| Seeding Dates                       | Species            | Lb./1,000 ft. <sup>2</sup> | Per Ac.  |
| March 1 to August 15                | Oats               | 3                          | 4 bushel |
|                                     | Tall Fescue        | 1                          | 40 lb.   |
|                                     | Annual Ryegrass    | 1                          | 40 lb.   |
|                                     | Perennial Ryegrass | 1                          | 40 lb.   |
|                                     | Tall Fescue        | 1                          | 40 lb.   |
| August 16 to November 1             | Rye                | 3                          | 2 bushel |
|                                     | Tall Fescue        | 1                          | 40 lb.   |
|                                     | Annual Ryegrass    | 1                          | 40 lb.   |
|                                     | Perennial Ryegrass | 1                          | 40 lb.   |
|                                     | Tall Fescue        | 1                          | 40 lb.   |
| November 1 to Spring Seeding        | Wheat              | 3                          | 2 bushel |
|                                     | Tall Fescue        | 1                          | 40 lb.   |
|                                     | Annual Ryegrass    | 1                          | 40 lb.   |
|                                     | Perennial Ryegrass | 1                          | 40 lb.   |
|                                     | Tall Fescue        | 1                          | 40 lb.   |

Note: Other approved seed species may be substituted.

REVIEWED AND ACCEPTED  
LAKE COUNTY GENERAL  
HEALTH DISTRICT

Date: 4-15-04  
JAMES R. GILLS, P.E.

FOR USE DISPOSEL PERMIT MUST BE  
OBTAINED BY A LAKE COUNTY LICENSED  
INSTALLER BEFORE INSTALLATION IS  
SETTLED.

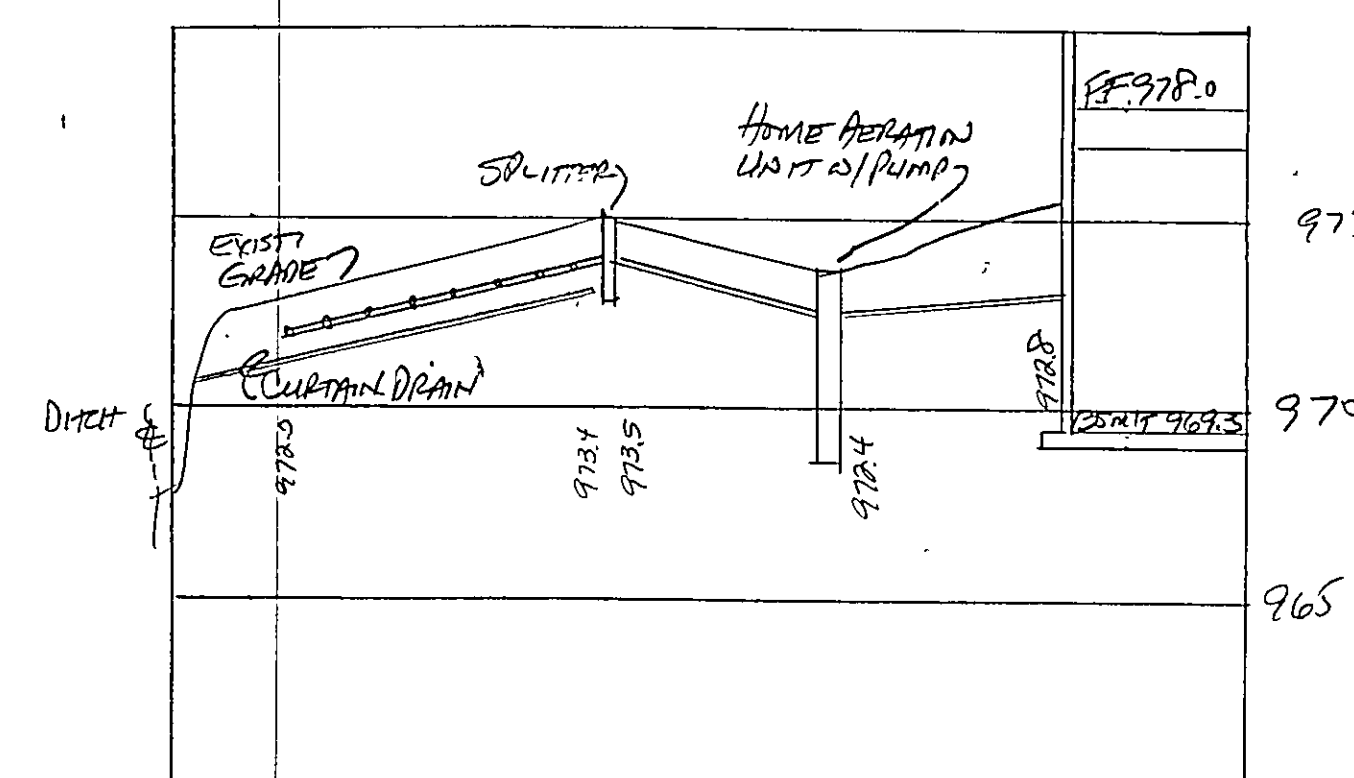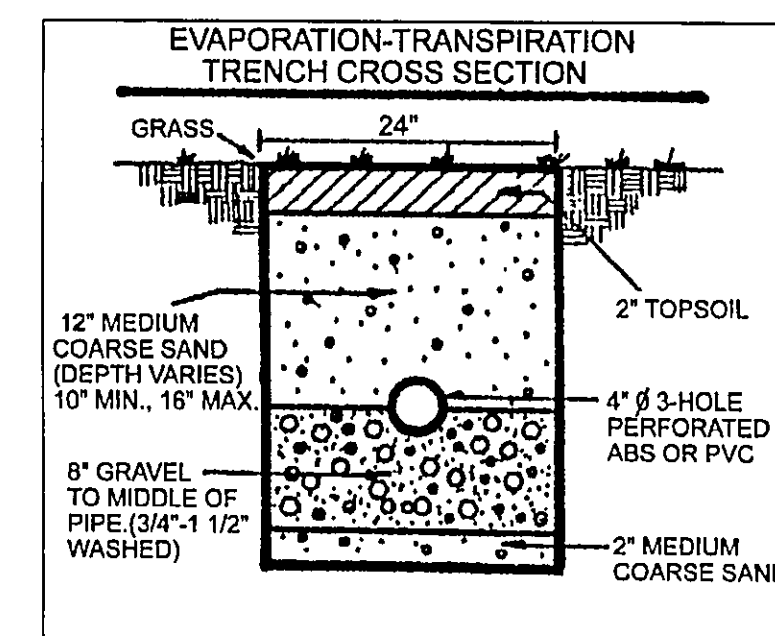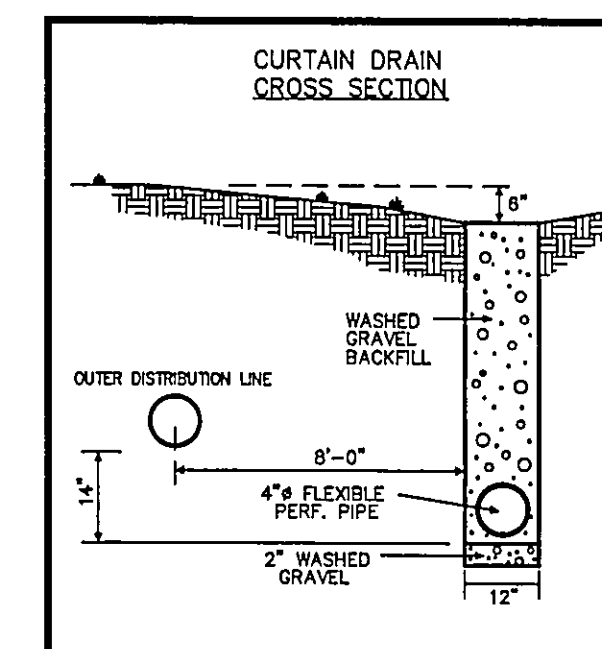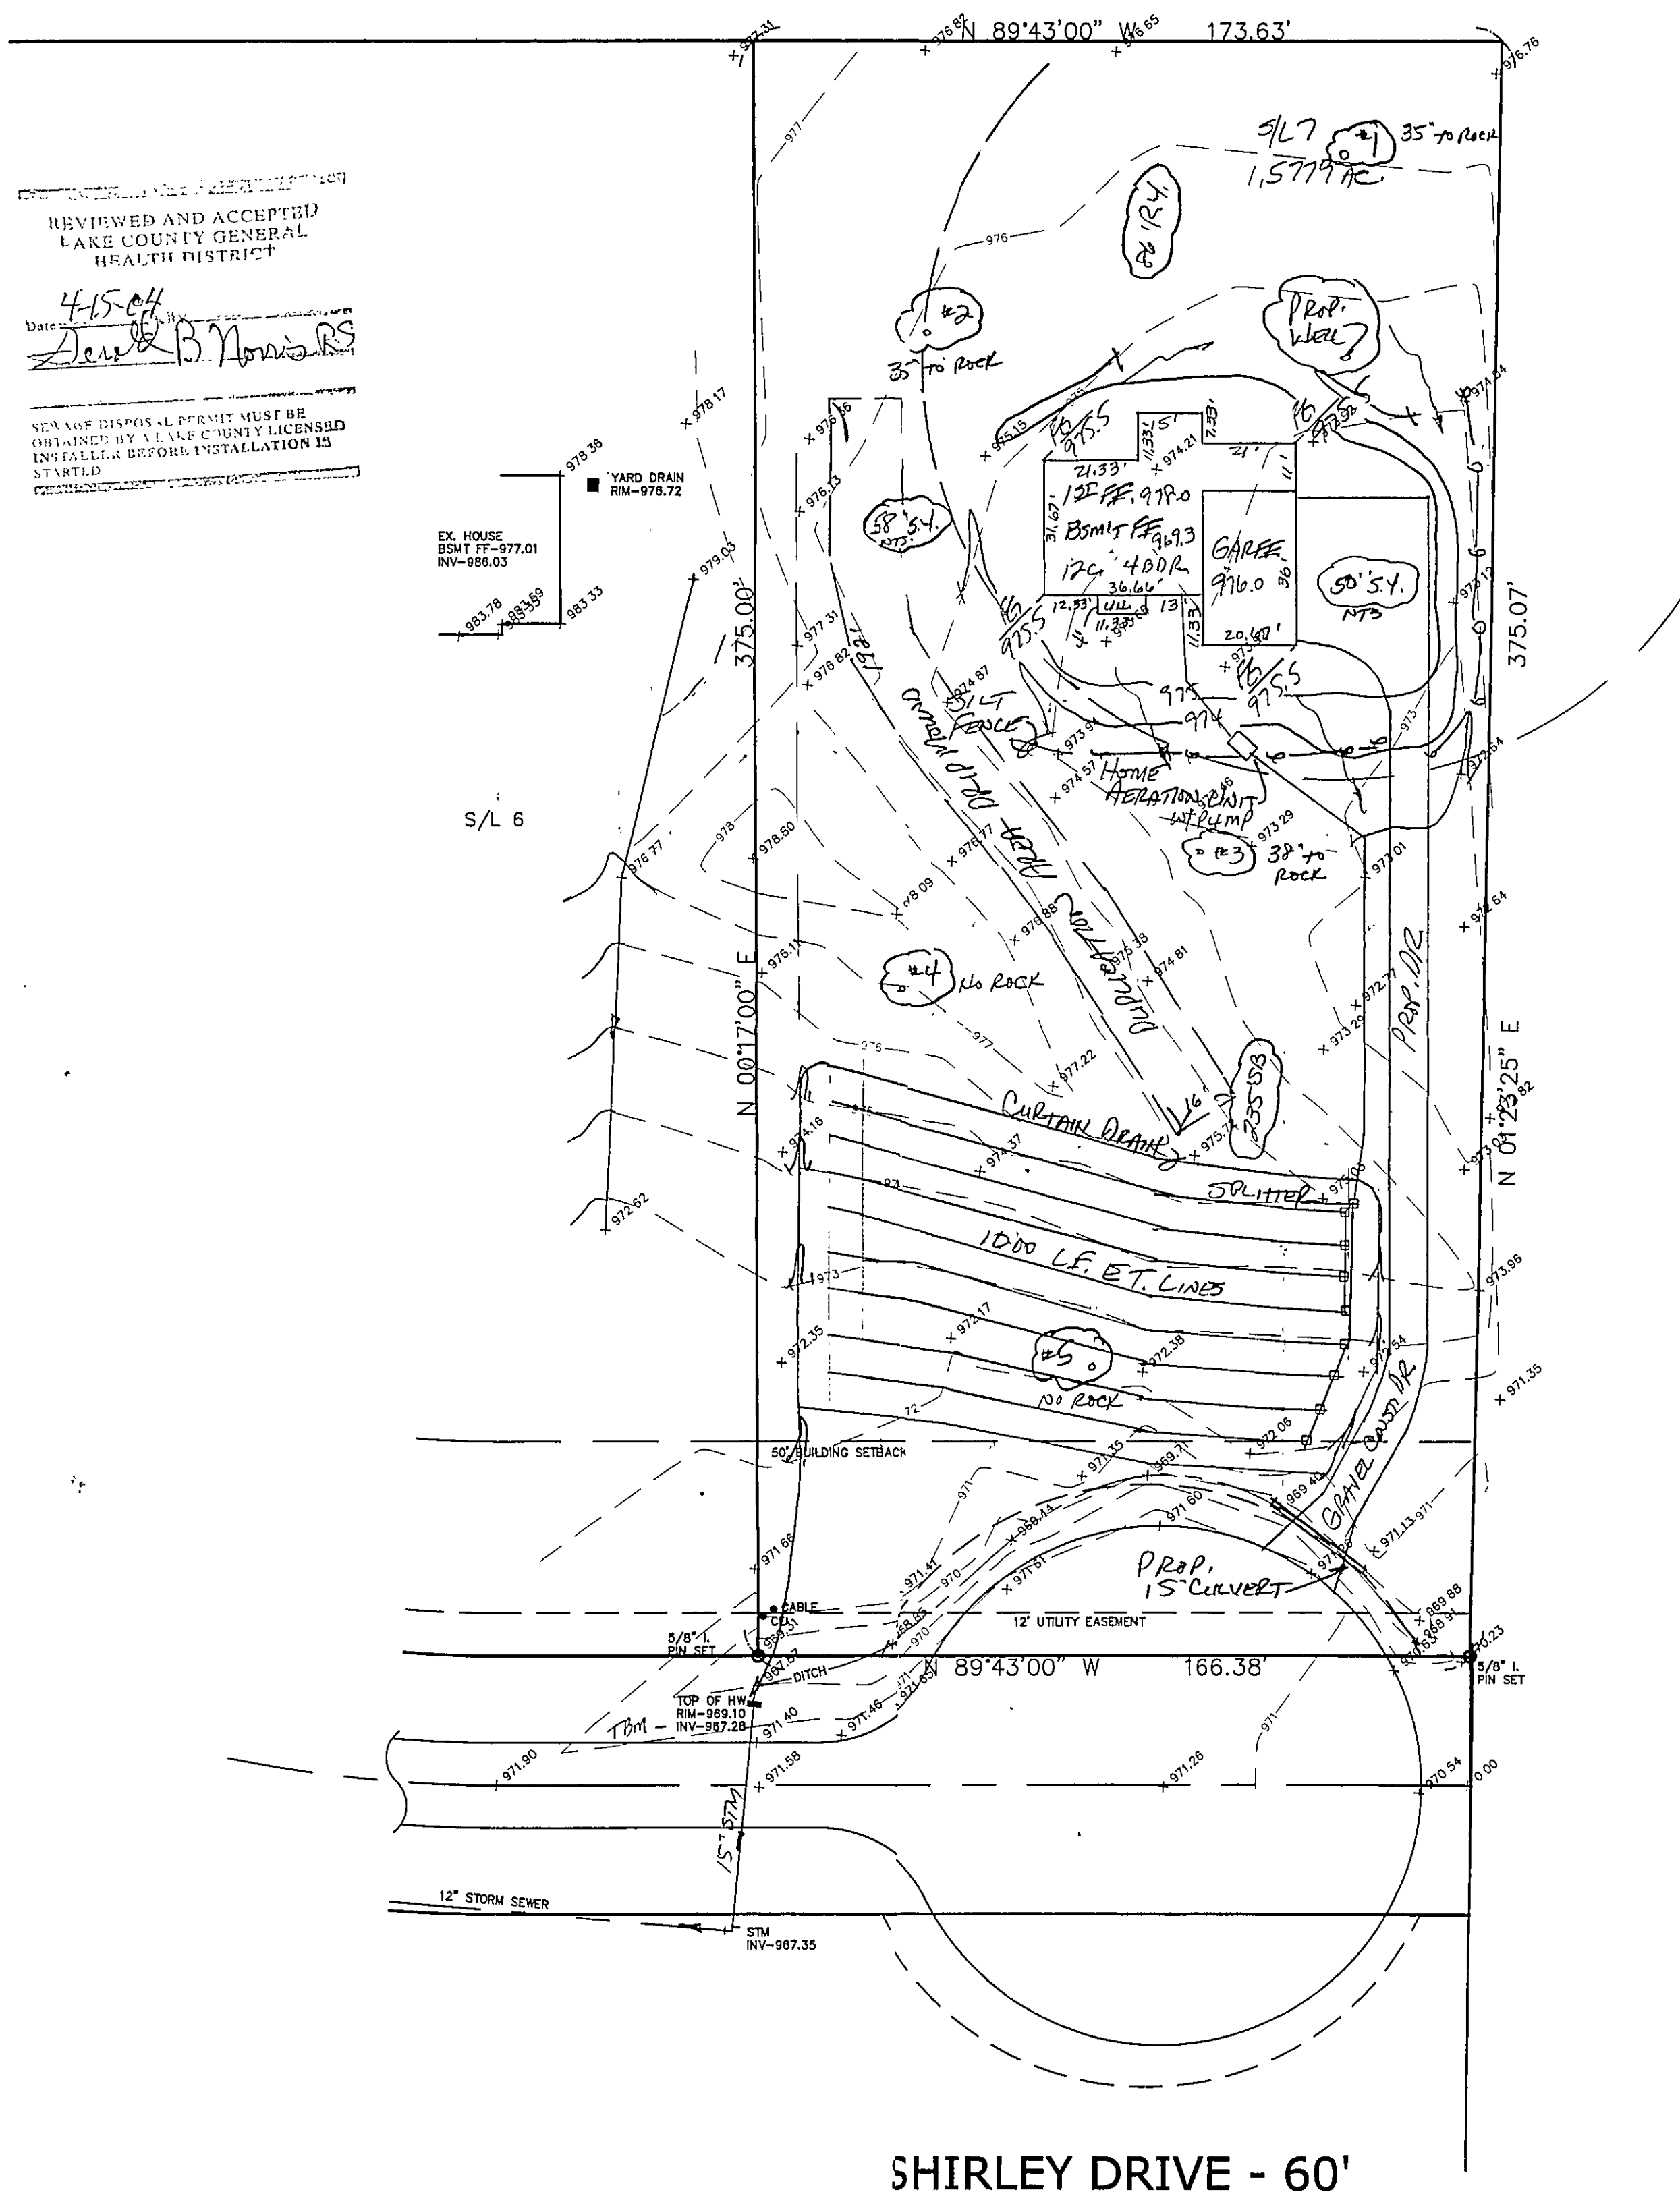

HYDRAULIC PROFILE  
HORIZ: 1" = 30' VERT: 1" = 5'

$$\frac{417}{2.4} = 174' \text{ mound}$$

$$174' + 9' + 9' = 192' \text{ LONG}$$

$$16' \text{ WIDE}$$


Stormwater Management Plan  
Approved as shown and/or noted  
JAMES R. GILLS, P.E.  
County Drainage Engineer  
By: [Signature] Date: 4/19/04

TBM 104.15 STORM  
ELEV. 967.28

"I, the undersigned hereby certify that this topography indicated by 6", 1" or 2" contours, and elevations shown hereon represent an actual field survey made by me on the 23rd day of March 2004 and that the elevations were taken at appropriate intervals and that as of that date they existed as indicated hereon."

James R. Gills, P.E.  
Name: [Signature] Reg. No. 6343

EXISTING UTILITIES NOTE:  
THE SIZE AND LOCATION OF THE UNDERGROUND UTILITIES SHOWN HEREON, HAVE BEEN OBTAINED BY A SEARCH OF AVAILABLE RECORDS. VERIFICATION BY FIELD OBSERVATION HAS BEEN CONDUCTED WHERE PRACTICAL, HOWEVER, BABCOCK, JONES AND ASSOCIATES, INC. DOES NOT GUARANTEE THE COMPLETENESS NOR ACCURACY THEREOF.

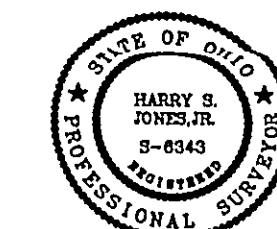

| REV. NO. | DESCRIPTION    | DATE    | BY | CHK'D |
|----------|----------------|---------|----|-------|
| 1        | REVISED S.V.'S | 3/16/04 | HJ | HJ    |
| 2        | REVISED SEPTIC | 4/15/04 | HJ | HJ    |

**babcock, JONES AND ASSOCIATES, INC**  
CIVIL ENGINEERS - SURVEYORS - LAND PLANNERS  
PAINESVILLE OHIO 44077

|             |        |
|-------------|--------|
| DATE        | 3/5/04 |
| DESIGN BY   | HJ     |
| DRAWN BY    | NS     |
| APPROVED BY | HJ     |

**SITE PLAN**  
FOR  
**VAL HOMES**  
S/L 7 SHIRLEY DRIVE WHITETAIL SUBDIVISION  
LEROY TOWNSHIP LAKE COUNTY STATE OF OHIO

|         |          |
|---------|----------|
| SCALE   | 1"=30'   |
| JOB NO. | 99-230-7 |
| SHEET   | OF       |
| 1       | 1        |