

SITE PLAN

for : R.L. Moore Homes, Inc.
 CLIENT
7121 Ravenna Road Concord Ohio 44077
 ADDRESS CITY STATE ZIP

6 White Tail Run
 SUBLOT No. SUBDIVISION NAME VOL. PAGE
LOT TRACT Leroy Twp. Ohio
 CITY STATE

Foresight Engineering Group
 Engineers & Surveyors
 440 286-1010
 440 286-1034 fax
 320 Center Street, Unit F
 Chardon, Ohio 44024


DESIGN CERTIFICATION

This Site Plan was prepared by Foresight Engineering Group, Inc., and is correct to the best of my knowledge and belief.

Steven N. Roessner
 NAME

CHECK LIST

LOT DIMENSIONS & BEARINGS
 TIE TO NEAREST STREET
 SUBLOT No. (PARCEL No.)
 SURROUNDING OWNERS
 BUILDING DIMENSIONS
 SETBACK, SIDEYARD, REARYARD
 FINISH GRADES
 DRIVE & APRON TYPE, WIDTH, THICKNESS
 SIDEWALK TYPE, WIDTH, THICKNESS
 CULVERT TYPE, DIAM., LENGTH
 WATER MAIN SIZE, LOCATION
 S.W. SEWER SIZE, % GRADE, LOC.
 SAN. MH. CAST. ELEV., INV. ELEV.
 SAN. CONN. SIZE, % GRADE, LOC.
 STORM SEWER SIZE, % GRADE, LOC.
 STORM MH. CAST. ELEV., INV. ELEV.
 PAV'T TYPE, GRADE, CURBS
 GAS LINE LOC., SIZE
 SEPTIC SYSTEM & DUPLICATION
 WELL LOCATION & ISOLATION RADIUS

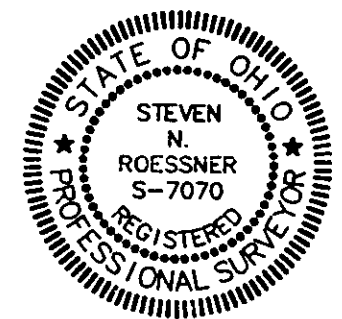

STATE SEAL

"AS BUILT" CERTIFICATION

I hereby certify that the circled information is existing as obtained on the site _____ 19____ and is correct to the best of my knowledge and belief.


NAME _____

SCALE : 1" = 30'	1
FILE NAME: I:\Rlm19915\field	2
DATE : Sept. 20, 1999	3


BENCHMARK: Ex. Catch Basin Rim Elev. = 969.83

"I, the undersigned hereby certify that this topography, indicated by 6", 1' or 2' contours, and the elevations shown hereon represent an actual field survey made by Foresight Engineering Group, Inc. on the 16 day of Aug 19 99 and that the elevations were taken at appropriate intervals and that as of that date they exist as indicated hereon."



Steven N. Roessner
 NAME
 Zoning Inspector

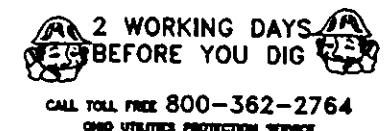

EXISTING UNDERGROUND UTILITIES NOTES:
 The location both horizontal and vertical of the underground utilities shown hereon, have been obtained by a diligent and comprehensive search of available records. Verification by field observation, has been conducted where practical. However, Foresight Engineering Group, Inc. does not guarantee the completeness nor accuracy thereof.

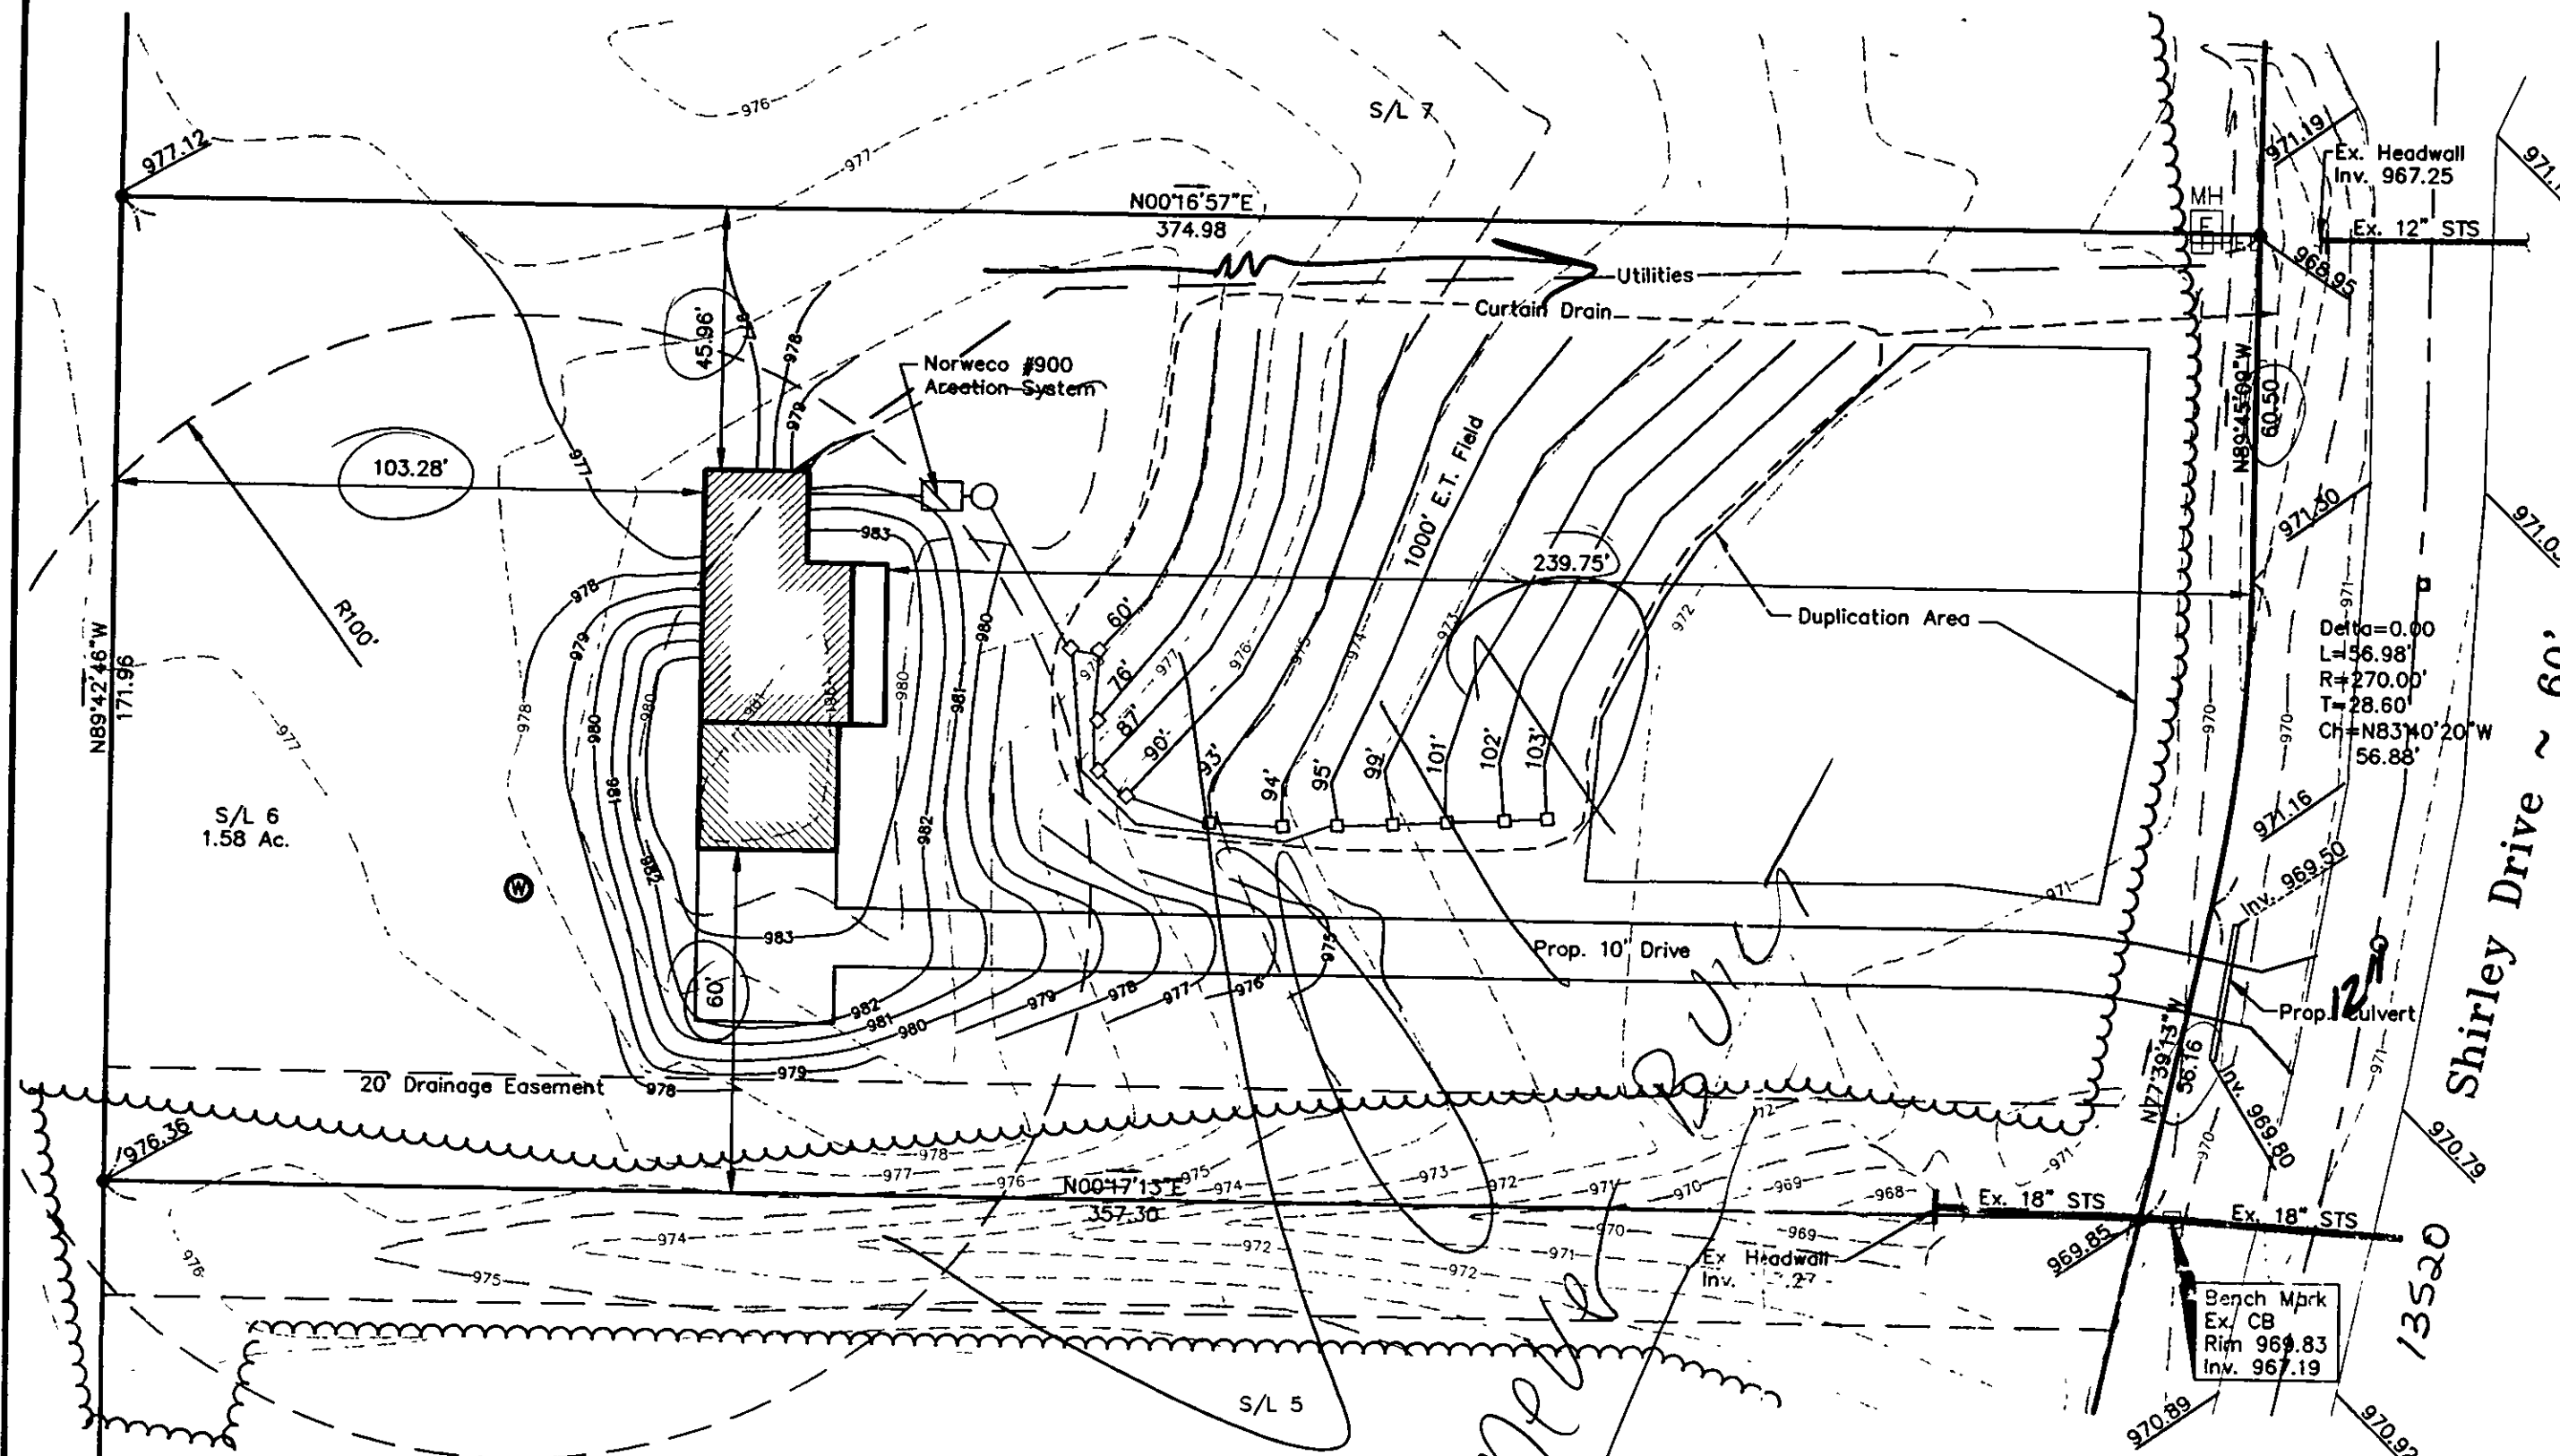


REVIEWED AND ACCEPTED
 LAKE COUNTY GENERAL
 HEALTH DISTRICT

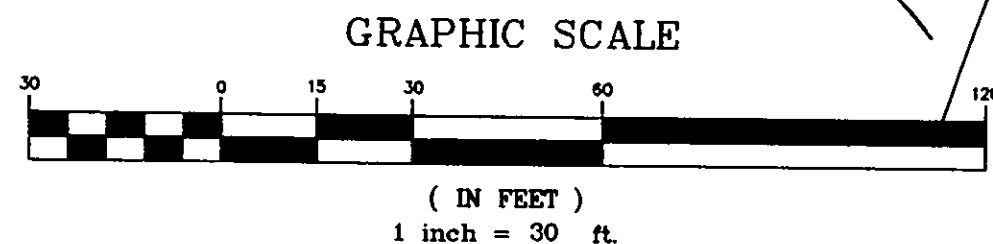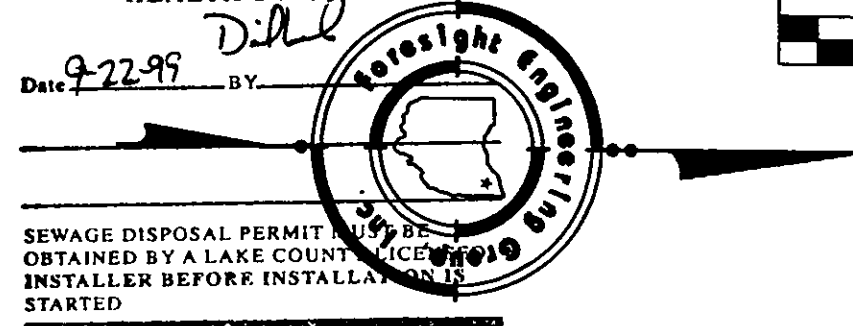


Grading Plan Approved
 as shown and/or noted
THOMAS P. MILLER, P.E.
 Lake County Engineer


TAM Date 9/27/99
 Scale as shown
 Lower F.G. to 982.00
 DRIVE CULVERT 12" min

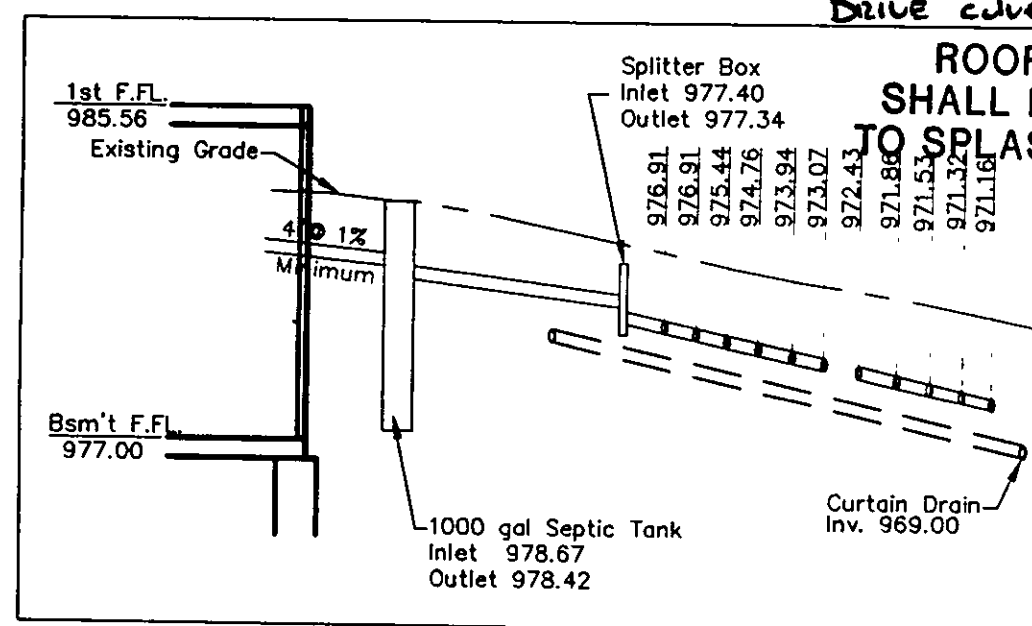

Hydraulic Profile

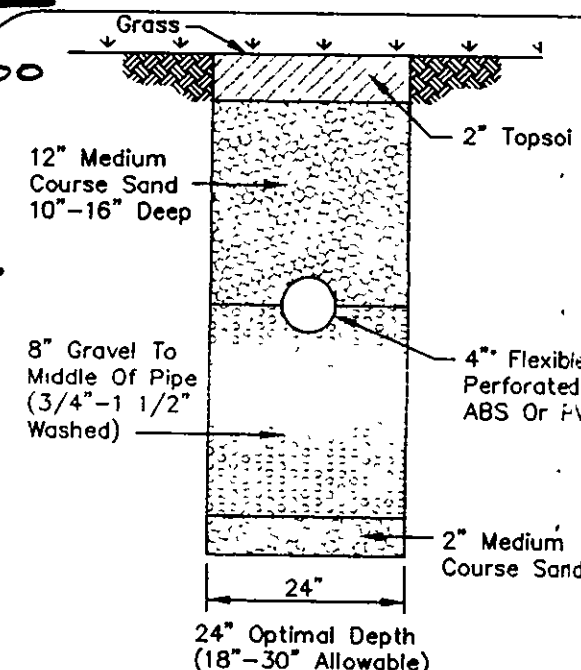

EVAPORATION-TRANSPIRATION
 TRENCH CROSS-SECTION
 NO SCALE

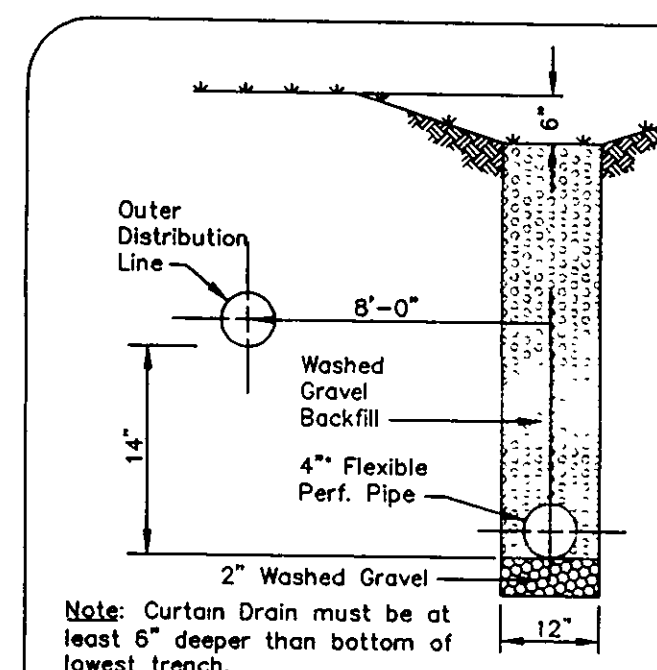

CURTAIN DRAIN CROSS SECTION
 NO SCALE

13520 Shirley Dr