


REVIEWED AND ACCEPTED
LAKE COUNTY GENERAL
HEALTH DISTRICT



2-18-00
Daryl B. Norris

SEWAGE DISPOSAL PERMIT MUST BE
OBTAINED BY A LAKE COUNTY LICENSED
INSTALLER BEFORE INSTALLATION IS
STARTED

LEROY TOWNSHIP
Zoning Approved
2665
Zoning Inspector

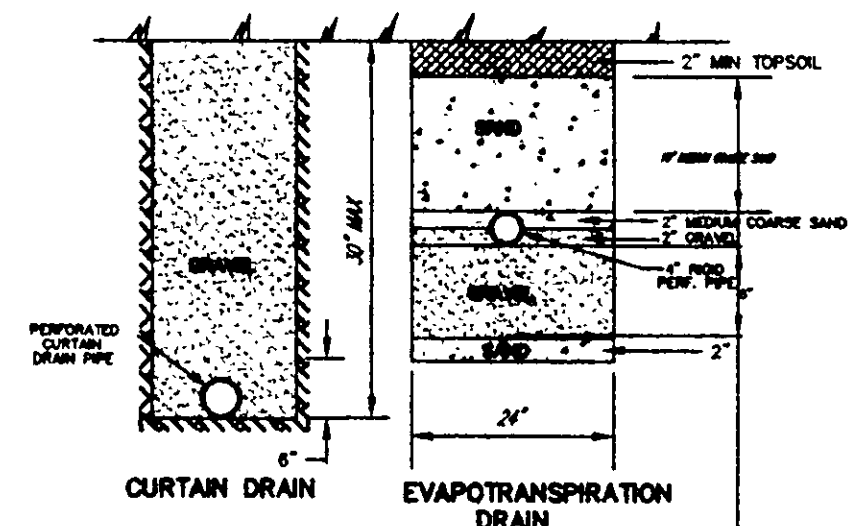

TRENCH DETAIL
NOT TO SCALE

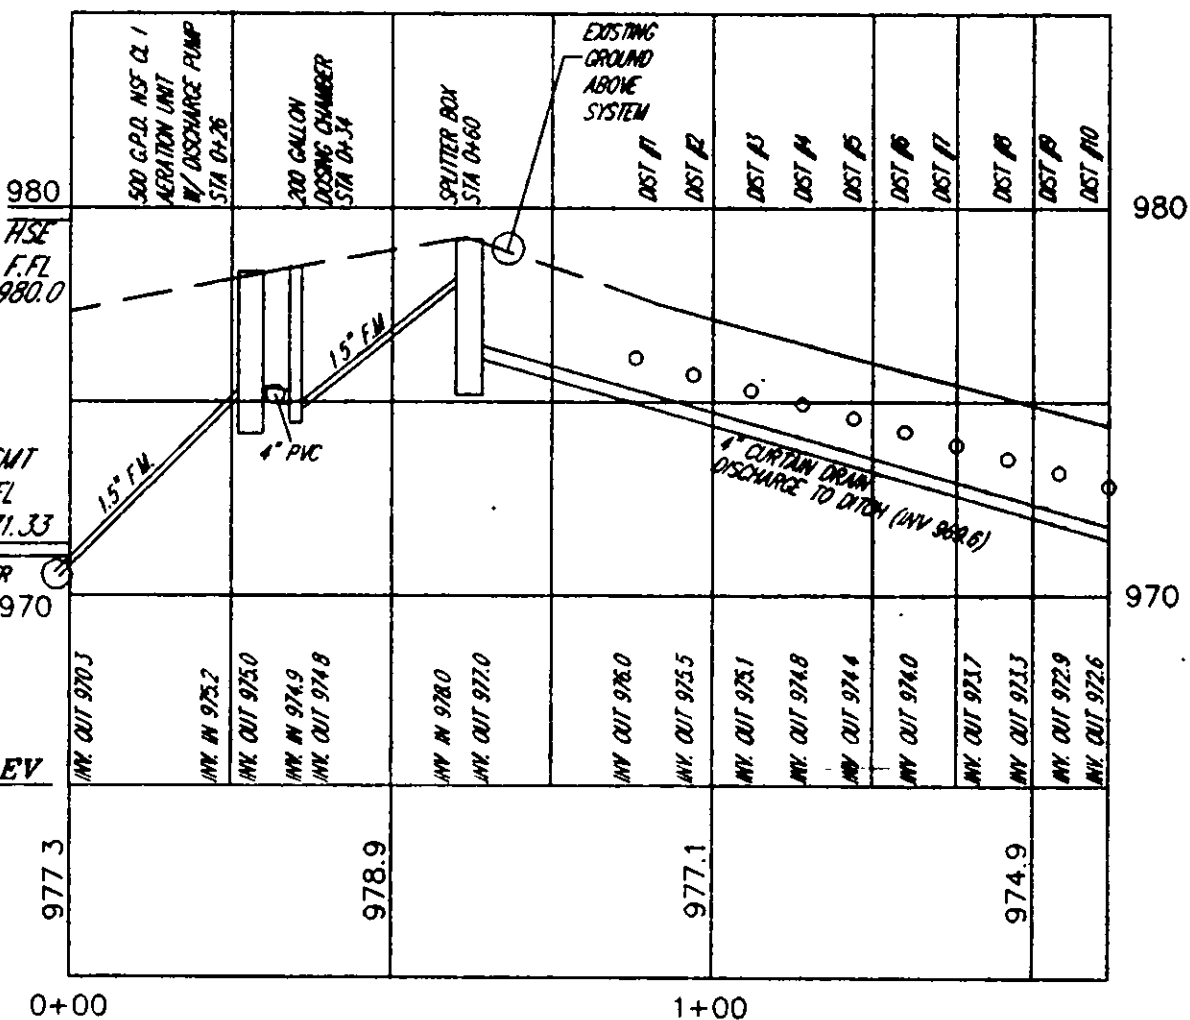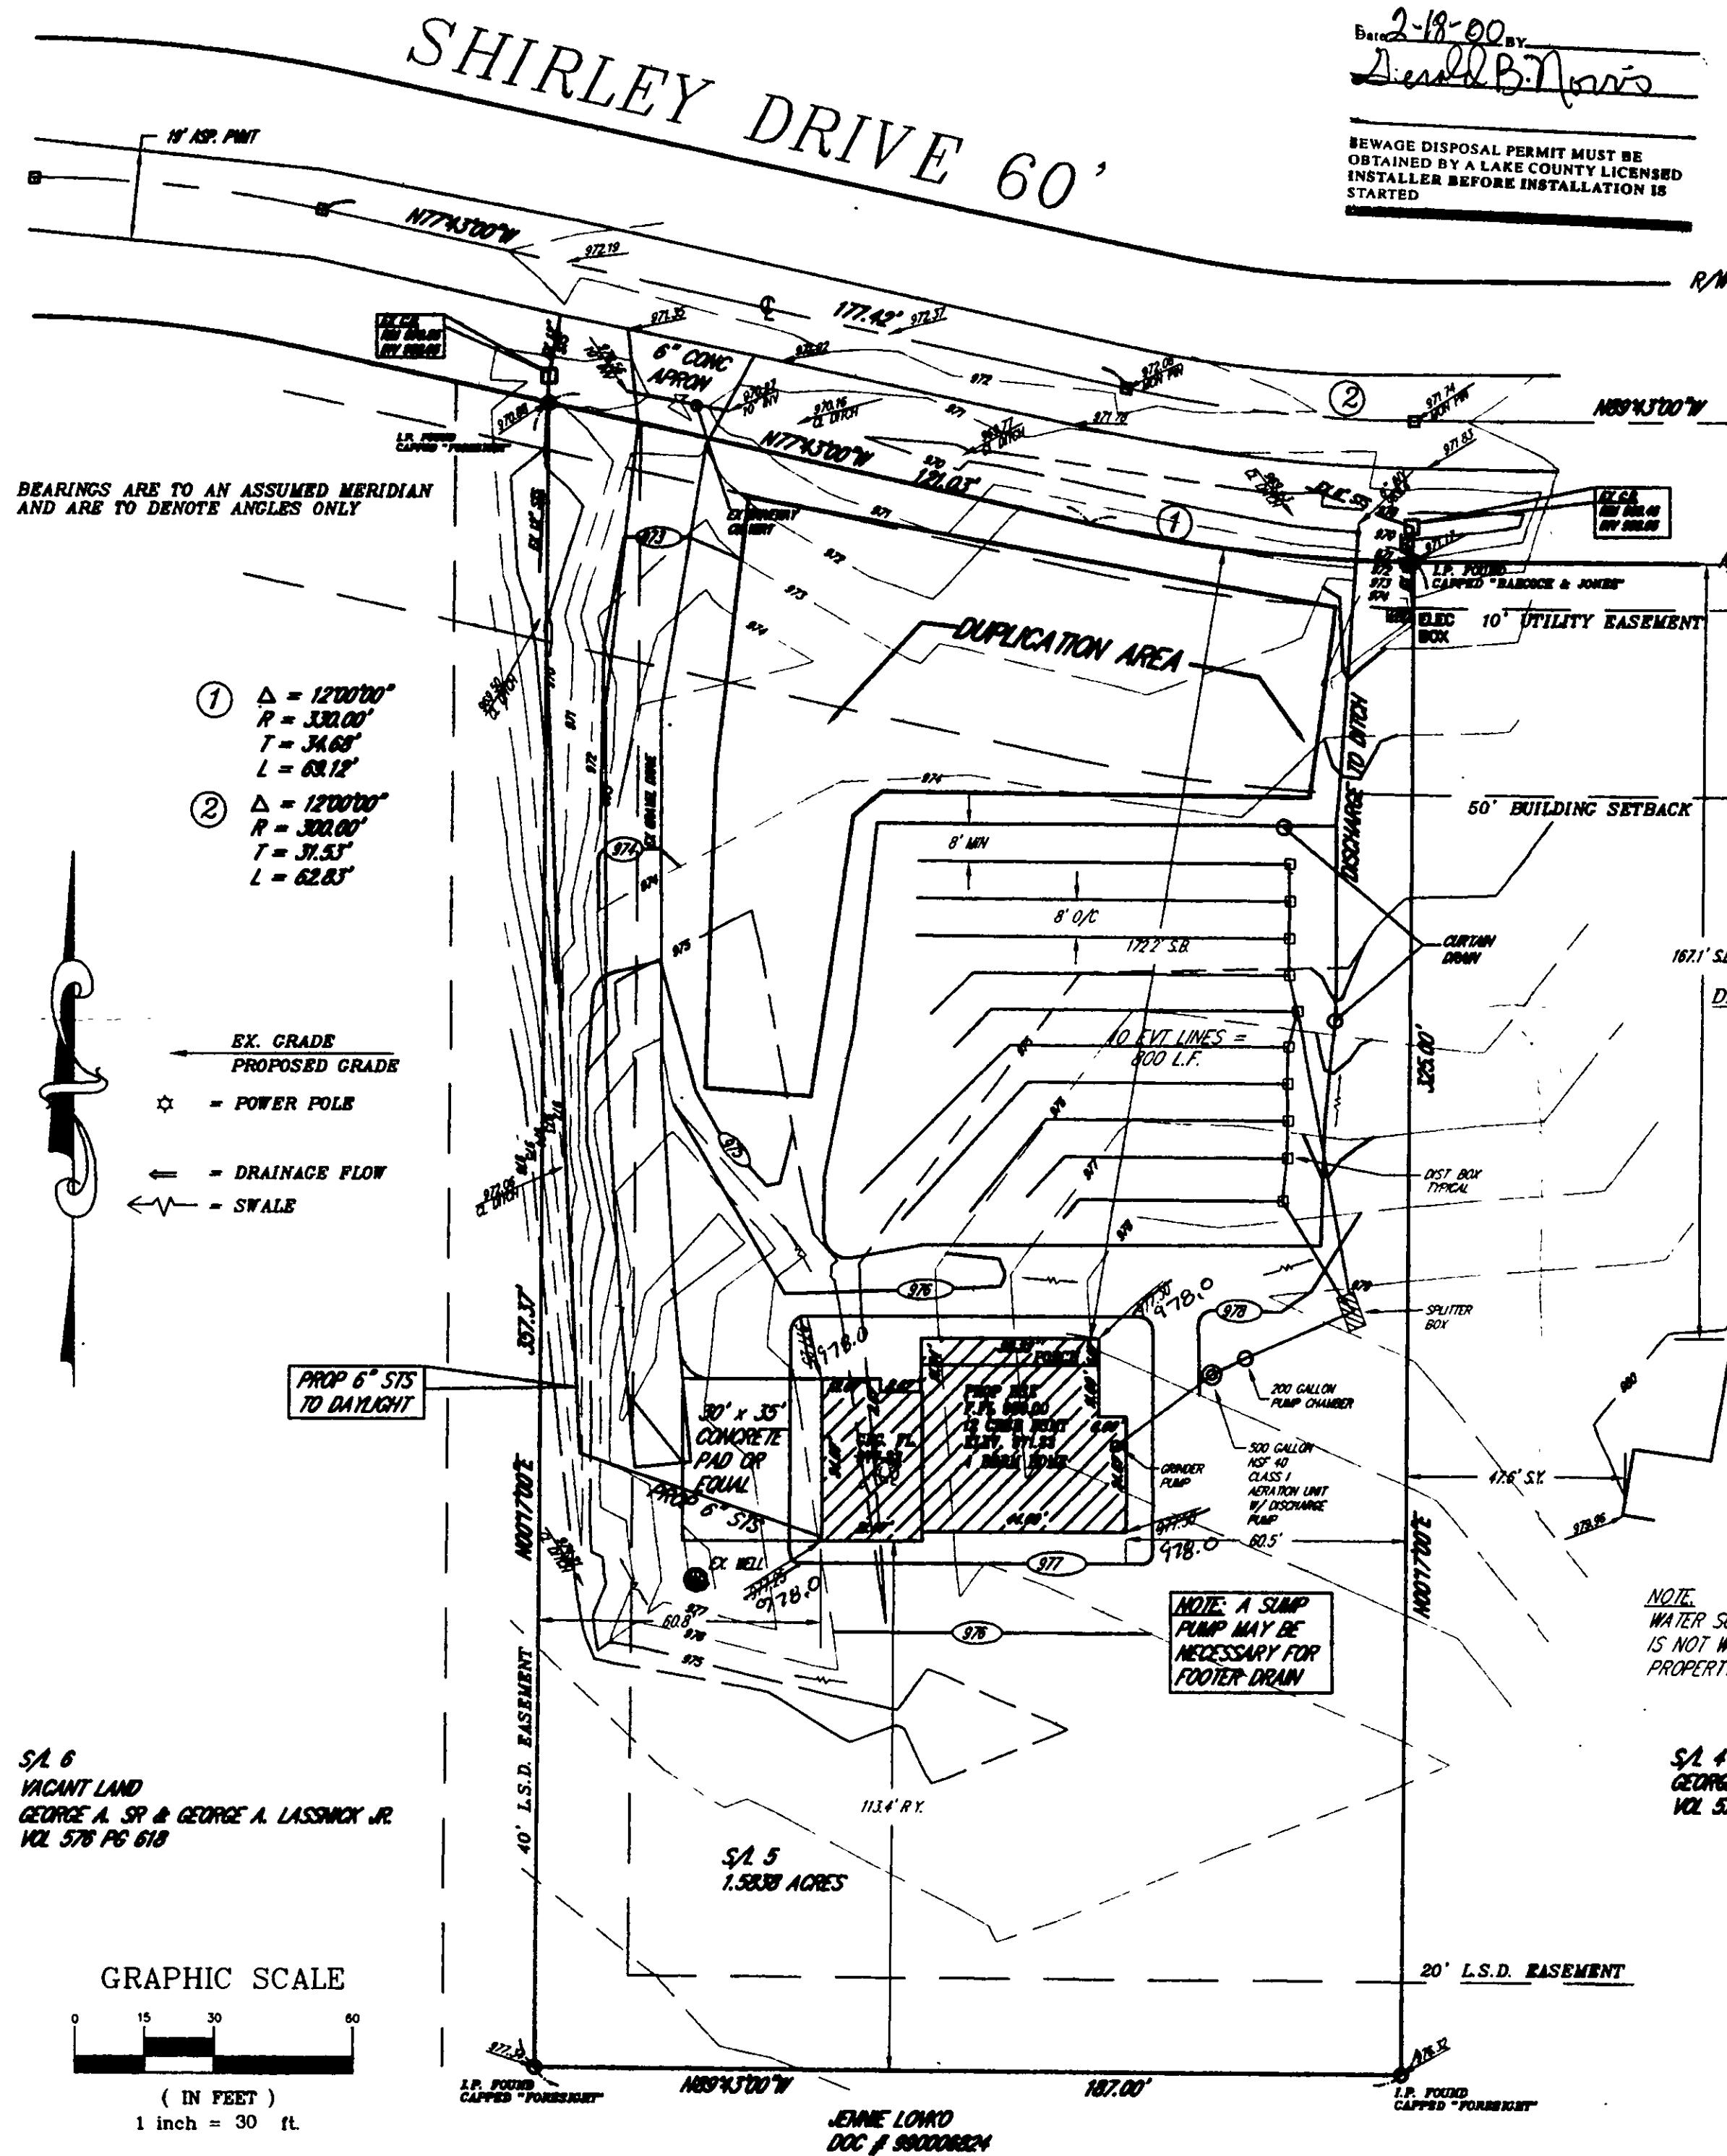


SEPTIC SYSTEM PROFILE
HORIZONTAL SCALE: 1" = 30'
VERTICAL SCALE: 1" = 5'

Grading Plan Approved
as shown and/or noted
THOMAS P. GILLES, P.E.
Lake County Engineer

By TAM Date 2/25/2000
REVISION: FIG. AS NOTED

BENCHMARK *
FINISHED FIRST FLOOR OF
HOUSE ON SUBLOT 4
ELEV. = 982.74

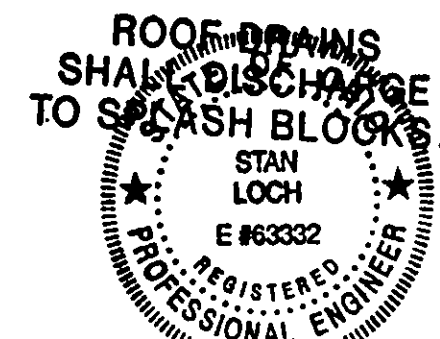

2-2-2000

"I, the undersigned hereby certify that this topography, indicated by 6", 1" or 2" contours, and elevations shown hereon represent on actual field survey made by me on the 10th day of January, 2000, and that the elevations were taken at appropriate intervals and that as of that date they existed as indicated hereon."

STAN R. LOCH

P.E. #63332
REG.#

SITE & GRADING PLAN
STEVE KINGZEL
S/L 5 - SHIRLEY DRIVE
WHITE TAIL RUN SUBD.
TOWNSHIP OF LEROY
LAKE COUNTY, OHIO

AVZTECH
ENGINEERING and SURVEYING
CMI Engineering - Land Surveying
FAX 639-9790
440-639-9950

VERT. SCALE: 1" = 5'	DATE: 1/21/00	DRAWING NO.: 100855	SHEET: 1 OF 1
HORIZ. SCALE: 1" = 30'	DPM	SRL	
DRAWN BY:		CHECKED BY:	
DATE:		NO. DATE	DESCRIPTION
			BY