

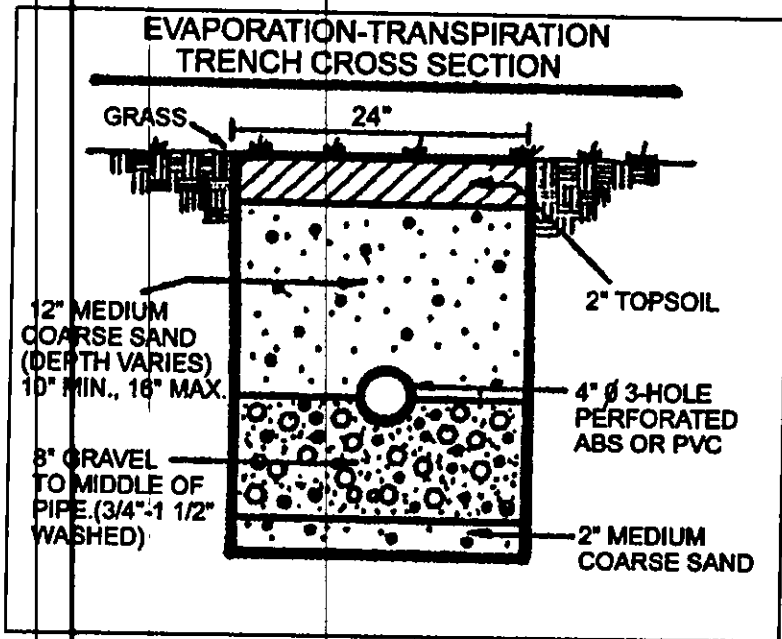
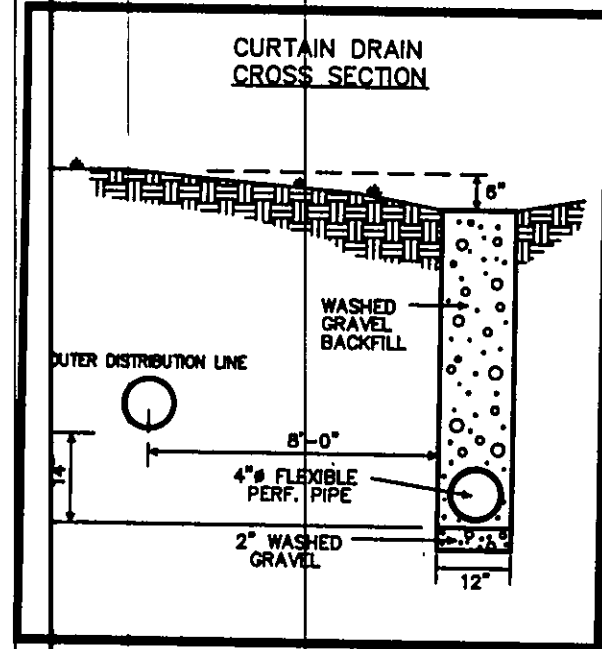


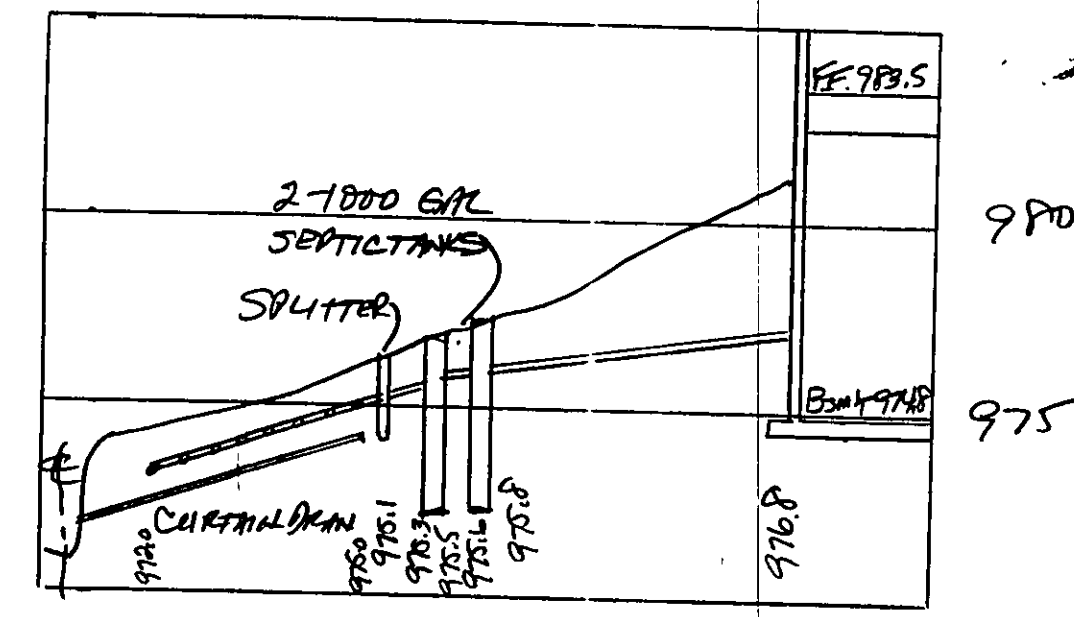

FRANK & JENNY LOVKO
VOL. 694 - PG. 431

Grading Plan Approved
as shown and/or noted
JAMES R. GILLS, P.E.
Lake County Engineer
By *[Signature]* Date 7/2/03

REVIEWED AND ACCEPTED
LAKE COUNTY GENERAL
HEALTH DISTRICT
6-30-03
[Signature]
SEWAGE DISPOSAL PERMIT MUST BE
OBTAINED BY LAKE COUNTY LICENSED
INSTALLER BEFORE INSTALLATION IS
STARTED.

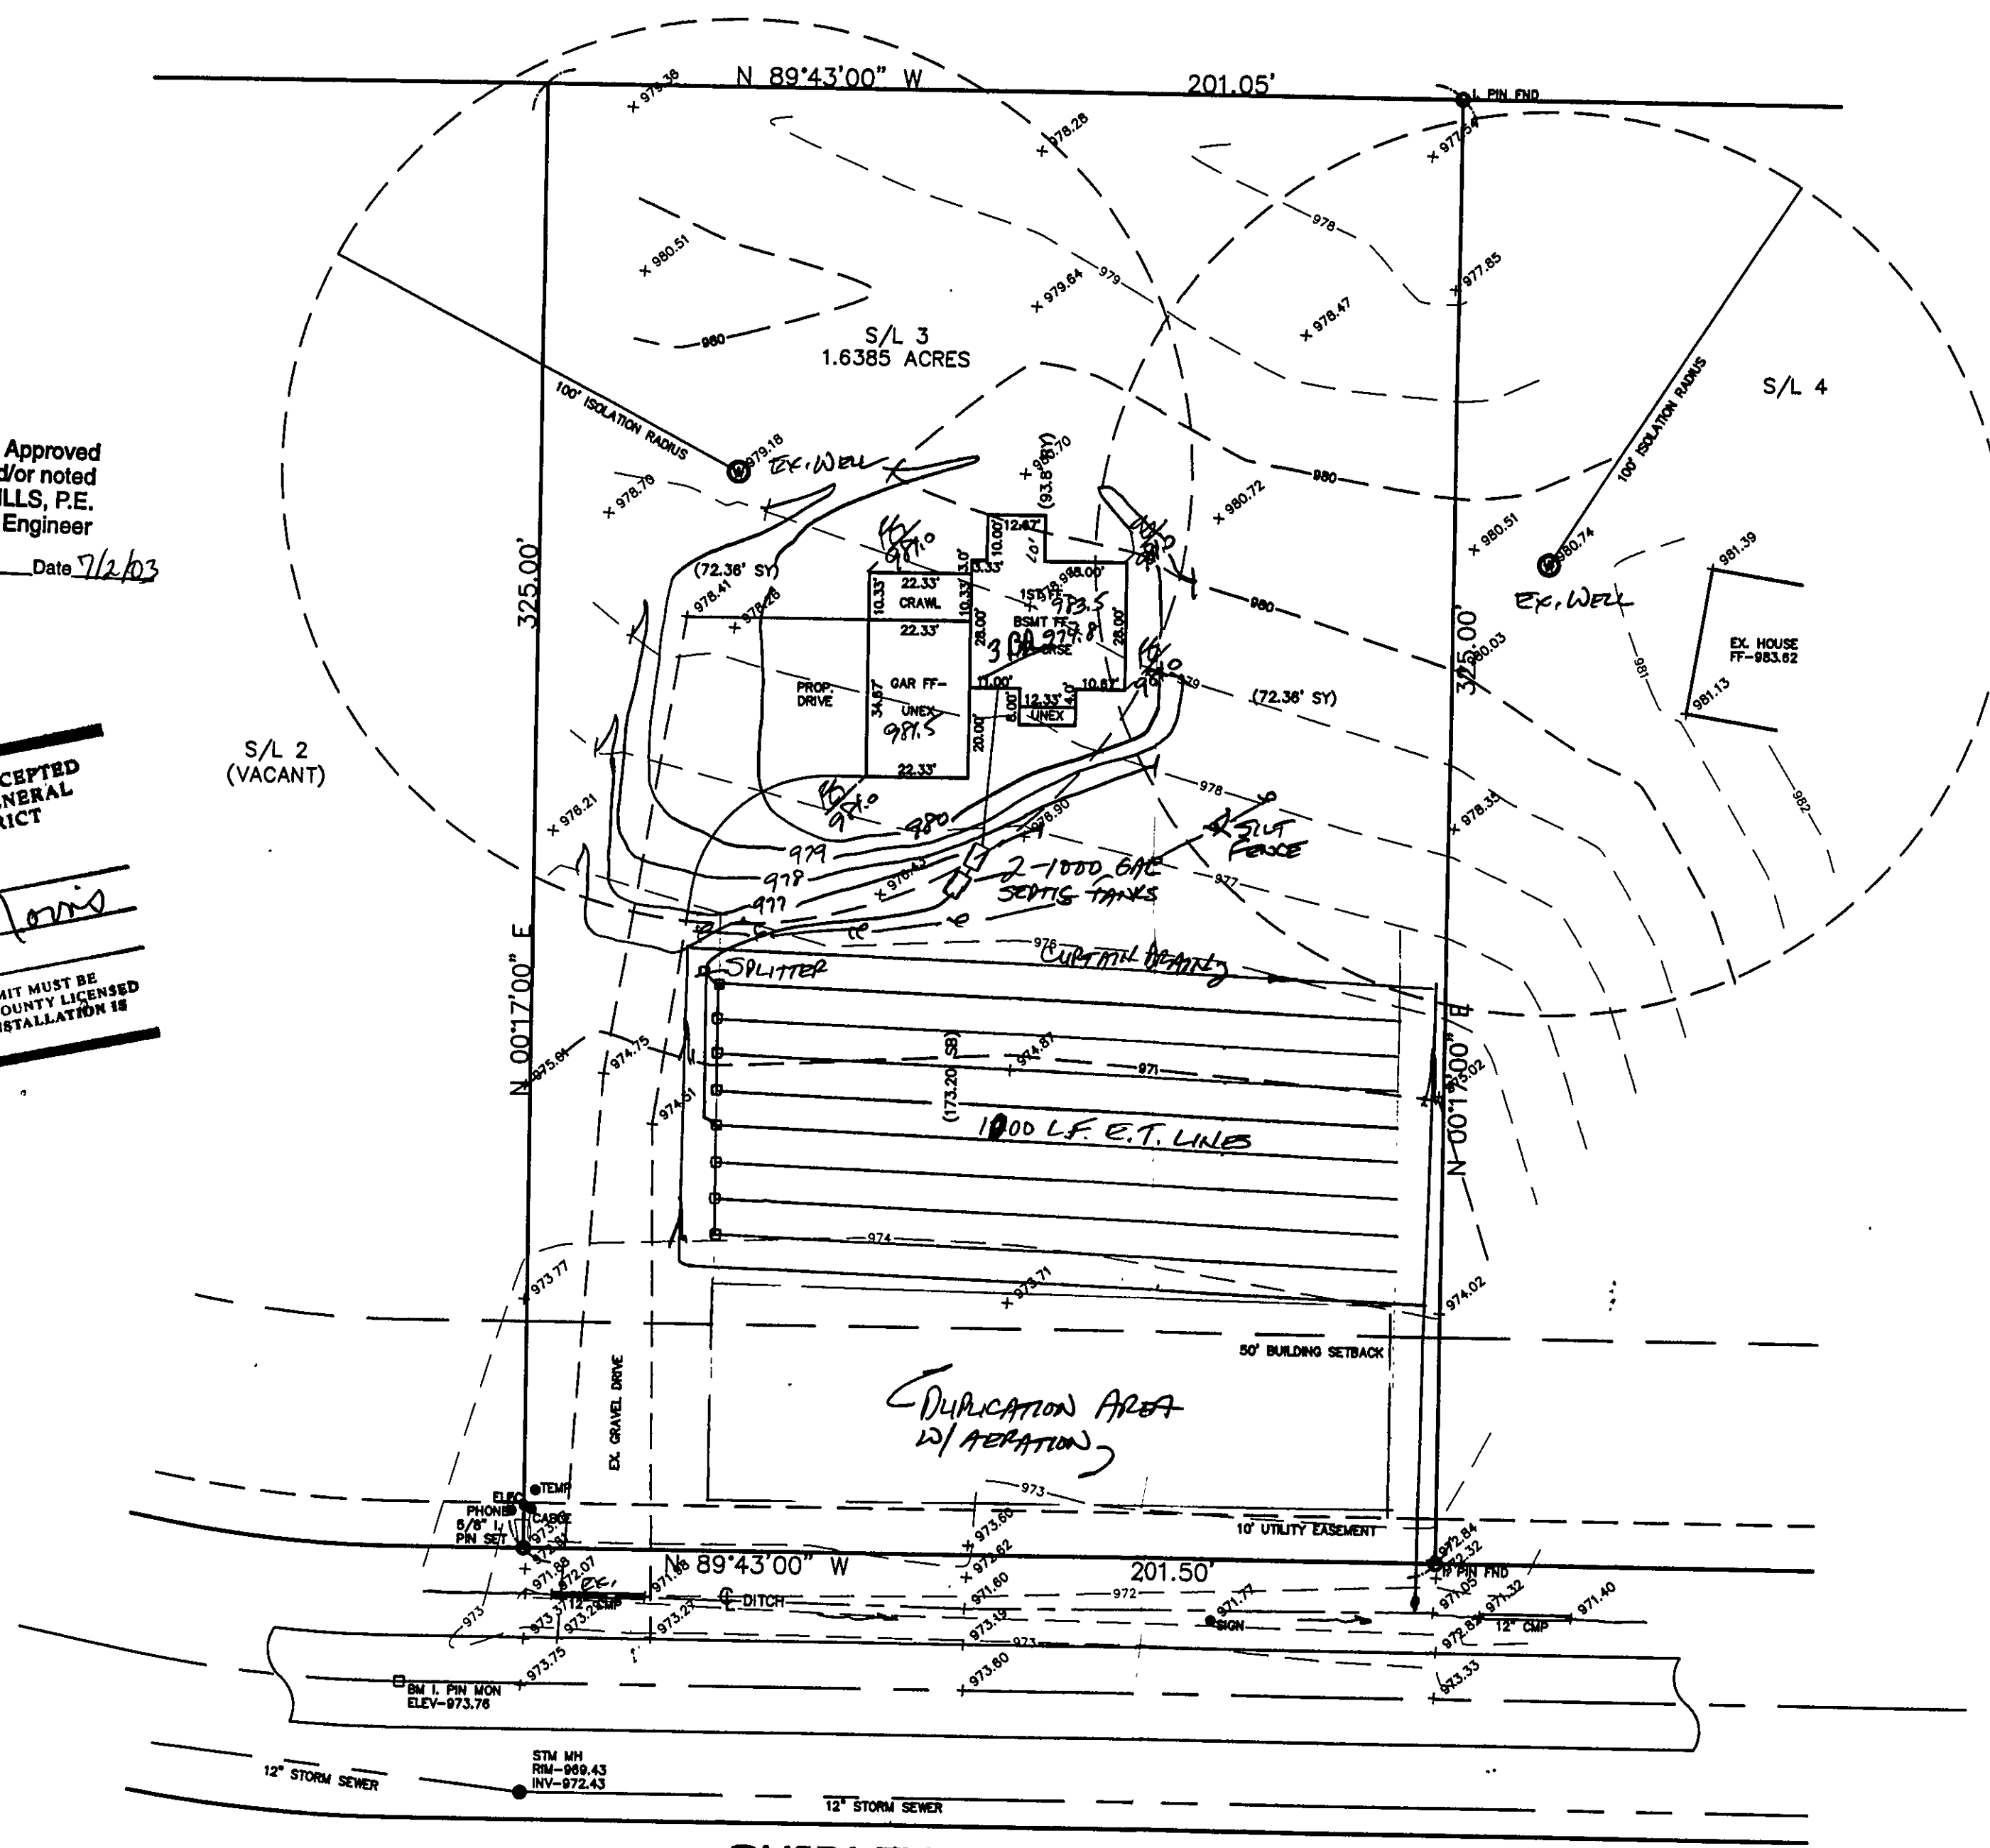


LERoy TOWNSHIP
Zoning Approved
6-29-03
[Signature]
Zoning Engineer

BM IRON PIN MONUMENT
ELEV-973.76

NOTE: ALL IRON PINS SET ARE
5/8" X 30" AND CAPPED
BABCOCK, JONES & ASSOC.

EXISTING UTILITIES NOTE:
THE SIZE AND LOCATION, BOTH HORIZONTAL AND VERTICAL,
OF THE UNDERGROUND UTILITIES SHOWN HEREON, HAVE BEEN
OBTAINED BY A SEARCH OF AVAILABLE RECORDS.
VERIFICATION BY FIELD OBSERVATION HAS BEEN CONDUCTED
WHERE PRACTICAL, HOWEVER, BABCOCK, JONES AND ASSOCIATES
INC. DOES NOT GUARANTEE THE COMPLETENESS NOR ACCURACY
THEREOF.

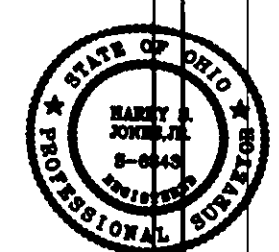

"I, the undersigned hereby certify that
this topography indicated by 6", 1", or 2"
contours, and elevations shown hereon
represent an actual field survey made by
me on the 18th day of June, 2003
and that the elevations were taken at
appropriate intervals and that as of that
date they existed as indicated hereon."

[Signature] #6343
Name Reg. No.

REV. NO.	DESCRIPTION	DATE	BY	CHK'D

bj BABCOCK, JONES AND ASSOCIATES, INC
CIVIL ENGINEERS - SURVEYORS - LAND PLANNERS
PAINESVILLE OHIO 44077

DATE 6/19/03
DESIGN BY HJ
DRAWN BY NS
APPROVED BY HJ

STE PLAN
FOR
JACK WATERWASH
LERoy TOWNSHIP LAKE COUNTY STATE OF OHIO

SCALE 1"=30'
JOB NO 99-230-3
SHEET 1 OF 1