


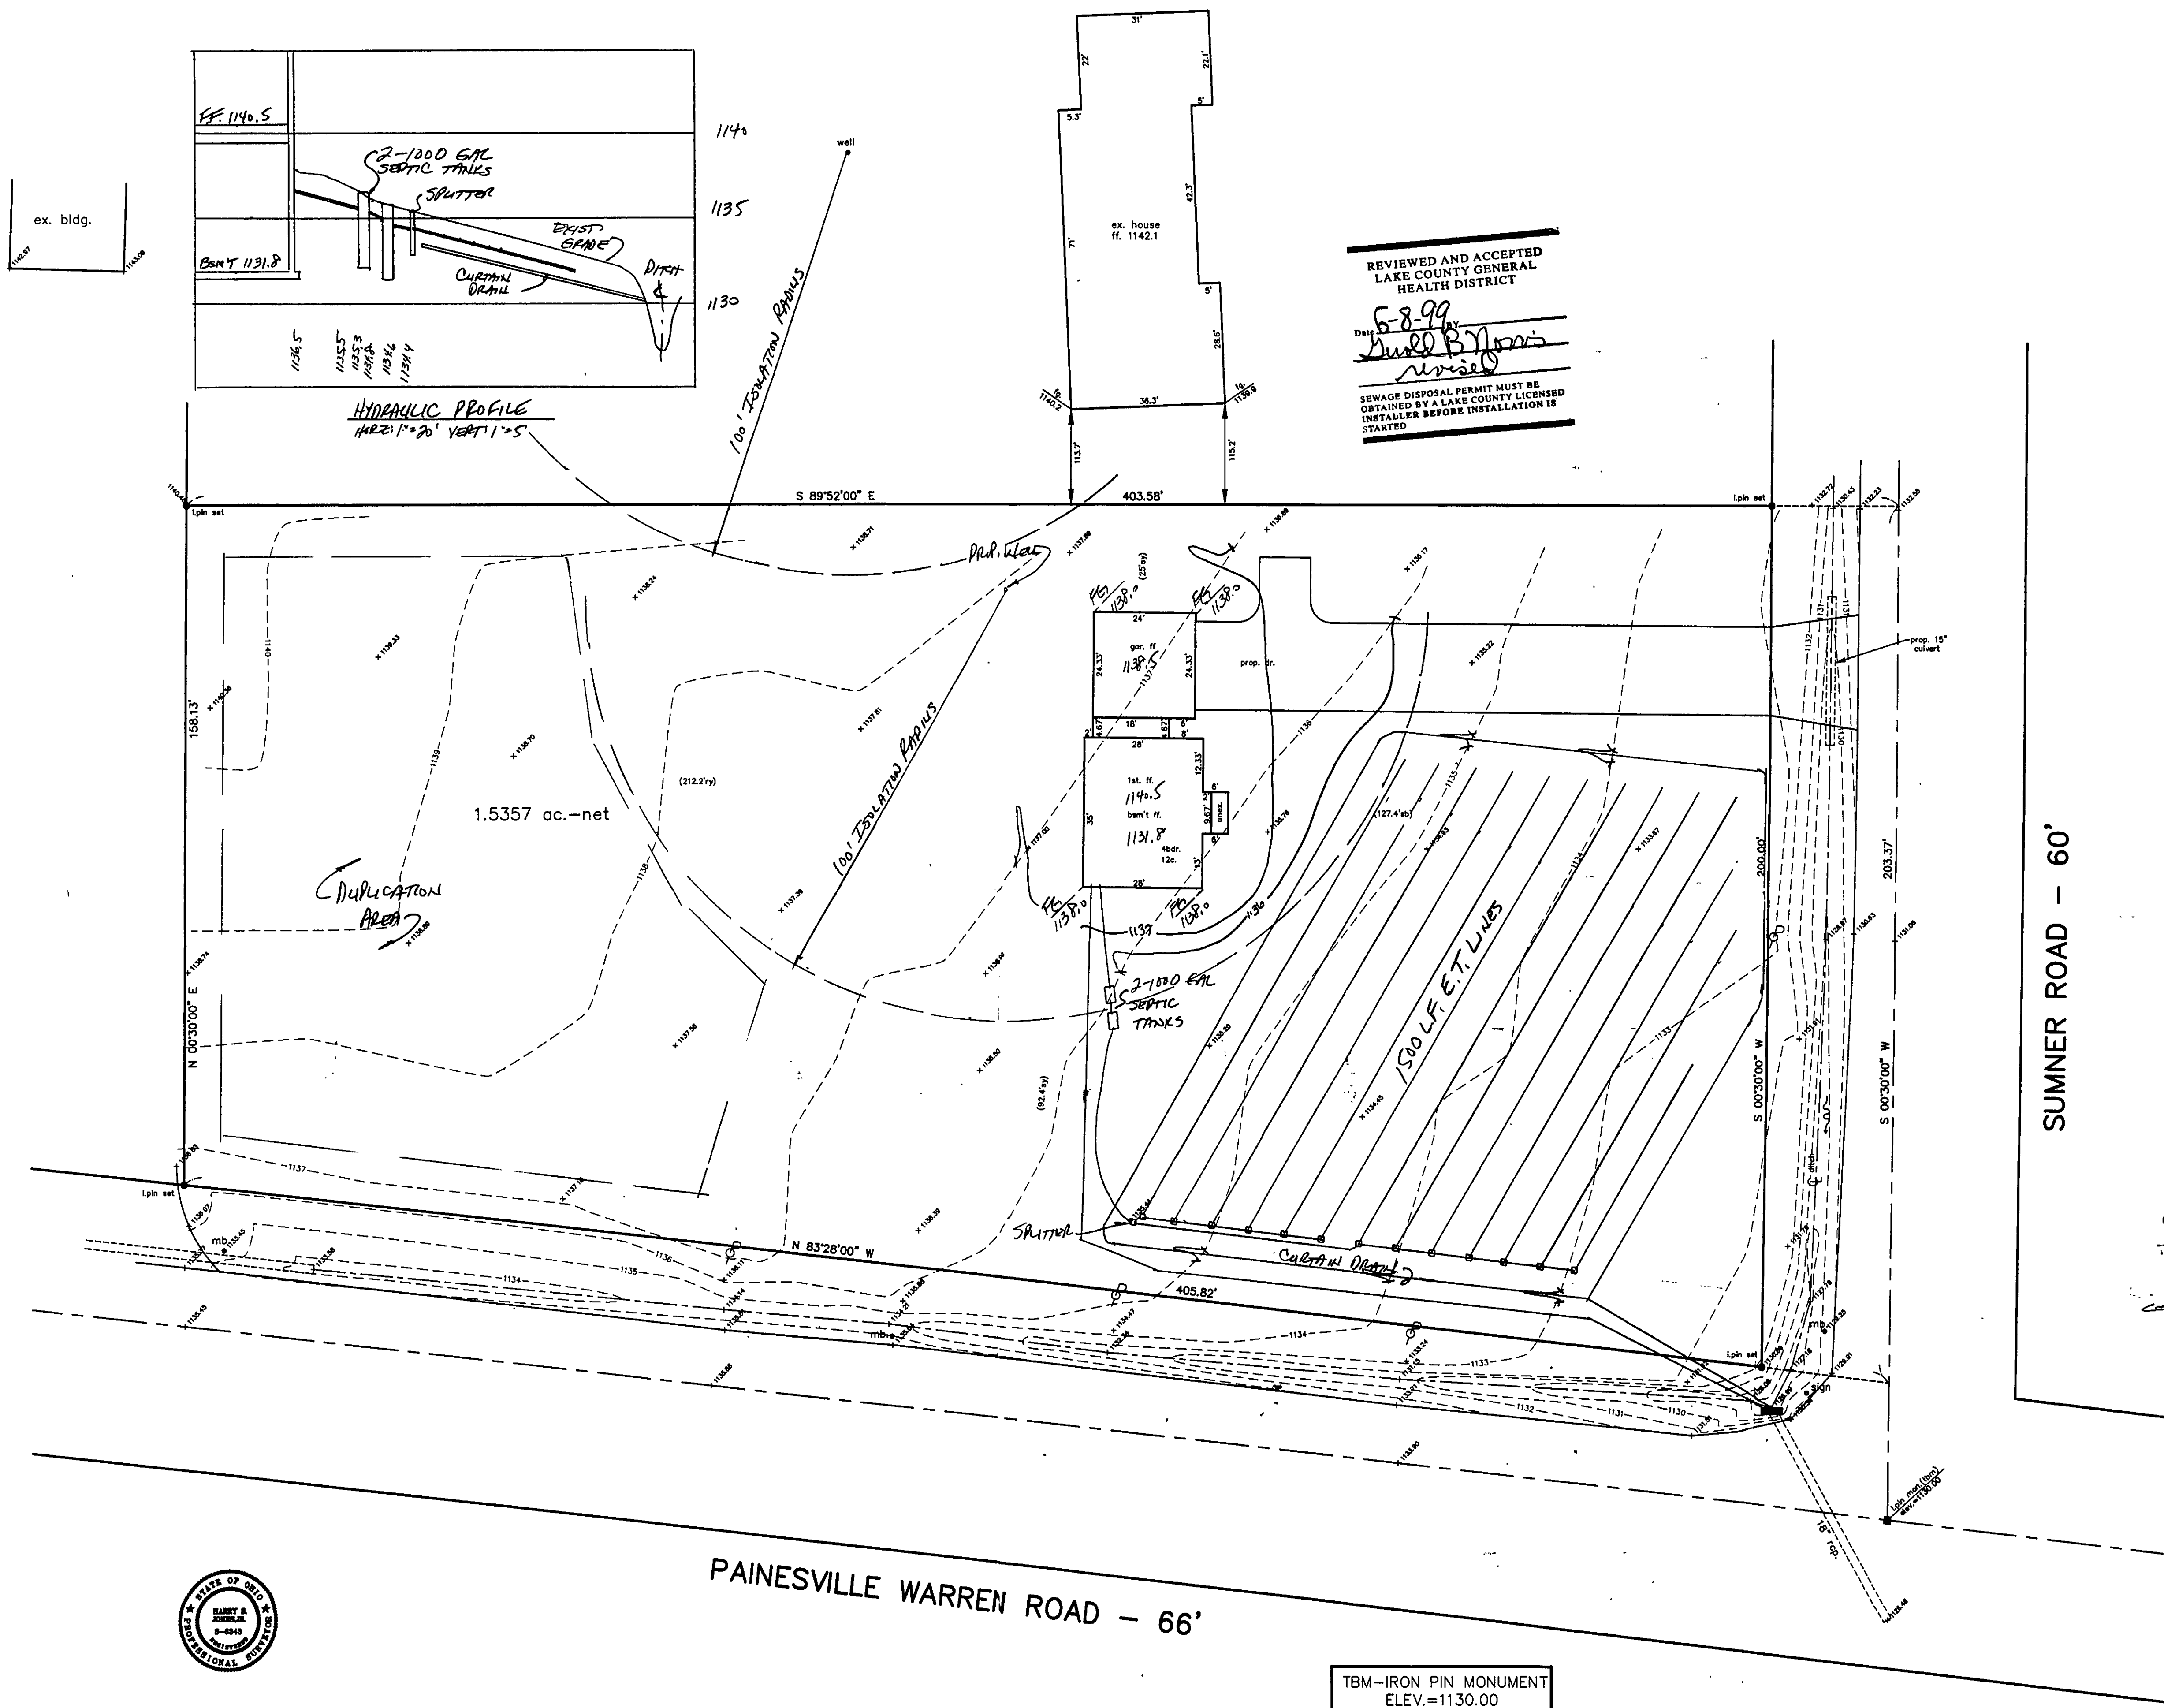

REVIEWED AND ACCEPTED
LAKE COUNTY GENERAL
HEALTH DISTRICT
DATE 5-8-99
SIGNED BY [Signature]
SEWAGE DISPOSAL PERMIT MUST BE
OBTAINED BY A LAKE COUNTY LICENSED
INSTALLER BEFORE INSTALLATION IS
STARTED

Grading Plan Approved
shown and/or noted
TAM, GILLES, P.E.
Landscape Architect
4/8/99
CONTINGENT on LEAD TAP BUMP

"I, the undersigned hereby certify that
this topography indicated by 6", 1", or 2"
contours, and elevations shown hereon
represent an actual field survey made by
me on the 22nd day of July, 1998
and that the elevations were taken at
appropriate intervals and that as of that
date they existed as indicated hereon.

HARRY A. JONES
Name: HARRY A. JONES
Reg. No. 46343



TBM-IRON PIN MONUMENT
ELEV.=1130.00

REV. NO.	DESCRIPTION	DATE	BY	CHK'D
1	REVISE HOUSE/SEPTIC LOCATION	6/2/99	T.R.	H.J.

bj BABCOCK, JONES AND ASSOCIATES, INC
CIVIL ENGINEERS - SURVEYORS - LAND PLANNERS
PAINESVILLE OHIO 44077

DATE	1/28/99
DESIGN BY	H.J.
DRAWN BY	T.R.
APPROVED BY	H.J.

SITE PLAN
FOR
PAM SLEEK

LEROEY TOWNSHIP

LAKE COUNTY

SCALE	1"=20'
JOB NO.	98-376
SHEET	1 OF 1