

REVIEWED AND ACCEPTED  
LAKE COUNTY GENERAL  
HEALTH DISTRICT

Date 9-21-99 BY Dad





SEWAGE DISPOSAL PERMIT MUST BE  
OBTAINED BY A LAKE COUNTY LICENSED  
INSTALLER BEFORE INSTALLATION IS  
STARTED.



*SITE ADDRESS*  
5795 TAYLOR RD  
LEROY OH 44077


Grading Plan Approved  
as shown and/or noted  
THOMAS P. GILLES, P.E.  
Lake County Engineer

- By TAM Date 9/27/99
1. SUBJECT TO TWP. ZONING APPROVAL
  2. DRIVE CULVERT SHALL BE SIZED TO Twp. Requirement.
  3. Grade as shown

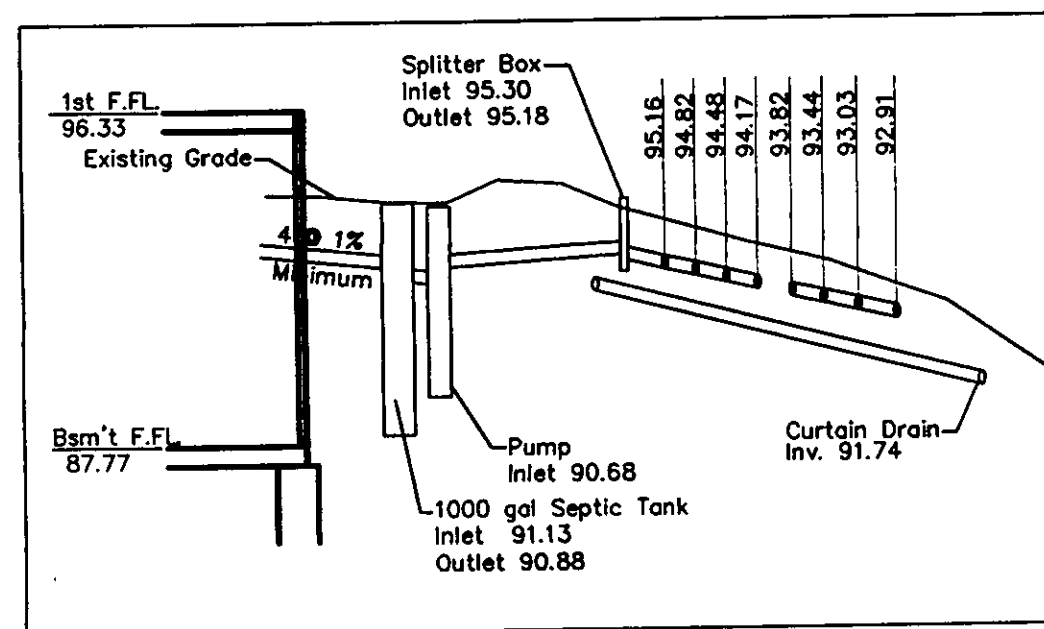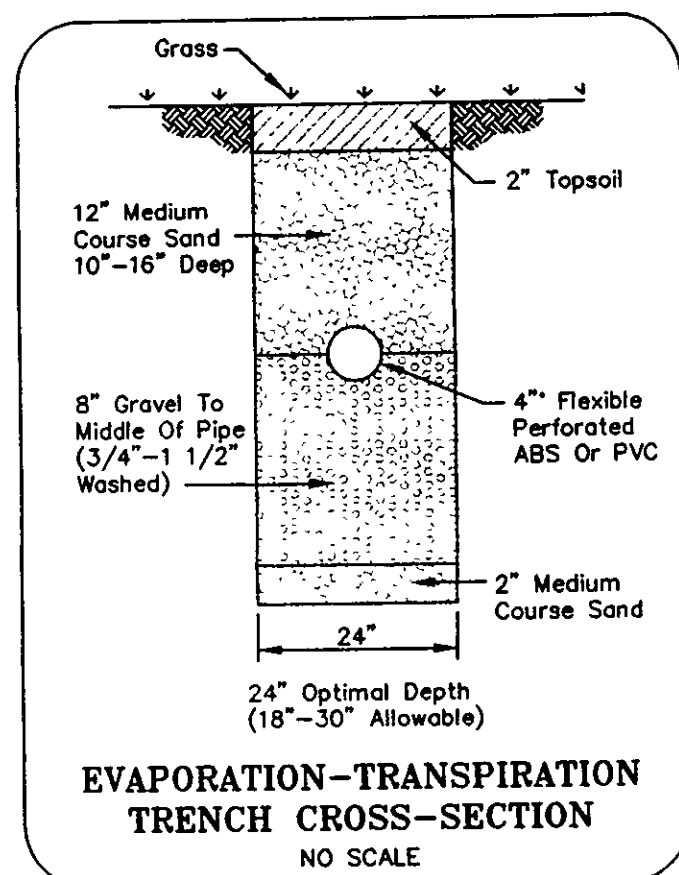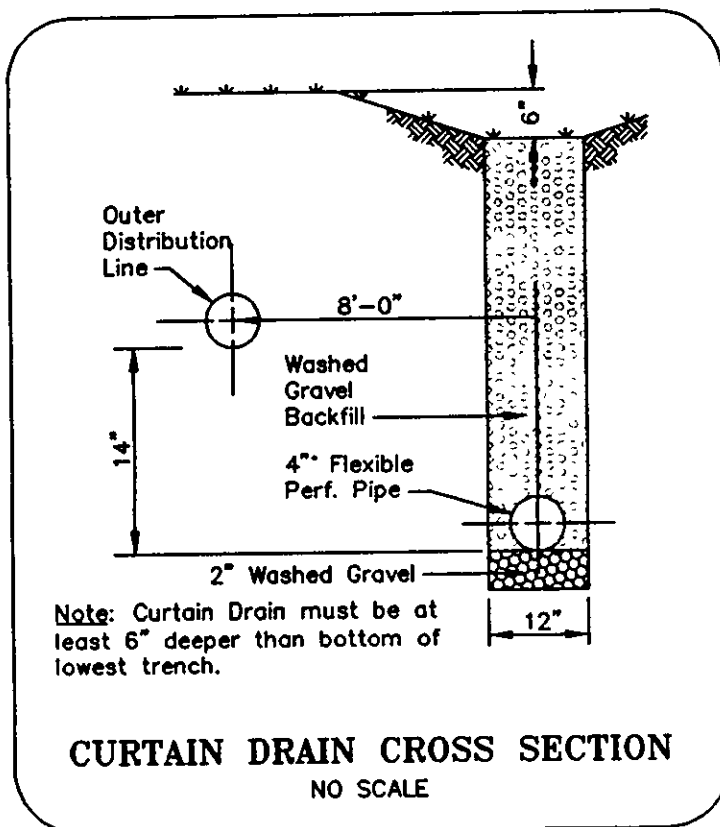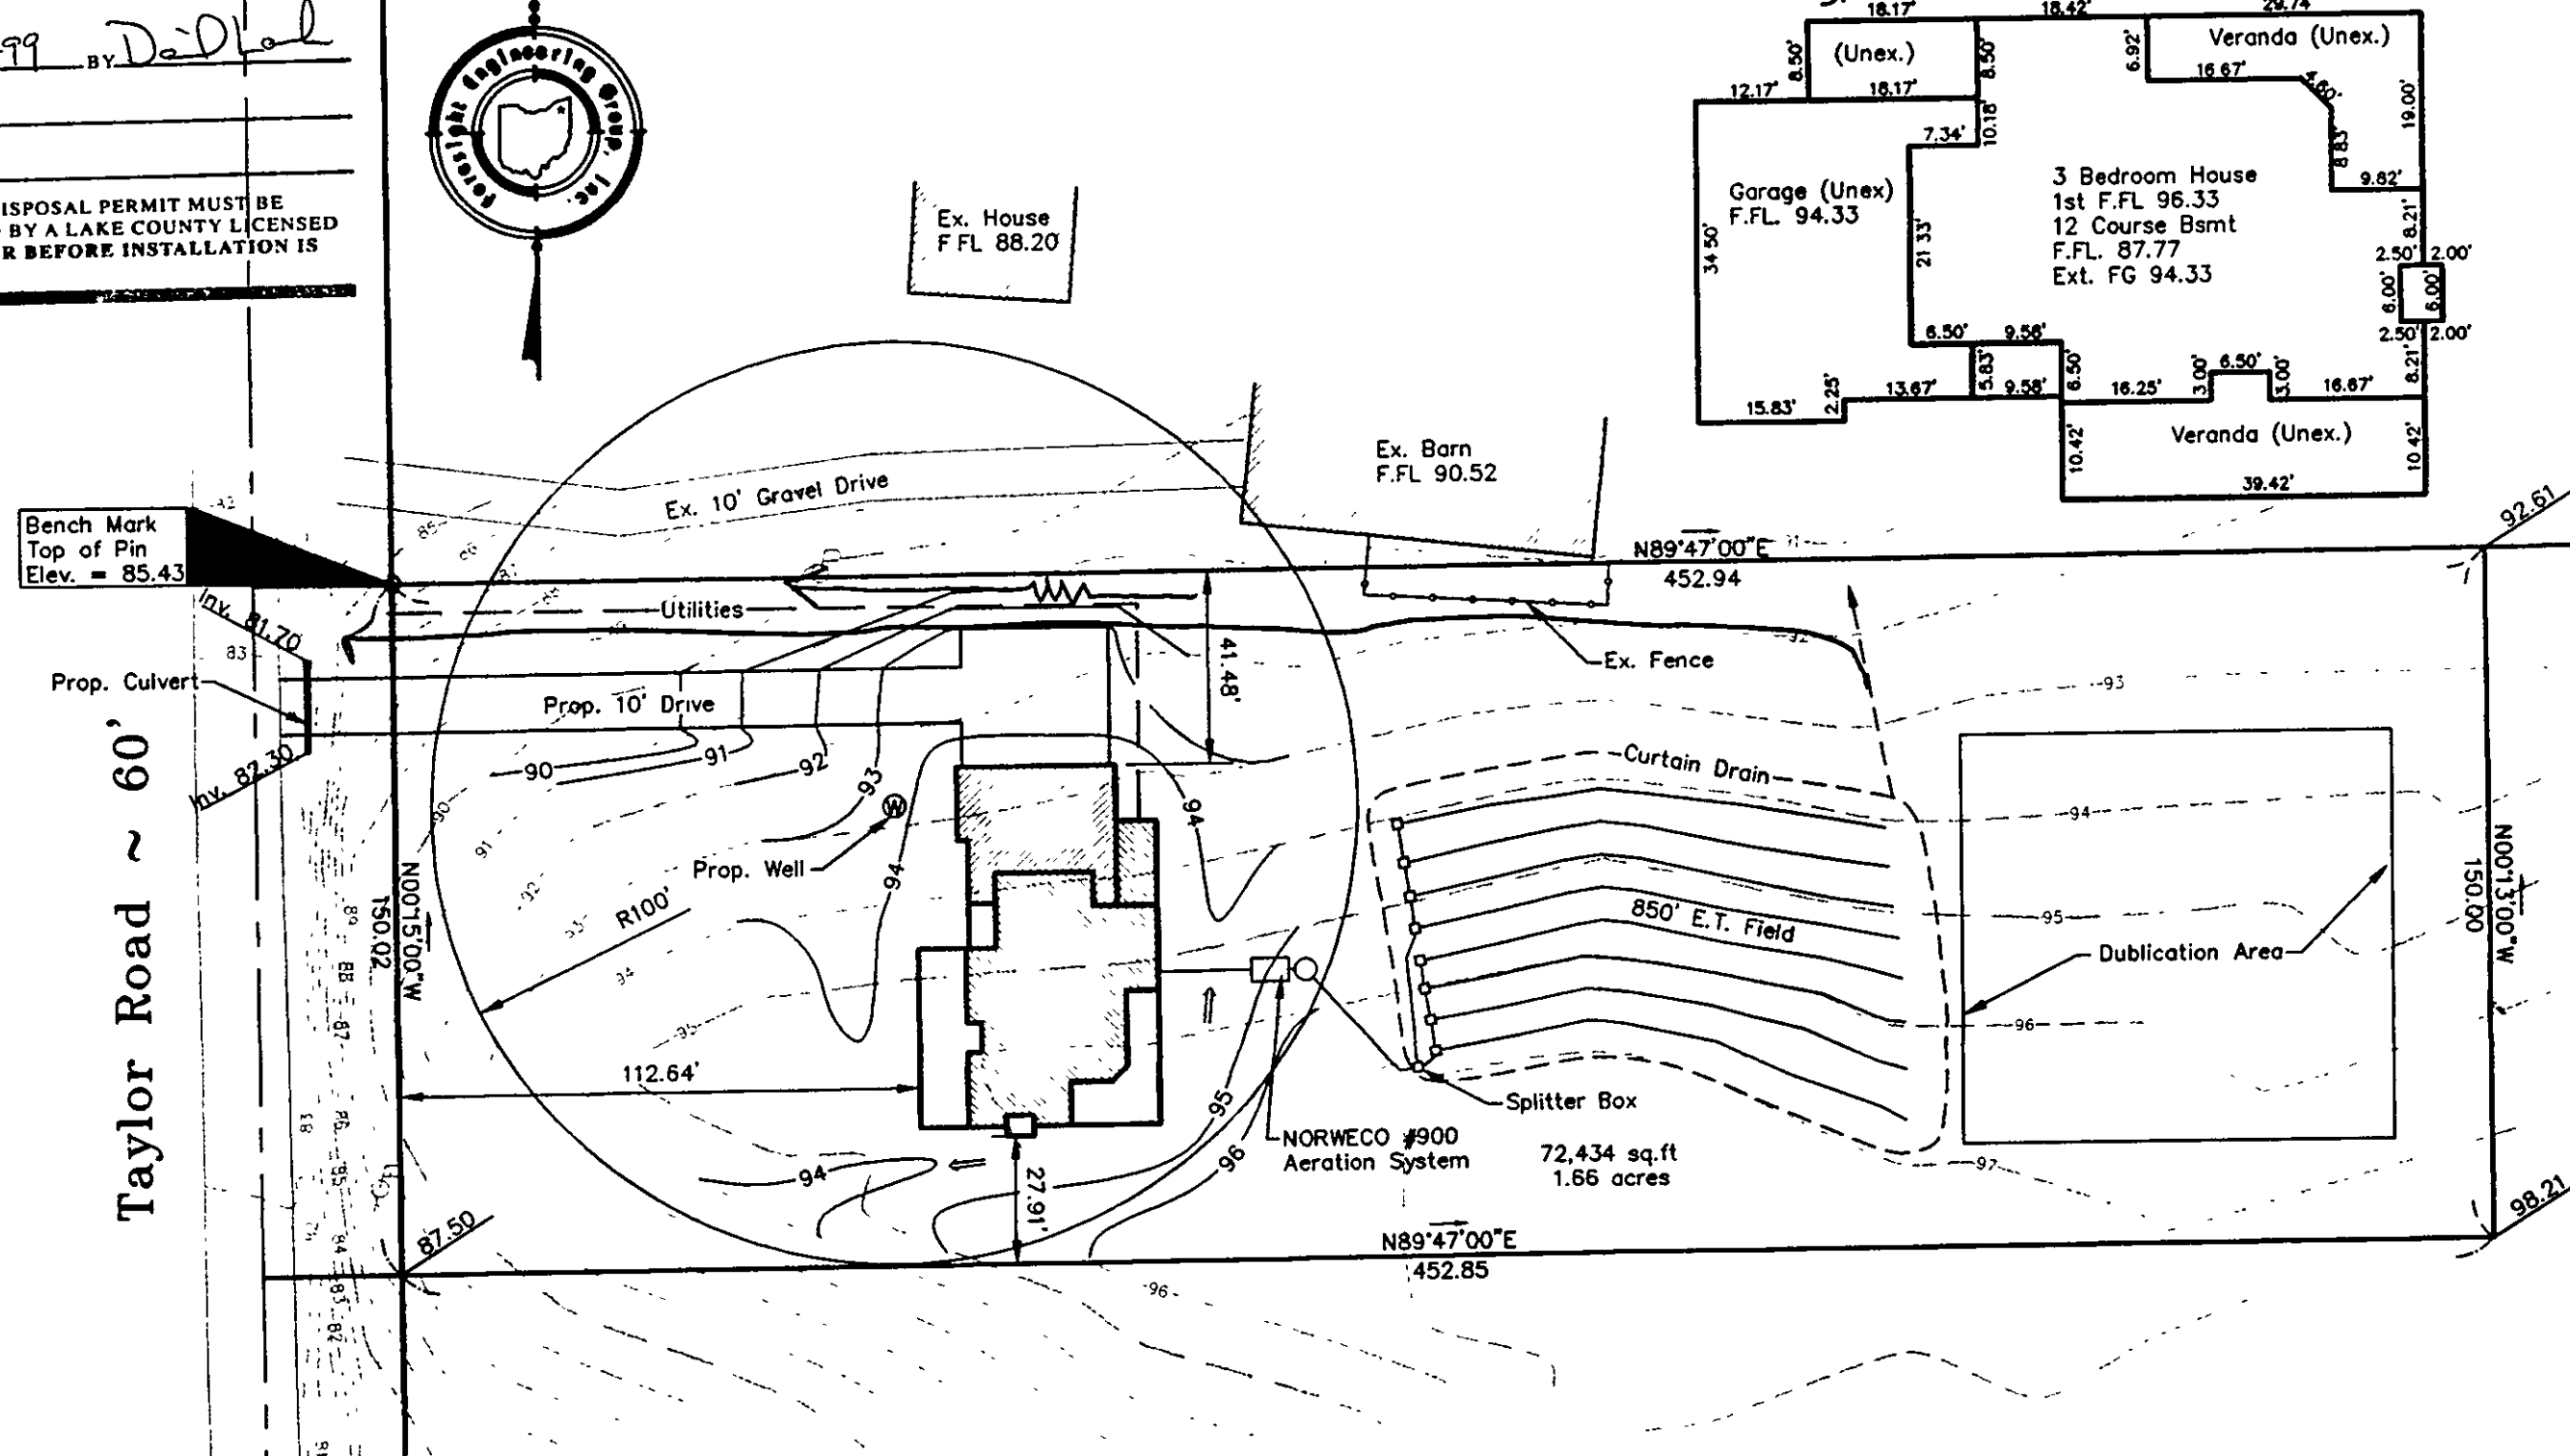

Hydraulic Profile

GRAPHIC SCALE

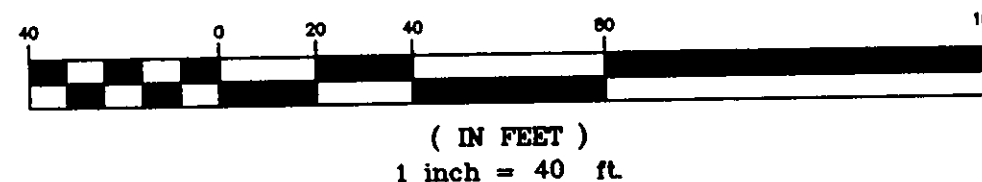

9-21-99 Steven Roessner  
stated no wells within  
100' of any sewage system  
DL

## SITE PLAN

for : Charles Graniteo CLIENT  
5851 Taylor Road ADDRESS Leroy CITY OH 44077 STATE ZIP

SUBLOT No. \_\_\_\_\_ SUBDIVISION NAME Leroy Township VOL. \_\_\_\_\_ PAGE \_\_\_\_\_  
LOT \_\_\_\_\_ TRACT \_\_\_\_\_ CITY Ohio STATE

## Foresight Engineering Group

Engineers & Surveyors

440 286-1010  
440 286-1034 fax  
320 Center Street, Unit F  
Chardon, Ohio 44024


## DESIGN CERTIFICATION

This Site Plan was prepared by Foresight Engineering Group, Inc. and is correct to the best of my knowledge and belief.

Steven A. Roessner  
NAME

## CHECK LIST

LOT DIMENSIONS & BEARINGS  
TIE TO NEAREST STREET  
SUBLOT No. (PARCEL No.)  
SURROUNDING OWNERS  
BUILDING DIMENSIONS  
SETBACK, SIDEYARD, REARYARD  
FINISH GRADES  
DRIVE & APRON TYPE, WIDTH, THICKNESS  
SIDEWALK TYPE, WIDTH, THICKNESS  
CULVERT TYPE, DIAM., LENGTH  
WATER MAIN SIZE, LOCATION  
SAN. SEWER SIZE, % GRADE, LOC.  
SAN. MH. CAST. ELEV., INV. ELEV.  
SAN. CONN. SIZE, % GRADE, LOC.  
STORM SEWER SIZE, % GRADE, LOC.  
STORM MH. CAST. ELEV., INV. ELEV.  
PAVT TYPE, GRADE, CURBS  
GAS LINE LOC., SIZE  
SEPTIC SYSTEM & DUPLICATION  
WELL LOCATION & ISOLATION RADIUS

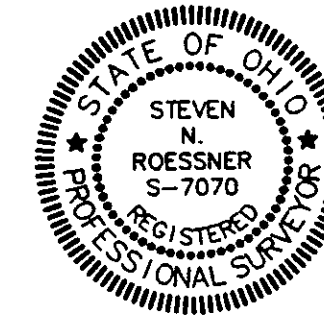

STATE SEAL

## "AS BUILT" CERTIFICATION

I hereby certify that the circled information is existing as obtained on the site \_\_\_\_\_ 19\_\_\_\_ and is correct to the best of my knowledge and belief.

NAME \_\_\_\_\_

SCALE : 1" = 40'


FILE NAME:  
I:\Gra49901\field

DATE : Sept. 2, 1999

BENCHMARK: Top of Pin Elev. = 85.43

"I, the undersigned hereby certify that this topography, indicated by 6", 1' or 2' contours, and the elevations shown hereon represent an actual field survey made by Foresight Engineering Group, Inc. on the \_\_\_\_\_ day of \_\_\_\_\_ 19\_\_\_\_ and that the elevations were taken at appropriate intervals and that as of that date they existed as indicated hereon."

Steven A. Roessner  
NAME

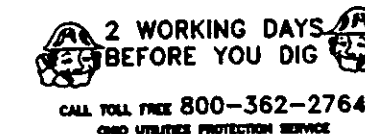

## EXISTING UNDERGROUND UTILITIES NOTES:

The location both horizontal and vertical of the underground utilities shown hereon, have been obtained by a diligent and comprehensive search of available records. Verification by field observation, has been conducted where practical. However, Foresight Engineering Group, Inc. does not guarantee the completeness nor accuracy thereof.