
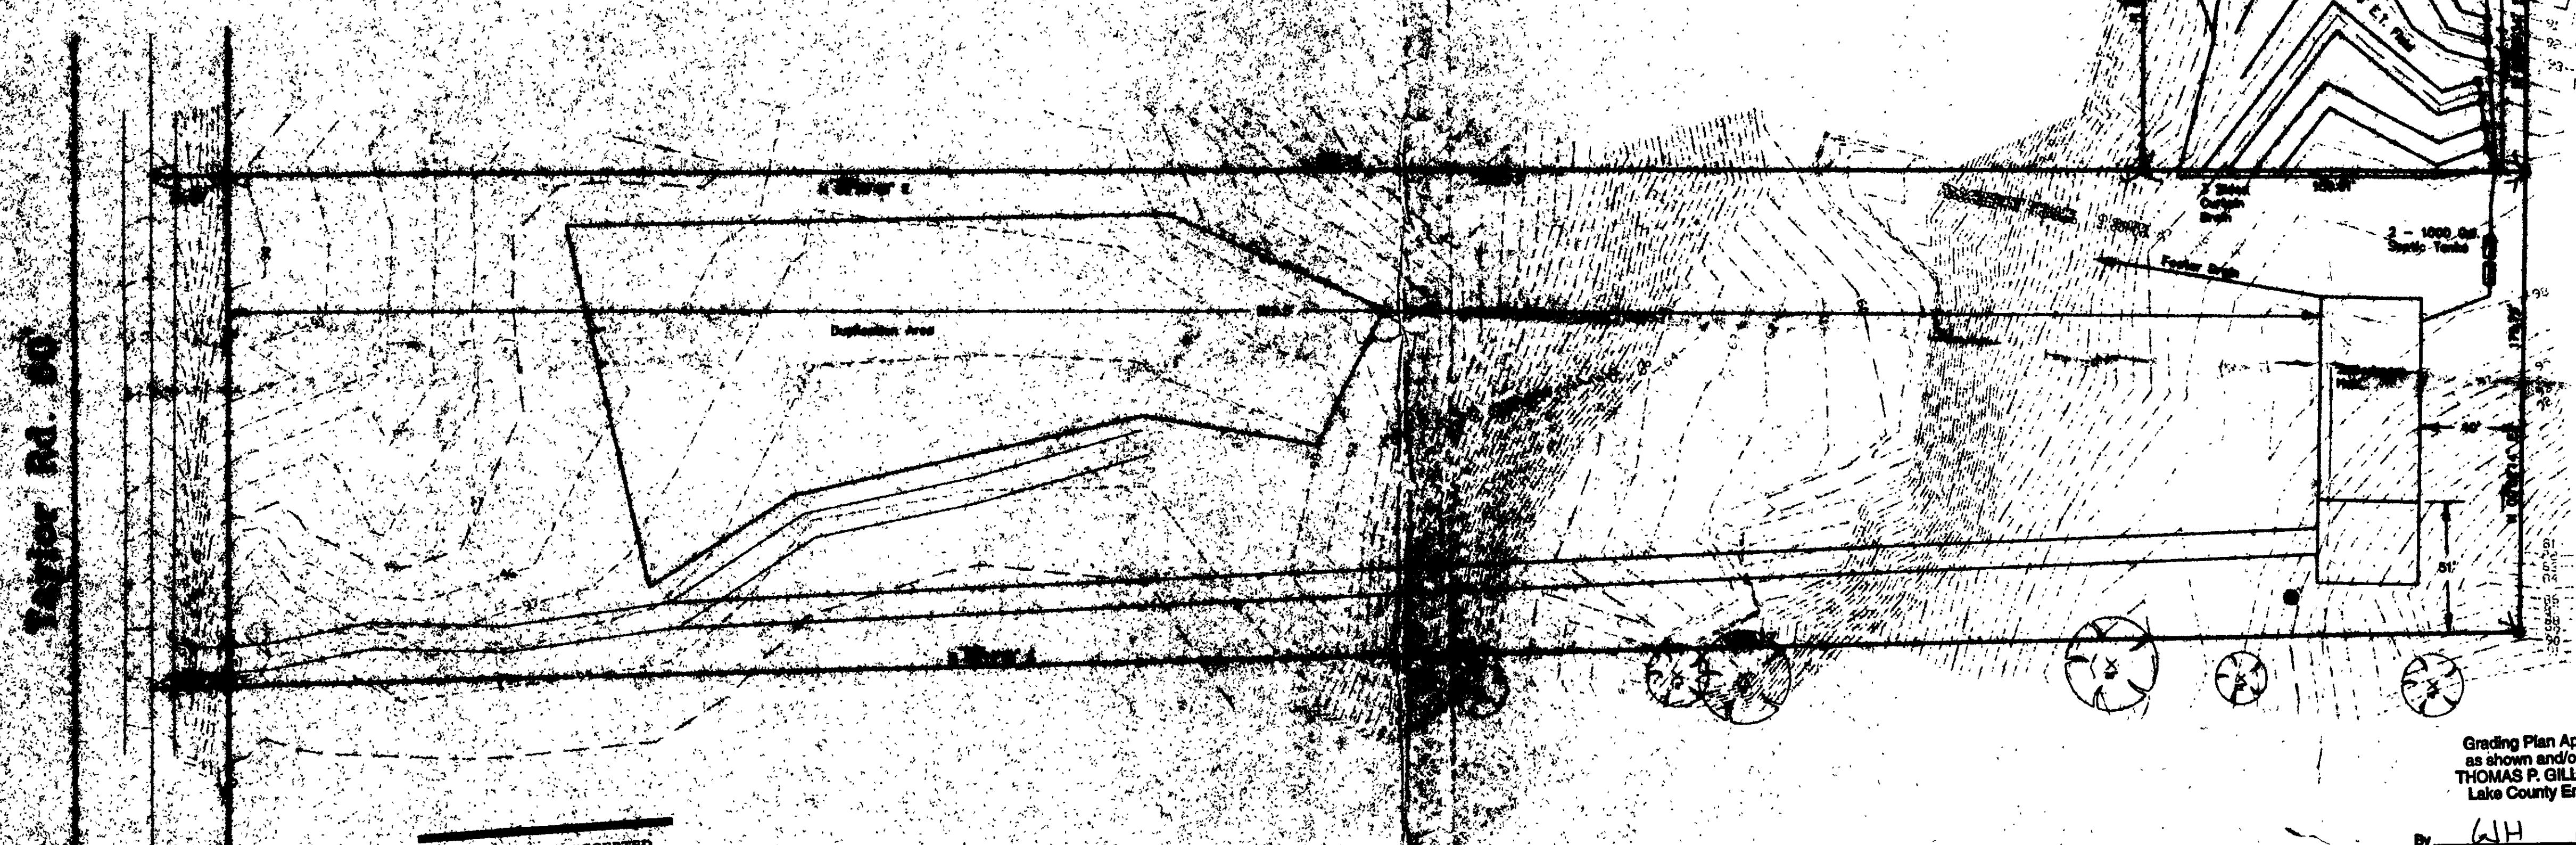
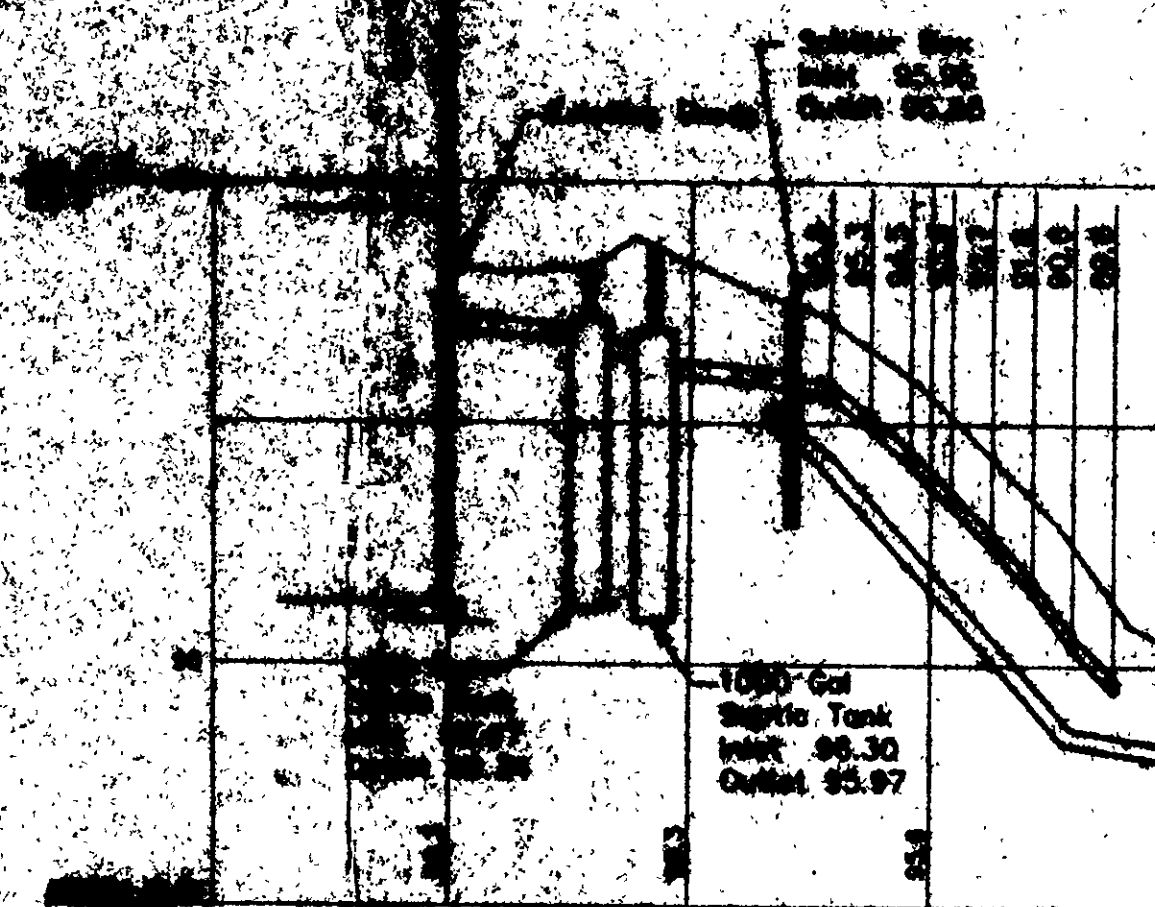
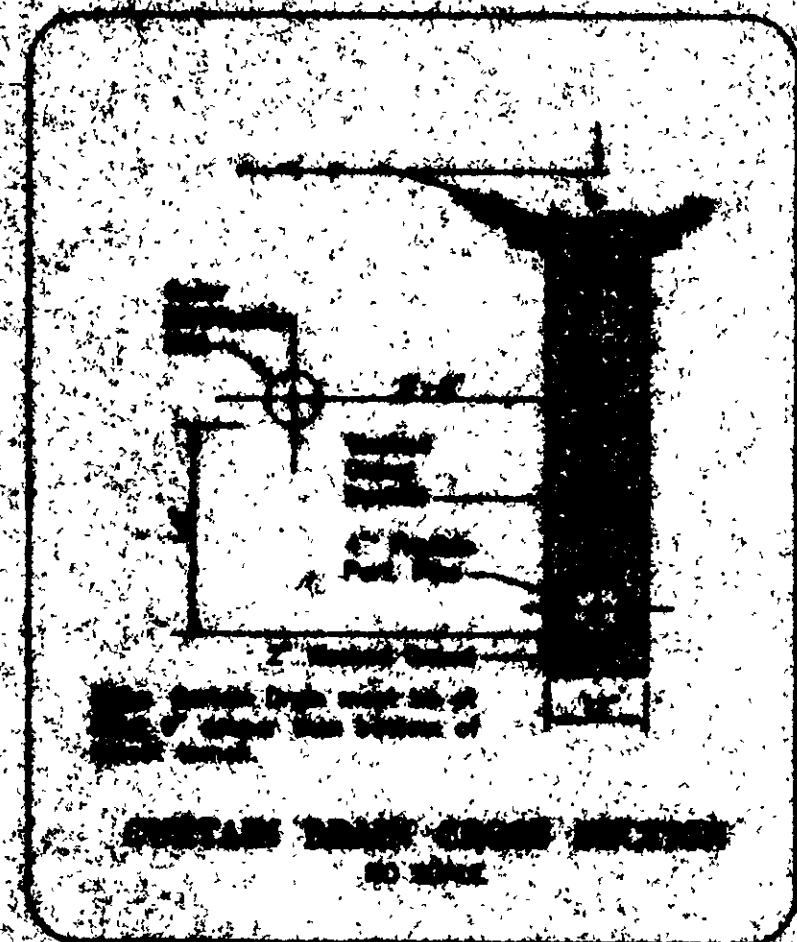


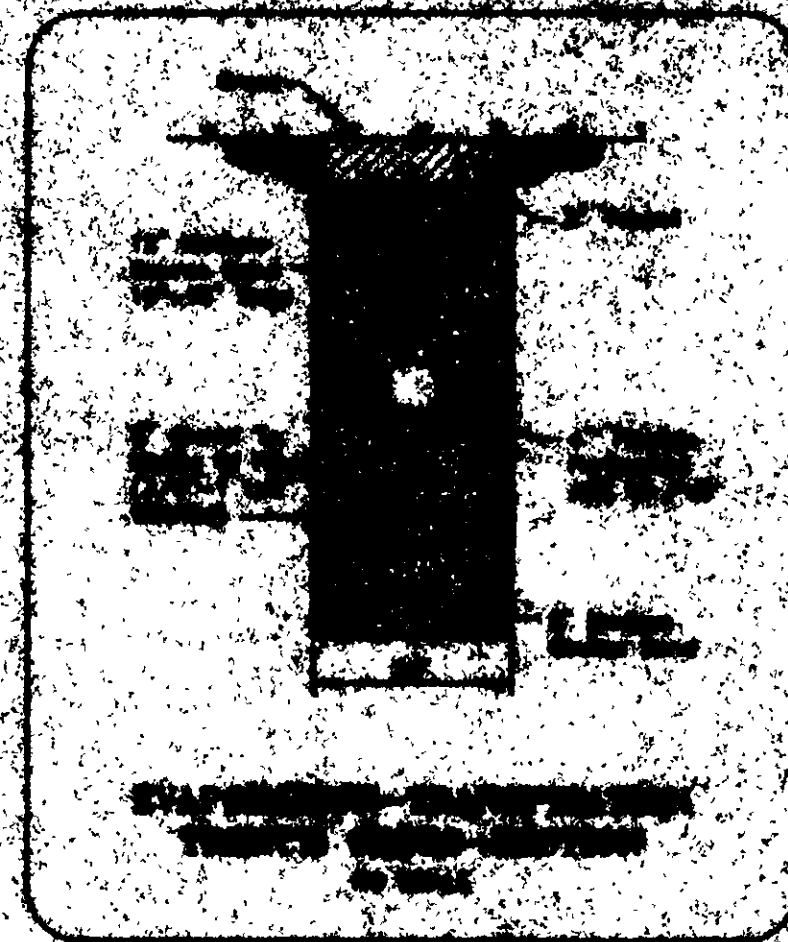

REVIEWED AND ACCEPTED
LAKE COUNTY GENERAL
HEALTH DISTRICT
DATE: 6/10/98
BY: [Signature]

SEWAGE DISPOSAL PERMIT MUST BE
OBTAINED IN A LAKE COUNTY LICENSED
INSTALLER BEFORE INSTALLATION IS
STARTED.

Grading Plan Approved
as shown and/or noted
THOMAS P. GILLES, P.E.
Lake County Engineer

By: [Signature] Date: 6/10/98


BENCHMARK: on Top of SW corner 94.50

I, the undersigned hereby certify that the topography, indicated by 6", 1" or 2" contours, and the elevations shown on this plan were taken by Foresight Engineering Group, Inc. on the 10th day of June, 1998, and that the elevations were taken at the location indicated and that as of that date they were as indicated herein.

DESIGN CERTIFICATION

This Site Plan was prepared by Foresight Engineering Group, Inc., and is subject to the best of my knowledge and belief.


[Signature]

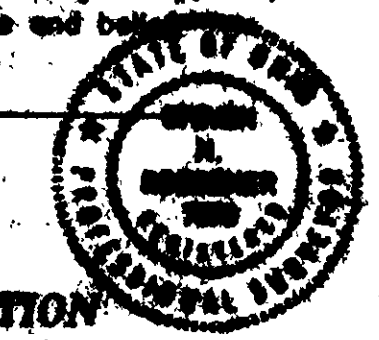

"AS BUILT" CERTIFICATION



I hereby certify that the above information is existing as shown on this site plan and is subject to the best of my knowledge and belief.

[Signature]

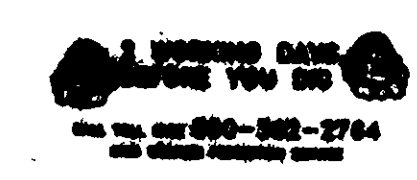

THESE DOCUMENTS ARE NOT TO BE USED FOR ANY OTHER PROJECT WITHOUT THE WRITTEN CONSENT OF FORESIGHT ENGINEERING GROUP, INC. ANY OTHER USE IS STRICTLY PROHIBITED.

GRAPHIC SCALE

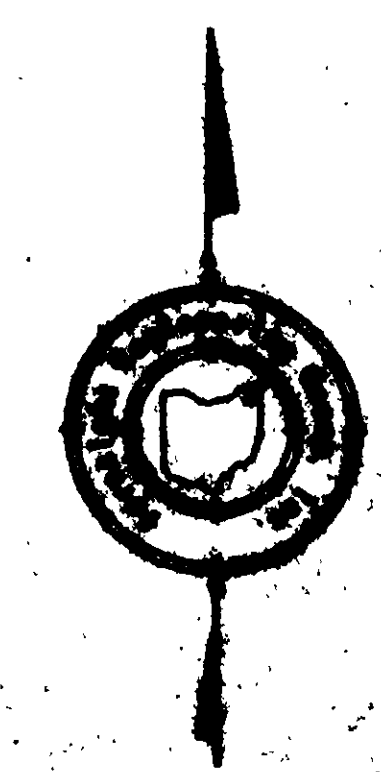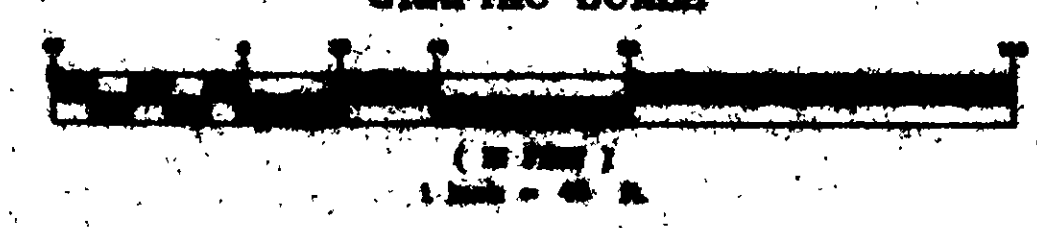

E.L. MOORE HOMES, INC.
Taylor Road Property
Taylor Township, Lake County, Ohio
Lot 1, 2, 3, 99, 100