



HILLER PLOT PLAN

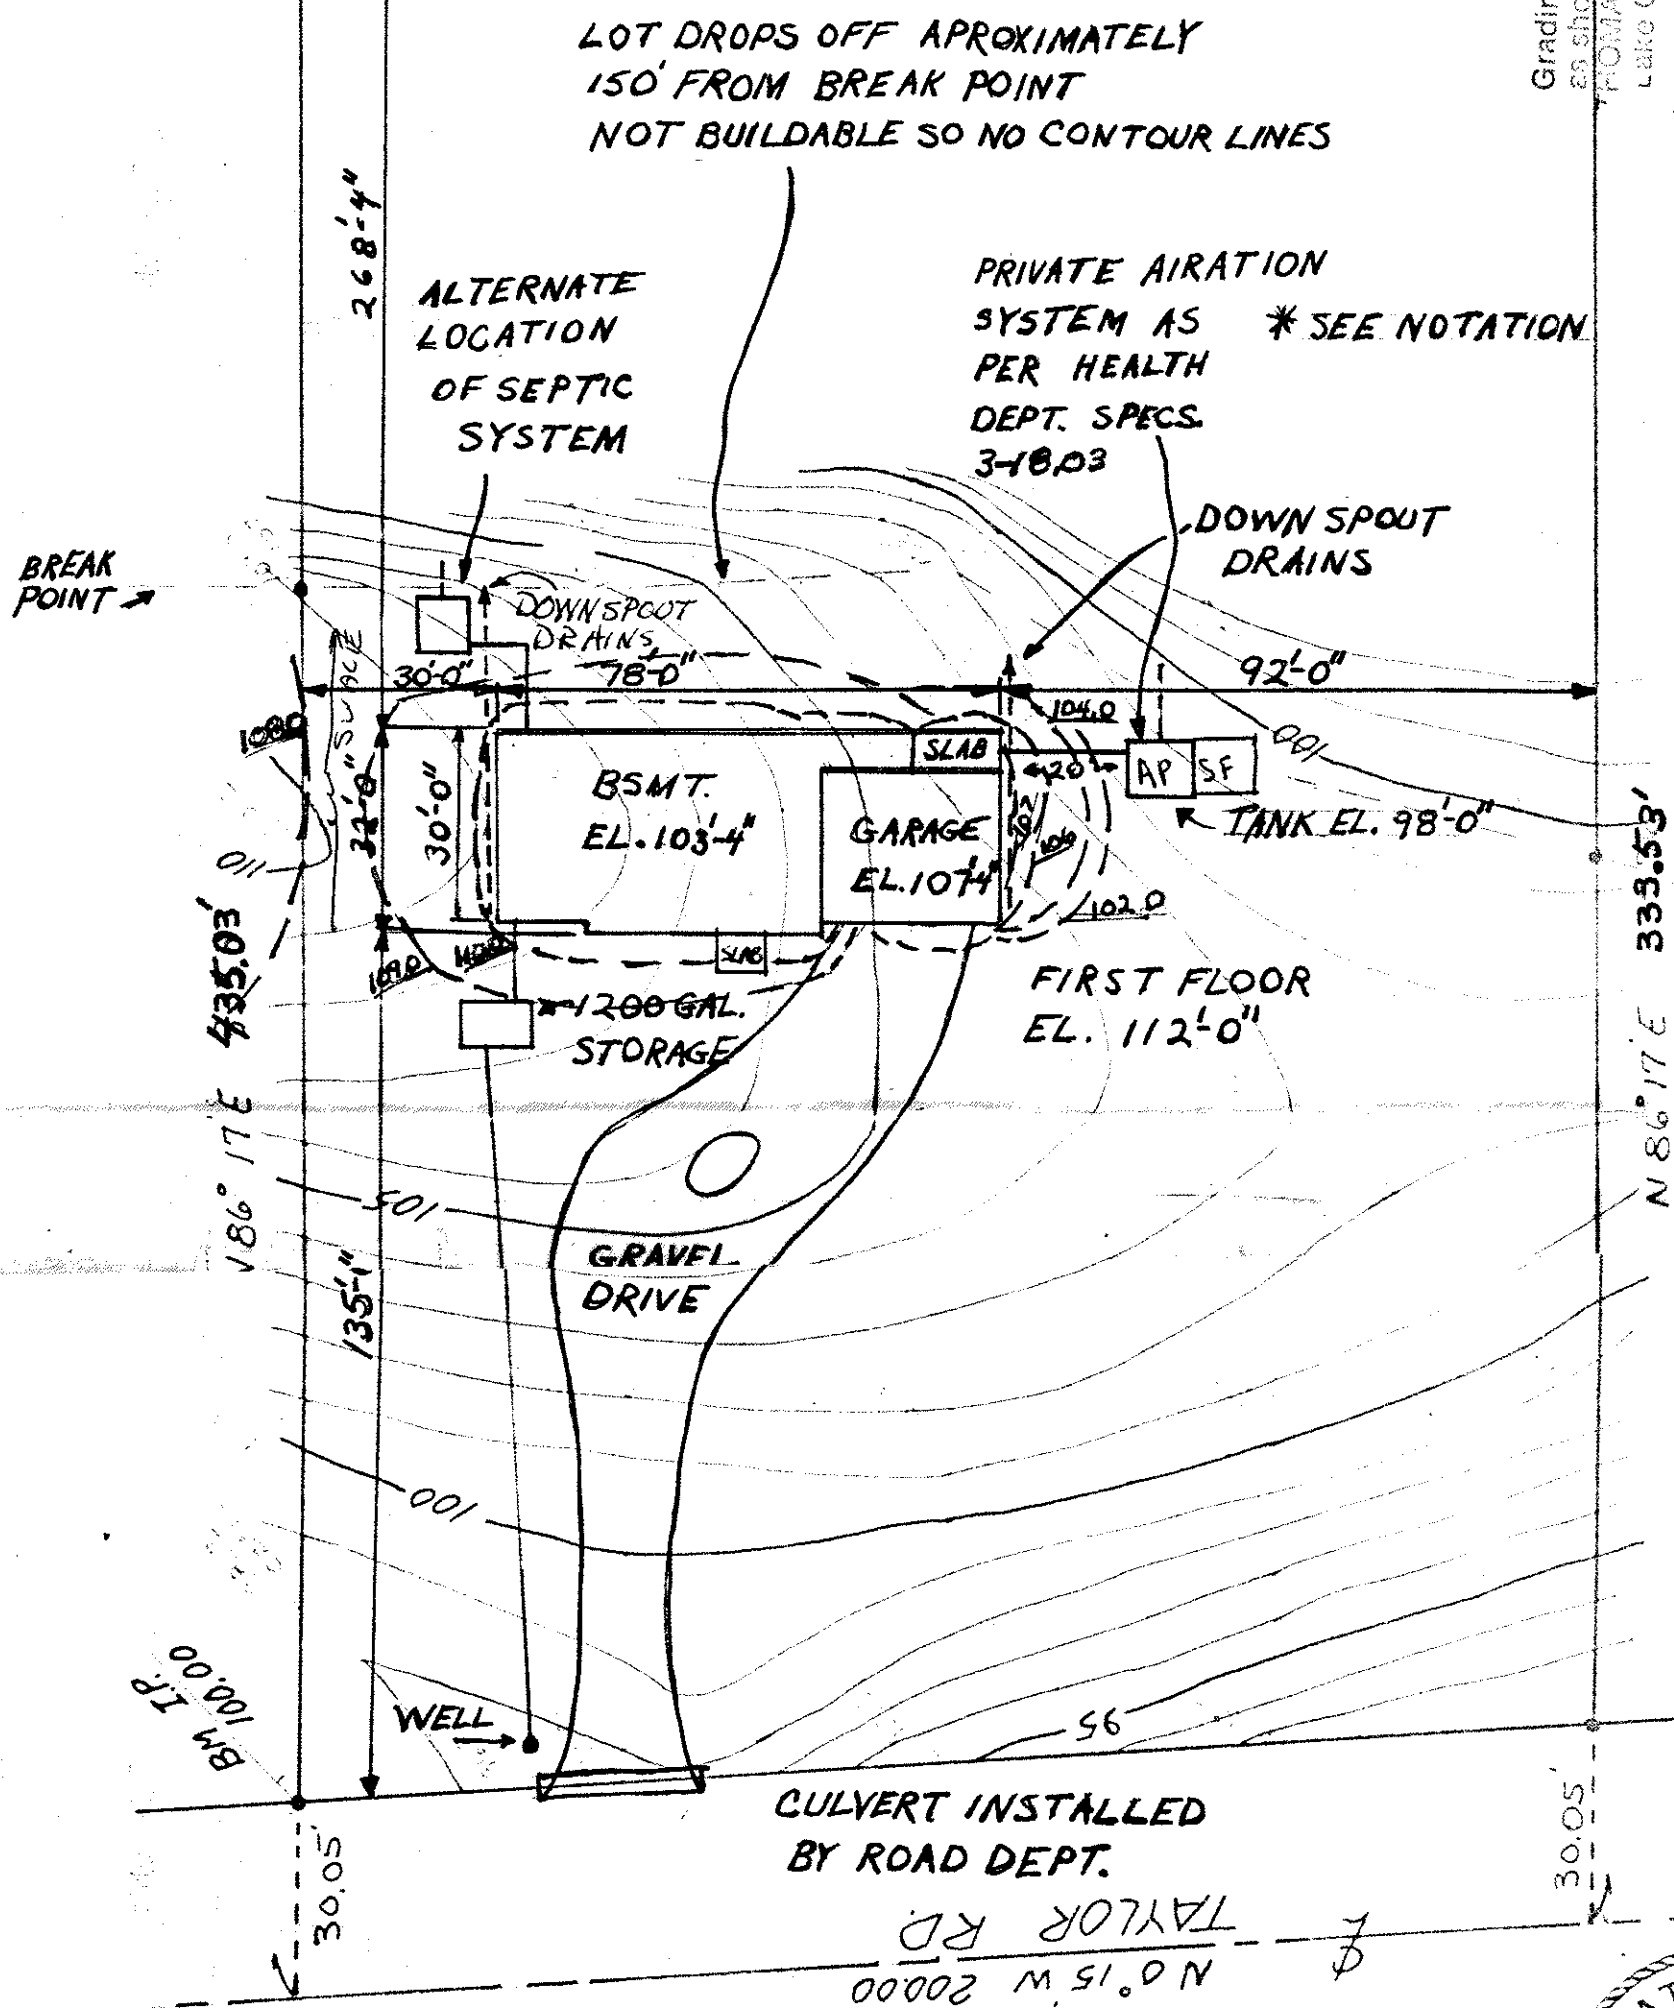

* NOTE
AIRATION SYSTEM SHALL INCL. TRASH TRAP AT
LEAST 20% OF DAILY FLOW. AIRATION COMP.
WITH 500 GAL. MIN. SETTLING COMP. WITH 20%
VOLUME OF AIR COMP. ALSO UPFLOW SAND FILTER
WITH CHLORINATION AND BACKWASH PUMP. DISCHARGING
INTO STREAM AT BACK OF LOT.

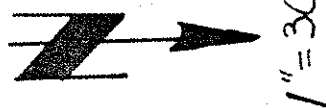

PLOT PLAN
HILLER RESIDENCE
HOUSE NO. 5854

David R. Idempis PEPS.

Grading Plan Approved
as shown and/or noted
THOMAS P. GILLES, P.E.
Lake County Engineer

By 720 Date 16 MAR 84

TOPOGRAPHIC SURVEY

FOR JACK HILLER

BY DAVID R. HOOPS PE P.S. FEB. 1984

REGISTRATION #6515

LEI OY TONG SHIP

Zoning Approved

10362 2-16-80

Zoning Inspector

