

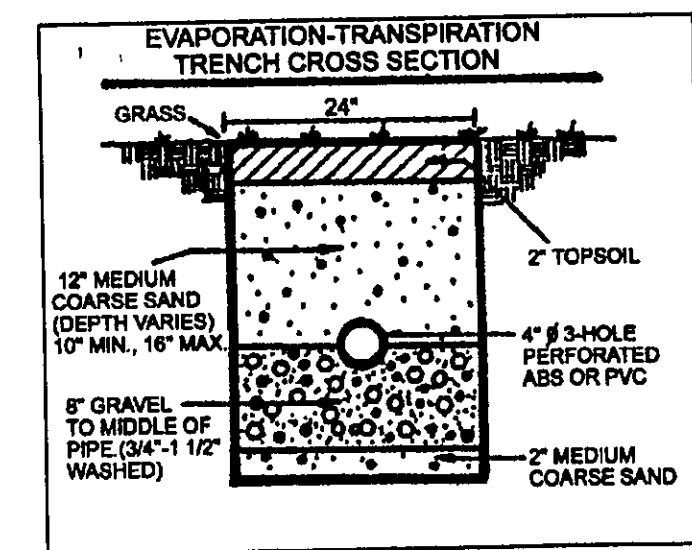


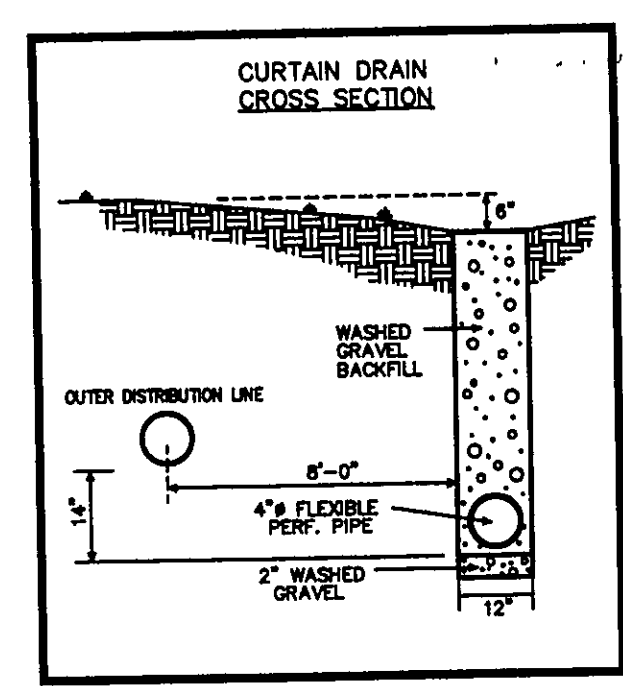

"I, the undersigned hereby certify that this topography indicated by 6", 1", or 2' contours, and elevations shown hereon represent an actual field survey made by me on the 10th day of May, 2000 and that the elevations were taken at appropriate intervals and that as of that date they existed as indicated hereon."

Name Thomas P. Gilles #6343 Reg. No.

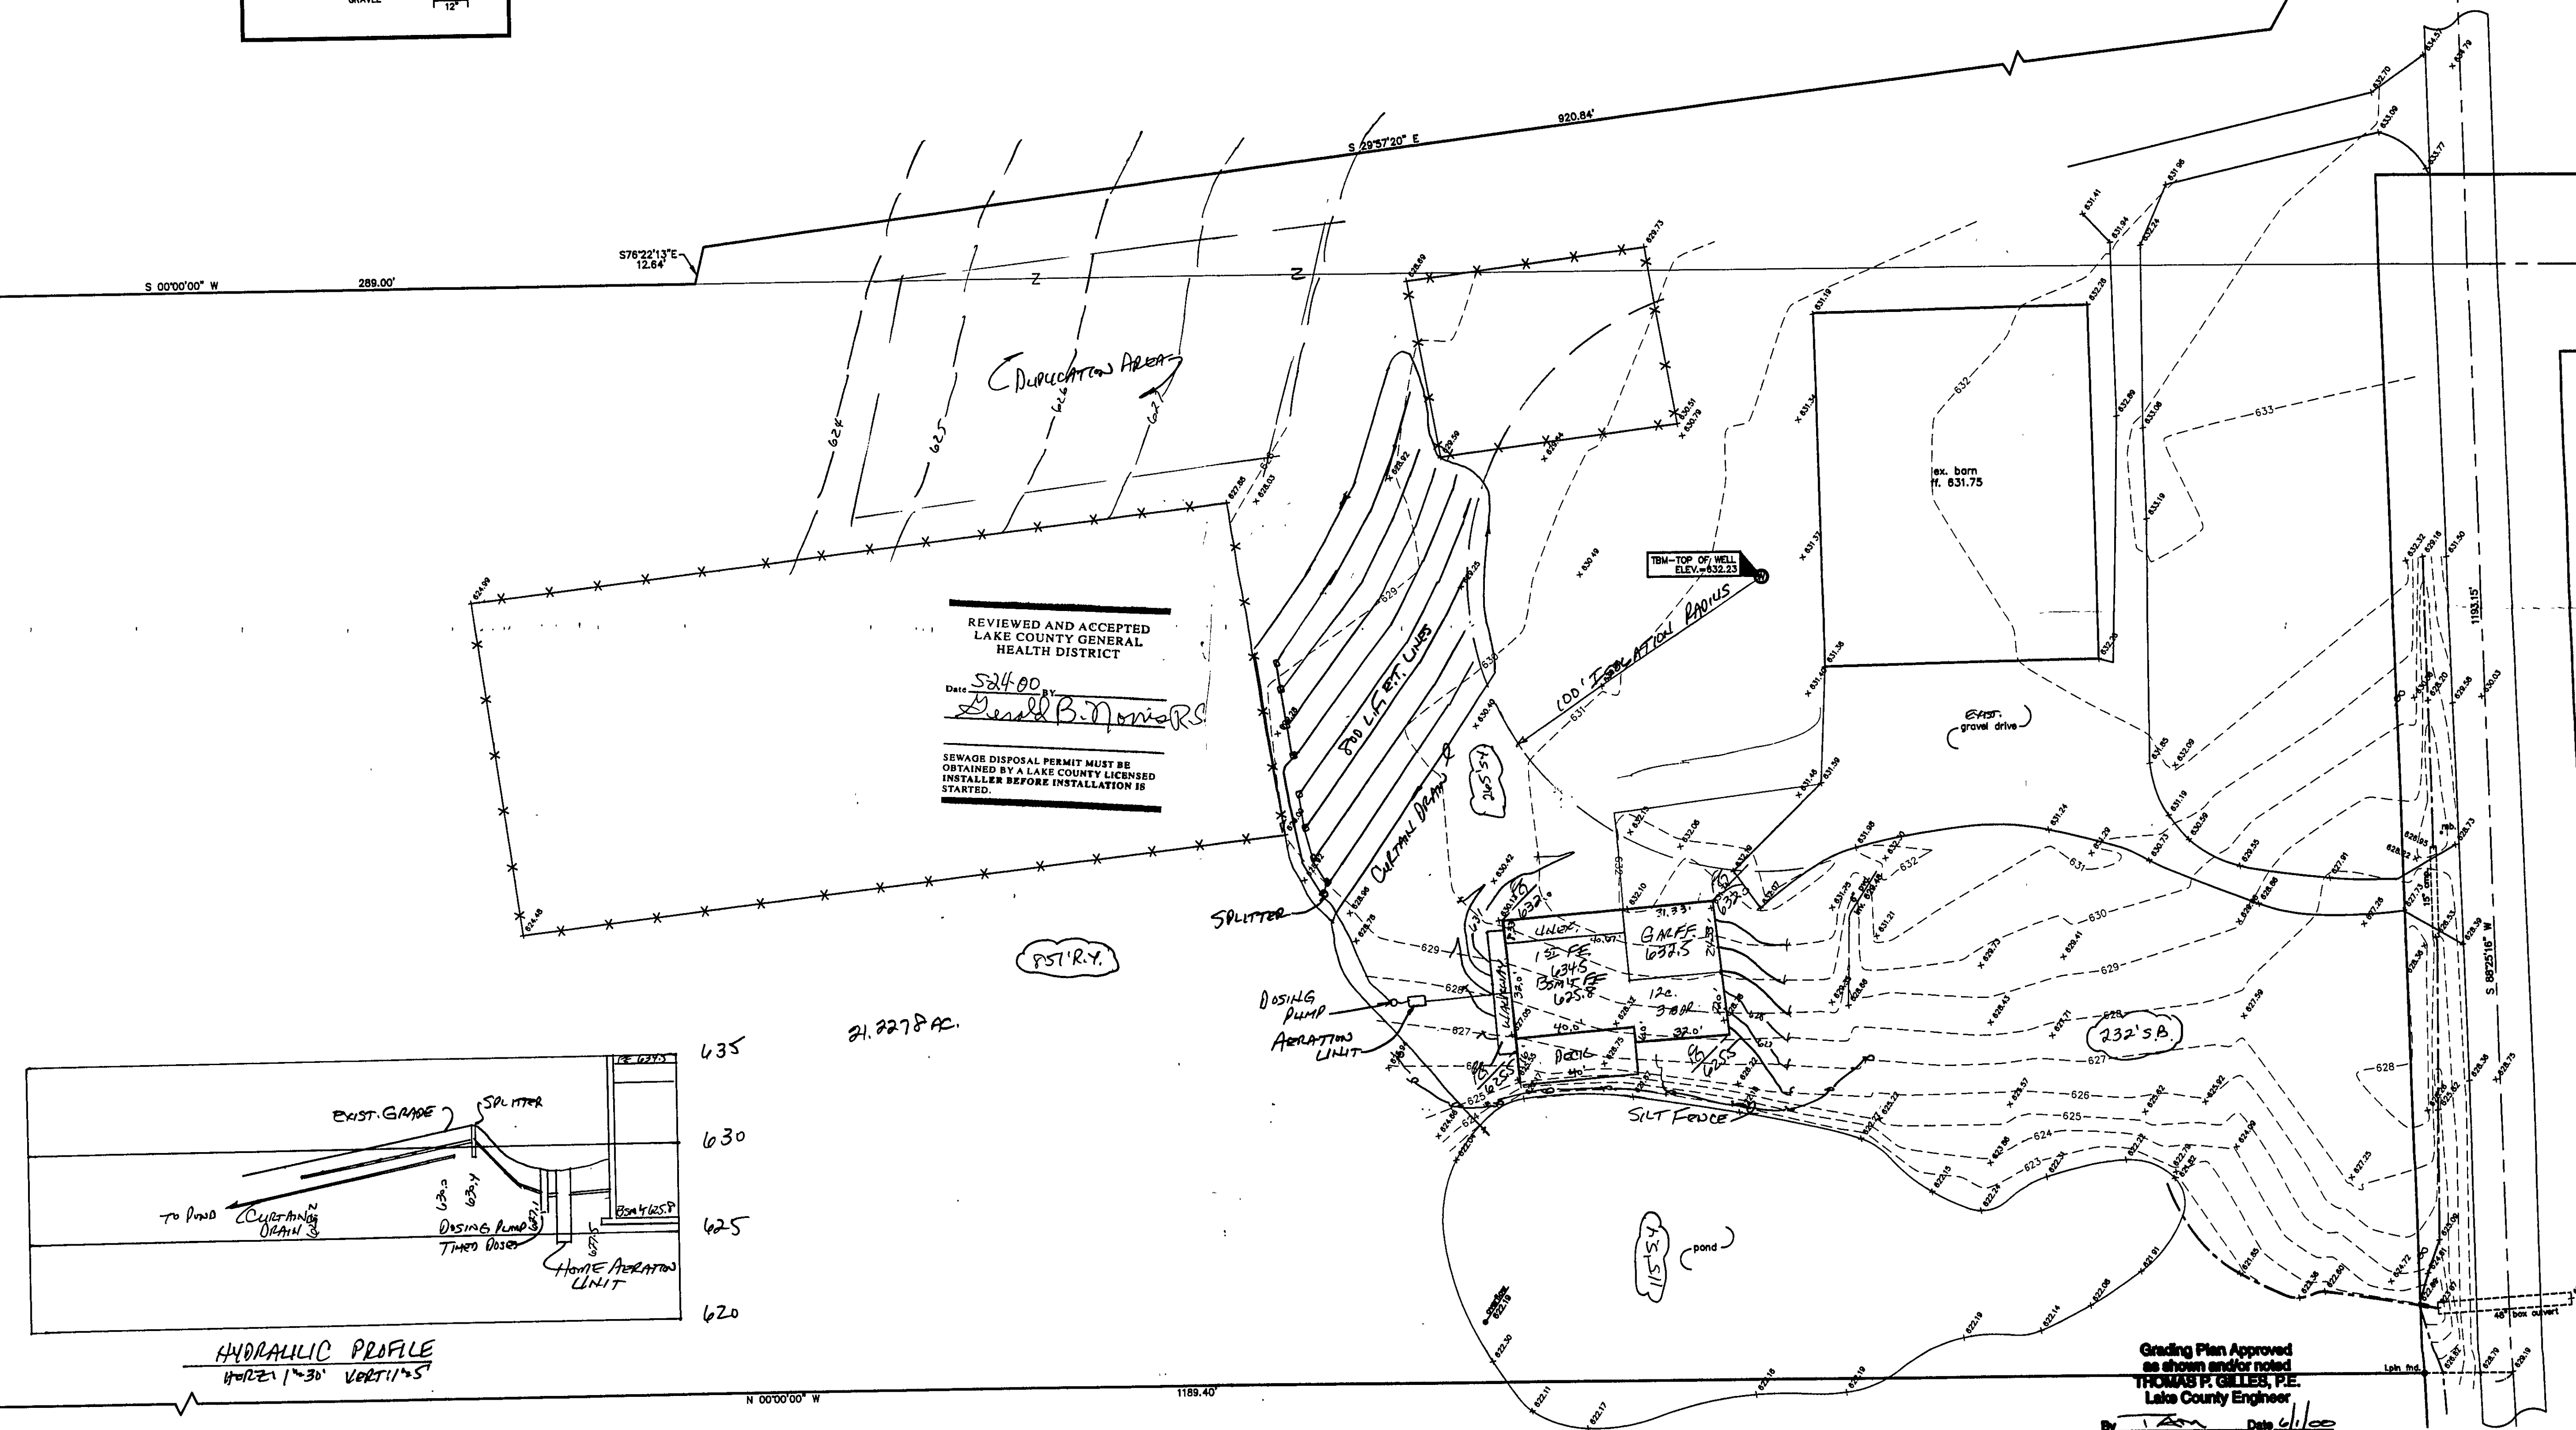

REV. NO.	DESCRIPTION	DATE	BY	CHK'D

bj BABCOCK, JONES AND ASSOCIATES, INC
CIVIL ENGINEERS - SURVEYORS - LAND PLANNERS
PAINESVILLE OHIO 44077

DATE 5/11/00
DESIGN BY H.J.
DRAWN BY T.R.
APPROVED BY H.J.

SITE PLAN
FOR
JACK HILLER
LERoy TOWNSHIP
LAKE COUNTY

SCALE 1"=30'
JOB NO 00-060
SHEET 1 OF 1