




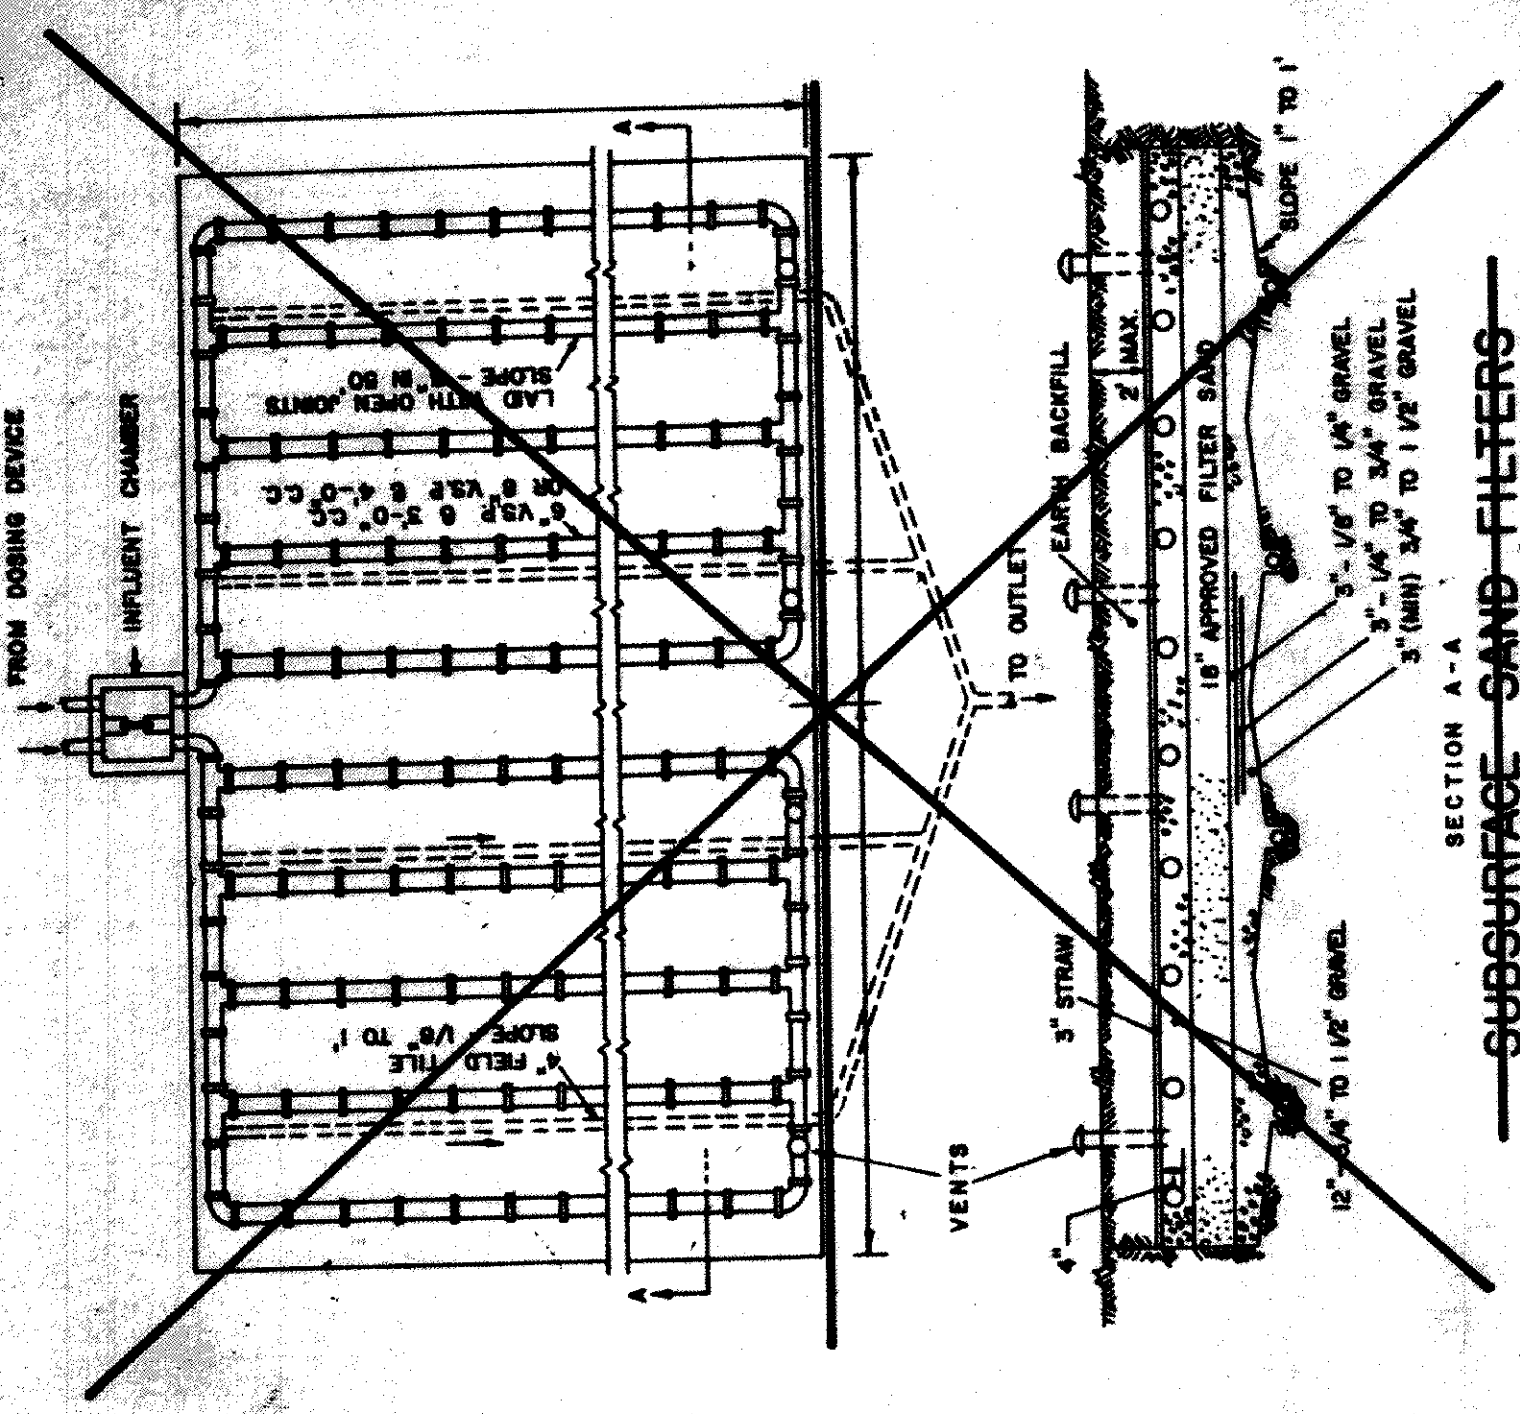


~~SECTION 05 11 00~~
~~SUBSURFACE SAND FILTERS~~

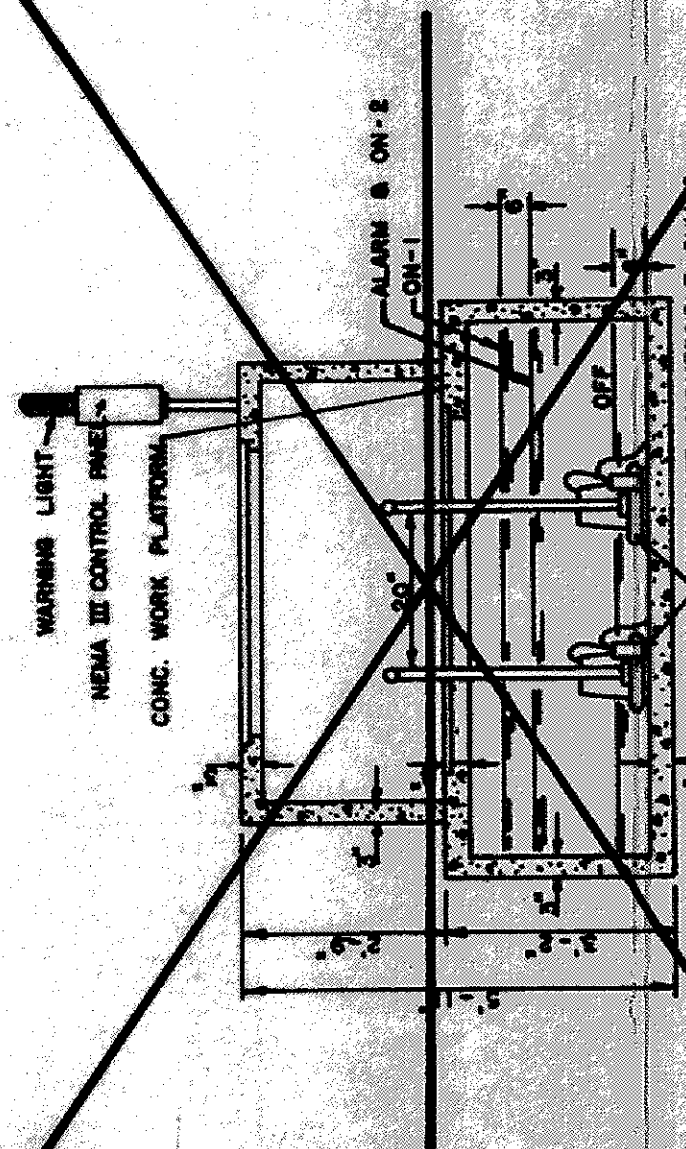

SETTLING TANK

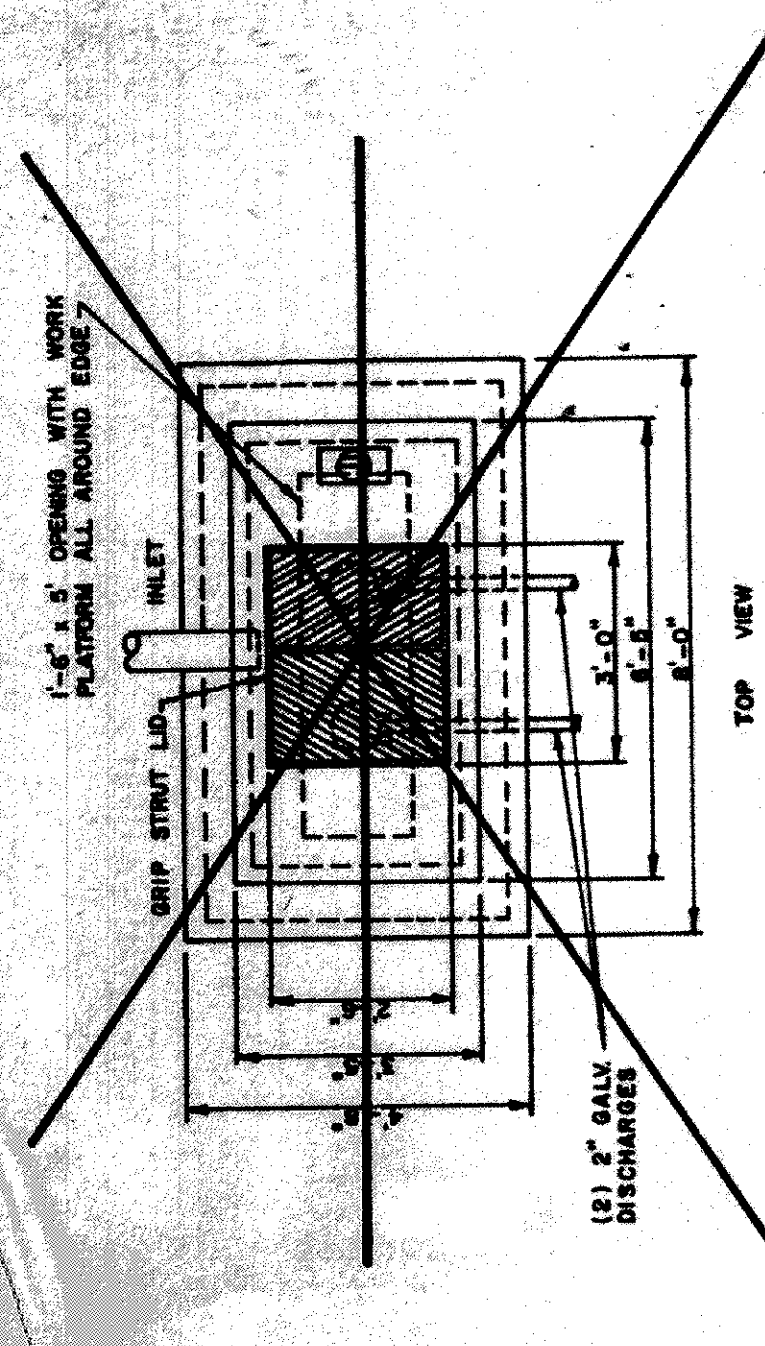


~~POSING DEVICE ALTERNATING PUMPS~~

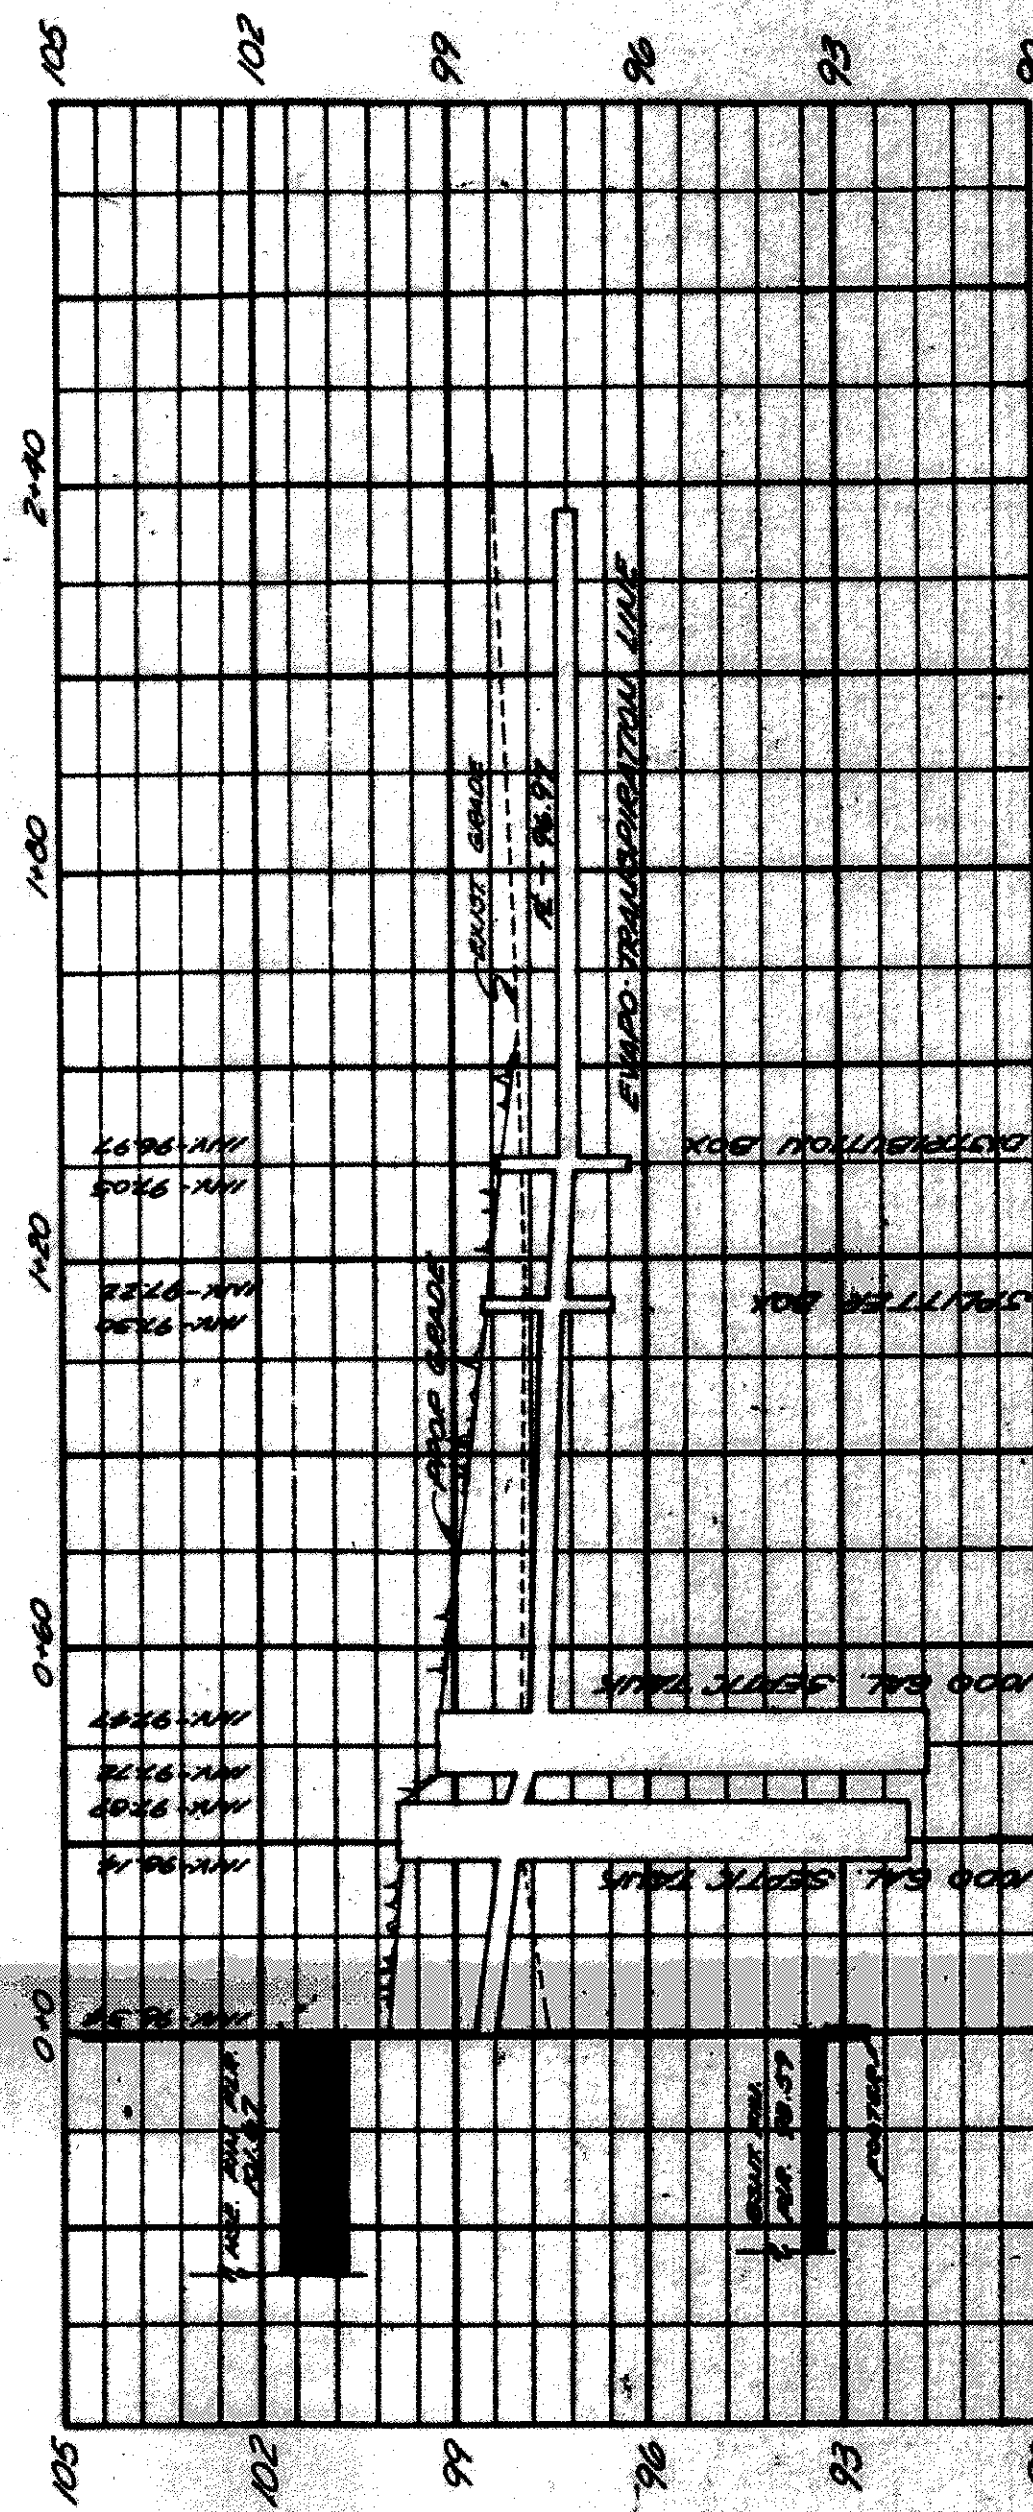

PROFILE

SCALES: VERTICAL 1" = 3' HORIZONTAL 1" = 30'


MIKE LAWRENCE - TAYLOR RD, LEROY

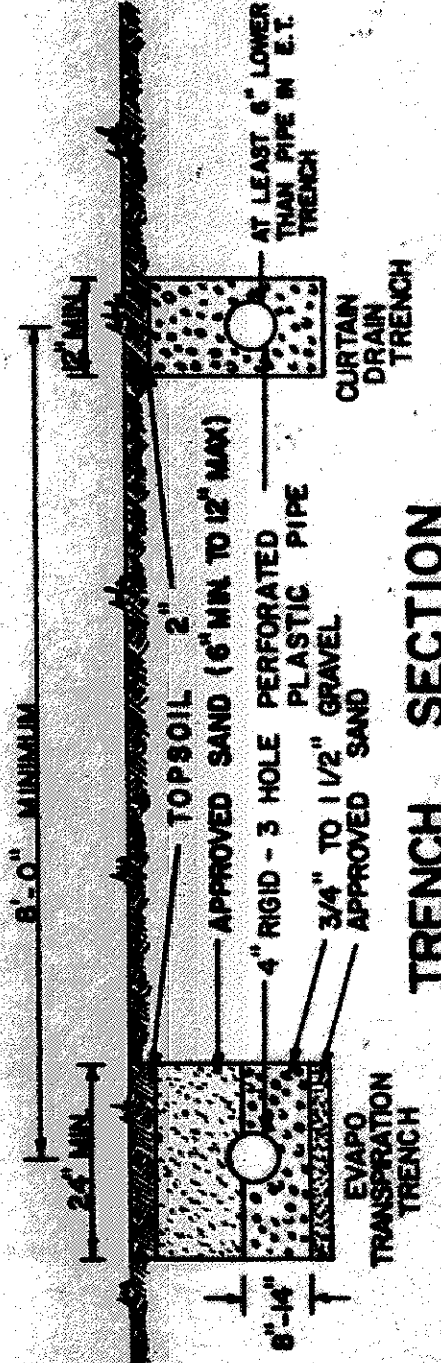

TRENCH SECTION



**DISTRIBUTION
BOX
SECTION**

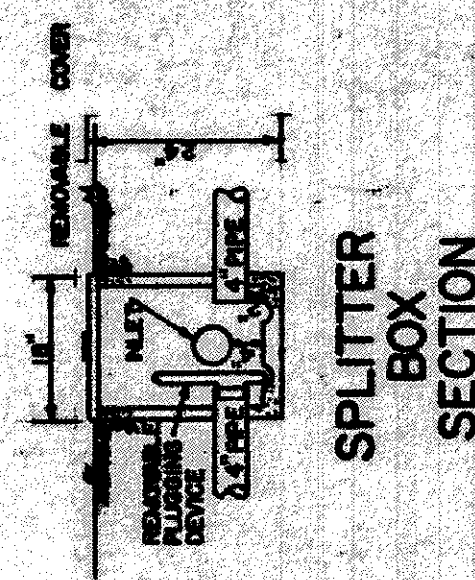

SPLITTER BOX SECTION