

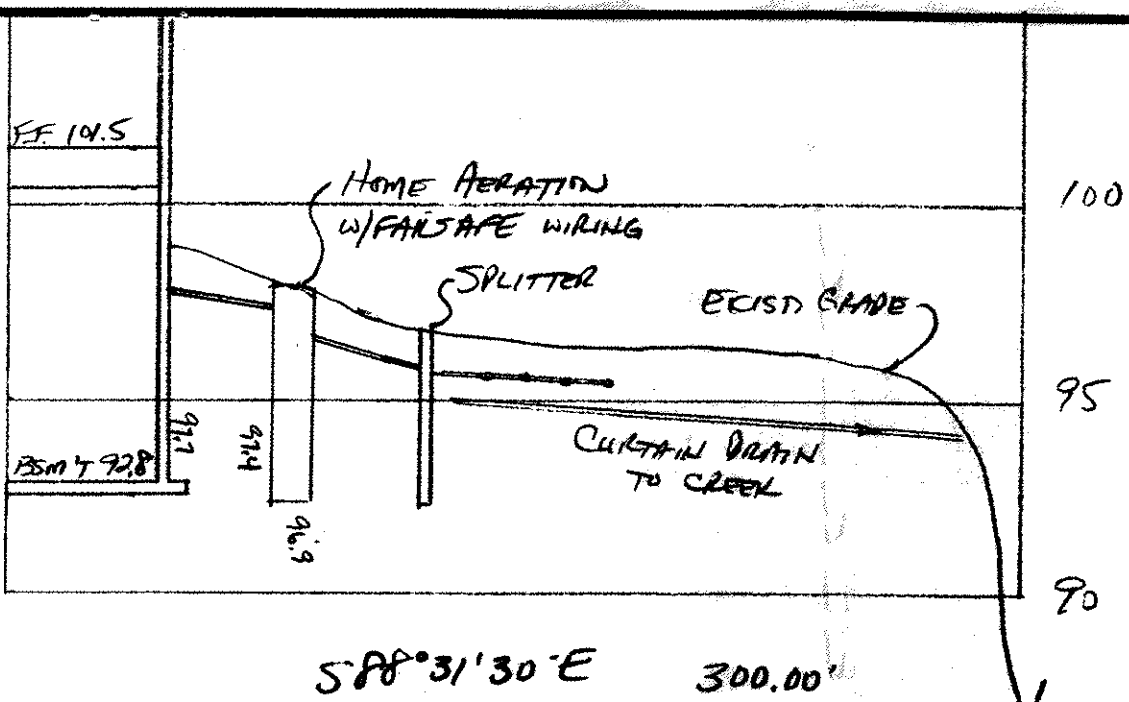
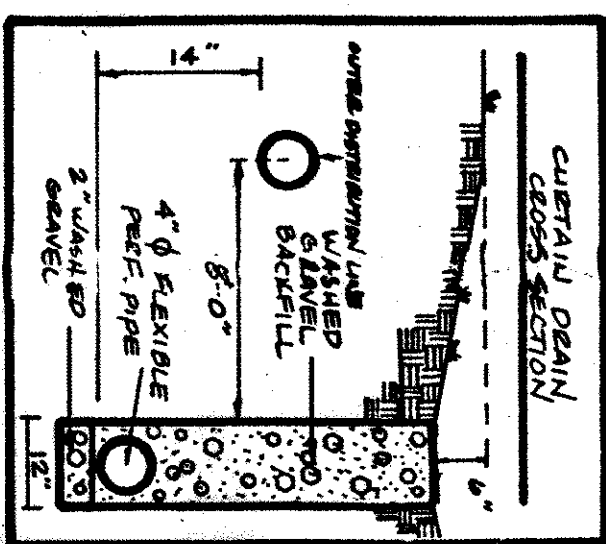
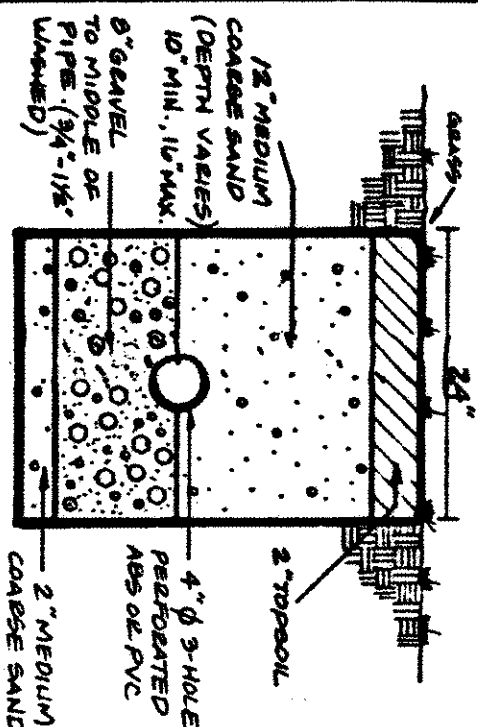


EVAPORATION - TRANSPIRATION
TRENCH CROSS SECTION

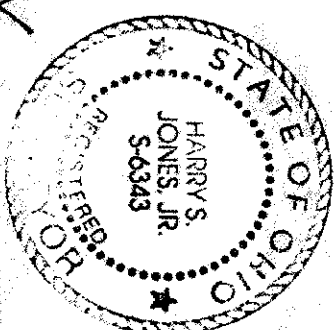

HYDRAULIC PROFILE

Horz: 1'-40"
Vert: 1'-5"

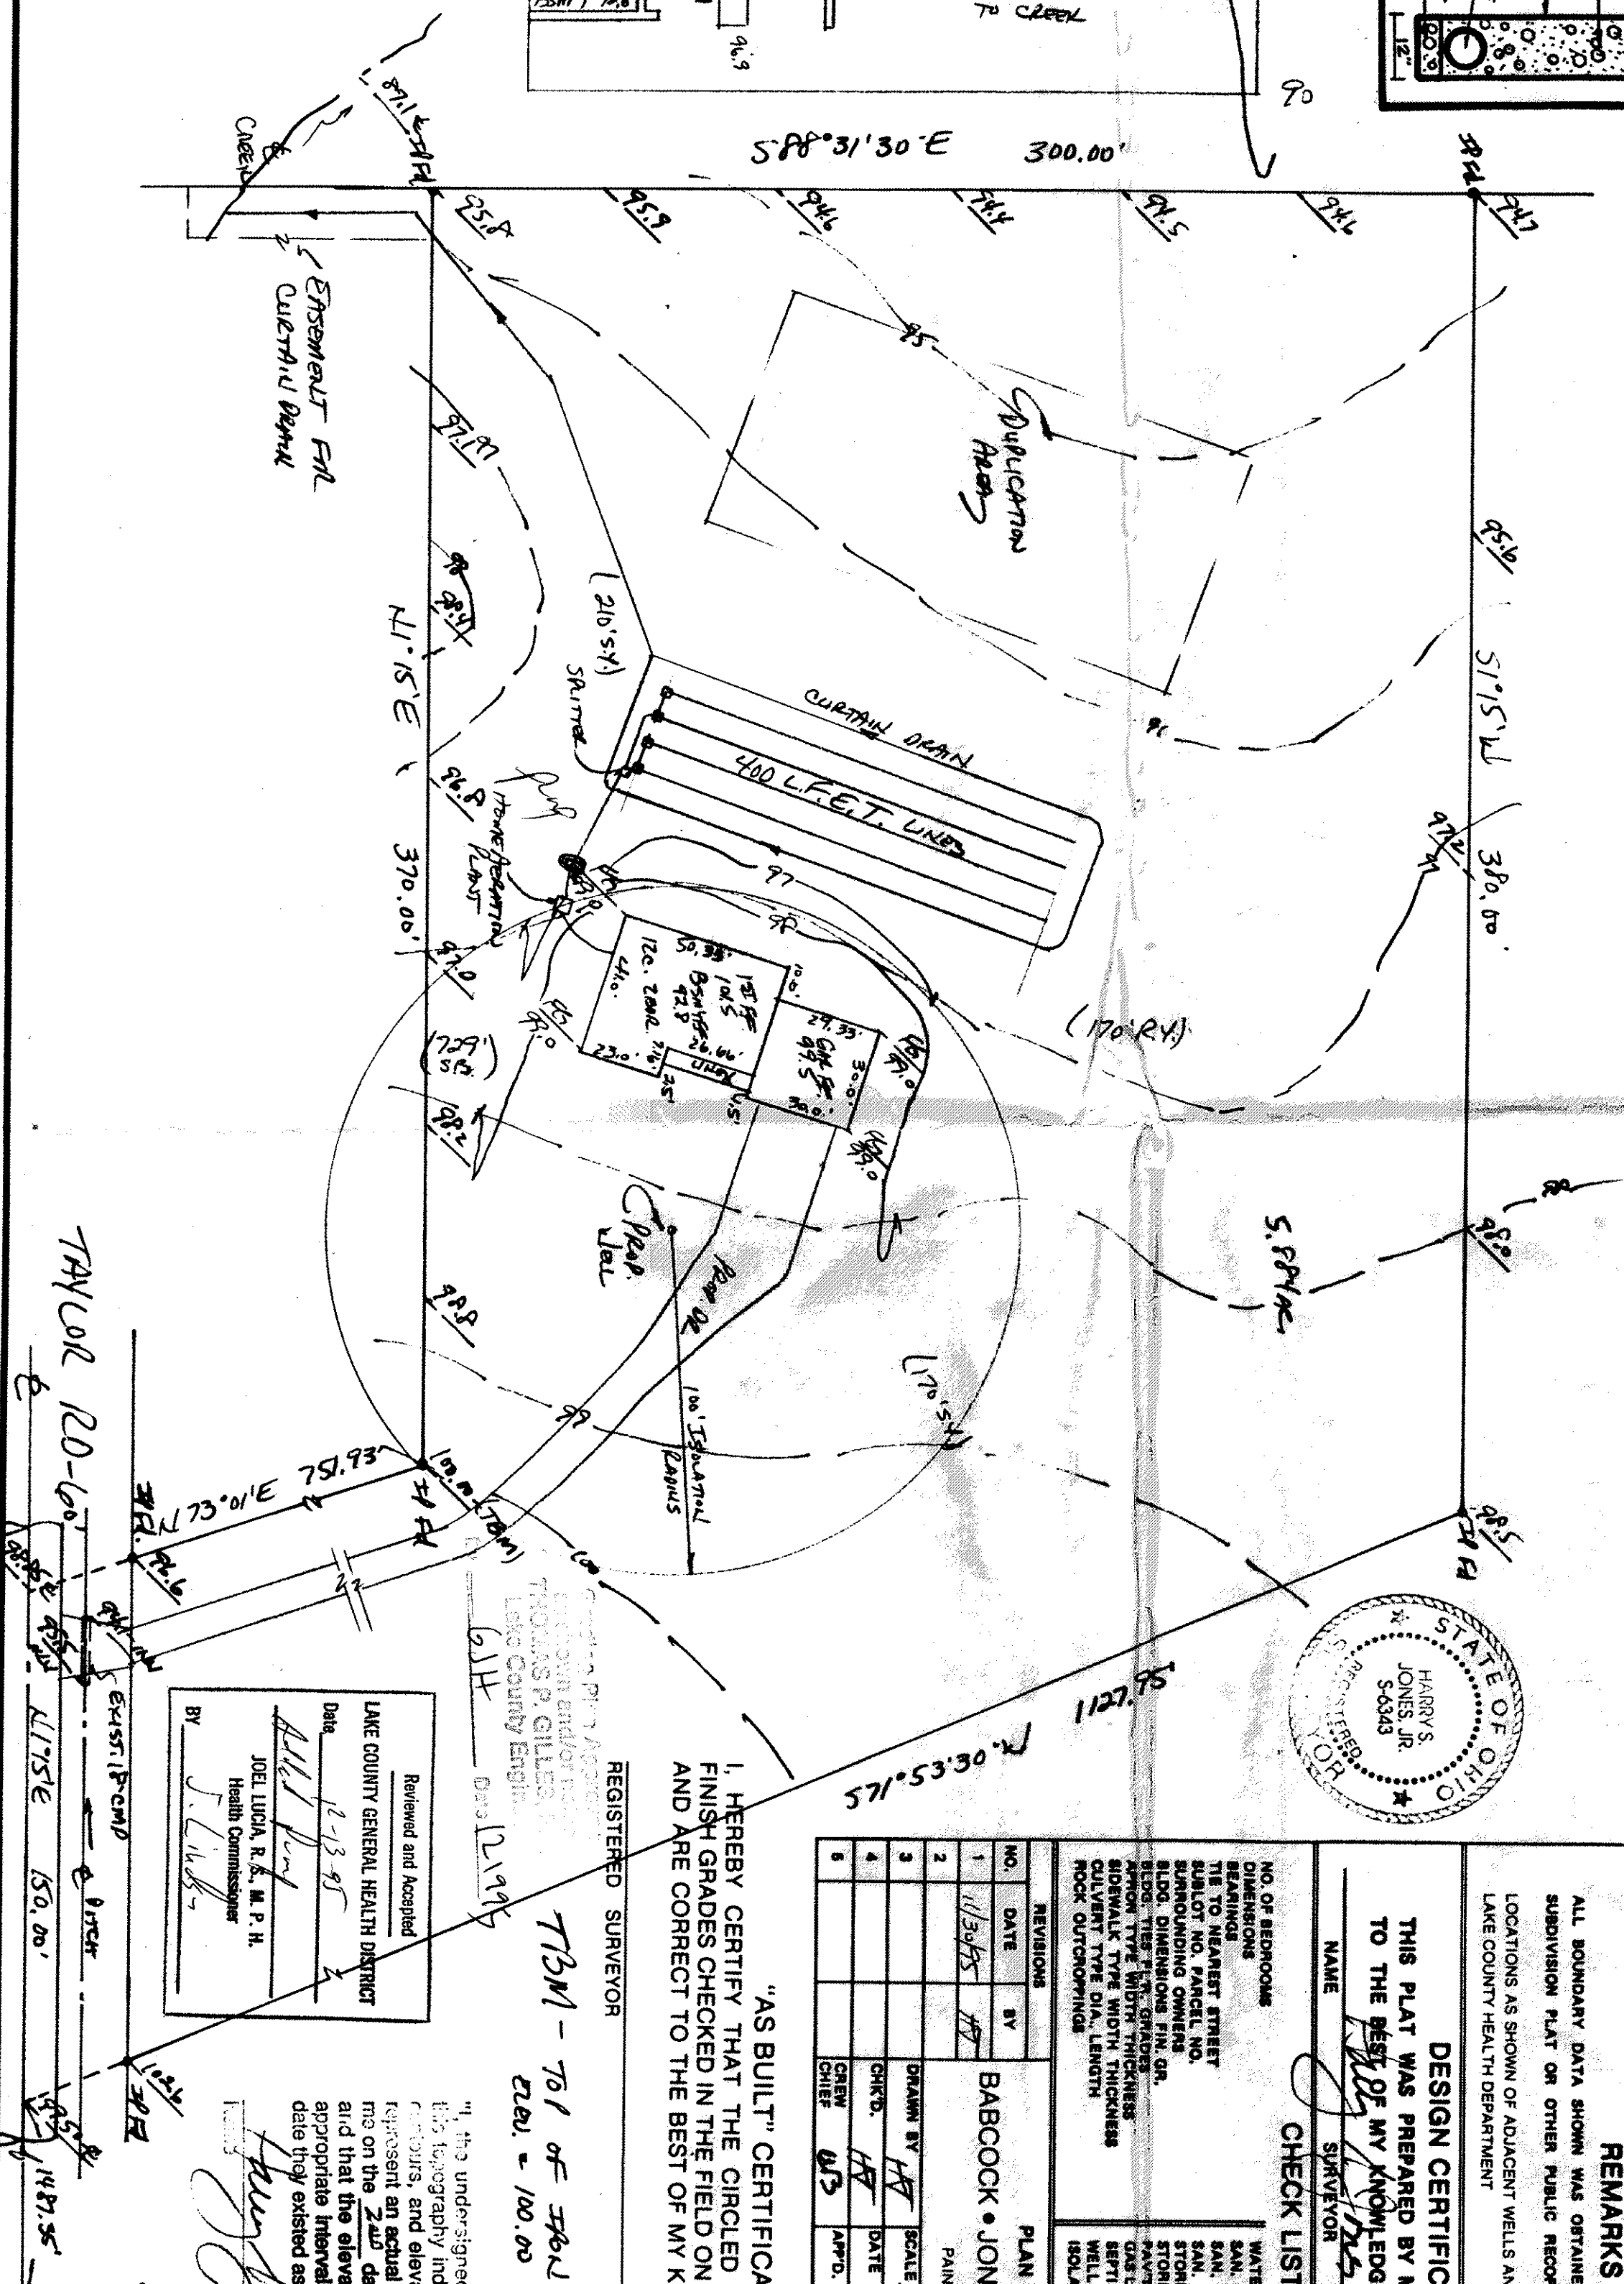

SITE PLAN

LeRoy Township, Lake County, Ohio

for: MAK HUBBA
CLIENT **OWNER**

ADDRESS	STREET	CITY	ZIP
---------	--------	------	-----

SUBDIVISION NAME _____

VOL. - PG.

SUBLOT NO. STREET

VOLUME
74-11-23
PERM. PARCEL NO.

PAGE
74-11-23
STREET

LEGEND

SANITARY	MANHOLE	WATER VALVE (GAS)	100.0
STORM	MANHOLE	WATER METER (GAS)	
INLET OR CATCH BASIN		AS BUILT ELEVATION	
HYDRANT			
EXISTING CONTOURS		INDICATES DIRECTION OF SURFACE DRAINAGE	
PROPOSED CONTOURS			
EXIST. ELEV.	100.0		
	100.0		
	PROP. ELEV.		

REMARKS

ALL BOUNDARY DATA SHOWN WAS OBTAINED FROM (DEEDS, RECORDED
SUBDIVISION PLAT OR OTHER PUBLIC RECORDS)

LOCATIONS AS SHOWN OF ADJACENT WELLS AND SEPTIC TANKS OBTAINED FROM
LAKE COUNTY HEALTH DEPARTMENT

DESIGN CERTIFICATION

THIS PLAT WAS PREPARED BY ME, AND IS CORRECT
TO THE BEST OF MY KNOWLEDGE AND BELIEF.

NAME	SURVEYOR	REGISTRATION	NO.

CHECK LIST

[illegible]

"AS BUILT" CERTIFICATION

I, HEREBY CERTIFY THAT THE CIRCLED GRADES ARE EXISTING
FINISH GRADES CHECKED IN THE FIELD ON _____, 19____
AND ARE CORRECT TO THE BEST OF MY KNOWLEDGE AND BELIEF.

REGISTERED SURVEYOR

REG. NO

713M-701 of F&L Prod

PLAU. - 100.00

Reviewed and Accepted

LAKE COUNTY GENERAL HEALTH DISTRICT

Date 12-13-93 3

Added plum

JOEL LUCIA, R.D., M.P.H.
Health Commissioner

"I, the undersigned hereby certify that the topography indicated by 6", 1" or 2" contours, and elevations shown hereon represent an actual field survey made by me on the 2nd day of Aug, 1972, and that the elevations were taken at appropriate intervals and that as of that date they existed as indicated hereon."

Henry Jones 4343
 Reg. No.

Fig. No.

LeRoy-Center
Road