


HYDRAULIC PROFILE  
HOUSE 11' x 30' VERT 11' x 5'

FORD ROAD

23' x 7' CULVERT

36' rcp

TRASK ROAD - 60'

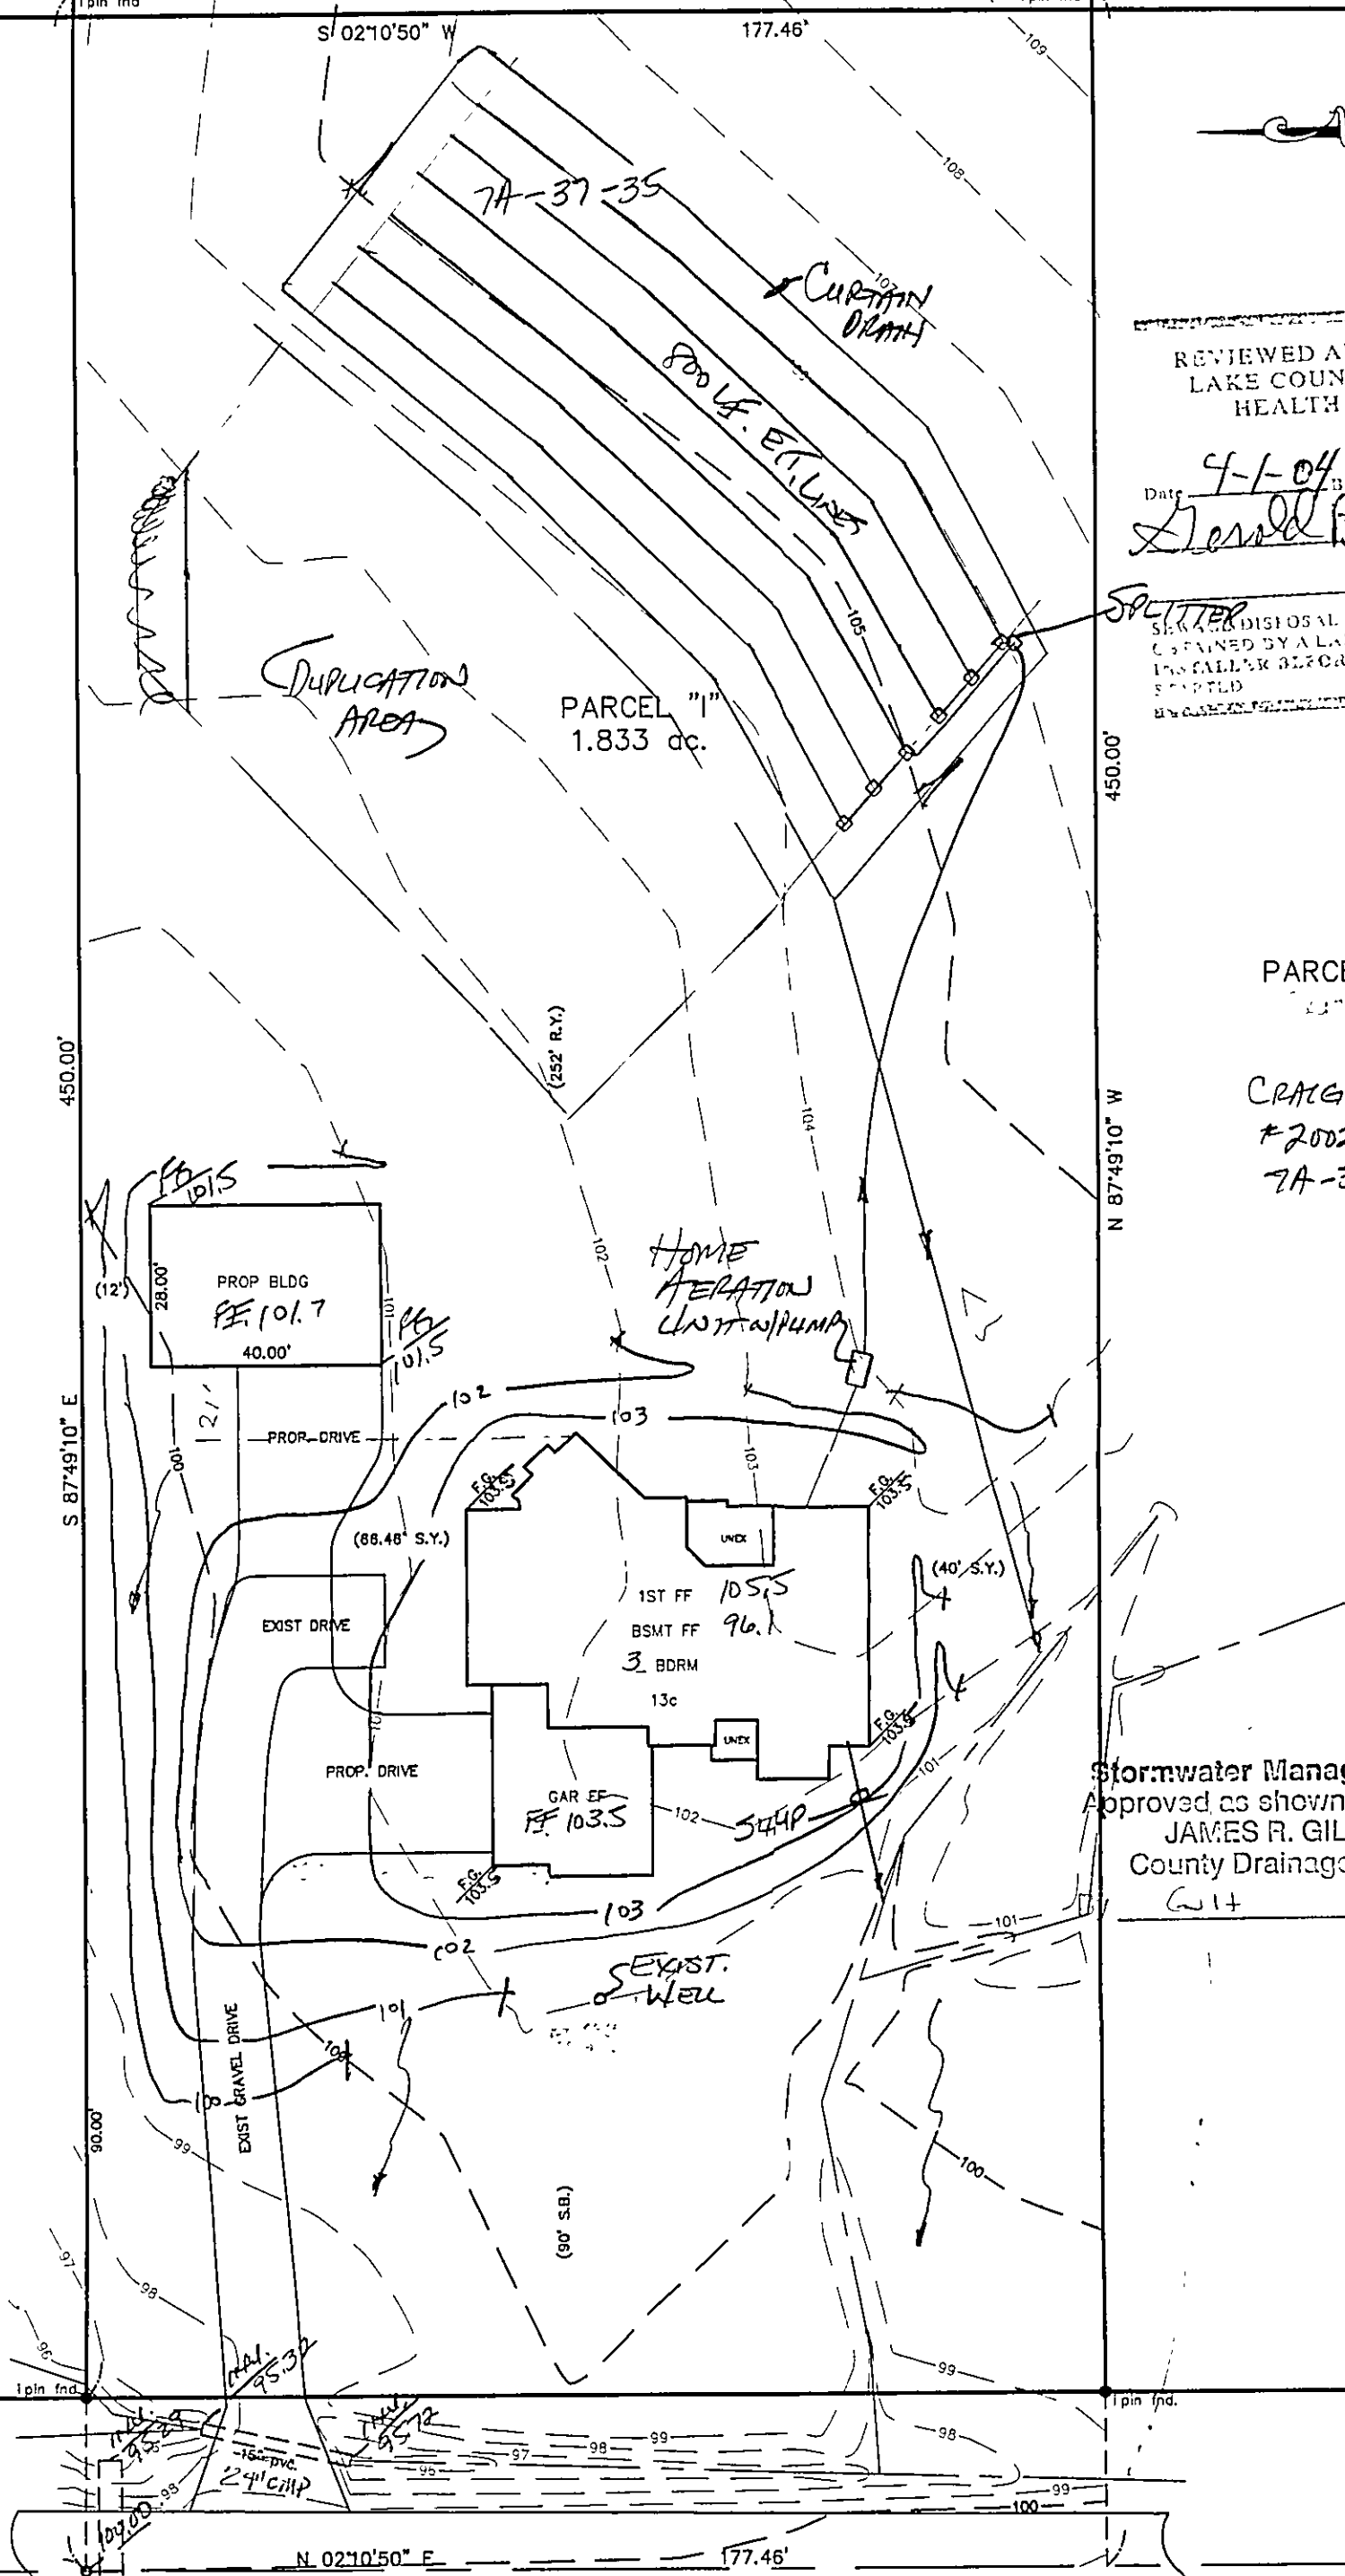

REVIEWED AND ACCEPTED  
LAKE COUNTY GENERAL  
HEALTH DISTRICT

Date: 4-1-04  
Herald B. Novak

SEWER DISPOSAL PERMIT MUST BE  
OBTAINED BY A LAKE COUNTY LICENSED  
INSTALLER BEFORE INSTALLATION IS  
COMPLETED

PARCEL "H"

Craig Young  
#200210263  
7A-37-34

Stormwater Management Plan  
Approved as shown and/or noted  
JAMES R. GILLS, P.E.  
County Drainage Engineer  
G-14 Date: 4/8/04

# SITE PLAN

LEROI TOWNSHIP, LAKE COUNTY, OHIO

for: TIM ROSS

CLIENT: 14425 BALCH ROAD ADDRESS  
OWNER: MADISON CITY 44057 CITY ZIP

SUBDIVISION: VOL.-PG.  
NAME: TRASK RD.  
TRACT: 5559  
LOT: 7A-37-35  
STREET: PERM. PARCEL NO.

## LEGEND

SANITARY MANHOLE  
STORM MANHOLE  
INLET OR CATCH BASIN  
HYDRANT  
EXISTING CONTOURS  
PROPOSED CONTOURS

EXIST. ELEV. 100.0  
100.0 ± 2  
PROP. ELEV. 100.0  
AS BUILT ELEVATION  
INDICATES DIRECTION OF SURFACE DRAINAGE

## REMARKS

ALL BOUNDARY DATA SHOWN WAS OBTAINED FROM (DEEDS, RECORDED  
SUBDIVISION PLAT OR OTHER PUBLIC RECORDS)  
LOCATIONS AS SHOWN OF ADJACENT WELLS AND SEPTIC TANKS OBTAINED FROM  
LAKE COUNTY HEALTH DEPARTMENT

## DESIGN CERTIFICATION

THIS PLAT WAS PREPARED BY ME, AND IS CORRECT  
TO THE BEST OF MY KNOWLEDGE AND BELIEF.

NAME: Harry Jones #6343  
SURVEYOR: REGISTRATION NO.

## CHECK LIST

NO. OF BEDROOMS  
DIMENSIONS  
BEARINGS  
TIE TO NEAREST STREET  
SUBLOT NO. PARCEL NO.  
SURROUNDING OWNERS  
BLDG. DIMENSIONS FIN GR.  
BLDG. TIES FL'R. GRADES  
APRON TYPE WIDTH THICKNESS  
SIDEWALK TYPE WIDTH THICKNESS  
CULVERT TYPE DIA. LENGTH  
ROCK OUTCROPPINGS

WATER MAIN SIZE, LOCATION  
SAN. SEWER SIZE & GR. LOC.  
SAN. MH. CAST. ELEV. INV. ELEV.  
SAN. CONN. SIZE, LOC. DEPTH  
STORM SEWER SIZE & GR. LOC.  
STORM MH. CAST. ELEV. INV. ELEV.  
PAVT TYPE GRADE CURES  
GAS LINE LOC. SIZE PRESSURE  
SEPTIC TANK LOCATION & DUPLICATION AREA  
WELL LOCATION  
ISOLATION RADIUS FROM WELL

NO.	DATE	BY
1	2/23/04	B.P.
2		
3		
4		
5		

PLAN PREPARED BY:  
BABCOCK JONES & ASSOCIATES, INC.  
PAINESVILLE, OHIO

DRAWN BY: T.R.  
SCALE: 1" = 30'  
PHONE NO.: 440-357-1811  
CHK'D: H.J.  
DATE: 4/12/99  
DRAWING NO.: 98-188-I  
CREW CHIEF: W.B.  
APP'D: H.J.

## "AS BUILT" CERTIFICATION

I, HEREBY CERTIFY THAT THE CIRCLED GRADES ARE EXISTING  
FINISH GRADES CHECKED IN THE FIELD ON 4/12/99  
AND ARE CORRECT TO THE BEST OF MY KNOWLEDGE AND BELIEF.

REGISTERED SURVEYOR

REG. NO.

TBM-PK SET @ CENTERLINE  
ELEV. = 100.00

"I, the undersigned hereby certify that  
this topography indicated by 6", 1", or 2"  
contours, and elevations shown hereon  
represent an actual field survey made by  
me on the 12th day of APRIL, 1999  
and that the elevations were taken at  
appropriate intervals and that as of that  
date they existed as indicated hereon."

Harry Jones #6343  
Name: Reg. No.

