

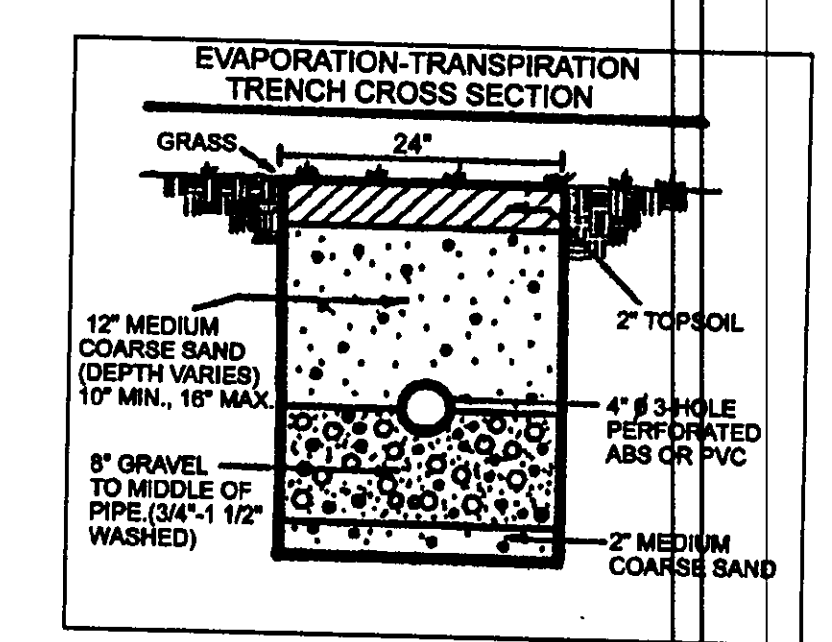
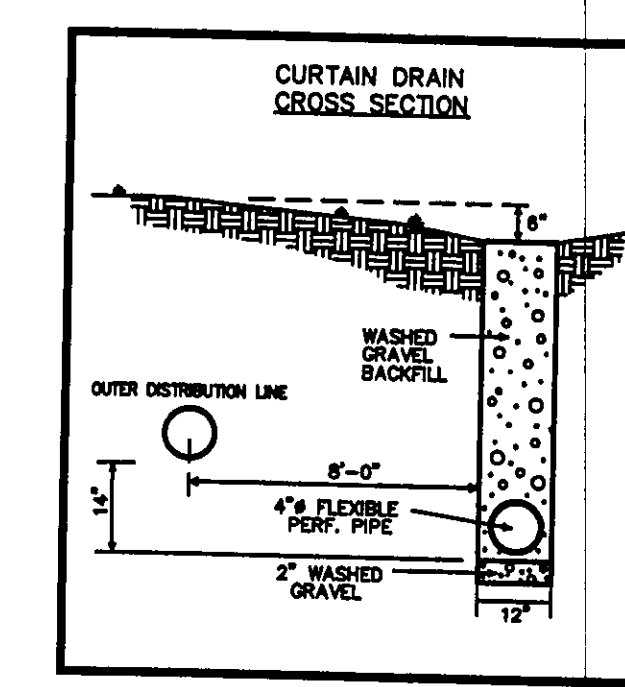


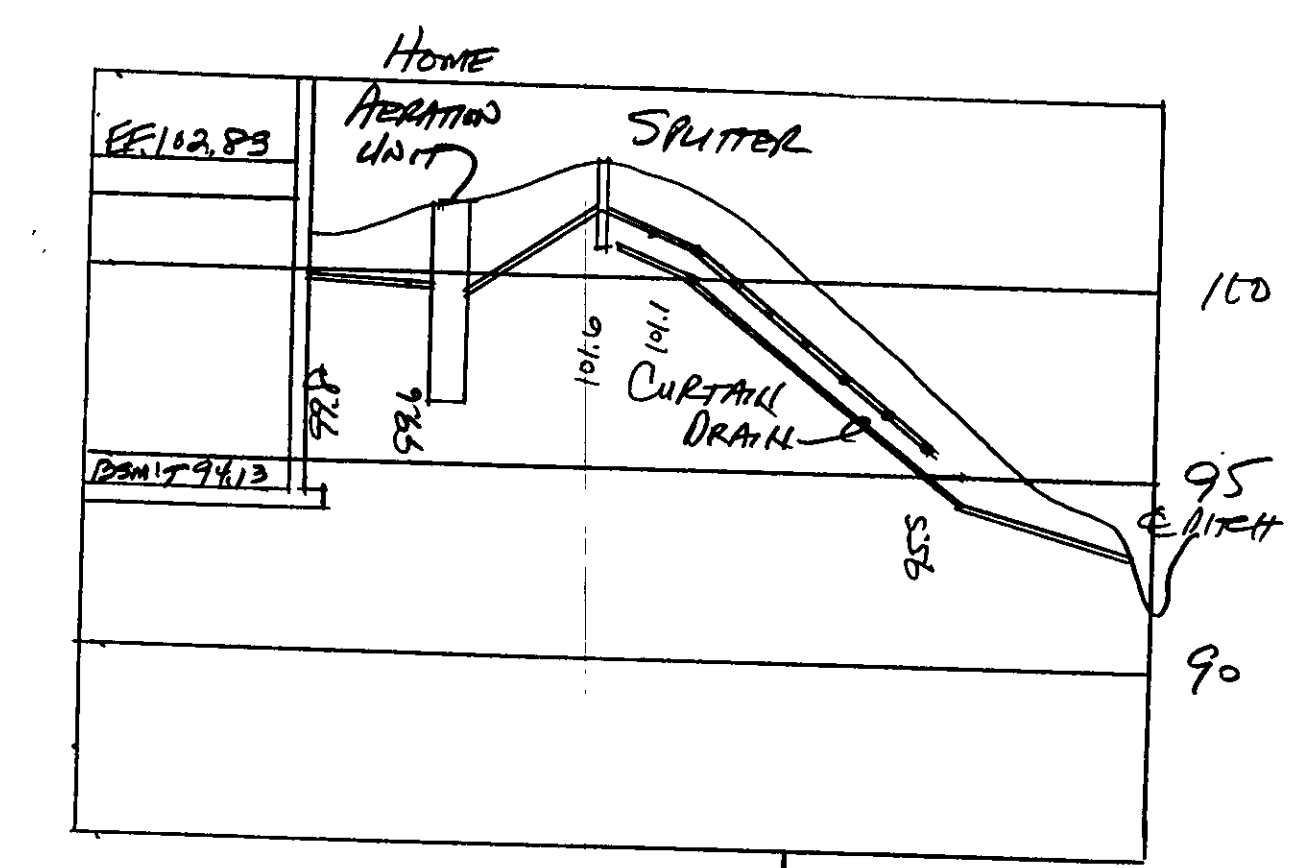

REVIEWED AND ACCEPTED  
LAKE COUNTY GENERAL  
HEALTH DISTRICT

Date: 9-15-03  
Jared B. Morris

SEWAGE DISPOSAL PERMIT MUST BE  
OBTAINED BY A LAKE COUNTY LICENSED  
INSTALLER BEFORE INSTALLATION IS  
STARTED.

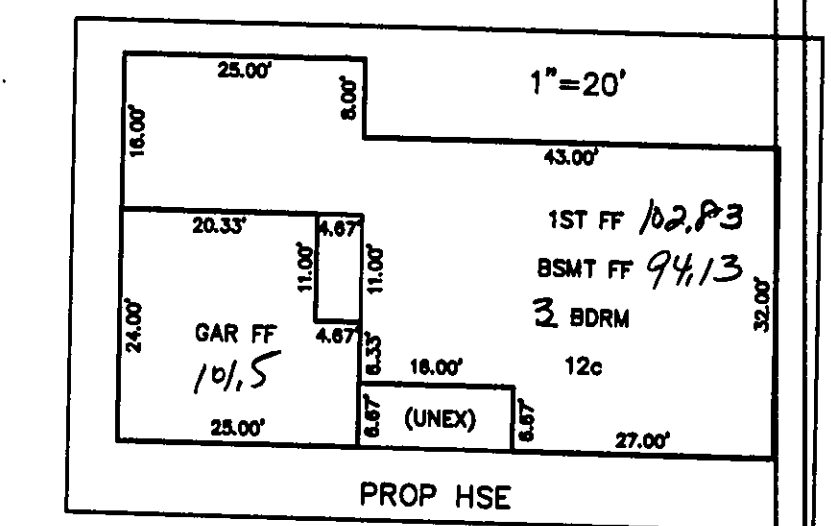

HYDRAULIC PROFILE  
HORIZ: 1"=20' VERT: 1"=5'

Grading Plan Approved  
as shown and/or noted  
JAMES R. GILLS, P.E.  
Lake County Engineer

By: J.H. Date: 9/16/03

"I, the undersigned hereby certify that  
this topography indicated by 6", 1", or 2"  
contours, and elevations shown hereon  
represent an actual field survey made by  
me on the 11th day of SEP, 2003  
and that the elevations were taken at  
appropriate intervals and that as of that  
date they existed as indicated hereon."

James R. Gills  
Name: Reg. No. 46313

NOTE: ALL IRON PINS SET ARE  
3/8" X 30" AND ARE CAPPED  
BABCOCK JONES & ASSOC.

EXISTING UTILITIES NOTE:  
THE SIZE AND LOCATION, BOTH HORIZONTAL AND VERTICAL  
OF THE UNDERGROUND UTILITIES SHOWN HEREON, HAVE BEEN  
OBTAINED BY A SEARCH OF AVAILABLE RECORDS.  
VERIFICATION BY FIELD OBSERVATION HAS BEEN CONDUCTED  
WHERE PRACTICAL, HOWEVER, BABCOCK, JONES AND ASSOCIATES  
INC. DOES NOT GUARANTEE THE COMPLETENESS NOR ACCURACY  
THEREOF.

TBM - IRON PIN SET - SOUTH  
EASTERLY CORNER OF LOT  
ELEV - 100.00

| REV. NO. | DESCRIPTION | DATE | BY | CHK'D |
|----------|-------------|------|----|-------|
|          |             |      |    |       |
|          |             |      |    |       |
|          |             |      |    |       |
|          |             |      |    |       |

TRASK ROAD - 60'

**bj** BABCOCK, JONES AND ASSOCIATES, INC  
CIVIL ENGINEERS - SURVEYORS - LAND PLANNERS  
PAINESVILLE OHIO 44077

DATE 9/17/03  
DESIGN BY H.J.  
DRAWN BY B.P.  
APPROVED BY H.J.  
CREW CHIEF W.B.

SITE PLAN  
FOR  
LEHTONEN BUILDING

5610 TRASK ROAD / PP# 74-37-4  
LAKE COUNTY STATE OF OHIO



SCALE 1"=20'  
JOB NO. 03-209  
SHEET 1 OF 1