
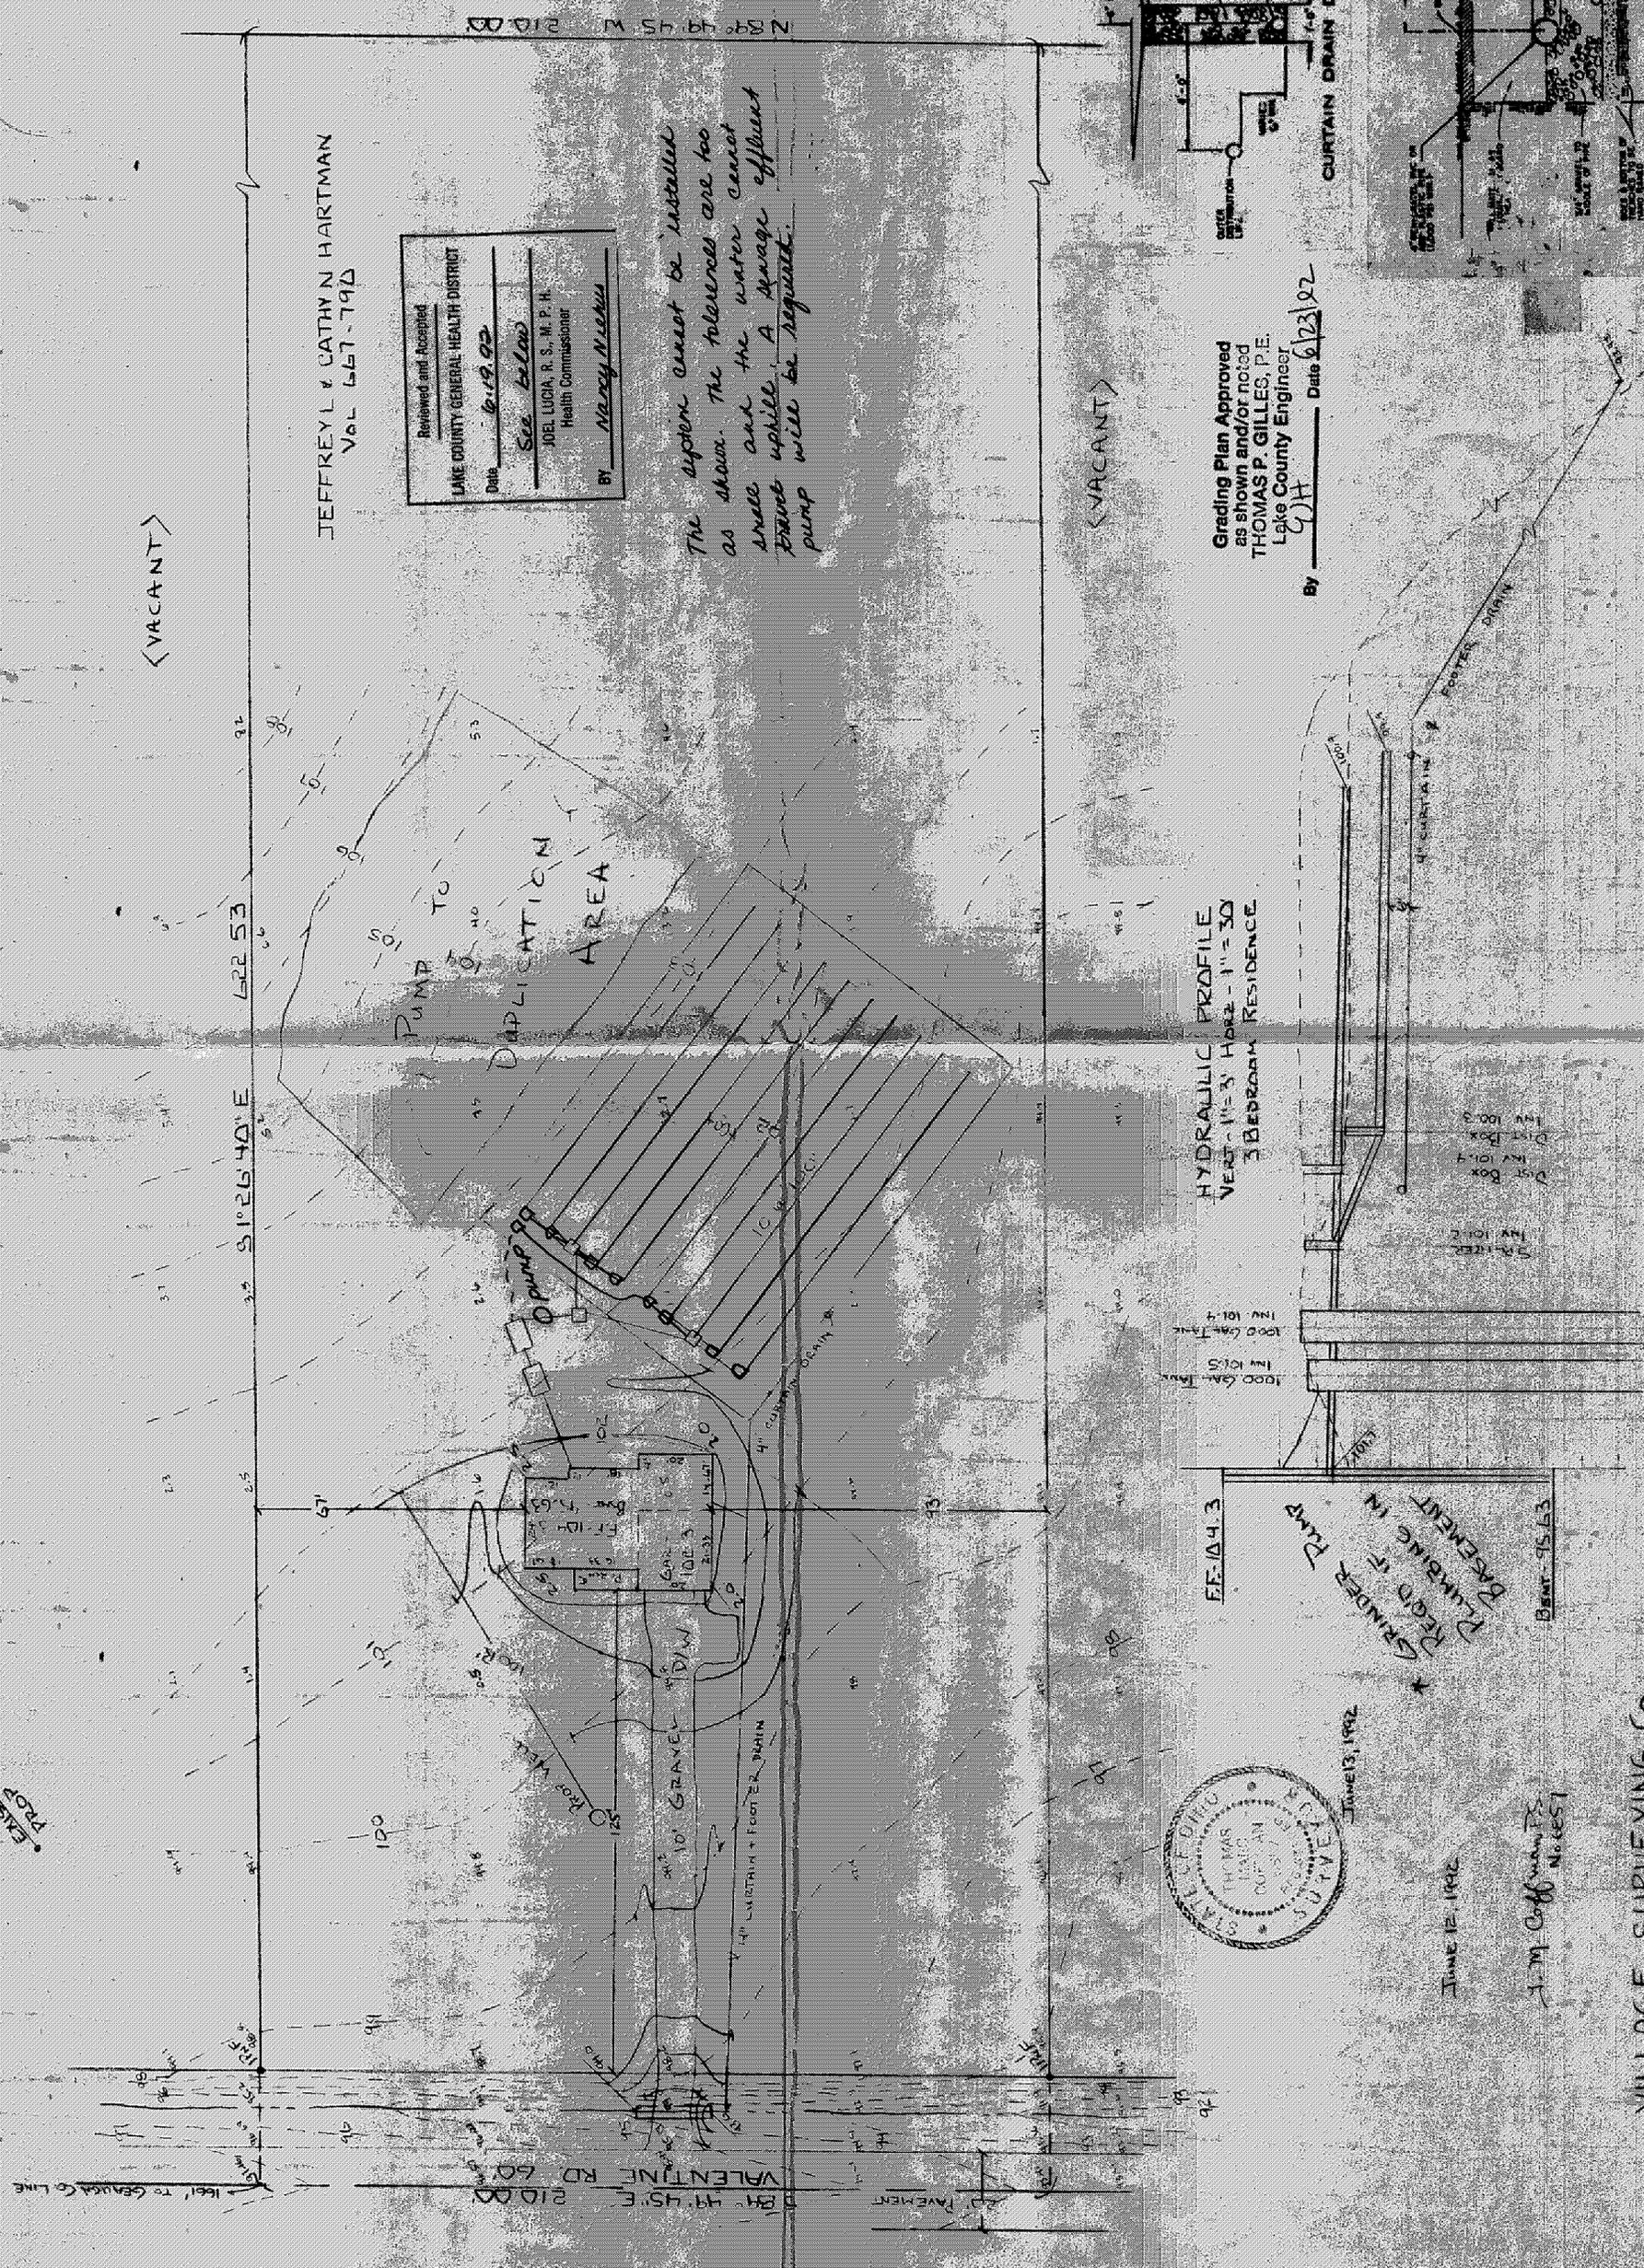


SITE PLAN FOR JOHN CHESNIC
 BEING A PART OF LOT NO. 31 IN THE TOWNSHIP OF LEROY, COUNTY OF LAKE, STATE OF OHIO.

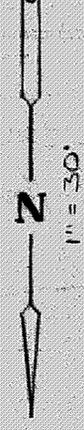

< VACANT >

JEFFREY L & CATHY N HARTMAN
 Vol. 667-79D


Reviewed and Accepted
 LAKE COUNTY GENERAL HEALTH DISTRICT
 Date: 6-19-92
 See below
 JOEL LUCIA, R. S., M. P. H.
 Health Commissioner
 BY: Nancy Nichols

The system cannot be installed as shown. The tolerances are too small and the water cannot travel uphill. A sewage effluent pump will be required.


< VACANT >

Grading Plan Approved as shown and/or noted
 THOMAS P. GILLES, P.E.
 Lake County Engineer
 By: T.P.G. Date: 6/23/92

HYDRAULIC PROFILE
 VERT. 1" = 3' HORZ. 1" = 30'
 3 BEDROOM RESIDENCE

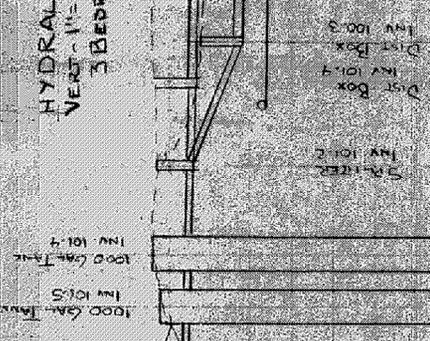


FF-104.3
 GRINDER TANK
 REMAINING IN BASEMENT
 DEM. - 95.63

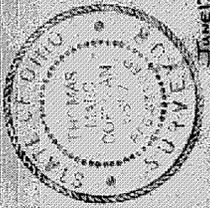

JUNE 12, 1992

J.M. Coffman, P.S.
 No. 1057

VILLAGE SURVEYING CO.
 202 THIRD ST. FAIRPORT HBR, OHIO 44017
 (216) 357-1359

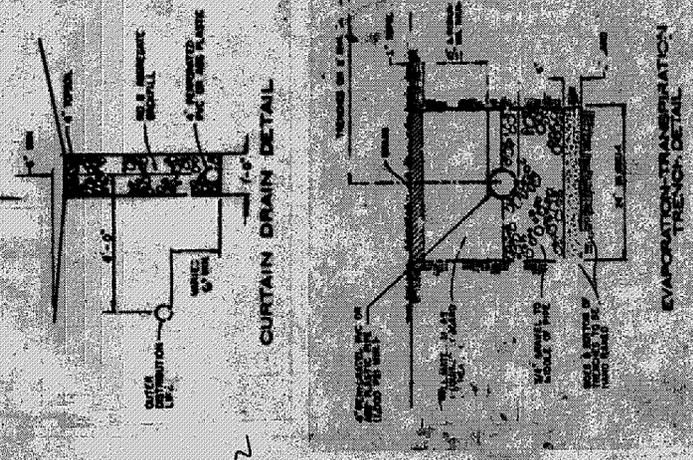

EVAPORATION TRANSPIRATION TRENCH DETAIL