

SITE PLAN FOR 3

NORM FRIEND
1651 MENTOR AVENUE
MENTOR, OHIO

BEING SUBLOTS No. 5, 6, AND 8 IN THE CONCORD AIR
PARK SUBDIVISION Not in Concord Township, Ohio

Grading Plan Approved
as shown and/or noted
THOMAS P. GILLES, P.E.
Lake County Engineer

By JWK Date 5 July 73

DATE MAY 30, 1973
SCALE 1" = 30'

PREPARED BY:

WM. R. GRAY ASSOC. INC.
ENGINEERS & SURVEYORS
7547 MENTOR AVENUE
MENTOR, OHIO

CERTIFICATION:


I HEREBY CERTIFY THAT THIS PLAN IS
CORRECT TO THE BEST OF MY KNOWLEDGE.

By: *Wm. R. Gray*
WM. R. GRAY P.E. SURV. #2752



NOTE:

SEPTIC TANK LAYOUT SHALL BE IN ACCORDANCE
TO THE LAKE COUNTY GENERAL HEALTH DISTRICT

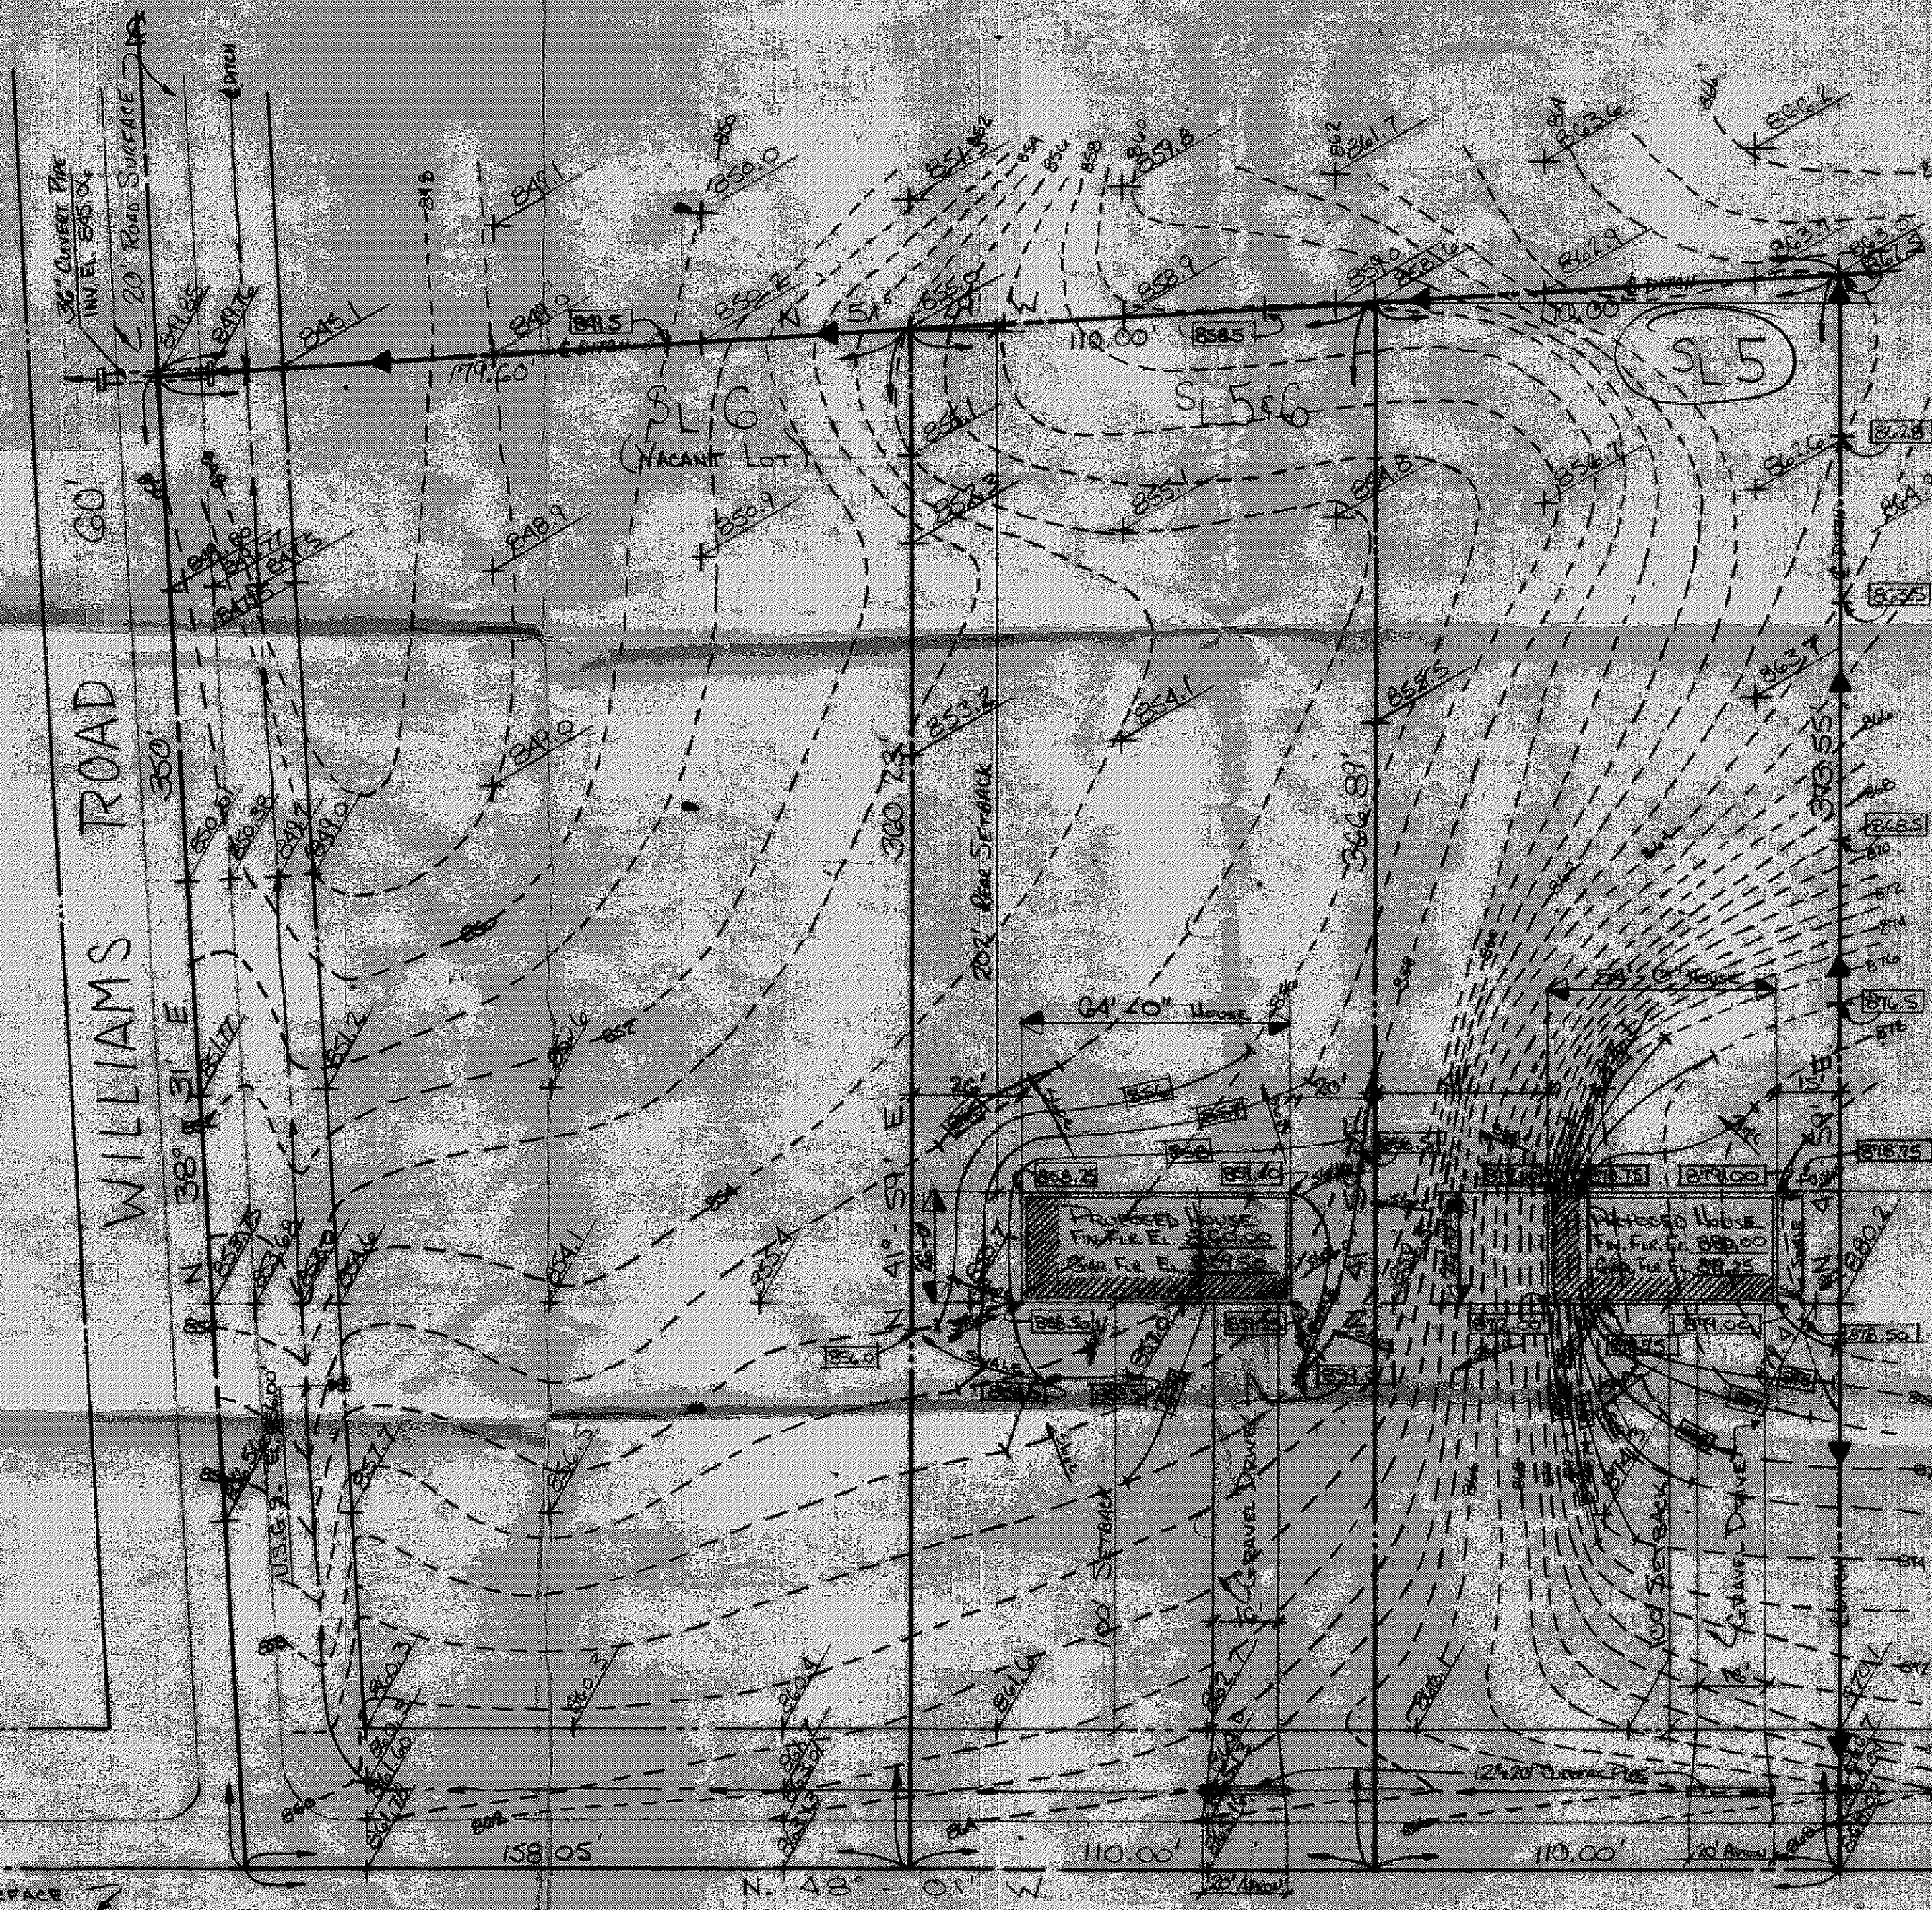

CONCORD - HAMBDEN ROAD 66'