

SITE PLAN

FOR
JOE WELCH

LAKE SHORE
FARMS
COEDINICAL

LOT No 17


MADISON TWP
LAKE CO OHIO

20 JUNE 1989

ETRIK MARK
RIM 631.62
ELEV 631.62

STIM M.H.
RIM 626.05
INV 624.10

Grading Plan Approved
as shown and/or noted
THOMAS P. GILLES, P.E.
Lake County Engineer
By GJH Date 7/5/89

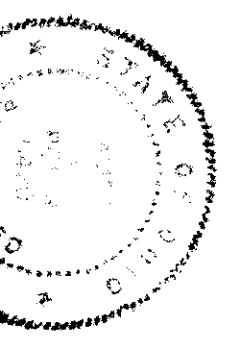

APPROVED
MADISON TWP. ZONING
19543
Permit
Zoning Inspector
JUL 03 1989

VACANT LOT
LOT 15
PENFILED INC
V 345 P 4

POND
ELEV
626.4 ft

SCALE 1" = 20 ft

N

